
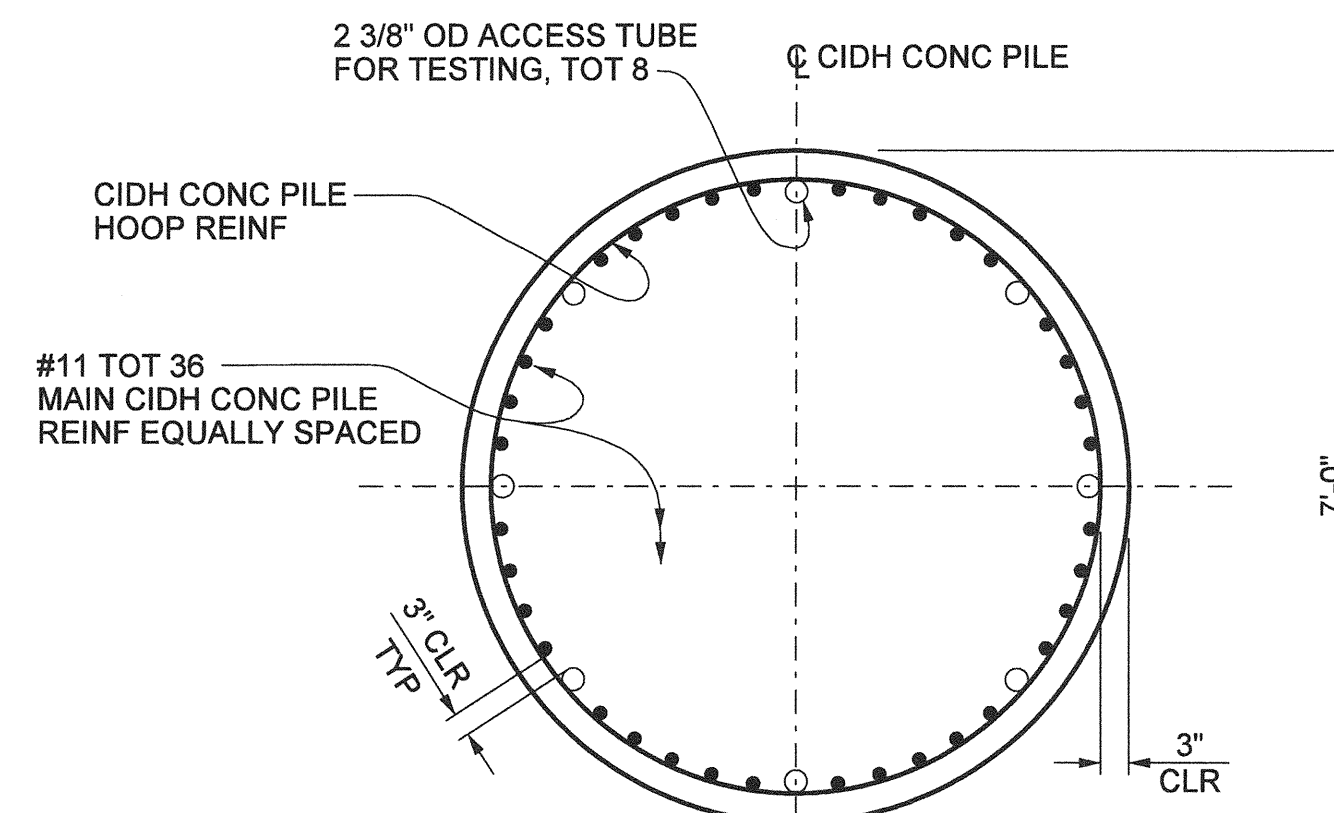
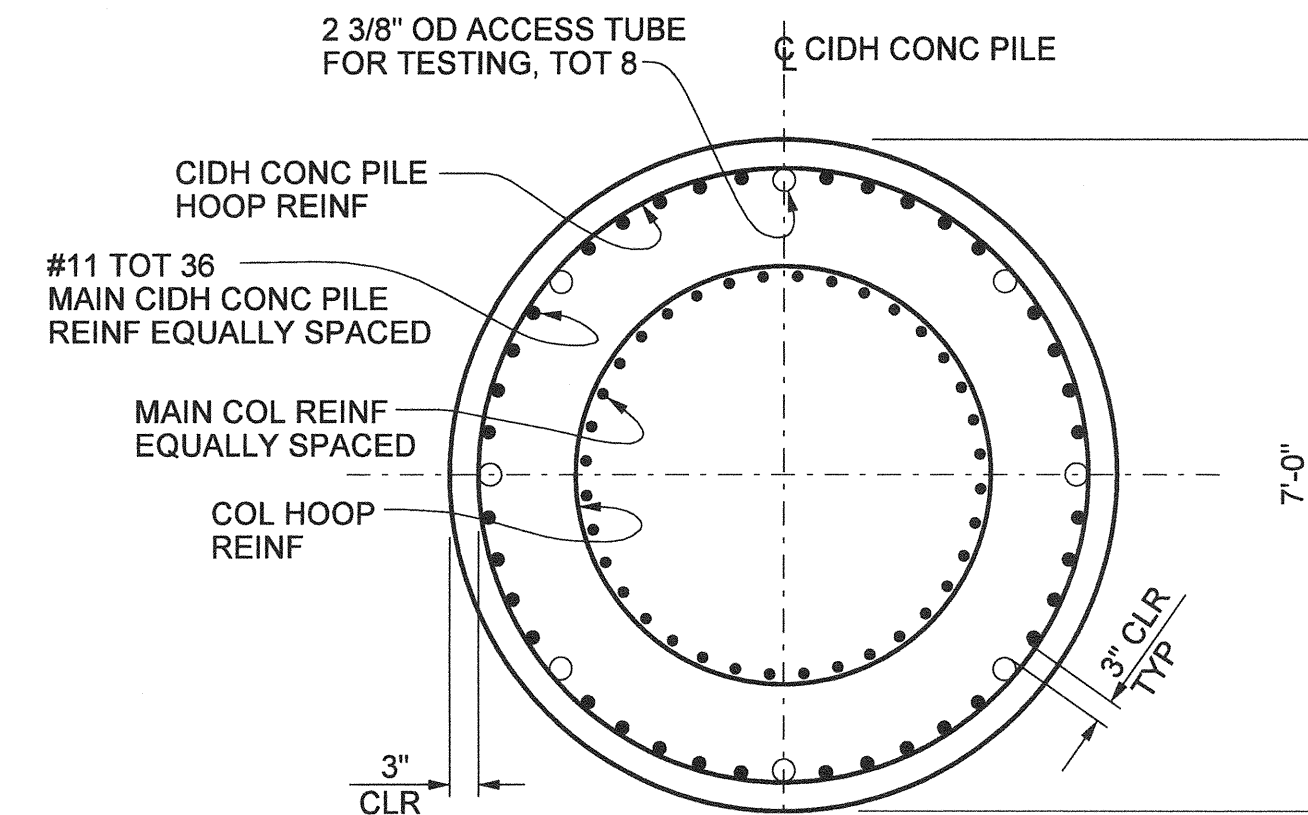


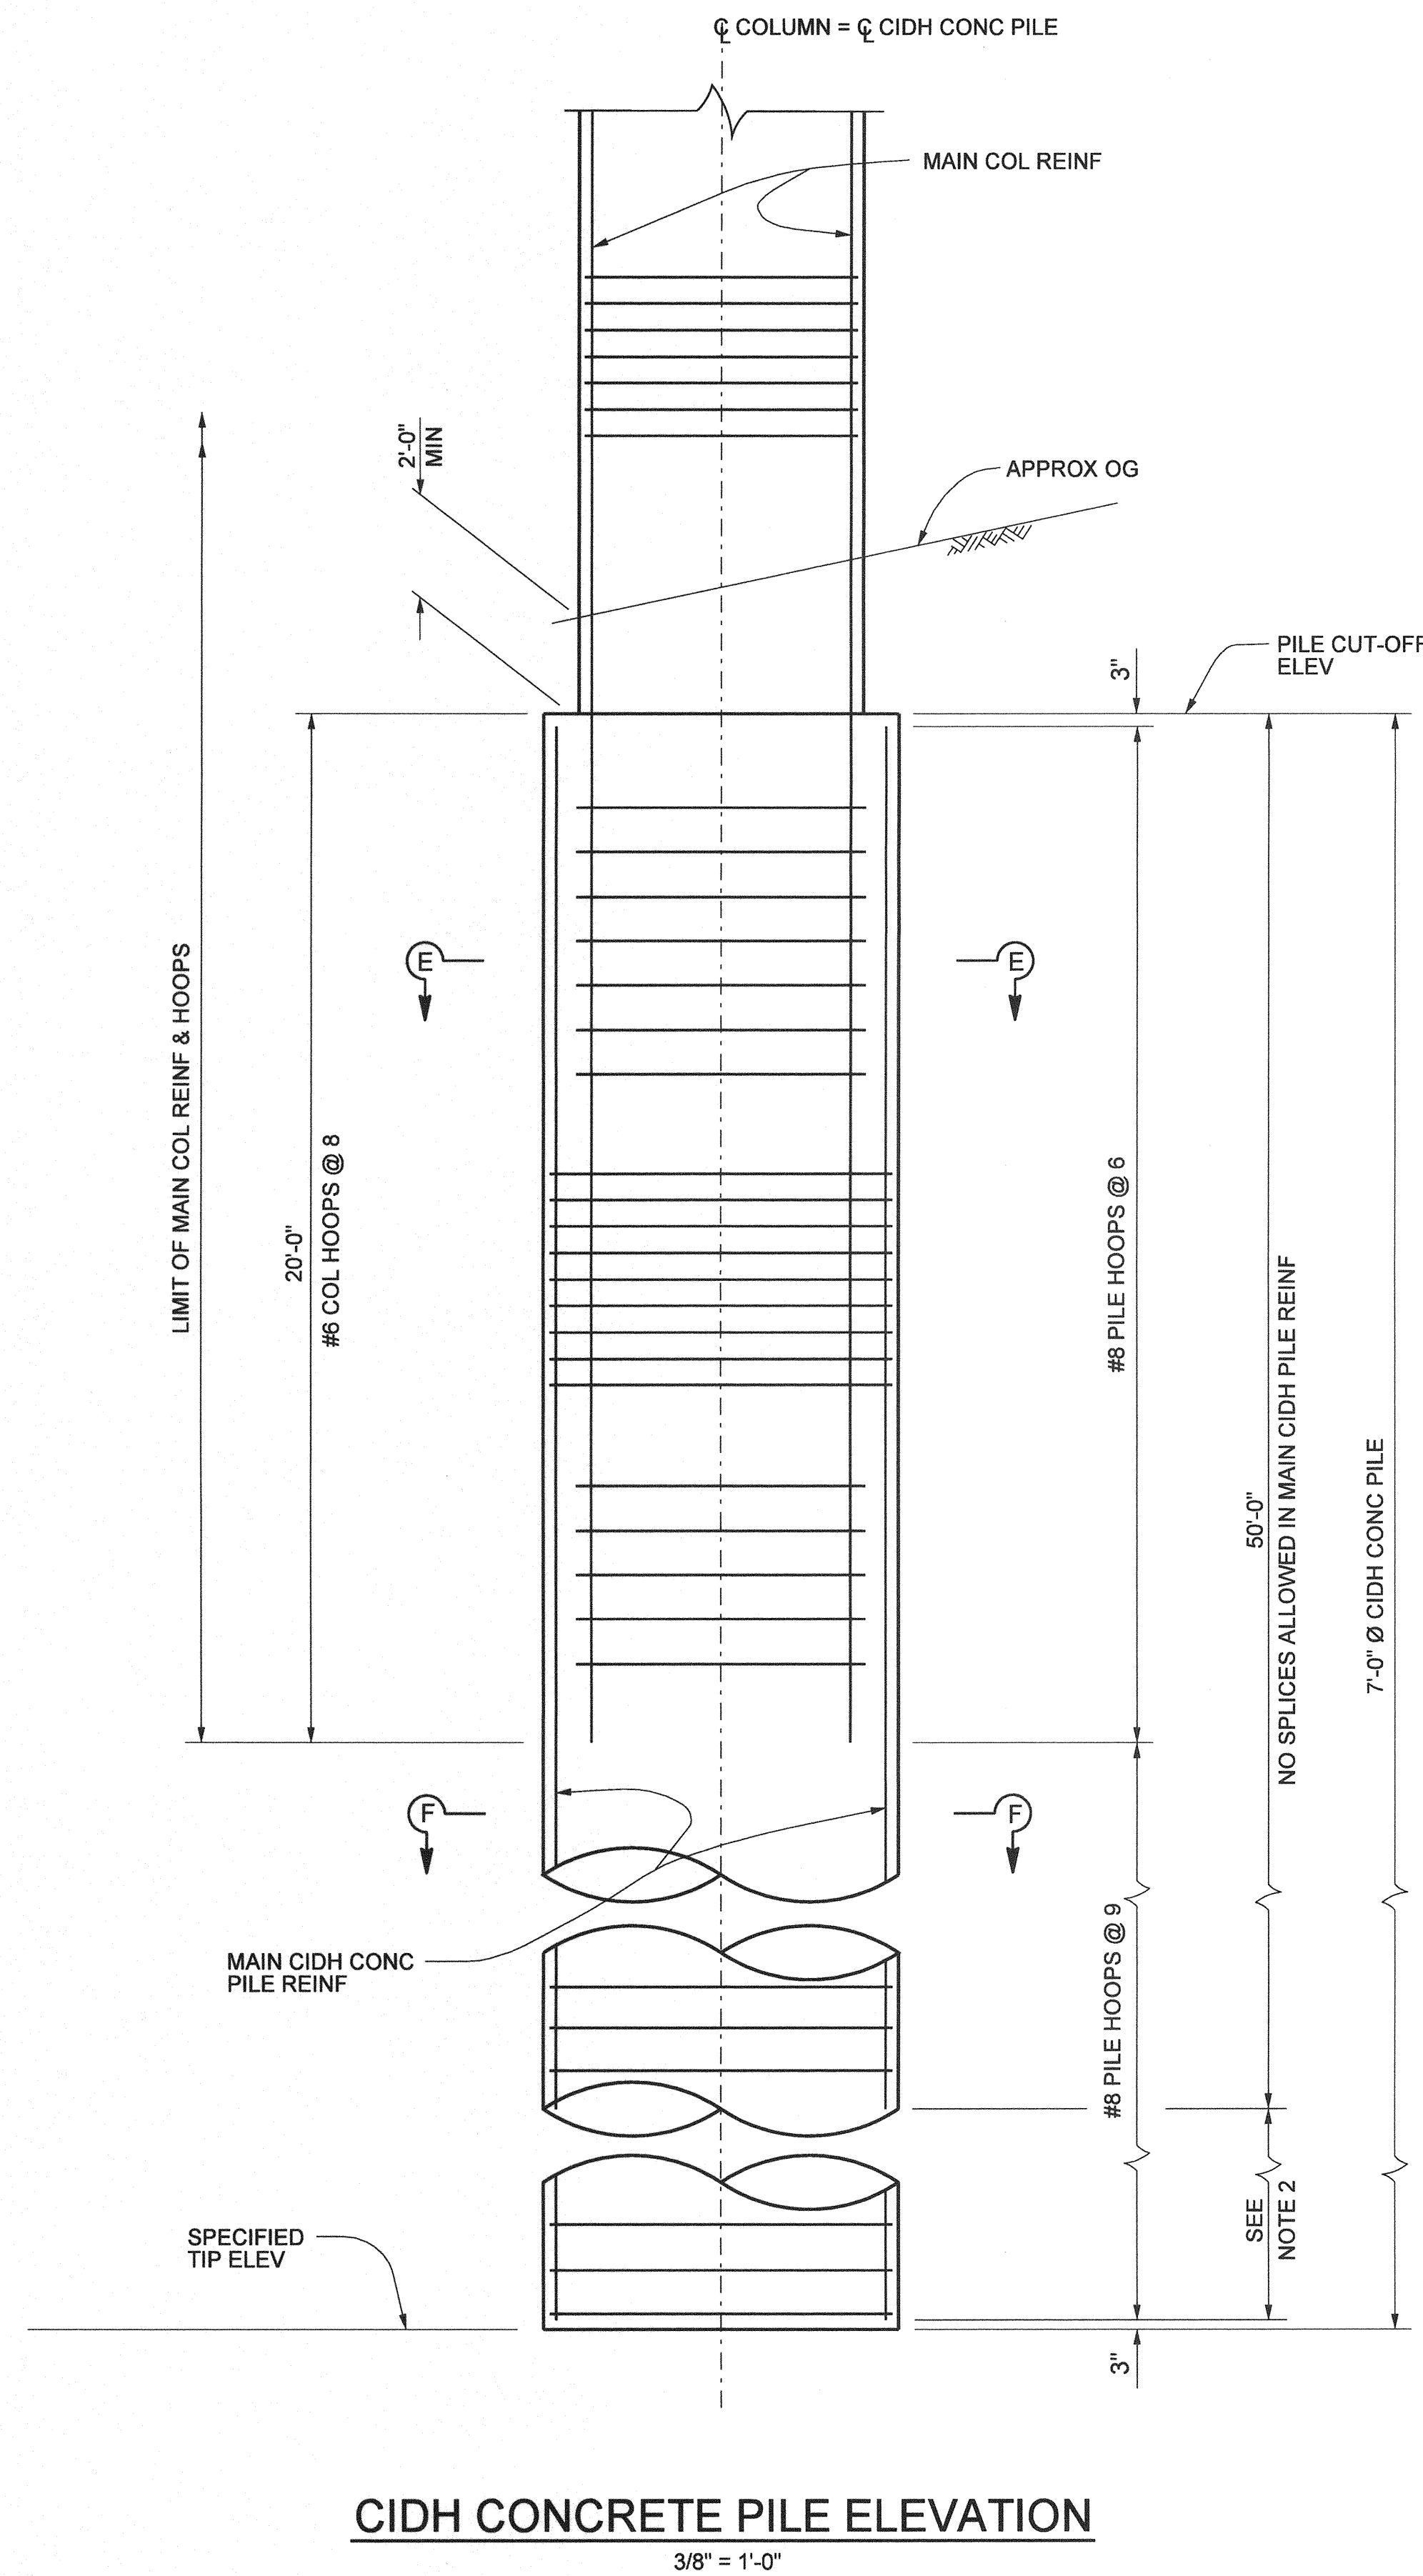

NO AS BUILT CHANGES

AS BUILT

CORRECTION BY: MN

CONTRACT NO.: ER28121

DATE: 12/30/2009

NOTES:

1. THE CONTRACTOR SHALL VERIFY ALL CONTROLLING FIELD DIMENSIONS BEFORE ORDERING OR FABRICATING ANY MATERIAL.
2. ONLY STAGGERED "ULTIMATE" BUTT SPLICES ARE ALLOWED IN MAIN CIDH CONC PILE REINF FOR BENTS 2 & 3.
3. ALL HOOPS SHALL BE WELDED AS SHOWN ON DETAIL "BAR SPIRAL SPLICE, SPIRAL ANCHOR AND HOOP DETAIL" ON "BENT 2 & 3 DETAIL NO. 2" SHEET.
4. FOR COL REINF AND DETAILS, SEE "BENTS 2 & 3 DETAILS NO. 1 AND NO. 2" SHEETS AND "ABUTMENT 1 DETAILS" SHEETS.

1/2" 0 2
3 inches on original drawing

PLANS PREPARED BY:
HNTB
HNTB Corporation
200 E. SANDPOINTE AVENUE, SUITE 200
SANTA ANA, CALIFORNIA 92707
TEL (714) 460-1600 FAX (714) 460-1610

ORANGE COUNTY RESOURCES & DEVELOPMENT MANAGEMENT DEPT		ANTONIO PARKWAY WILDLIFE UNDERCROSSING (WIDEN)																									
BENTS 2 & 3 DETAILS NO. 3		SHEET 55 OF 72																									
<table border="1"> <tr> <th>MARK</th> <th>DATE</th> <th>DESCRIPTION</th> </tr> <tr> <td colspan="3">REVISIONS</td> </tr> <tr> <td colspan="3">PREPARED UNDER RESPONSIBLE CHARGE OF:</td> </tr> <tr> <td colspan="3"> </td> </tr> <tr> <td>DESIGNED</td> <td>J. WANG</td> <td>CHECKED</td> <td>E. JEANG</td> </tr> <tr> <td>DRAWN</td> <td>J. WANG</td> <td>DATE</td> <td>9/19/08</td> </tr> <tr> <td>SCALE</td> <td>AS SHOWN</td> <td>DRAWING NO.</td> <td></td> </tr> </table>				MARK	DATE	DESCRIPTION	REVISIONS			PREPARED UNDER RESPONSIBLE CHARGE OF:						DESIGNED	J. WANG	CHECKED	E. JEANG	DRAWN	J. WANG	DATE	9/19/08	SCALE	AS SHOWN	DRAWING NO.	
MARK	DATE	DESCRIPTION																									
REVISIONS																											
PREPARED UNDER RESPONSIBLE CHARGE OF:																											
DESIGNED	J. WANG	CHECKED	E. JEANG																								
DRAWN	J. WANG	DATE	9/19/08																								
SCALE	AS SHOWN	DRAWING NO.																									

Date Plotted:

File Name: J:\34092\CADD\Struct\sheet\antonio\pkwy-S-14.dgn

Border sheet last modified 09-Nov-1999