



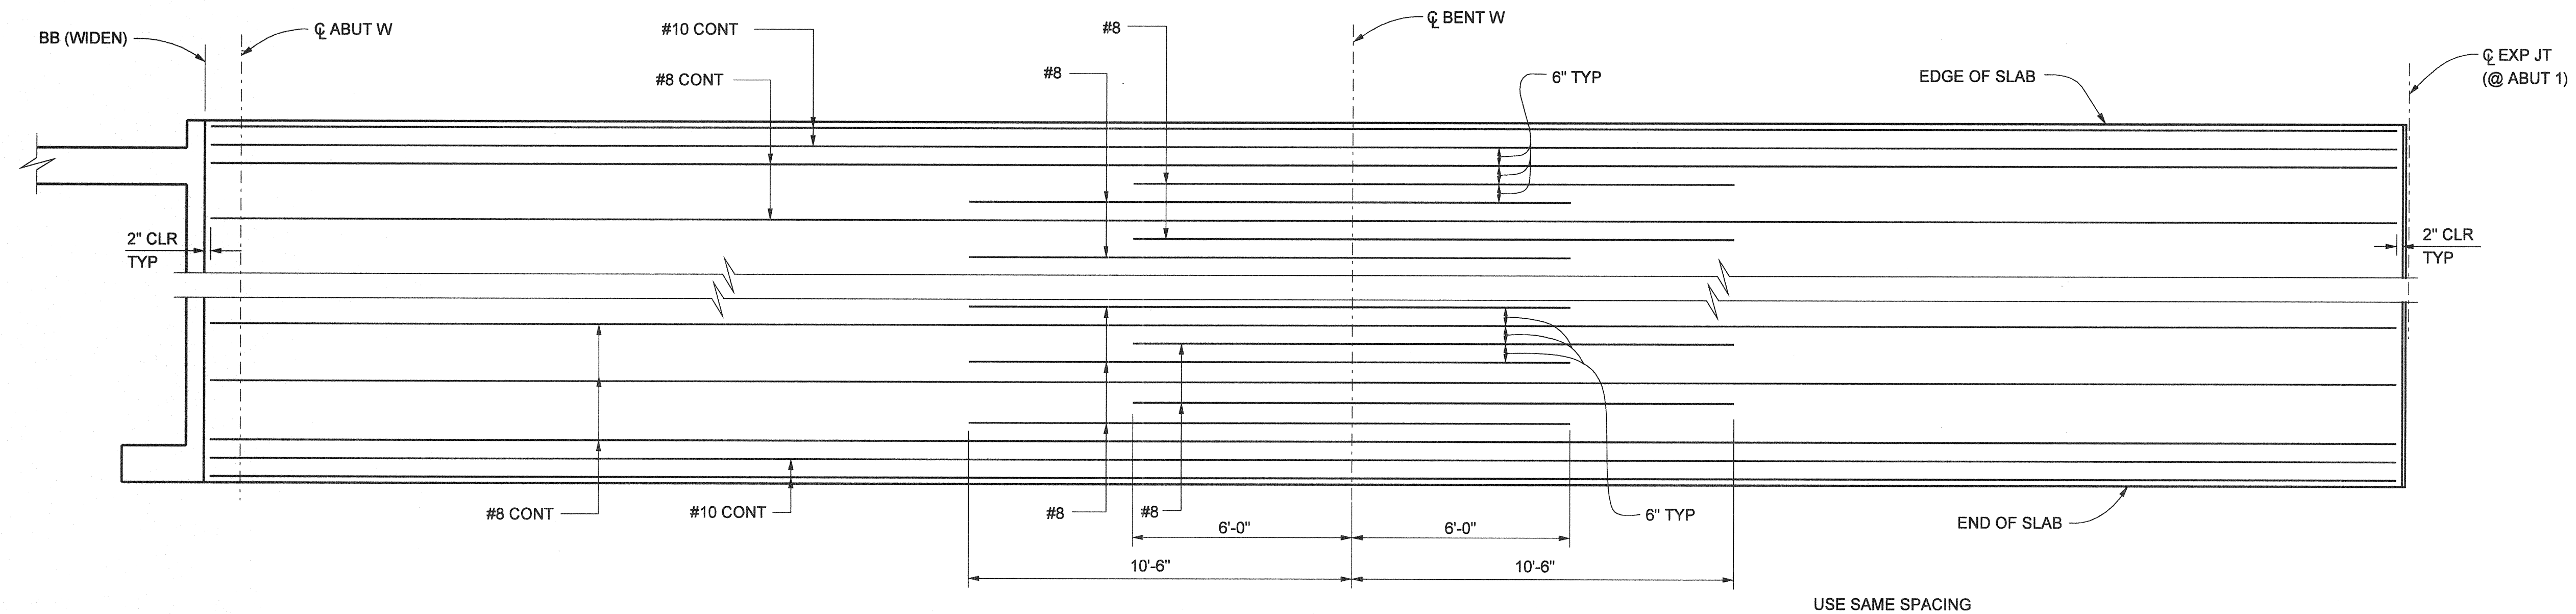

REINFORCEMENT - TOP OF SLAB

3/8" = 1'-0"

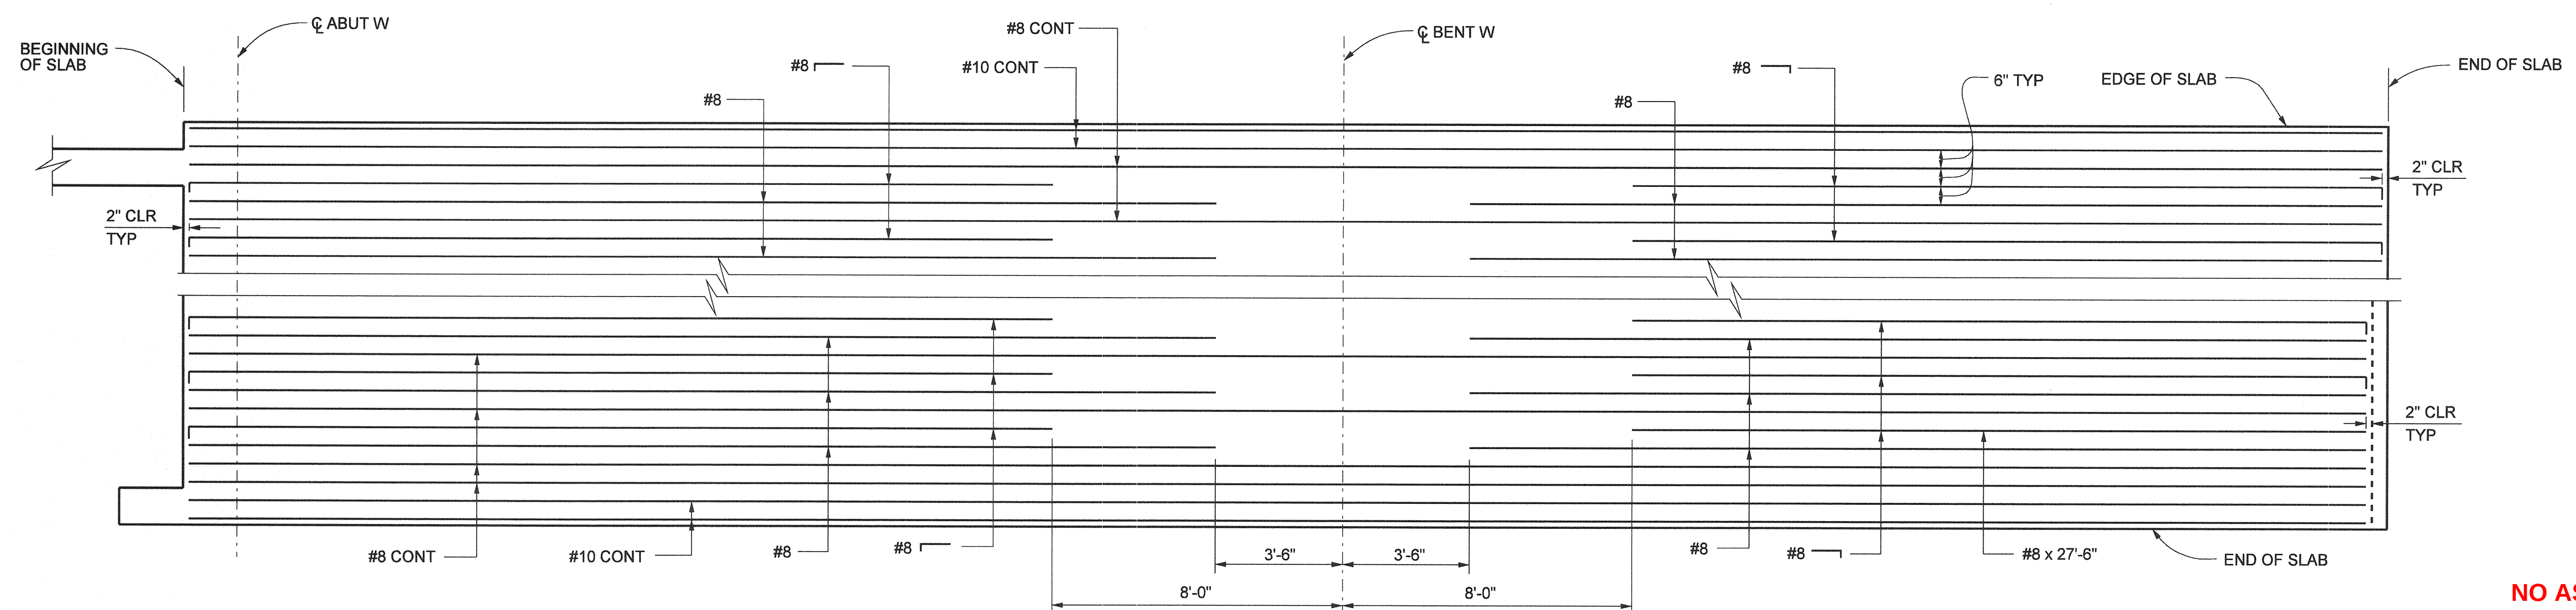


REINFORCEMENT - BOTTOM OF SLAB

3/8" = 1'-0"

NO AS BUILT CHANGES

AS BUILT

CORRECTION BY: MN
 CONTRACT NO.: ER28121
 DATE: 12/30/2009

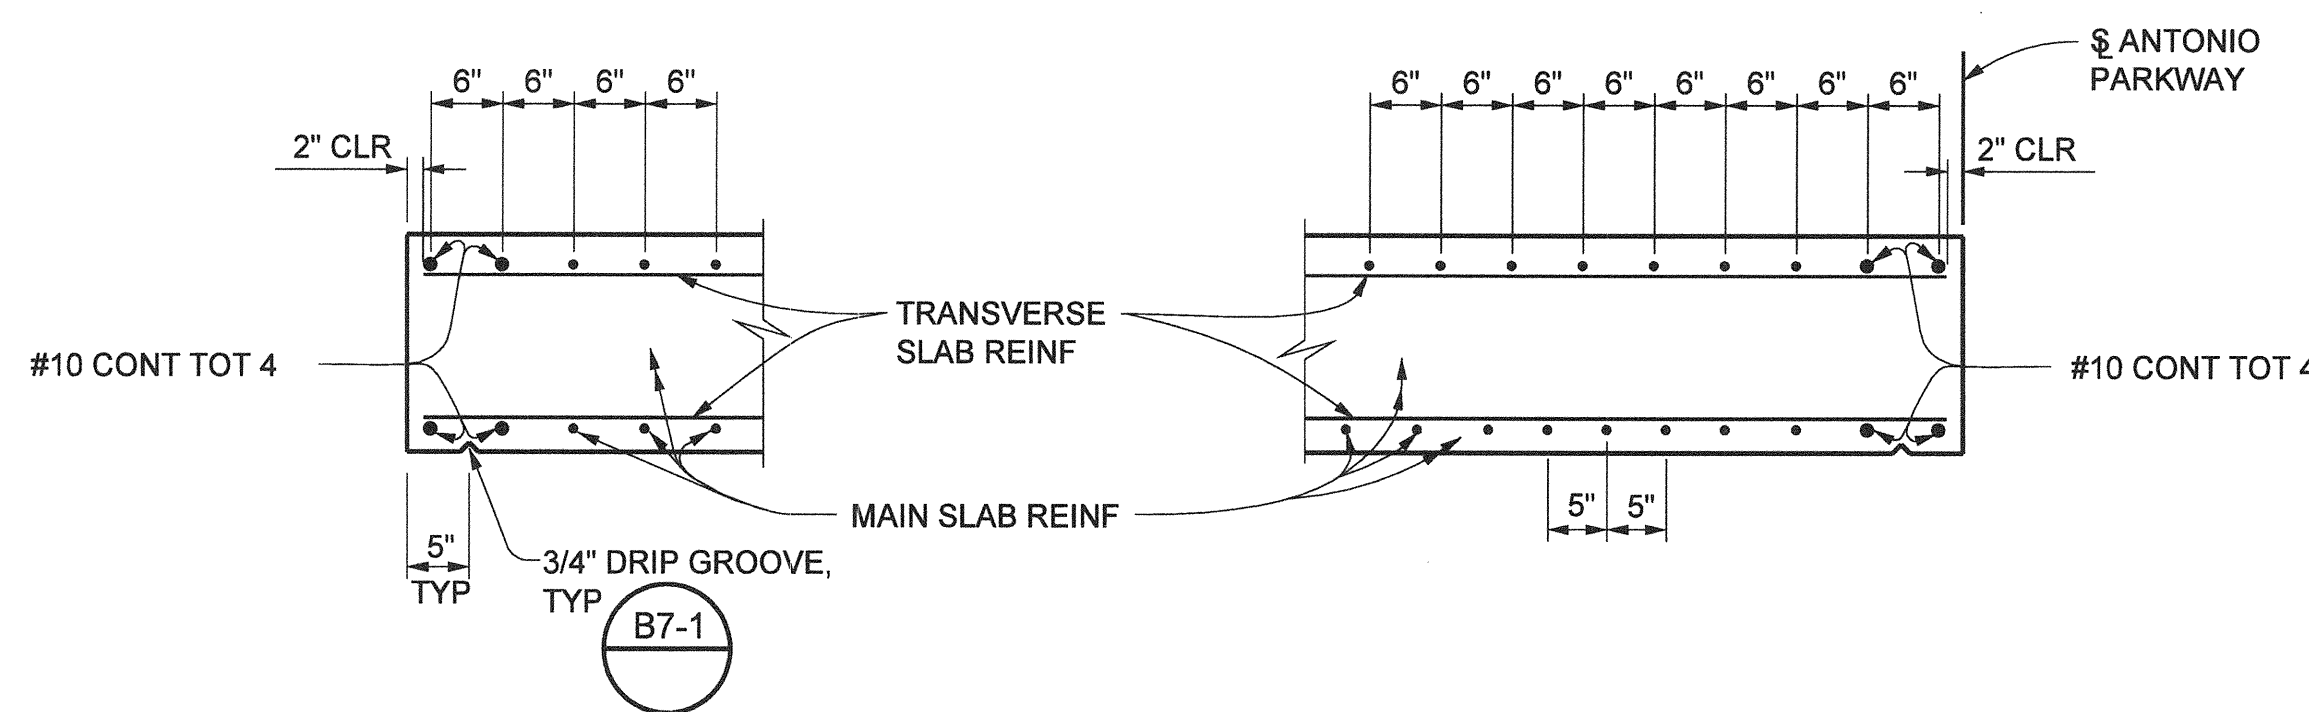

EDGE OF SLAB DETAIL

3/4" = 1'-0"

CURB AND RAILING NOT SHOWN FOR CLARITY

- NOTES:**
1. THE CONTRACTOR SHALL VERIFY ALL CONTROLLING FIELD DIMENSIONS BEFORE ORDERING OR FABRICATING ANY MATERIAL.
 2. NO SPLICE IS ALLOWED IN TOP AND BOTTOM MAIN BARS.
 3. FOR DECK CHANNEL DRAIN INFORMATION, SEE "DECK DRAIN LAYOUT" SHEET.

PLANS PREPARED BY: **HNTB**
 HNTB Corporation
 200 E. SANDPOINTE AVENUE, SUITE 200
 SANTA ANA, CALIFORNIA 92707
 TEL (714) 460-1600 FAX (714) 460-1610

ORANGE COUNTY RESOURCES & DEVELOPMENT MANAGEMENT DEPT		ANTONIO PARKWAY WILDLIFE UNDERCROSSING (WIDEN)		SHEET 56 OF 72	
SLAB REINFORCEMENT					
DESIGNED	J. WANG	CHECKED	F. JEANG	DATE	
DRAWN	N. MORALES	DATE			
SCALE	AS SHOWN	DATE	9/19/08	DRAWING NO.	
PREPARED UNDER RESPONSIBLE CHARGE OF: Yung-Nien Wang RCE C 43559 (EXP. 6-30-08)					