



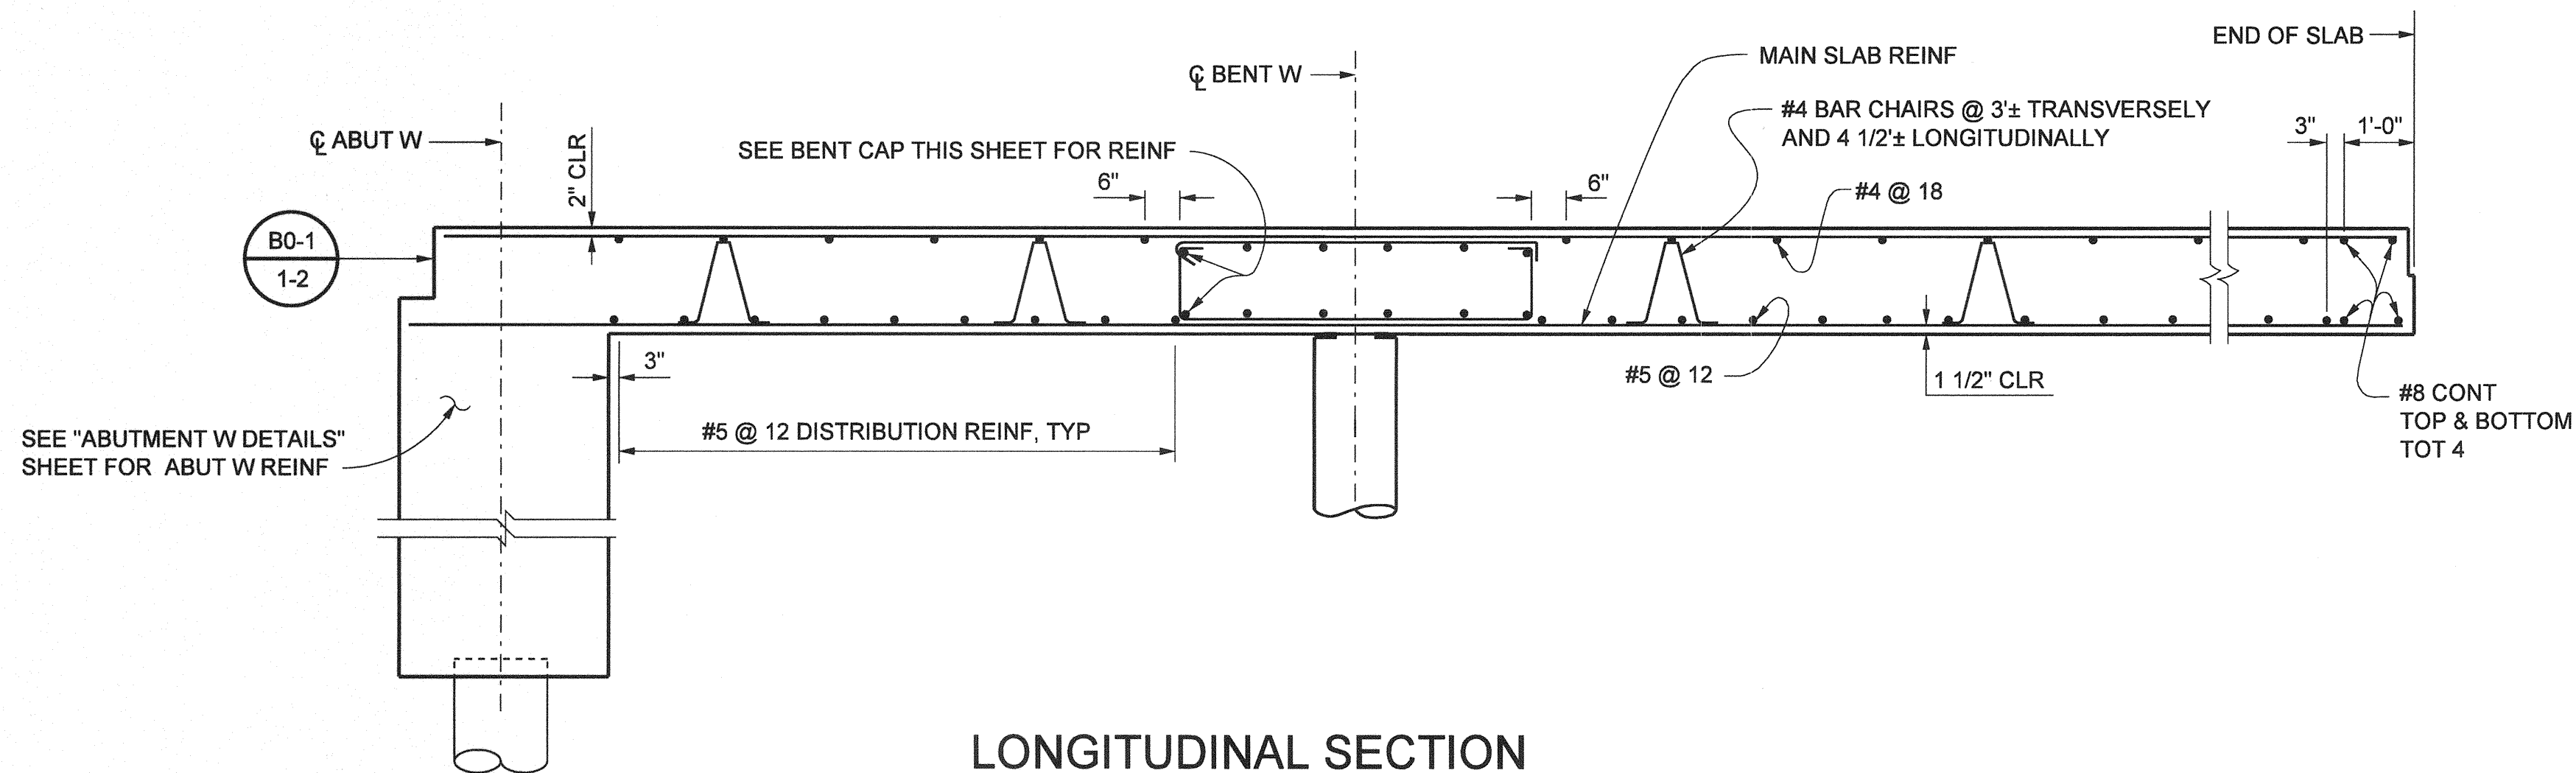

LONGITUDINAL SECTION


NO SCALE

PILE REINF NOT SHOWN FOR CLARITY

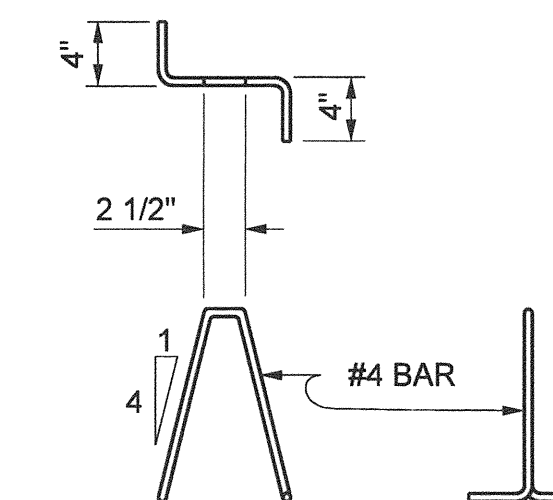

BAR CHAIR DETAIL


NO SCALE

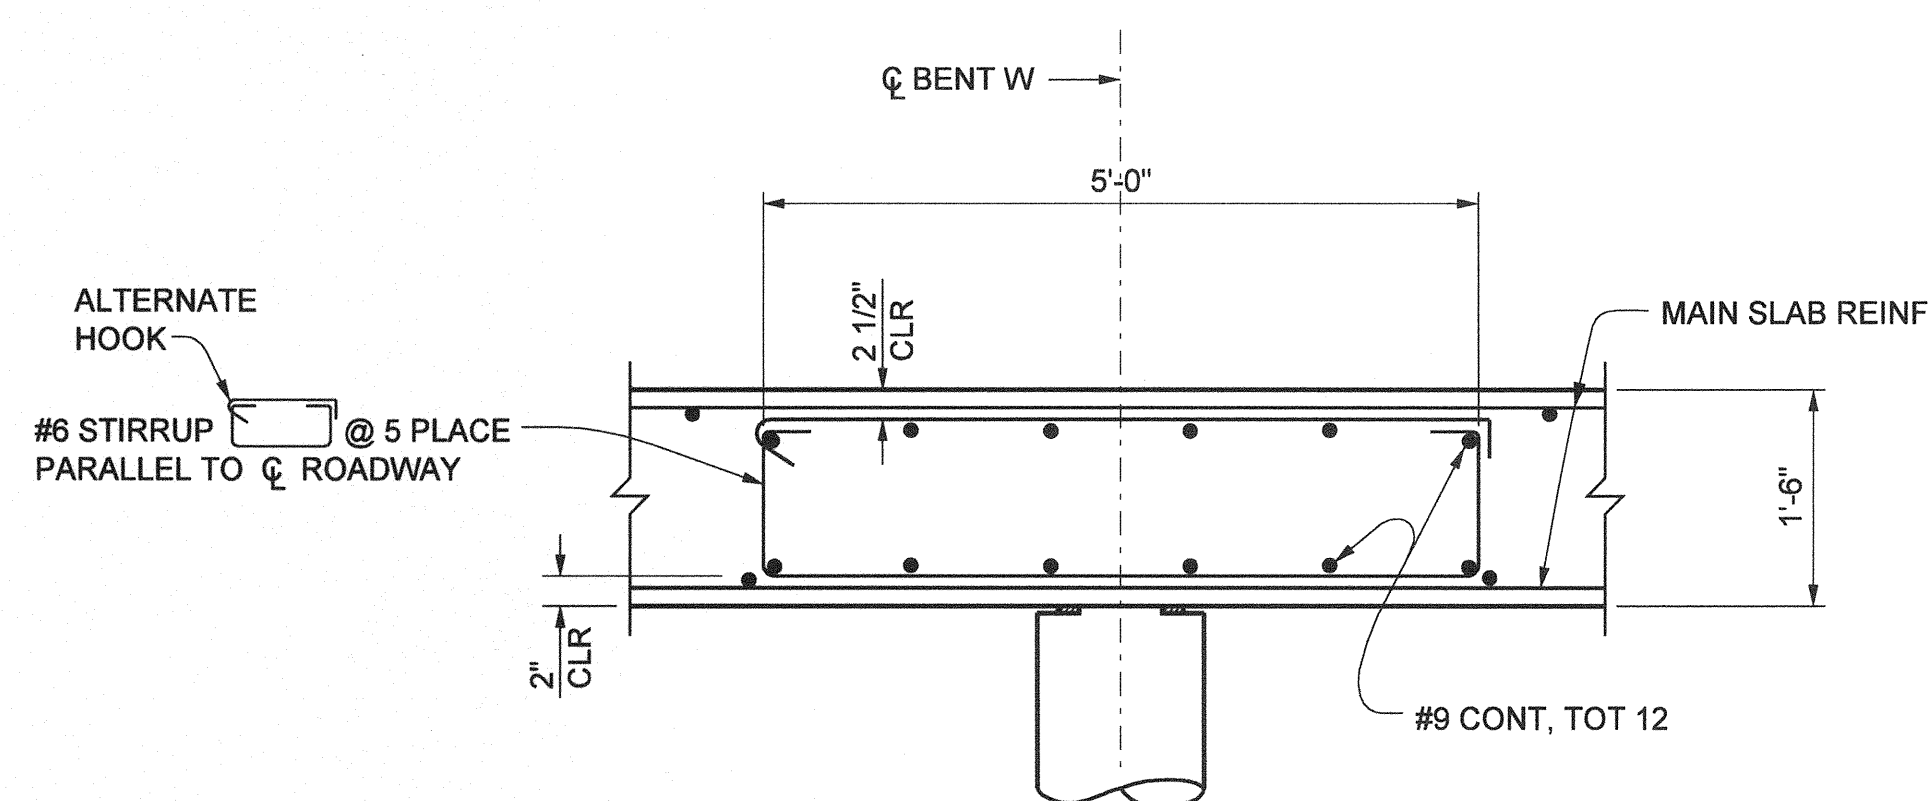

BENT CAP

NO SCALE

PILE REINF NOT SHOWN FOR CLARITY

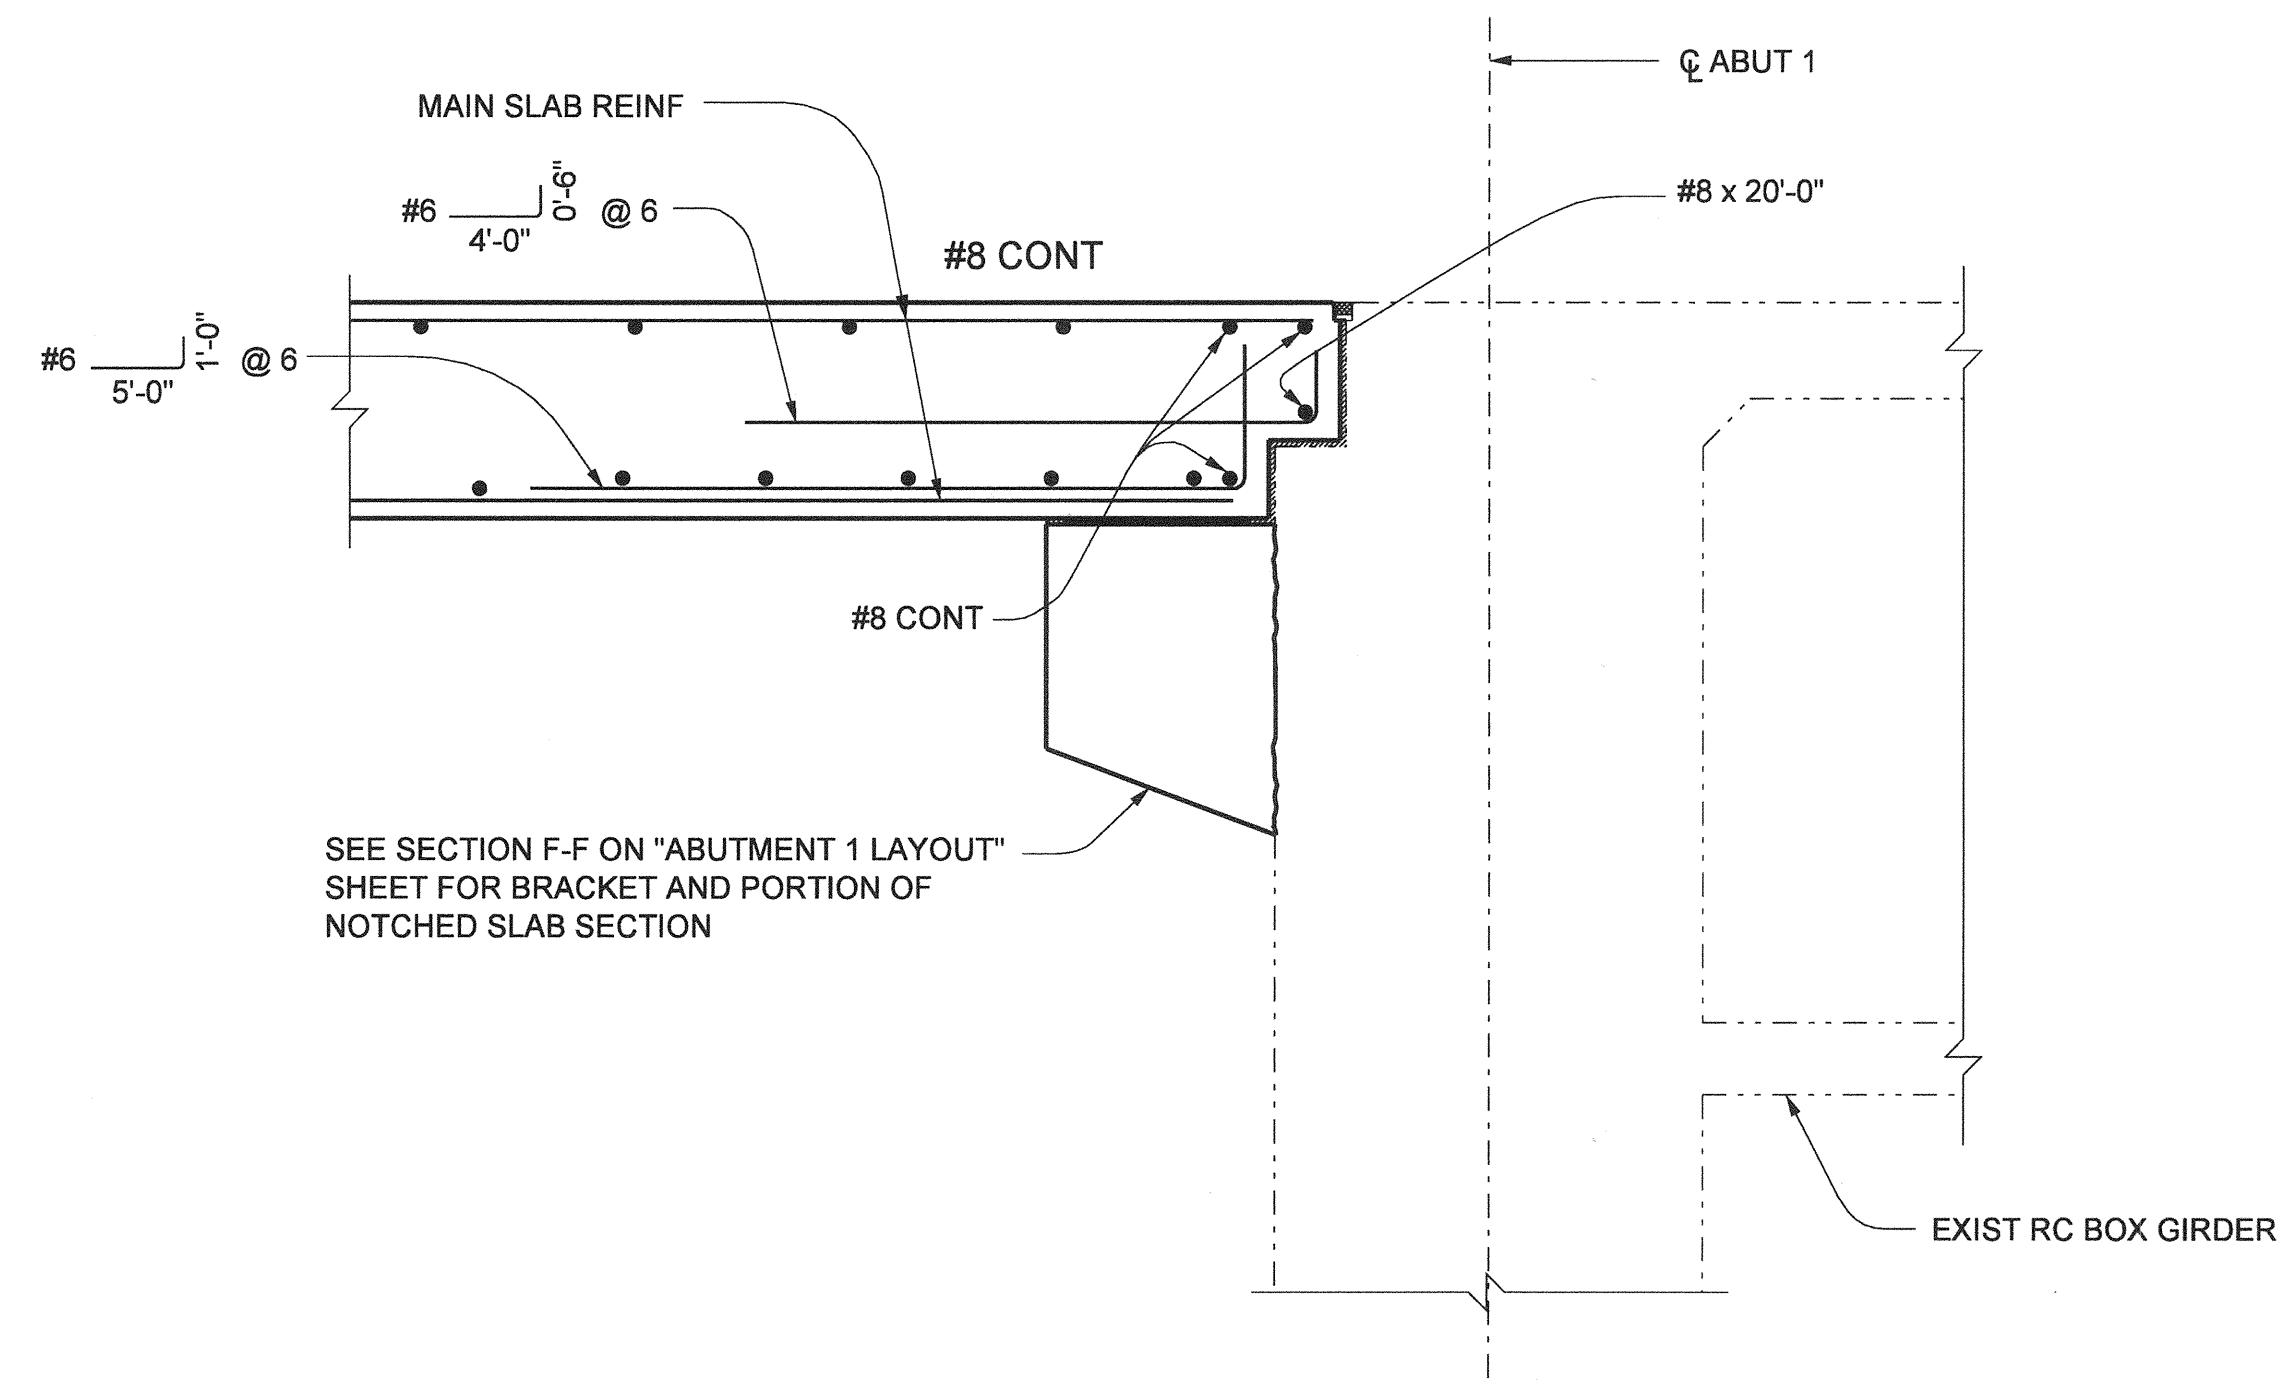

NOTCHED SLAB SECTION

NO SCALE

SEE LONGITUDINAL SECTION THIS SHEET FOR REINF INFORMATION NOT SHOWN FOR THIS SECTION ONLY.

NO AS BUILT CHANGES

AS BUILT

CORRECTION BY: MN
CONTRACT NO.: ER28121
DATE: 12/30/2009

NOTE:
THE CONTRACTOR SHALL VERIFY ALL CONTROLLING FIELD DIMENSIONS BEFORE ORDERING OR FABRICATING ANY MATERIAL.

LEGEND

----- DENOTES EXISTING STRUCTURE
————— DENOTES NEW STRUCTURE

PLANS PREPARED BY:
HNTB
HNTB Corporation
200 E. SANDPOINTE AVENUE, SUITE 200
SANTA ANA, CALIFORNIA 92707
TEL (714) 460-1600 FAX (714) 460-1610

ORANGE COUNTY RESOURCES & DEVELOPMENT MANAGEMENT DEPT		ANTONIO PARKWAY WILDLIFE UNDERCROSSING (WIDEN)	
SLAB REINFORCEMENT DETAILS			
DESIGNED <u>A. WANG</u>	CHECKED <u>F. JEANG</u>	SHEET 57 OF 72	
DRAWN <u>N. MORALES</u>	DATE <u>9/19/06</u>	DRAWING NO.	
SCALE <u>AS SHOWN</u>	DATE <u>9/19/06</u>	DRAWING NO.	

PREPARED UNDER RESPONSIBLE CHARGE OF:
Yung-Nien Wang
REGISTERED PROFESSIONAL ENGINEER
NO. C 43559
EXP. 6-30-08
CIVIL
STATE OF CALIFORNIA
Yung-Nien Wang
RCE C 43559 (EXP. 6-30-08)

Date Plotted:

File Name: J:\34092\CADD\Structs\slabs\antonio\pky-S-16.dgn

Border sheet last modified 05-Nov-1999