



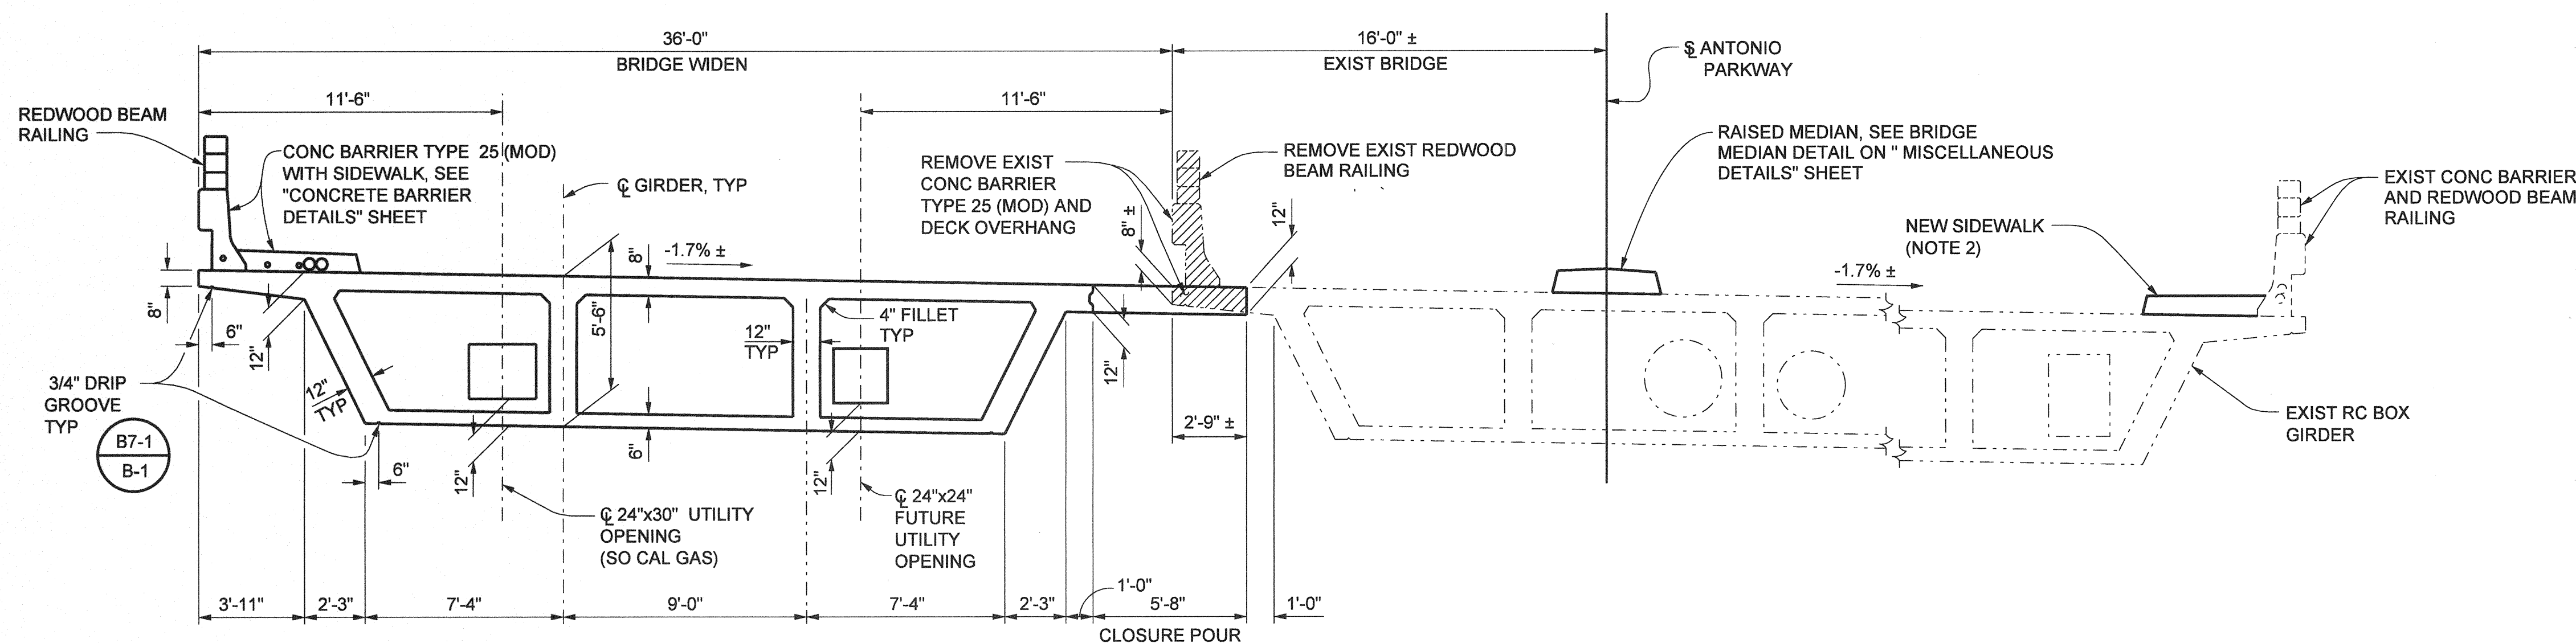

TYPICAL SECTION

1/4" = 1'-0"

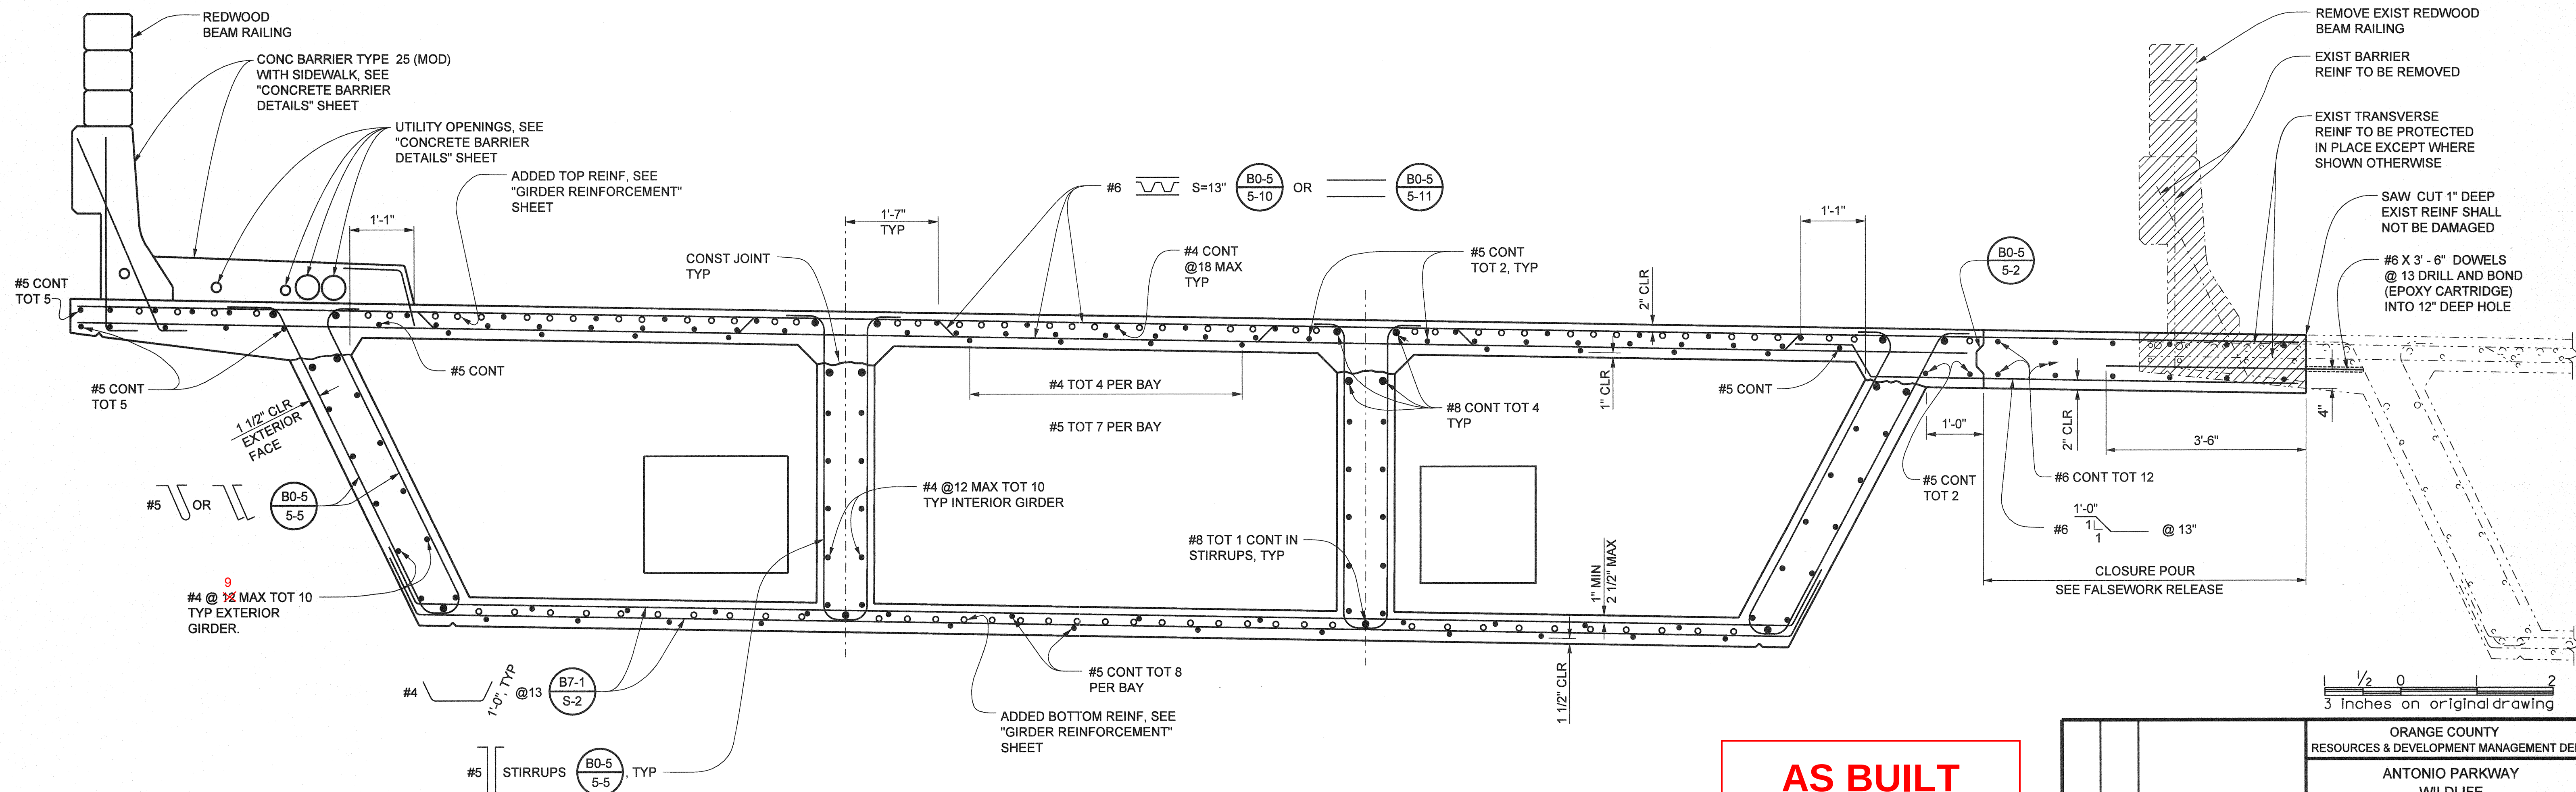

PART TYPICAL SECTION

1/2" = 1'-0"

NOTES:

1. THE CONTRACTOR SHALL VERIFY ALL CONTROLLING FIELD DIMENSIONS BEFORE ORDERING OR FABRICATING ANY MATERIAL.
2. FOR NEW SIDEWALK ON EASTSIDE OF THE EXIST BRIDGE, SEE "SIDEWALK DETAILS" SHEET.
3. FOR END DIAPHRAGM DETAILS AT ABUTMENT 1, SEE "ABUTMENT 1 DETAILS NO. 2" SHEET.
4. SEE ROAD PLANS FOR STAGING OF CONSTRUCTION OF NEW SIDEWALK ALONG THE EAST SIDE OF THE EXIST BRIDGE.

AS BUILT

CORRECTION BY: MN

CONTRACT NO.: ER28121

DATE: 12/30/2009

PLANS PREPARED BY:
HNTB
HNTB Corporation
200 E. SANDPOINTE AVENUE, SUITE 200
SANTA ANA, CALIFORNIA 92707
TEL (714) 460-1600 FAX (714) 460-1610

ORANGE COUNTY RESOURCES & DEVELOPMENT MANAGEMENT DEPT		ANTONIO PARKWAY WILDLIFE UNDERCROSSING (WIDEN)	
TYPICAL SECTION			
DESIGNED <u>J. WANG</u>	CHECKED <u>F. JIANG</u>	SHEET 58 OF 72	
DRAWN <u>N. MORALES</u>	DATE <u>9/18/08</u>	DRAWING NO.	
SCALE <u>AS SHOWN</u>	DATE <u>9/18/08</u>	DRAWING NO.	

Date Plotted:

File Name: J:\34092\CADD\Strocsheets\antoniopkwy-S-17.dgn

Border sheet last modified 09-Nov-1999