

ADDED TOP DECK REINFORCEMENT
NO SCALE

ADDED BOTTOM SLAB REINFORCEMENT
NO SCALE

AS BUILT
CORRECTION BY: MN
CONTRACT NO.: ER28121
DATE: 12/30/2009


1/2 0 2
3 inches on original drawing

- NOTES:
1. THE CONTRACTOR SHALL VERIFY ALL CONTROLLING FIELD DIMENSIONS BEFORE ORDERING OR FABRICATING ANY MATERIAL.
 2. NUMBERS AT THE END OF BARS INDICATE LENGTH FROM CL OF BENT CAP. TOP REINFORCEMENT SHALL NOT BE LAP SPLICED WITHIN 25' OF MID-SPAN OR WITHIN 25' OF CL OF BENT CAP. TOP REINFORCEMENT SHALL NOT BE LAP SPLICED WITHIN 25' OF CL OF BENT CAP.
 3. BOTTOM REINFORCEMENT SHALL NOT BE LAP SPLICED WITHIN 25' OF MID-SPAN OR WITHIN 25' OF CL OF BENT CAP. TOP REINFORCEMENT SHALL NOT BE LAP SPLICED WITHIN 25' OF CL OF BENT CAP.
 4. TOP AND BOTTOM REINF SYMMETRICAL ABOUT CL SPAN 2.

LEGEND

----- DENOTES EXISTING STRUCTURE

————— DENOTES NEW STRUCTURE

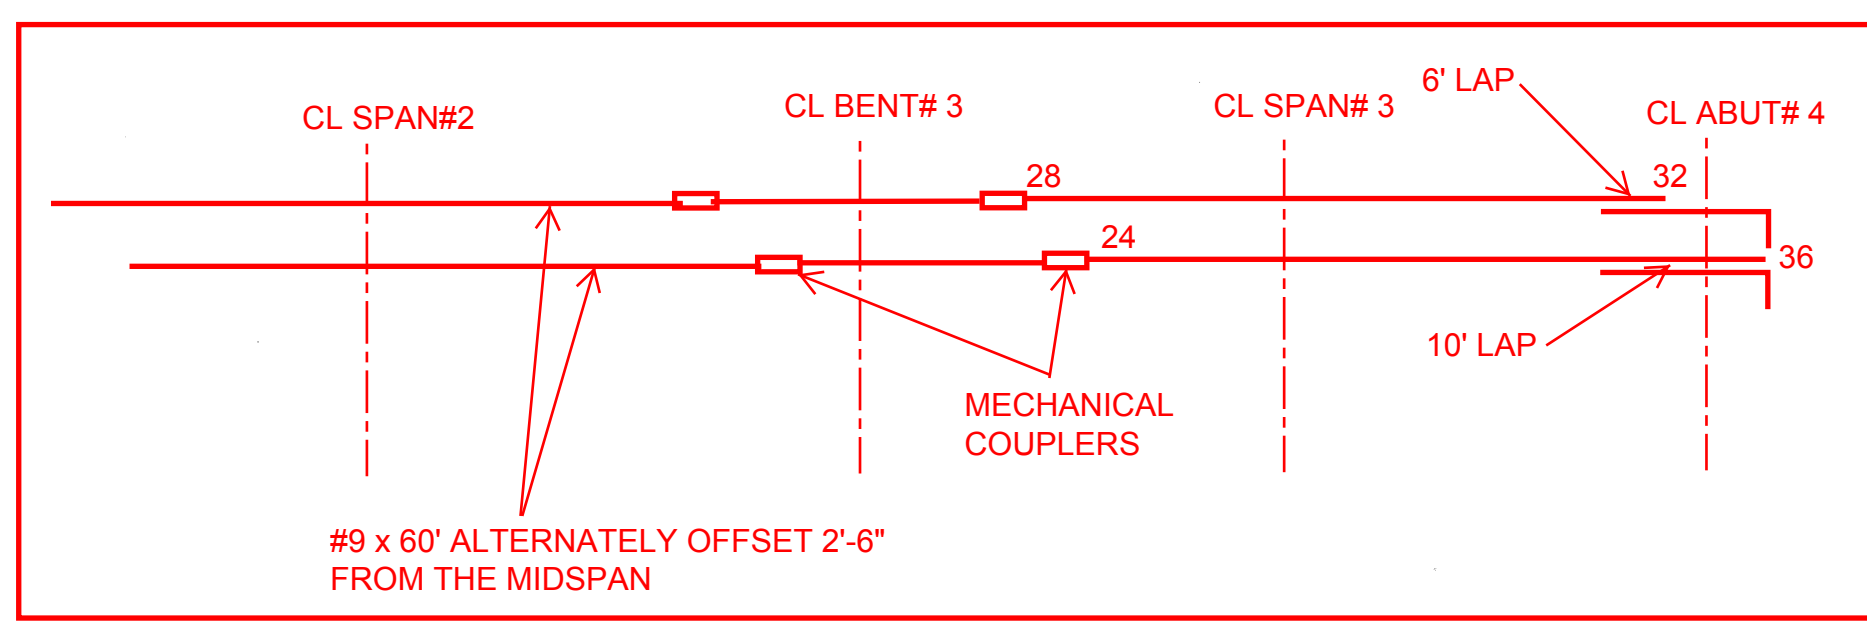

PLANS PREPARED BY:
HNTB
HNTB Corporation
200 E. SANDPOINTE AVENUE, SUITE 200
SANTA ANA, CALIFORNIA 92707
TEL (714) 460-1600 FAX (714) 460-1610

ORANGE COUNTY RESOURCES & DEVELOPMENT MANAGEMENT DEPT	
ANTONIO PARKWAY WILDLIFE UNDERCROSSING (WIDEN)	
GIRDER REINFORCEMENT	
DESIGNED <u>J. WANG</u>	SHEET <u>60</u>
DRAWN <u>L. ZHANG</u>	CHECKED <u>E. JEAN</u>
DATE <u>9/19/09</u>	DRAWING NO. <u>OF 72</u>
PREPARED UNDER RESPONSIBLE CHARGE OF: Yung-Nien Wang REGISTERED PROFESSIONAL ENGINEER NO. C 43559 EXP. 6-30-08 CIVIL STATE OF CALIFORNIA DATE <u>1/21/06</u>	
Date Plotted:	
File Name: J:\34092\CADD\Structs\sheet\antonio\pkwy-S-19.dgn	

Border sheet last modified 09-Nov-1999