



NO SCALE



SECTION A-A

NO SCALE



NO SCALE



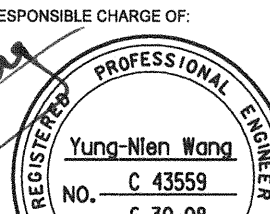


NO SCALE

AS BUILT

PLANS PREPARED BY: **HNTB** Corporation
 200 E. SANDPOINTE AVENUE, SUITE 200
 SANTA ANA, CALIFORNIA 92707
 TEL (714) 460-1600 FAX (714) 460-1610

File Name: J:\34092\CADD\Strc\sheets\antoniojpkwy-S-21.dgn

ORANGE COUNTY RESOURCES & DEVELOPMENT MANAGEMENT DEPT.		
ANTONIO PARKWAY WILDLIFE UNDERCROSSING (WIDEN)		
MARK	DATE	DESCRIPTION
REVISIONS		
PREPARED UNDER RESPONSIBLE CHARGE OF:		
 Yung-Nien Wang REG. C 43559 (EXP. 8-30-08) CIVIL DATE <u>10/31/06</u>		
DESIGNED <u>J. WANG</u> DRAWN <u>N. MORALES</u> SCALE _____ AS SHOWN CHECKED <u>E. WANG</u> DATE <u>9/19/06</u> DRAWING NO. _____		
		SHEET 62 OF 72