


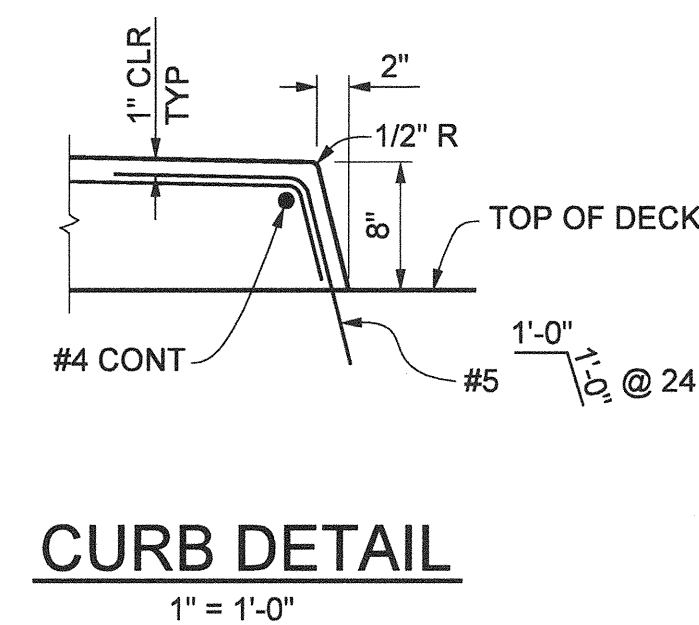

CORRECTION BY: MN
CONTRACT NO.: ER28121
DATE: 12/30/2009

3 inches on original drawing

		ORANGE COUNTY RESOURCES & DEVELOPMENT MANAGEMENT DEPT.	
MARK	DATE	ANTONIO PARKWAY WILDLIFE UNDERCROSSING (WIDEN)	
REVISIONS		CONCRETE BARRIER DETAILS	
PREPARED UNDER RESPONSIBLE CHARGE OF:		DESIGNED <u>J. WANG</u>	
Yung-Nian Wang No. C 43559 Exp. 6-30-08 CIVIL STATE OF CALIFORNIA		DRAWN <u>J. A. WANG</u>	
Yung-Nian Wang RCF C 43559 (EXP. 6-30-08)		CHECKED <u>F. JEANG</u>	
DATE		SCALE AS SHOWN	DATE 9/19/06
131/06		DRAWING NO.	
		OF 72	

PLANS PREPARED BY:

HNTB

HNTB Corporation
200 E. SANDPOINTE AVENUE, SUITE 200
SANTA ANA, CALIFORNIA 92707
TEL (714) 460-1600 FAX (714) 460-1610

Date Plotted:

File Name: J:\34092\CADD\Strc\sheets\antonio.pkwy-S-22.dgn

Border sheet last modified 09-Nov-1999