




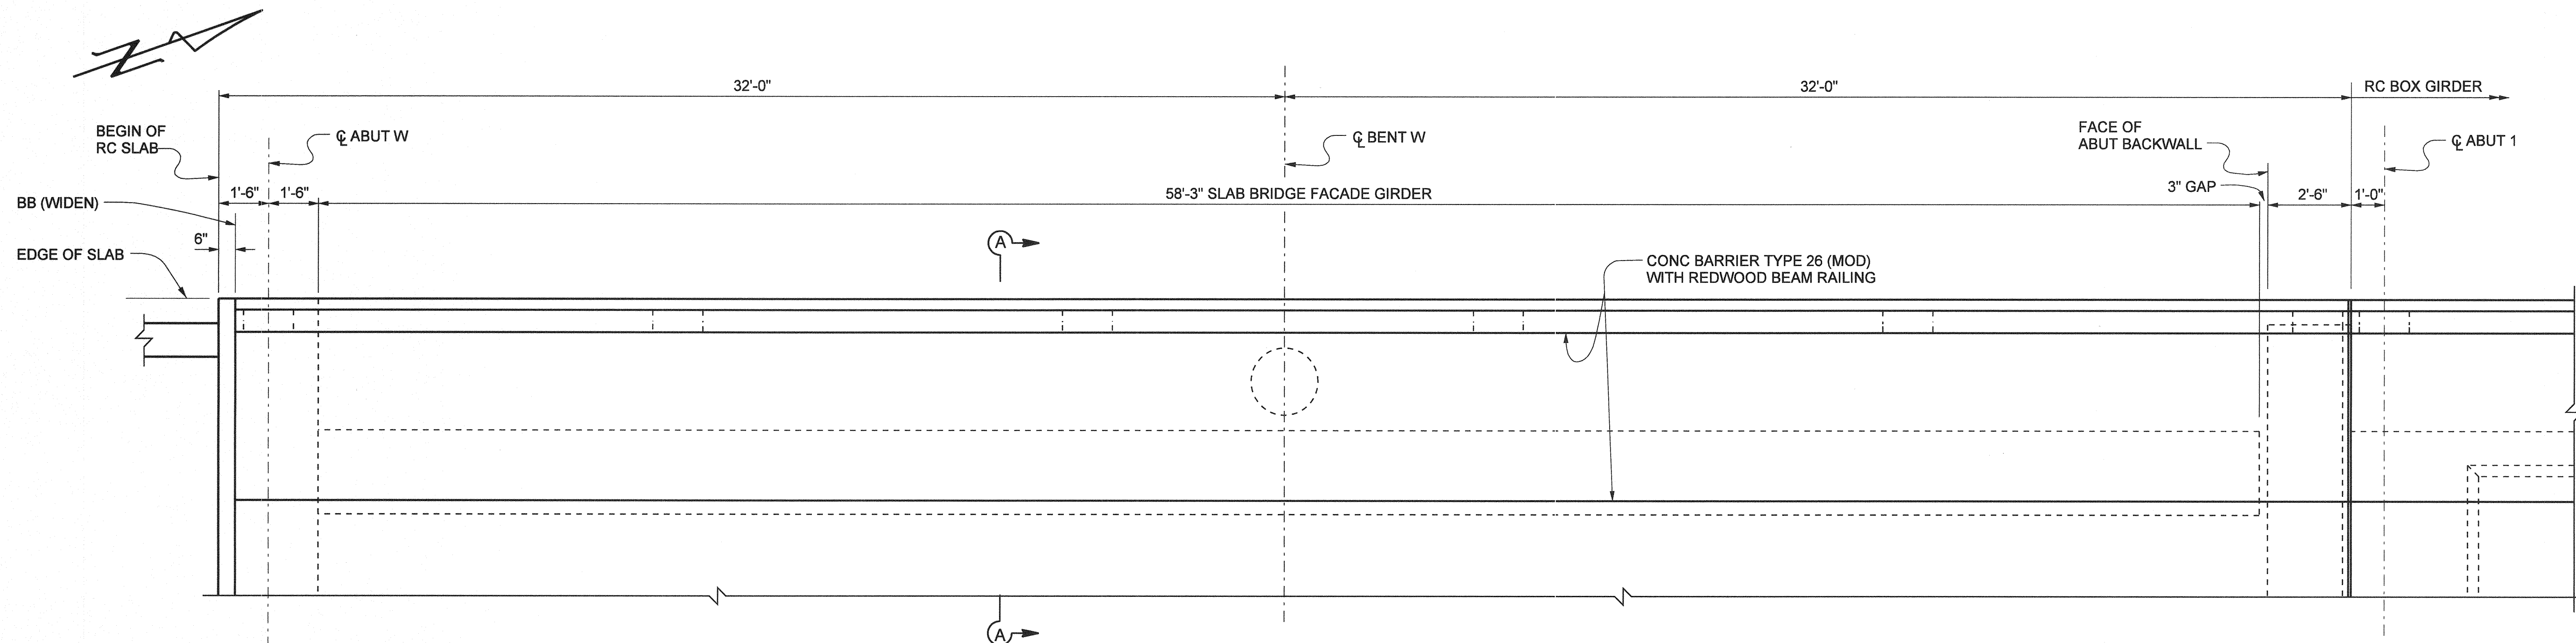


FACADE GIRDER LAYOUT
3/8" = 1'-0"

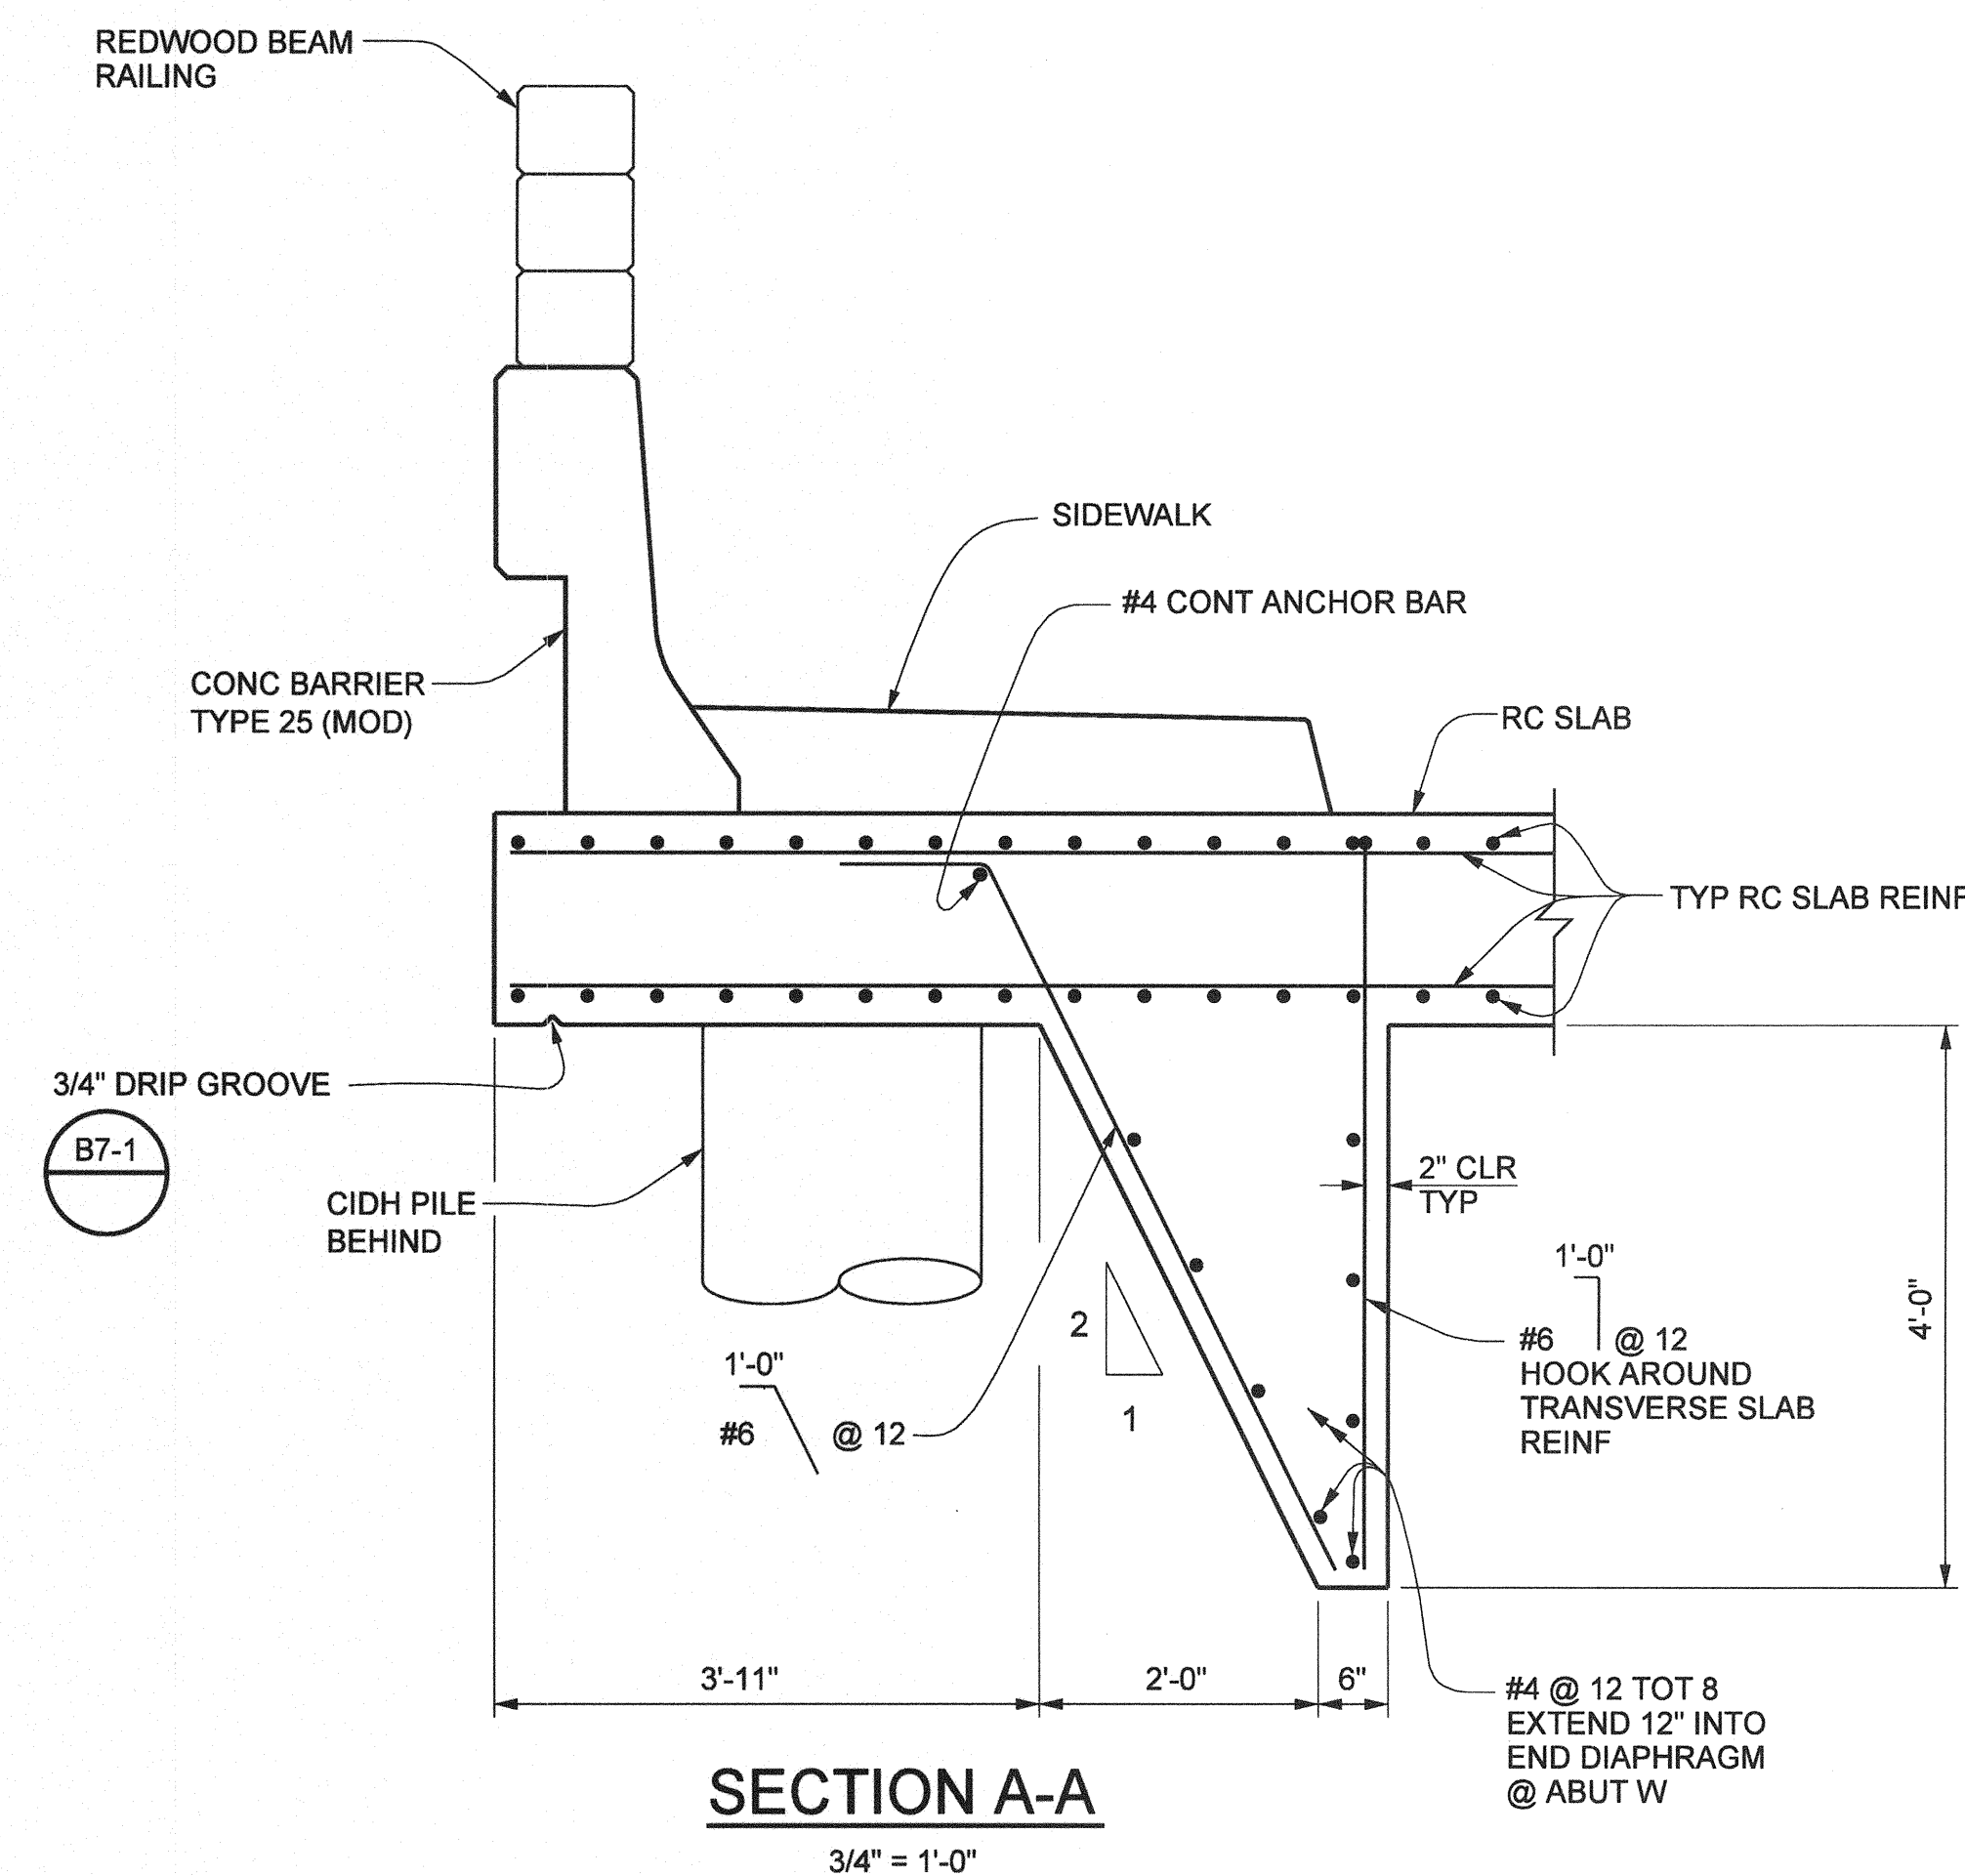

SECTION A-A
3/4" = 1'-0"

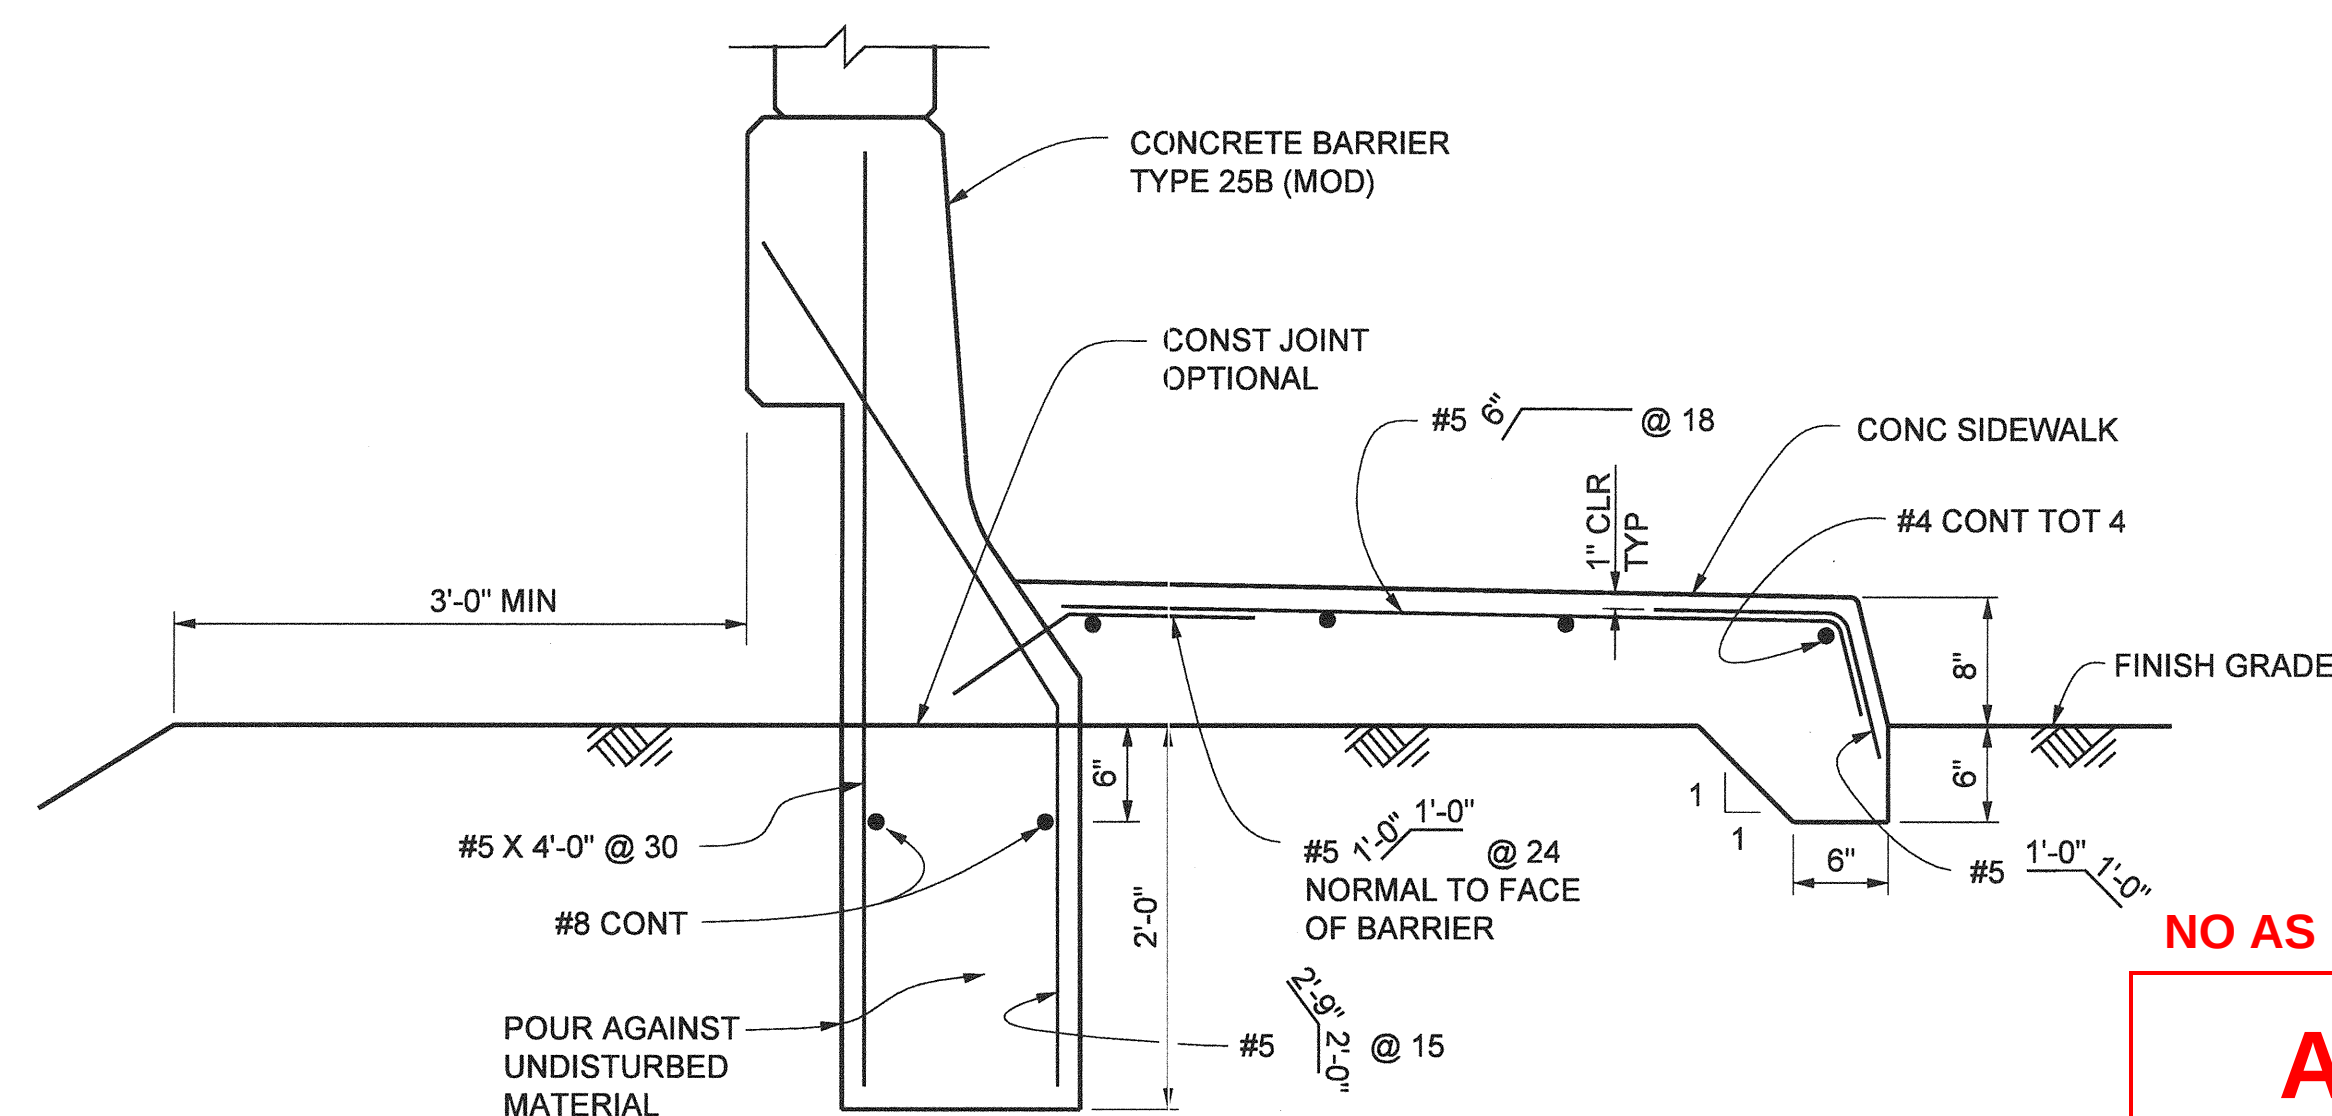

SECTION B-B
1" = 1'-0"

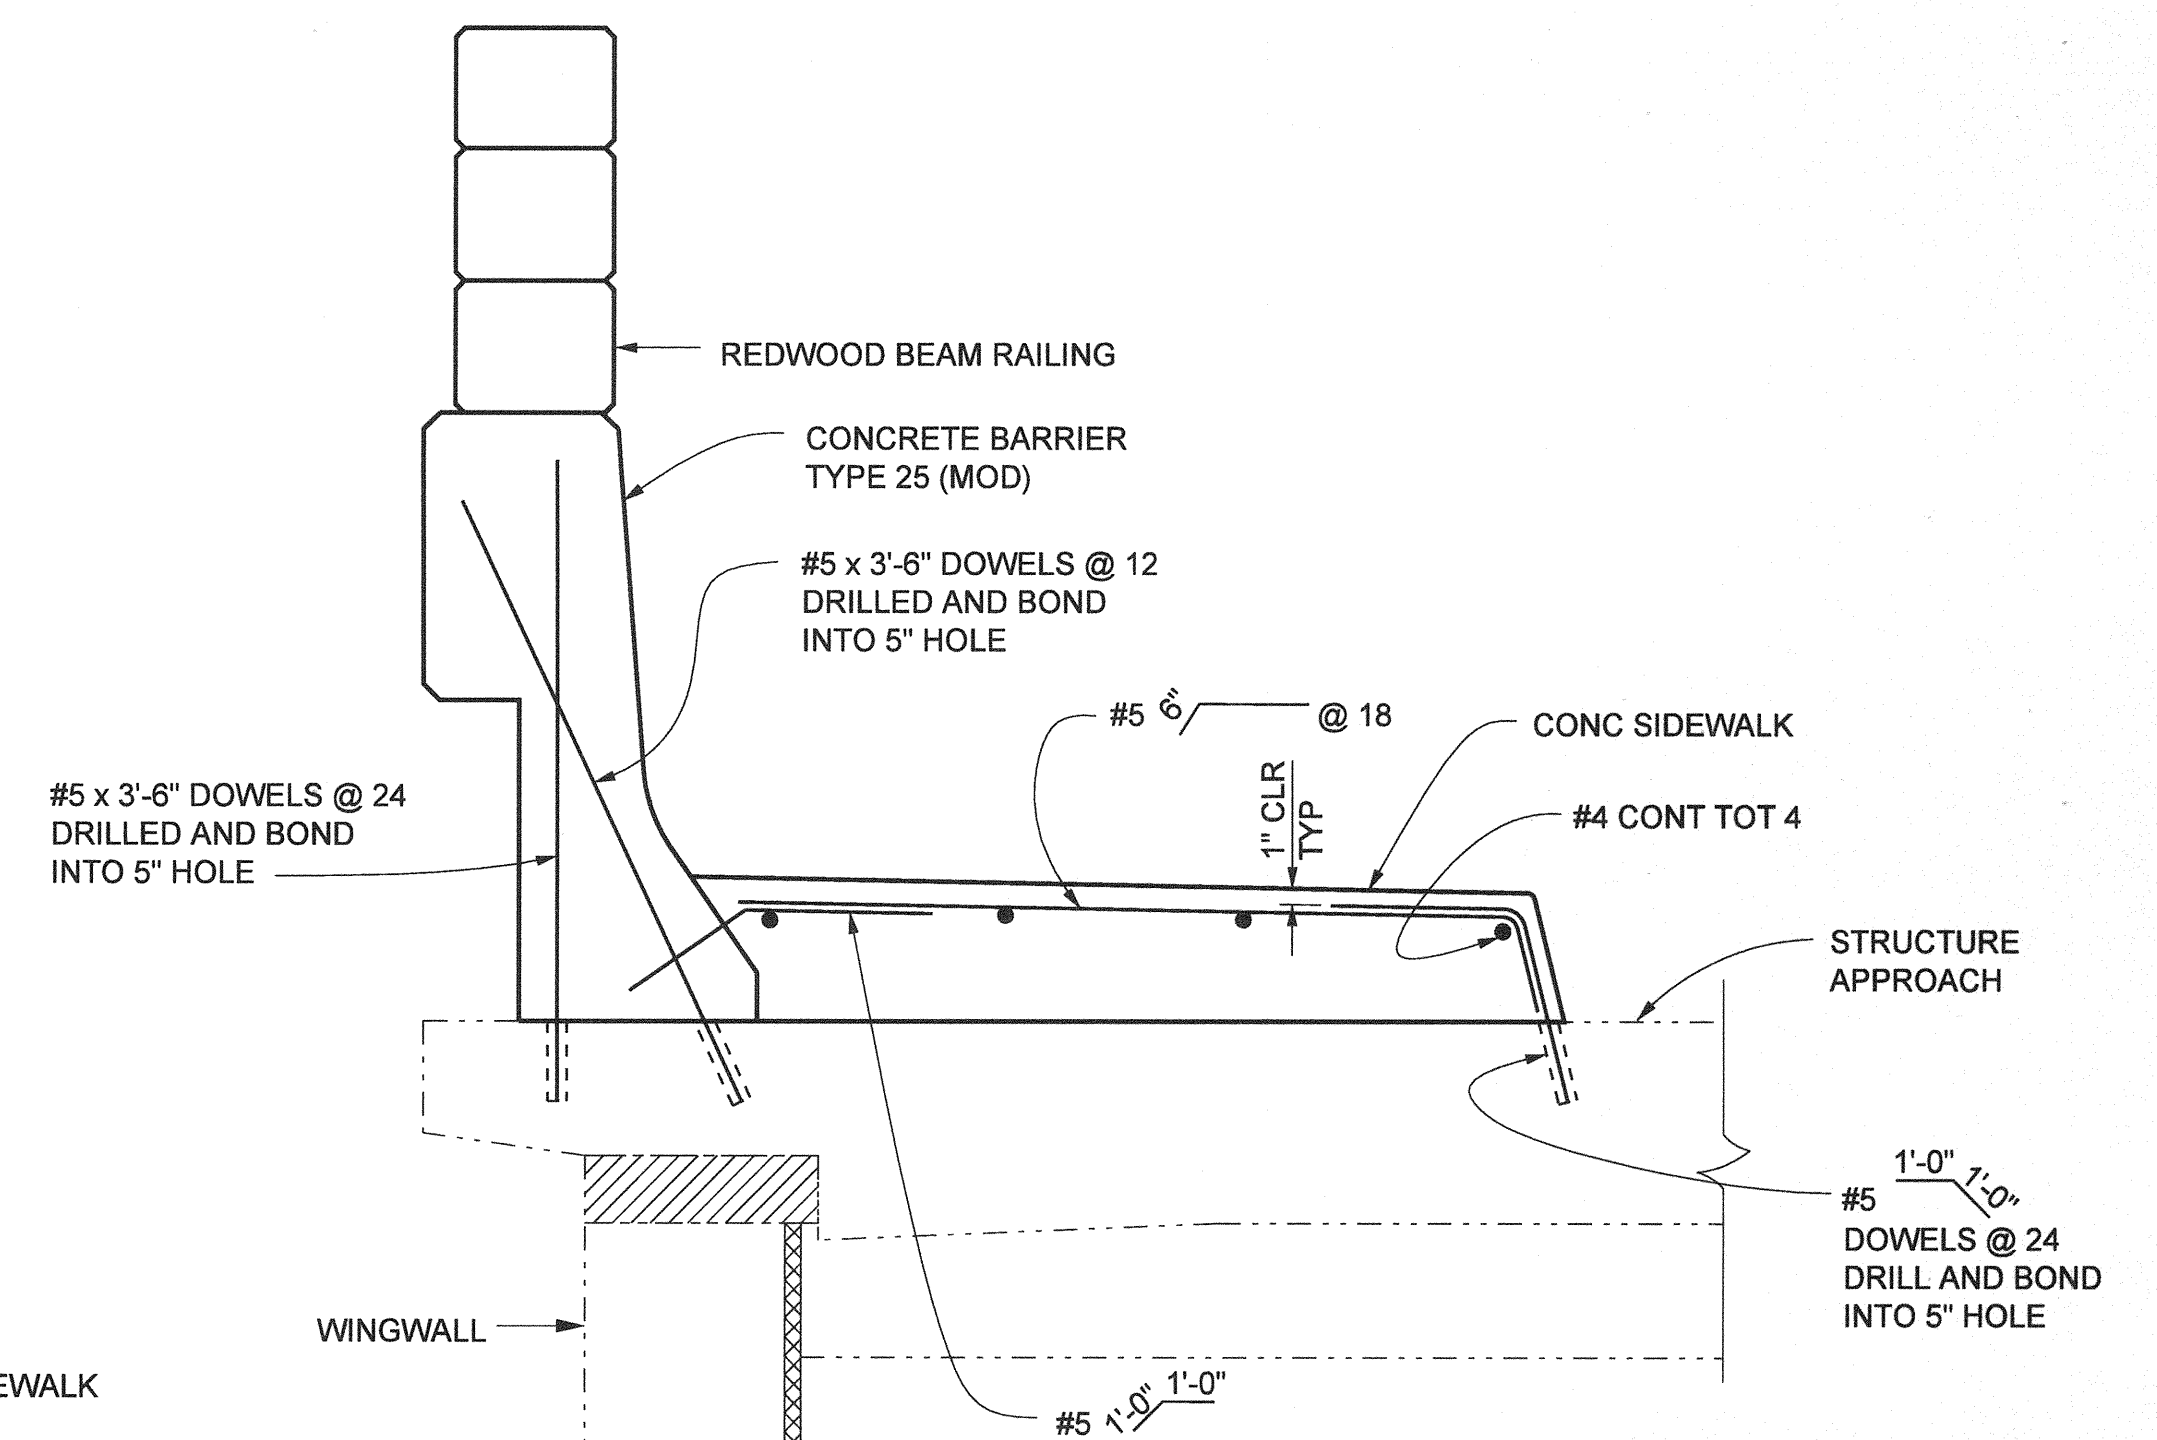

SECTION C-C
1" = 1'-0"

- NOTES:**
1. THE CONTRACTOR SHALL VERIFY ALL CONTROLLING FIELD DIMENSIONS BEFORE ORDERING OR FABRICATING ANY MATERIAL.
 2. FOR LOCATION OF SECTION B-B AND C-C, SEE "SIDEWALK DETAIL" SHEET.

NO AS BUILT CHANGES

AS BUILT

CORRECTION BY: MN

CONTRACT NO.: ER28121

DATE: 12/30/2009

PLANS PREPARED BY:
HNTB
HNTB Corporation
200 E. SANDPOINTE AVENUE, SUITE 200
SANTA ANA, CALIFORNIA 92707
TEL (714) 460-1600 FAX (714) 460-1610

ORANGE COUNTY RESOURCES & DEVELOPMENT MANAGEMENT DEPT		ANTONIO PARKWAY WILDLIFE UNDERCROSSING (WIDEN)	
FACADE GIRDER DETAILS			
DESIGNED: <u>J. WANG</u>	CHECKED: <u>F. JEANG</u>	SHEET 68 OF 72	
DRAWN: <u>N. MORALES</u>	DATE: <u>9/19/06</u>	DRAWING NO.	
SCALE: <u>AS SHOWN</u>	DATE: <u>9/19/06</u>	DRAWING NO.	

PREPARED UNDER RESPONSIBLE CHARGE OF:
Yung-Nien Wang
No. C 43559
EXP. 6-30-08
CIVIL
STATE OF CALIFORNIA
12/31/06
Yung-Nien Wang
RCE C 43559 (EXP. 6-30-08)

Date Plotted:

File Name: J:\34092\CADD\Sto\sheet\antonio\pkwy-S-27.dgn

Border sheet last modified 08-Nov-1999