
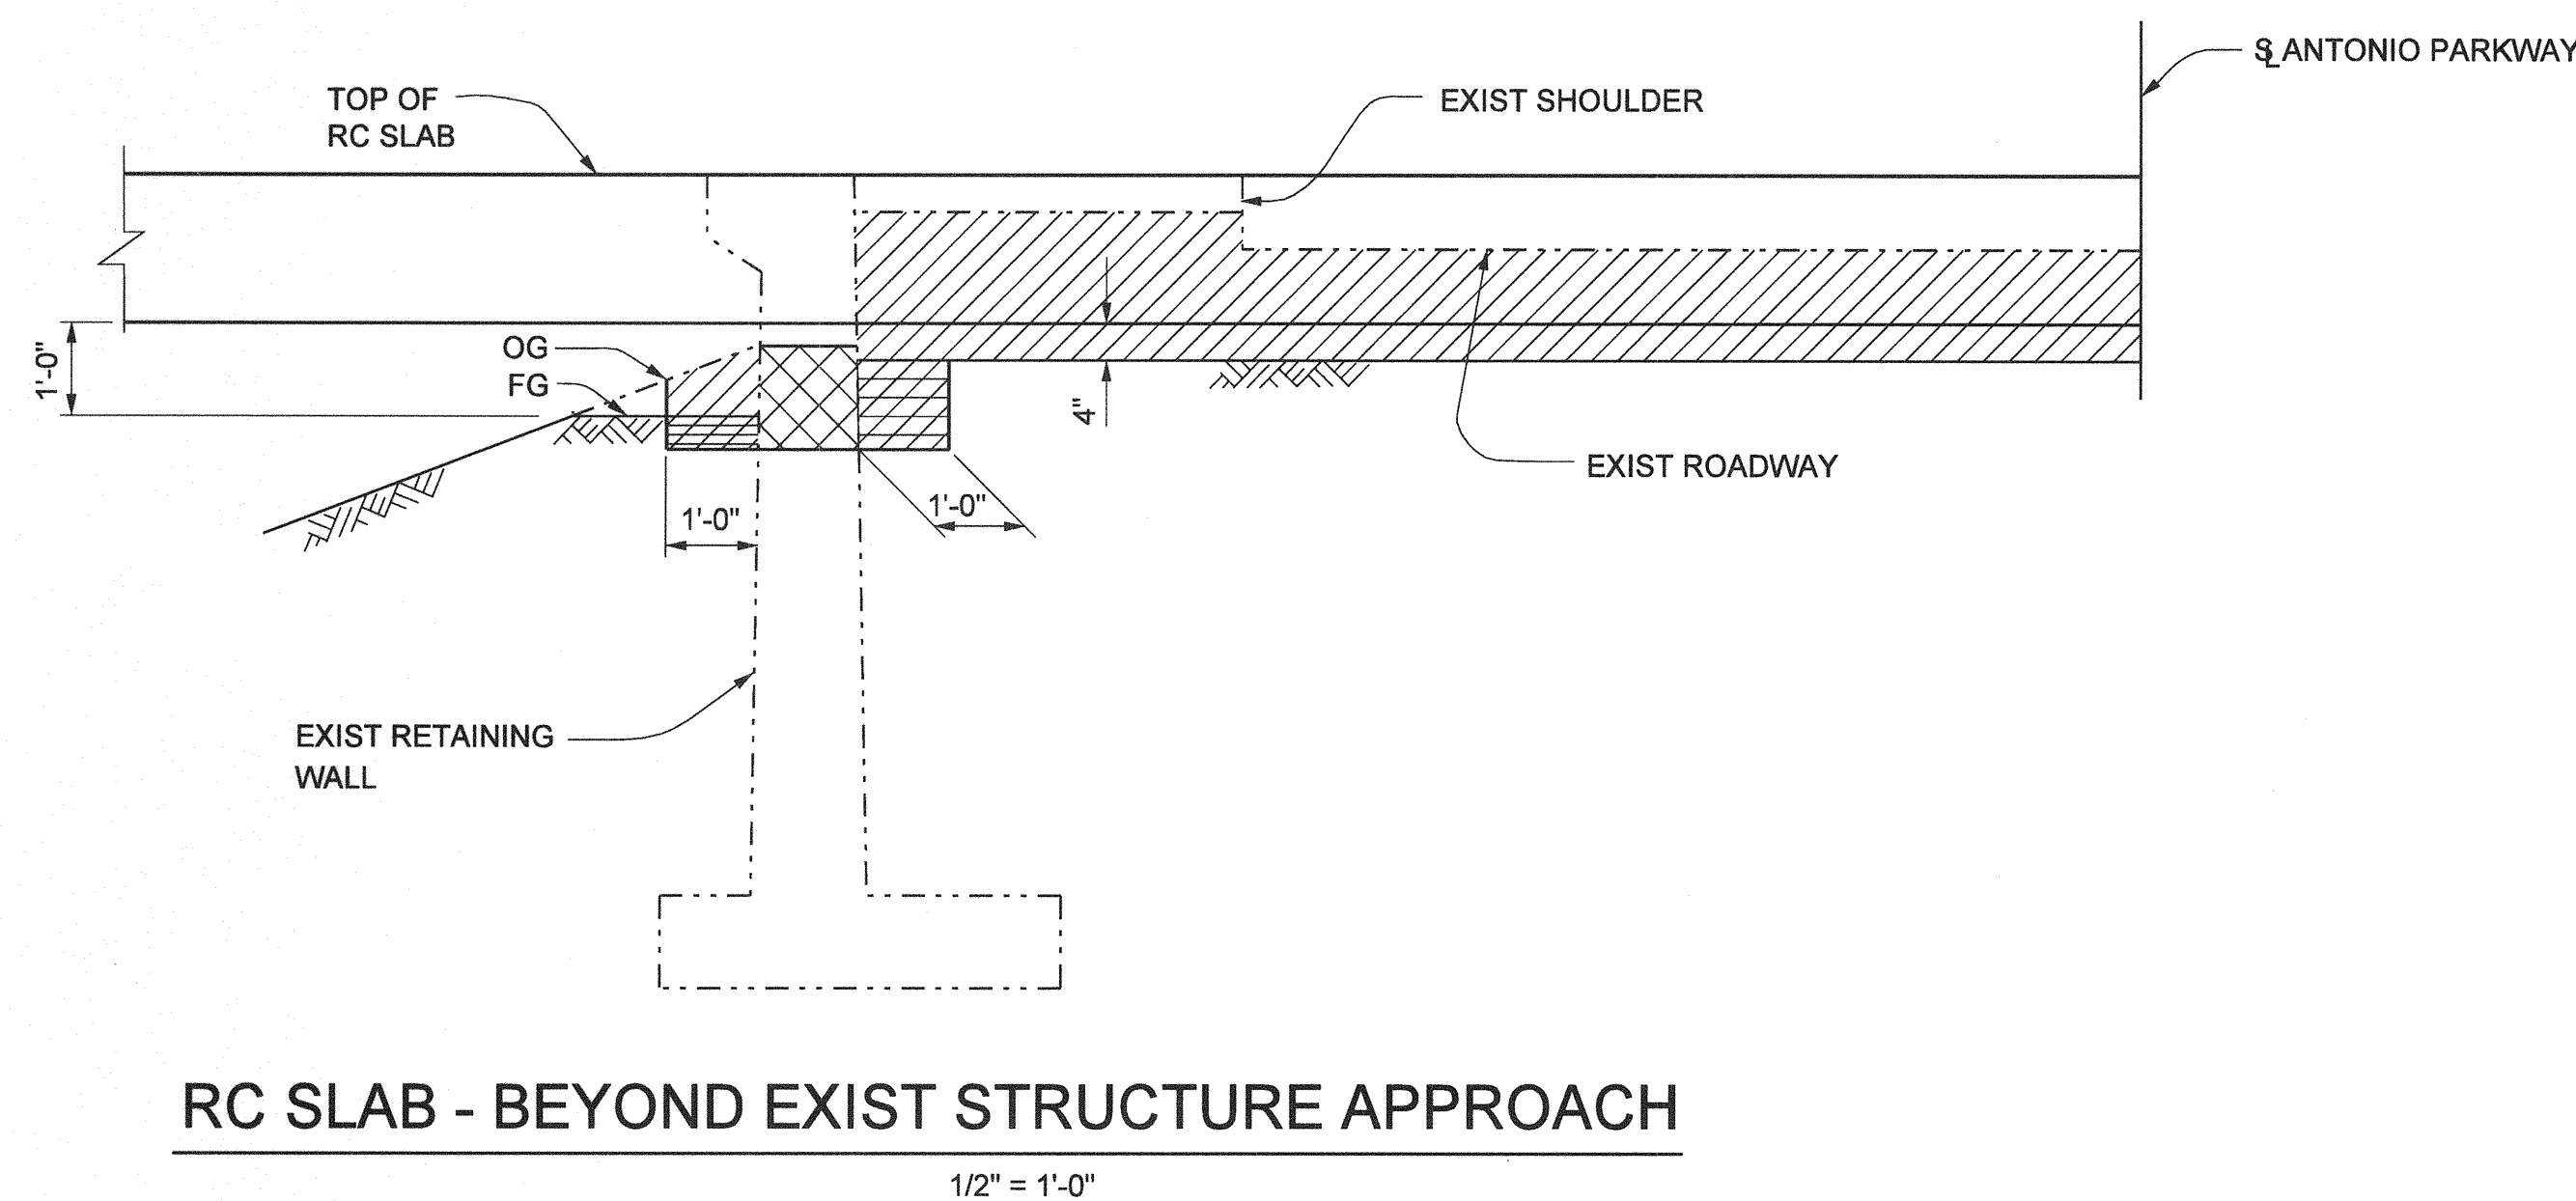
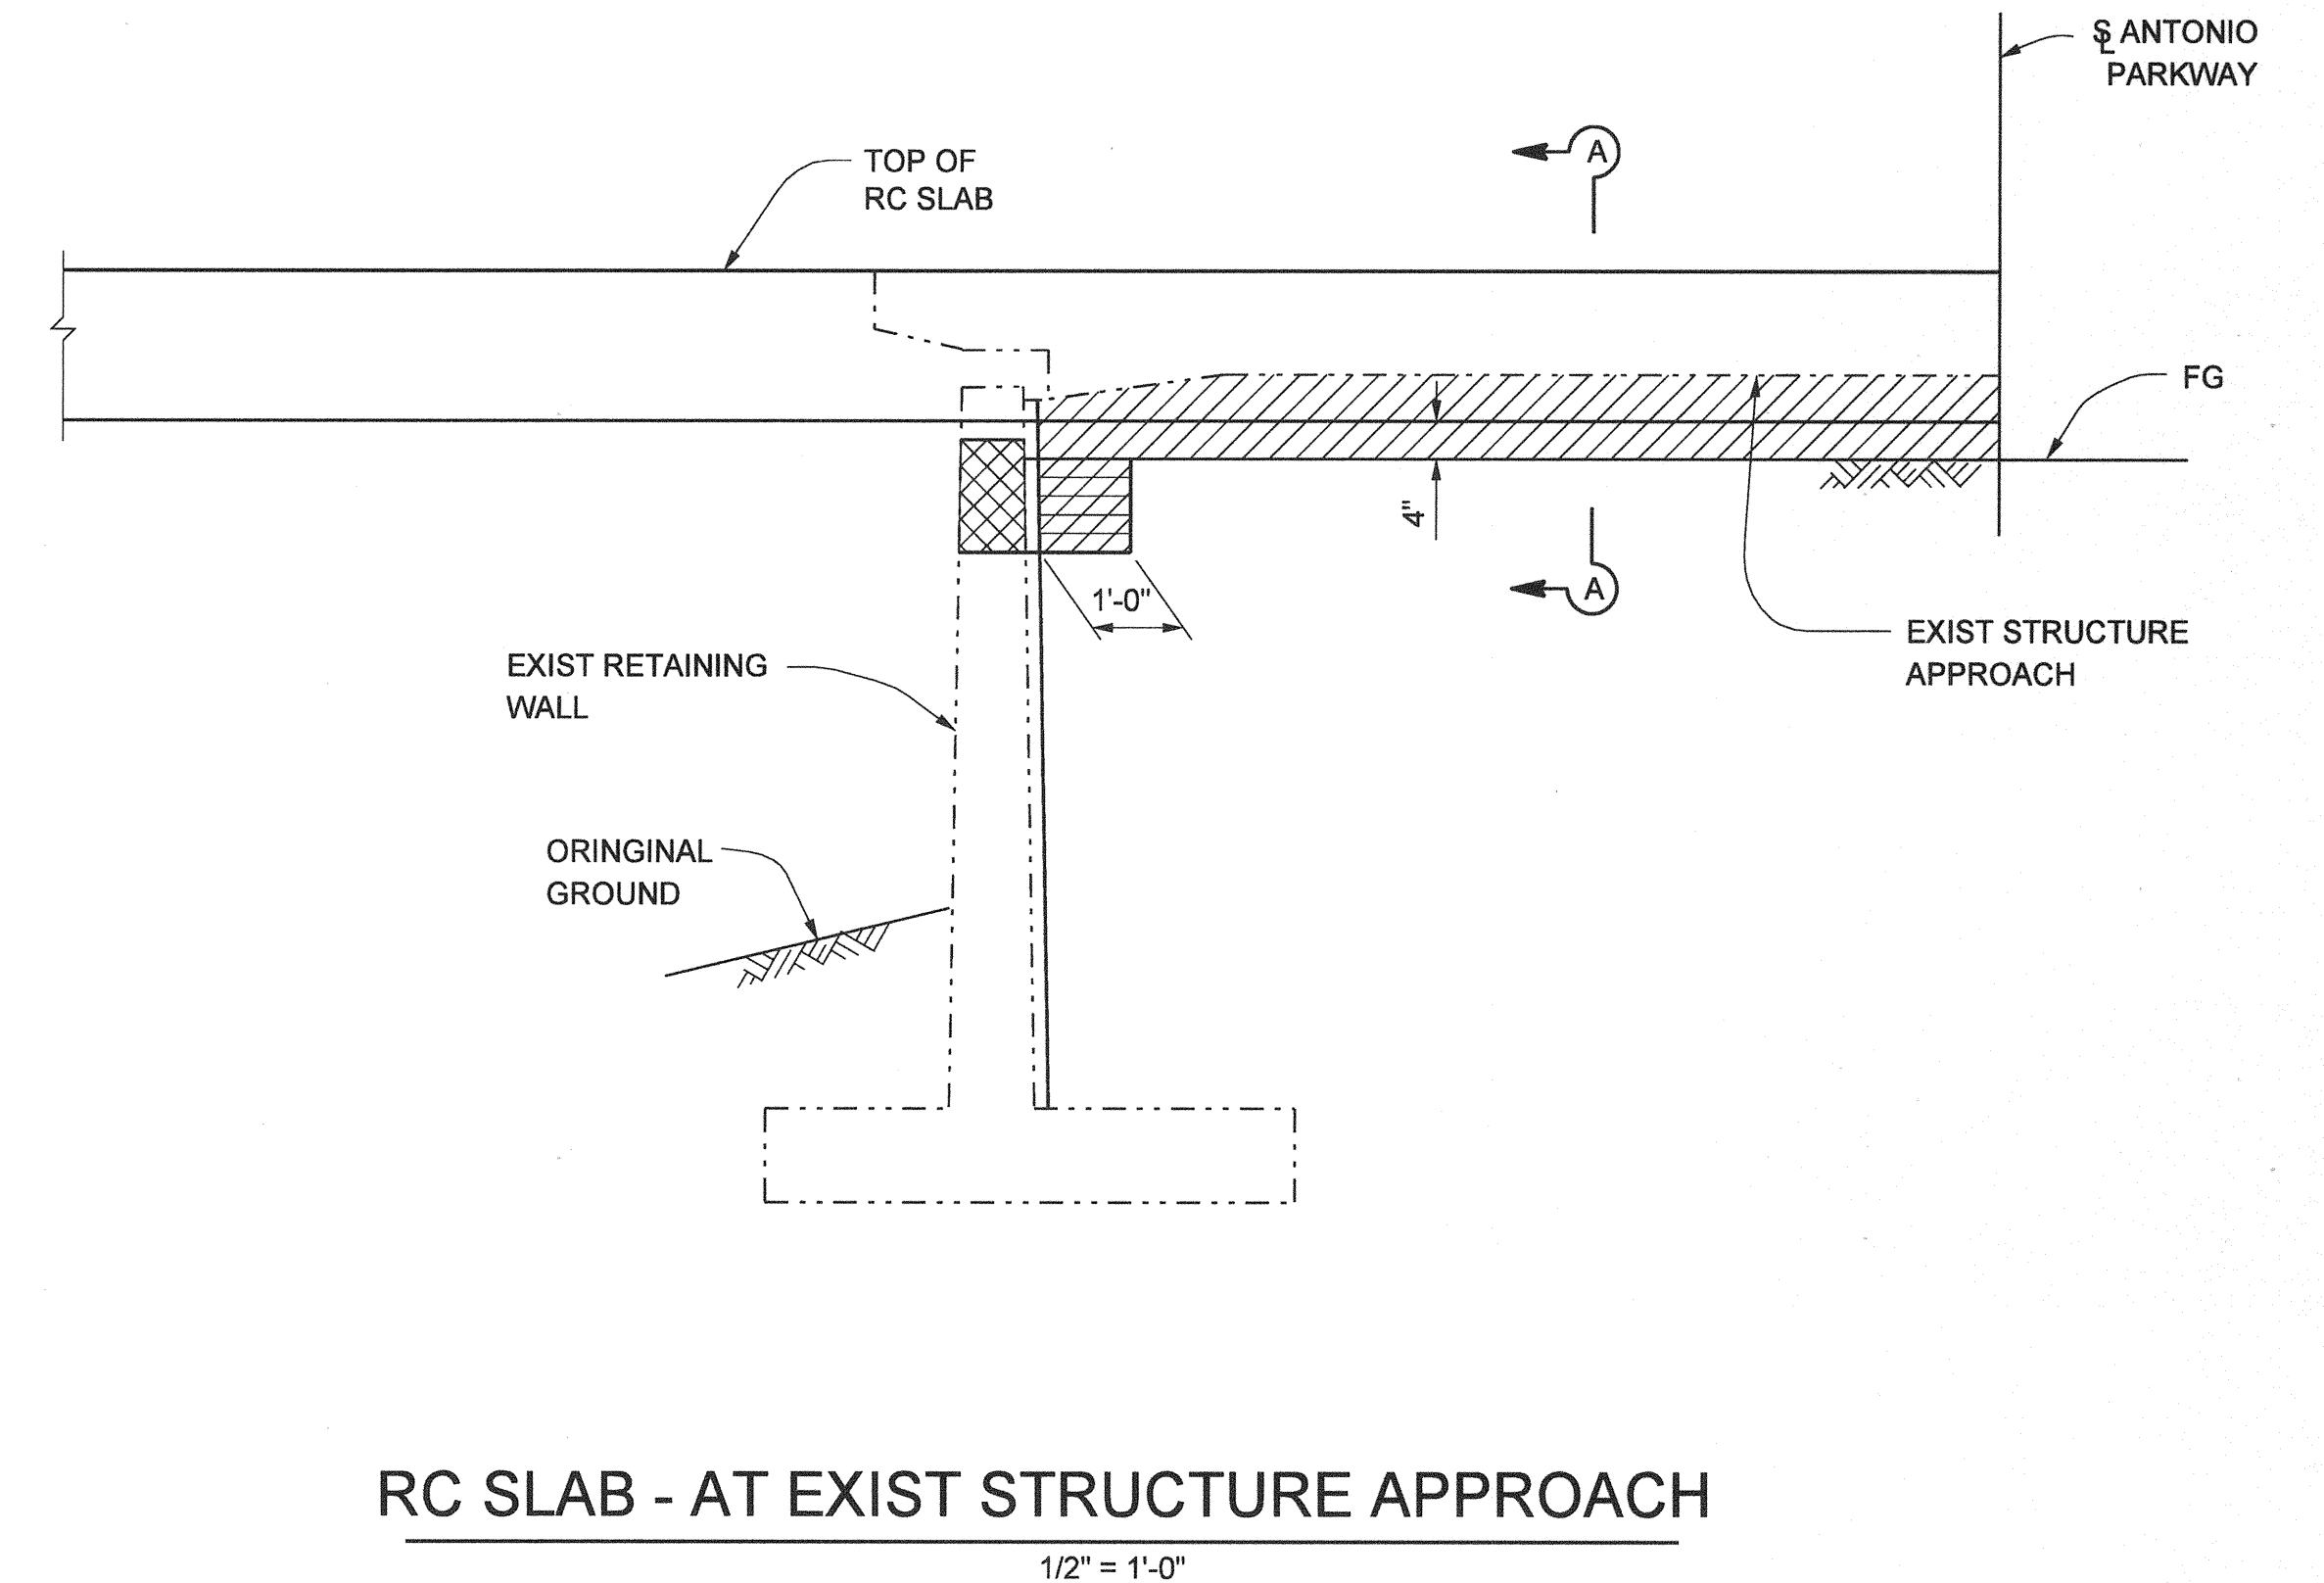
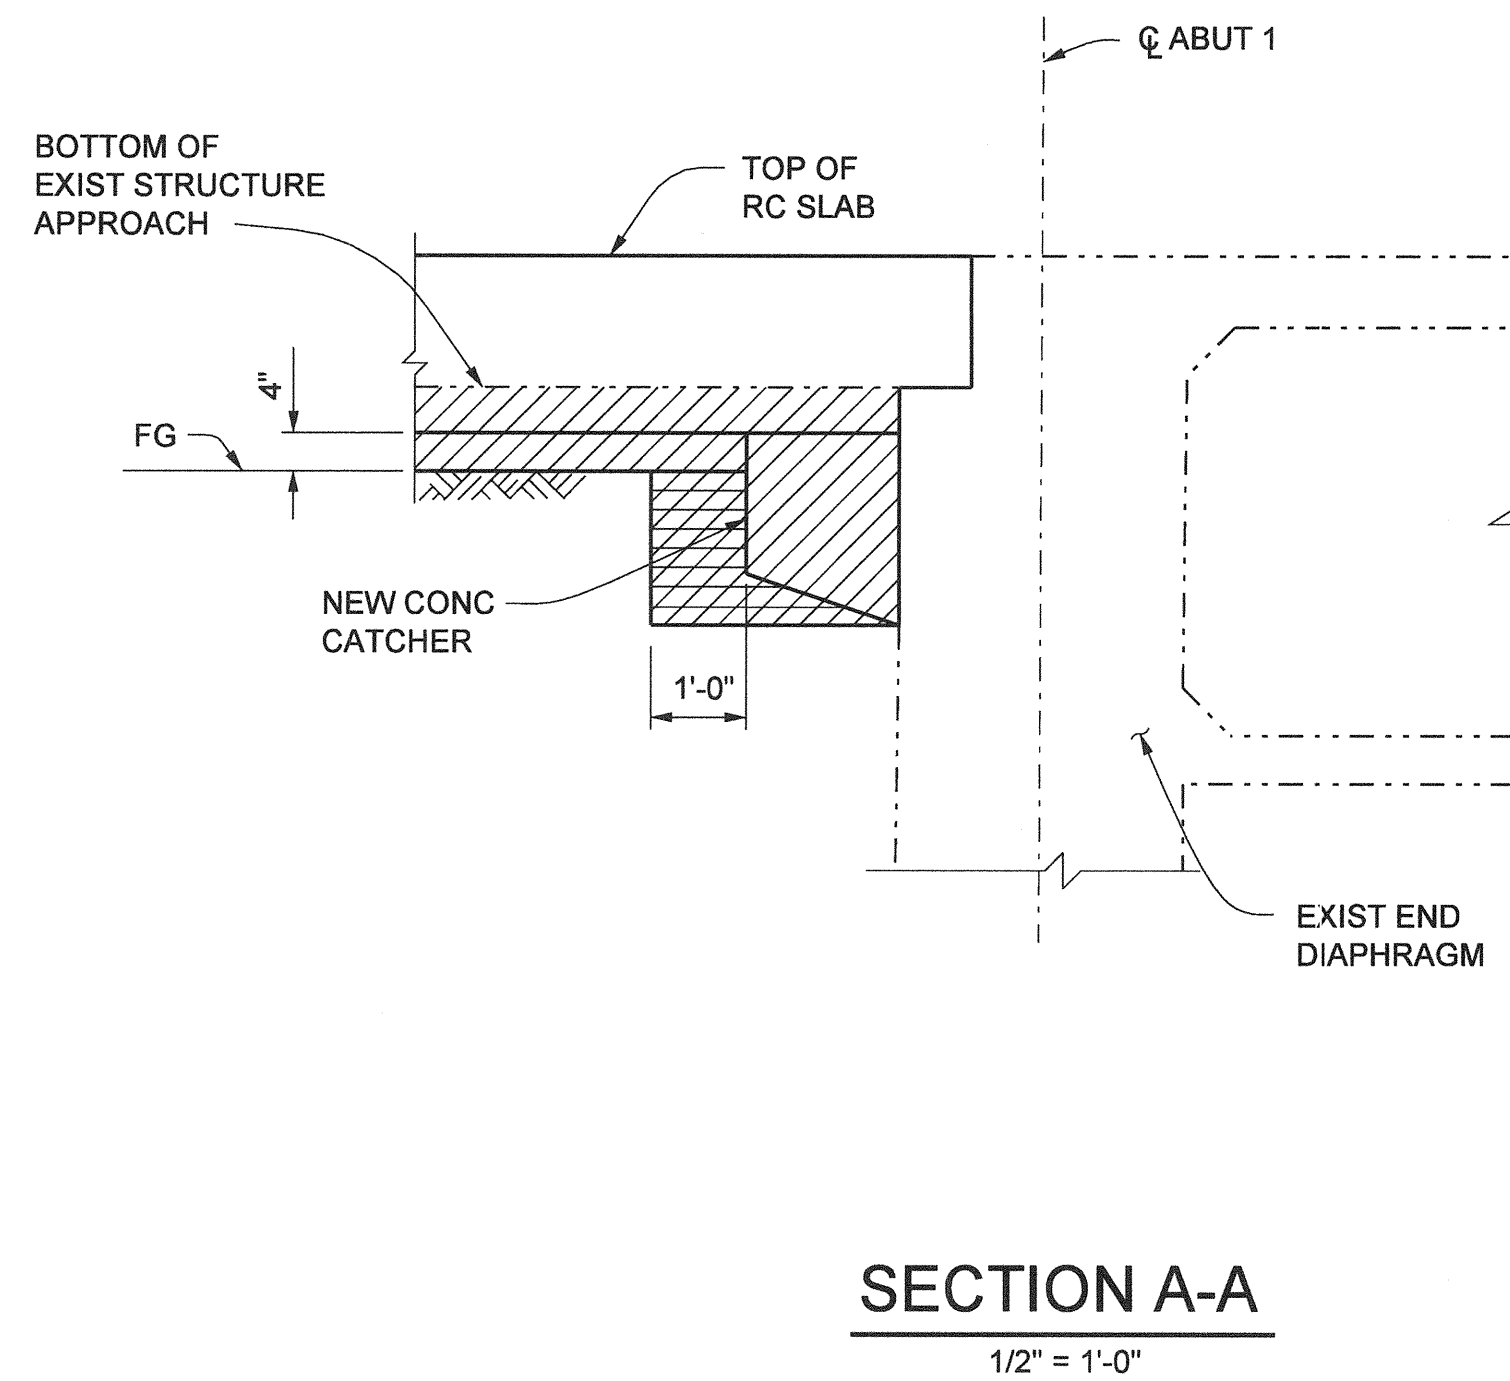


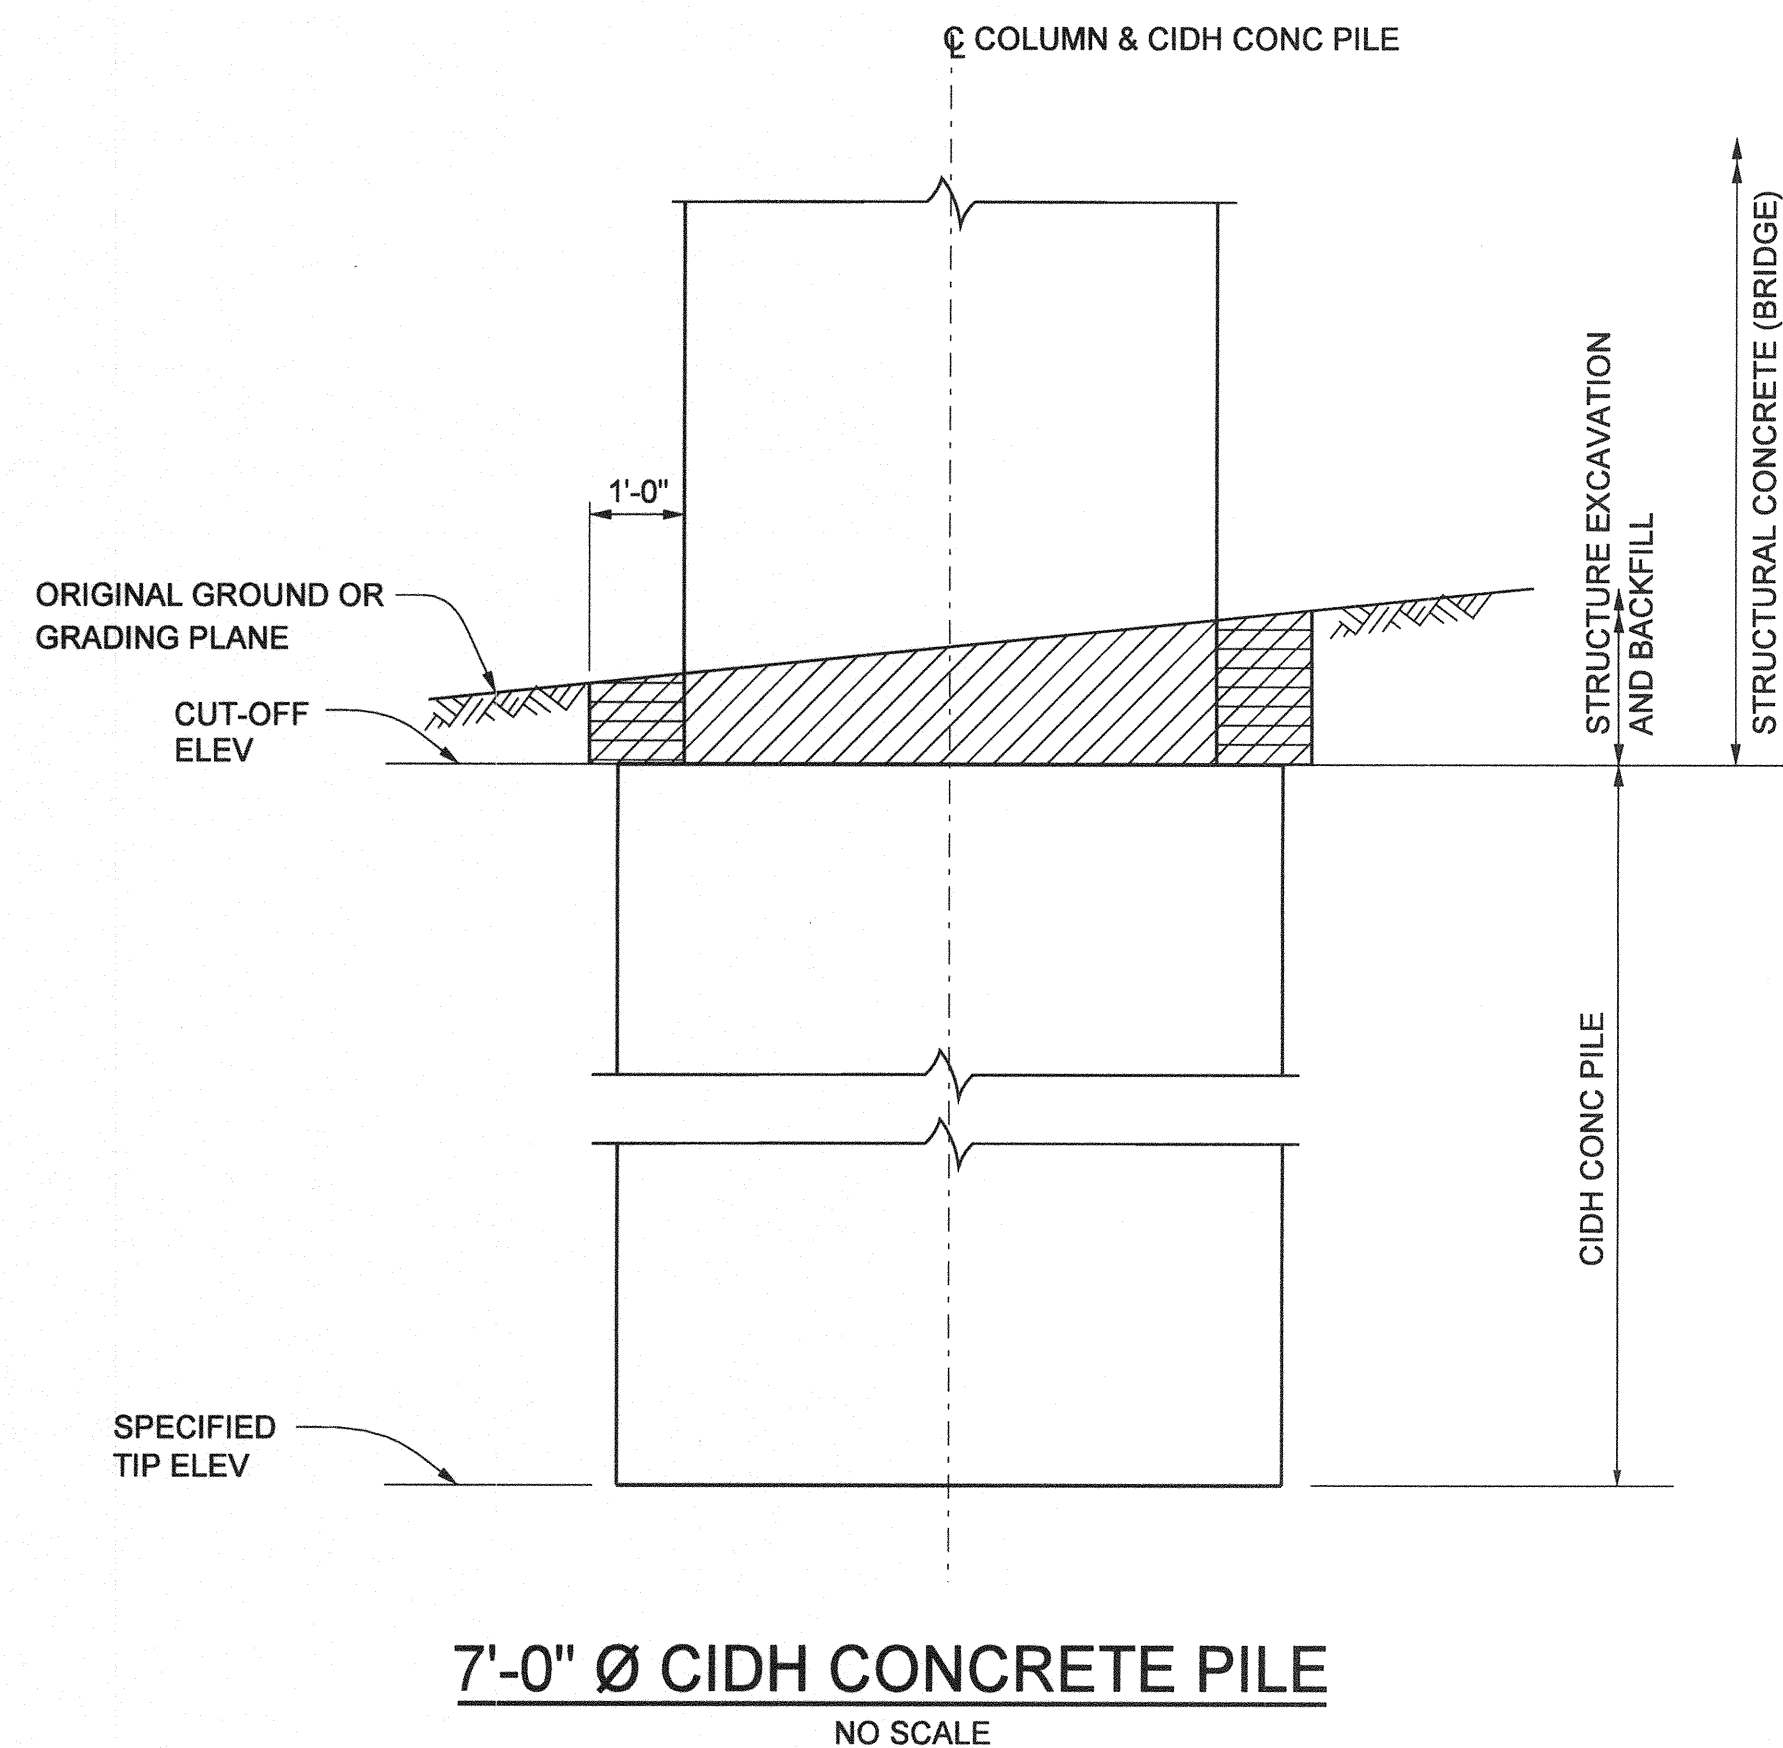

LEGEND

-----	DENOTES EXISTING STRUCTURE
————	DENOTES NEW STRUCTURE
	STRUCTURE EXCAVATION
	STRUCTURE BACKFILL
	REMOVE & REPLACE CONCRETE

NO AS BUILT CHANGES

AS BUILT

CORRECTION BY: MN
 CONTRACT NO.: ER28121
 DATE: 12/30/2009

NOTES:

1. THE CONTRACTOR SHALL VERIFY ALL CONTROLLING FIELD DIMENSIONS BEFORE ORDERING OR FABRICATING ANY MATERIAL.
2. SEE "ISOLATION CASING DETAILS" SHEET AND CALTRANS STANDARD PLAN A62C FOR OTHER LIMIT FOR STRUCTUA EXCAVATION AND BACKFILL.

PLANS PREPARED BY:
HNTB
 HNTB Corporation
 200 E. SANDPOINTE AVENUE, SUITE 200
 SANTA ANA, CALIFORNIA 92707
 TEL (714) 460-1600 FAX (714) 460-1610

ORANGE COUNTY RESOURCES & DEVELOPMENT MANAGEMENT DEPT		ANTONIO PARKWAY WILDLIFE UNDERCROSSING (WIDEN)	
LIMIT FOR STRUCTURAL EXCAVATION AND BACKFILL			
DESIGNED <u>J. WANG</u>	DRAWN <u>J. WANG</u>		CHECKED <u>E. JEANG</u>
DATE <u>9/19/06</u>		DATE <u>9/19/06</u>	
SCALE <u>AS SHOWN</u>	DATE <u>9/19/06</u>	DRAWING NO. <u>69</u>	
SHEET <u>69</u>		OF 72	

Date Plotted:

File Name: J:\34092\CADD\Struct\sheet\antonio\pkwy-S-28.dgn

Border sheet last modified 09-Nov-1999