



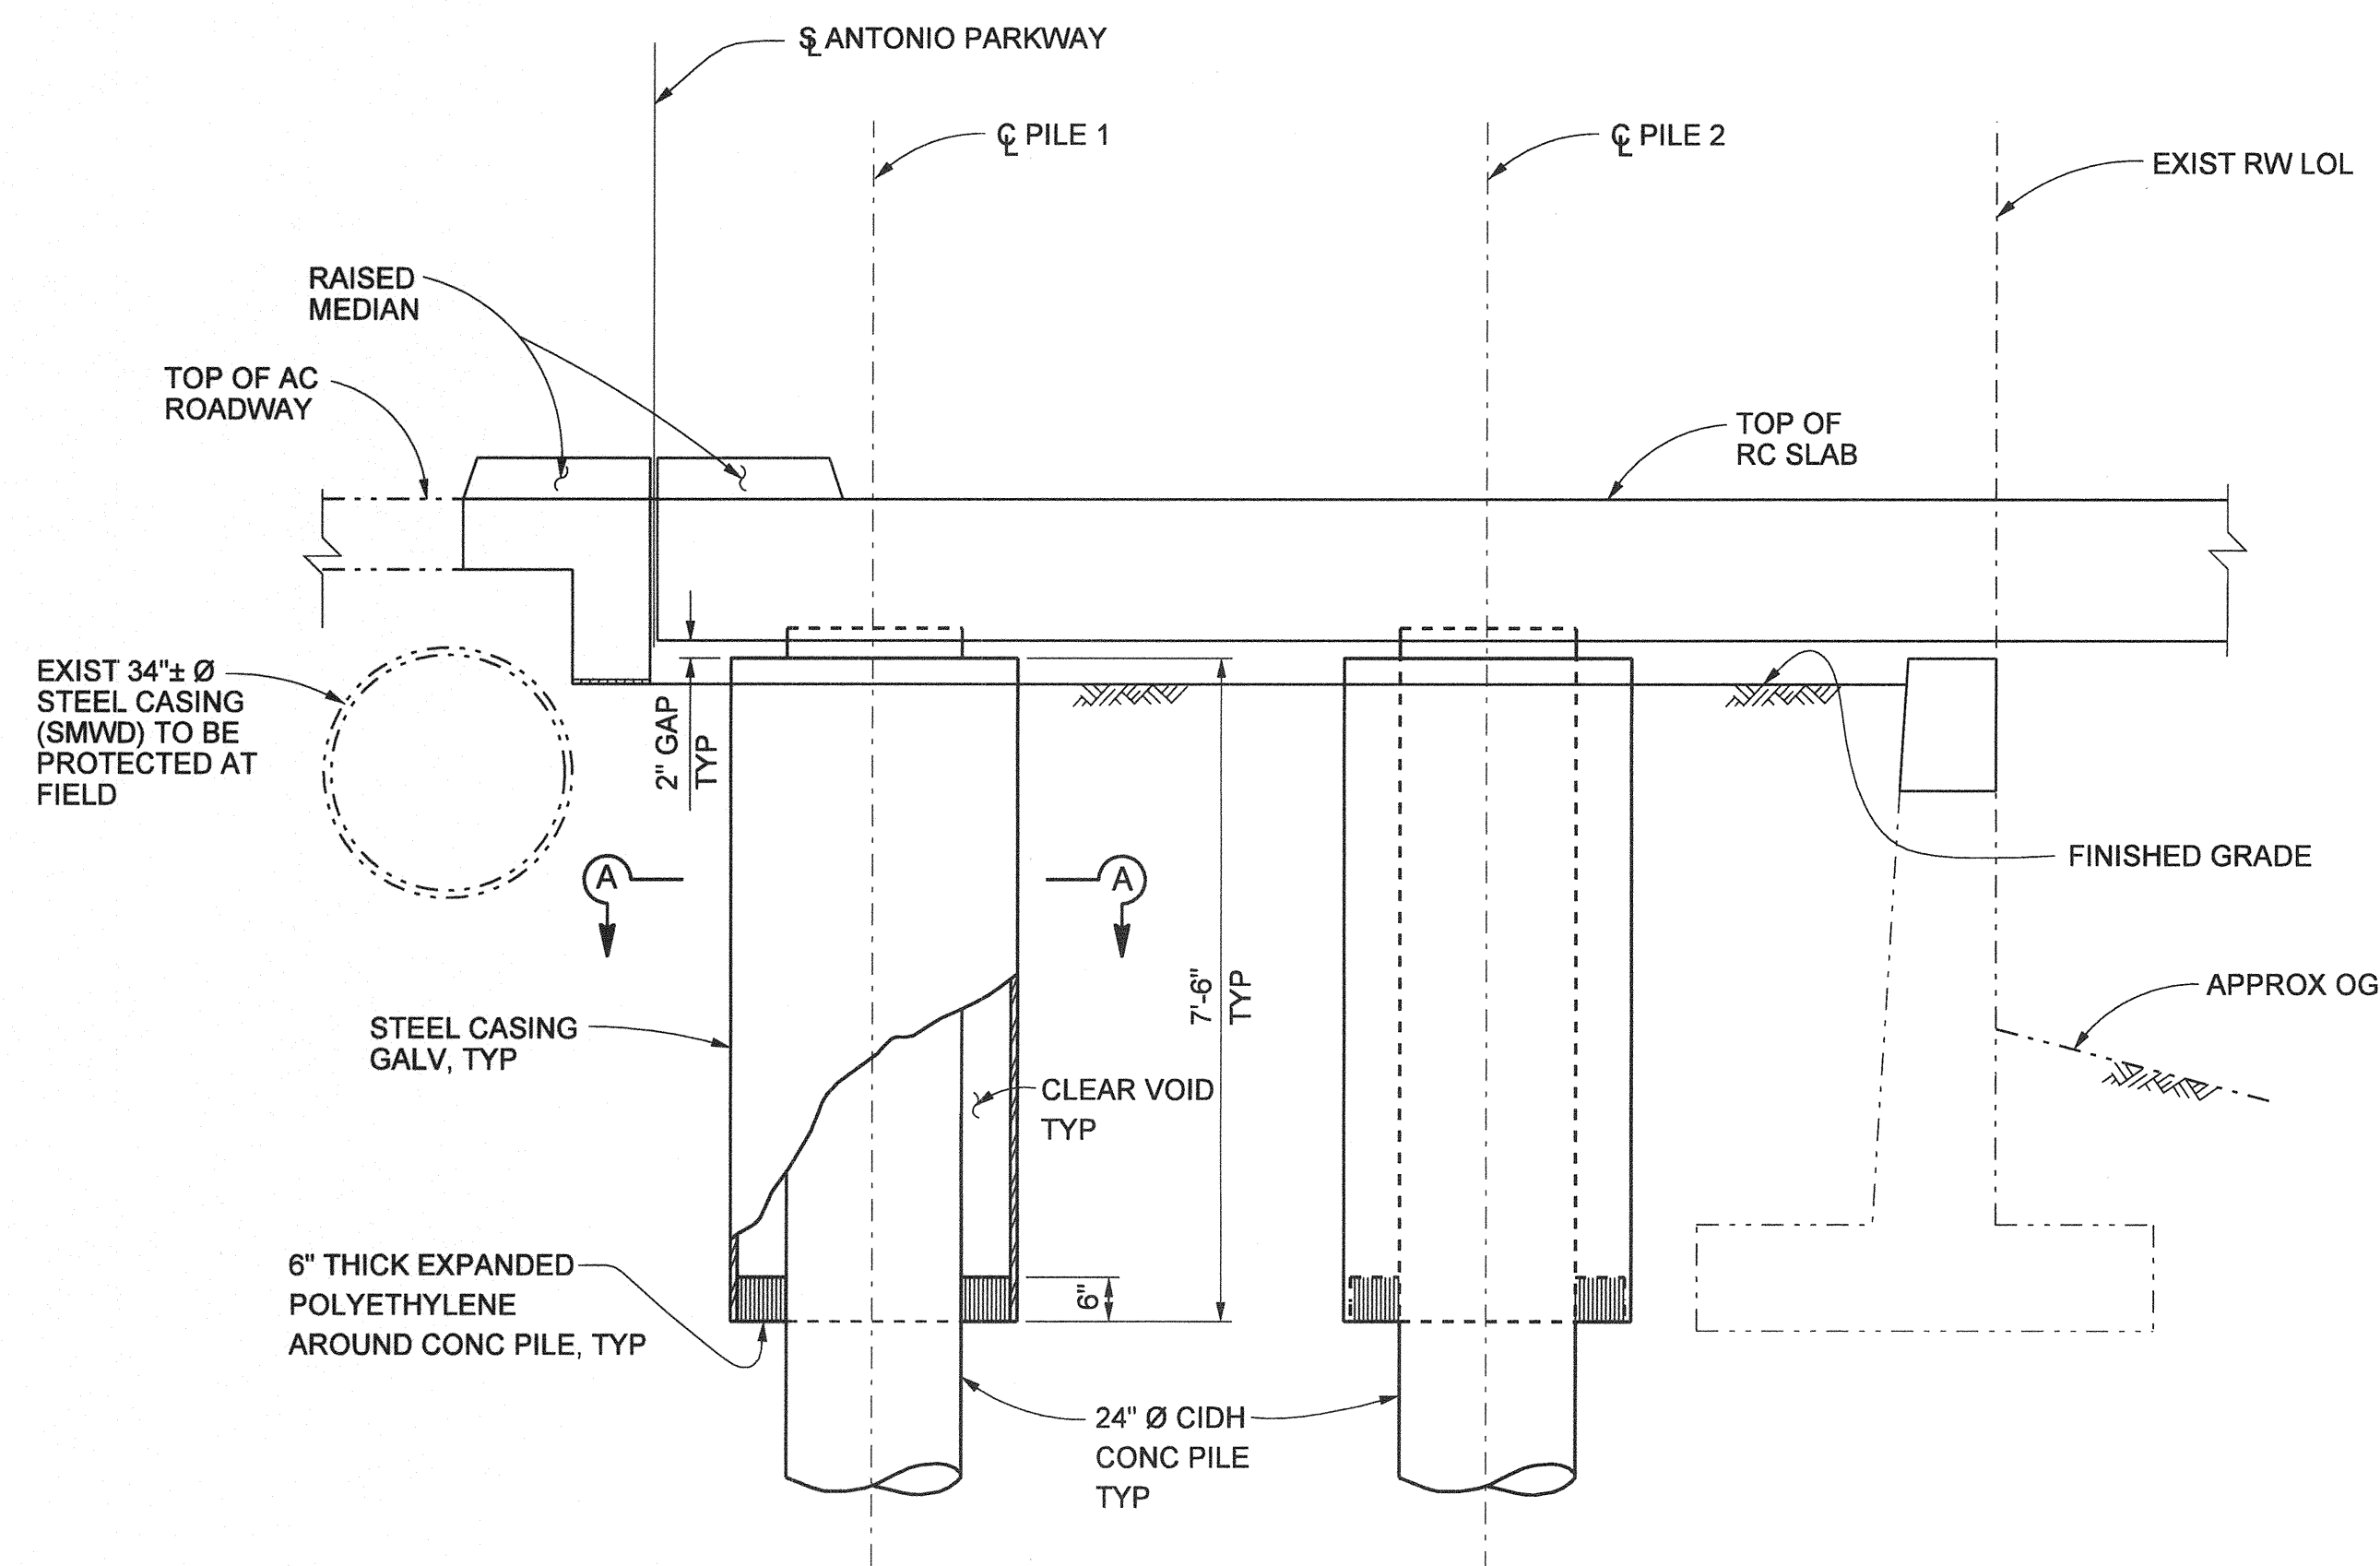


ELEVATION
1/2" = 1'-0"

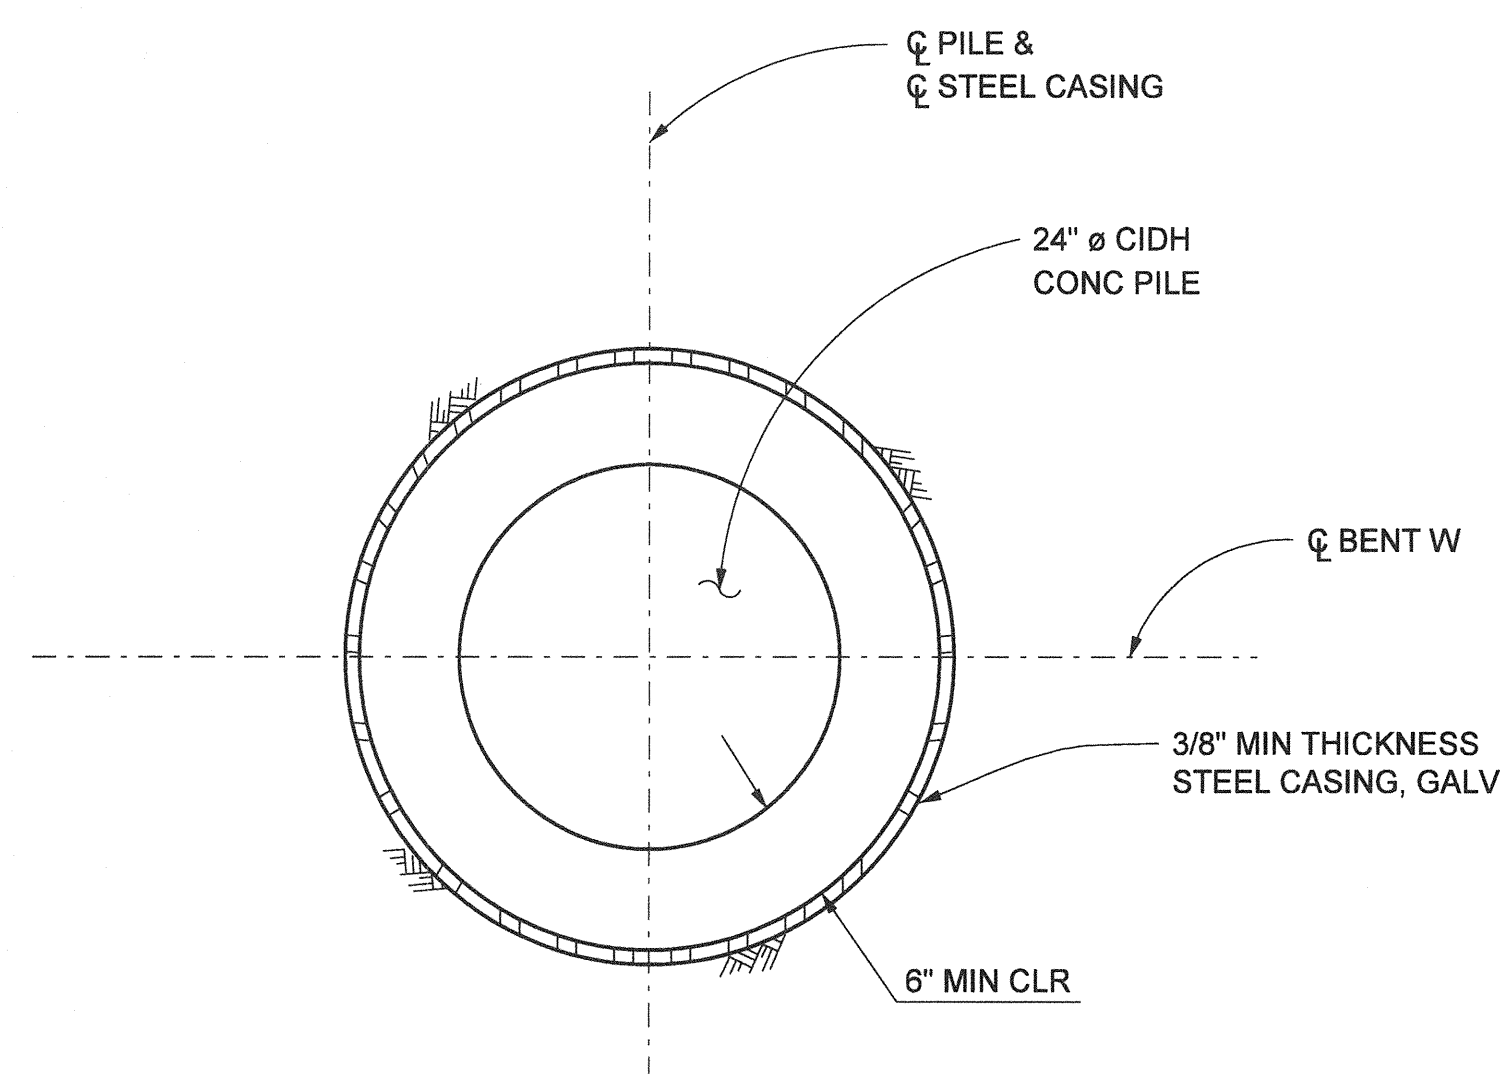


SECTION A-A
1" = 1'-0"

NOTES:

1. THE CONTRACTORS SHALL VERIFY ALL CONTROLLING FIELD DIMENSIONS BEFORE ORDERING OR FABRICATING ANY MATERIALS.
2. SEE "LIMIT FOR STRUCTURAL EXCAVATION AND BACKFILL" SHEET AND CALTRANS STANDARD PLAN A62C FOR OTHER LIMIT FOR STRUCTURAL EXCAVATION AND BACKFILL.
3. SEE "BENT W AND 24" Ø PILE DETAILS" SHEET FOR PILE LAYOUT.

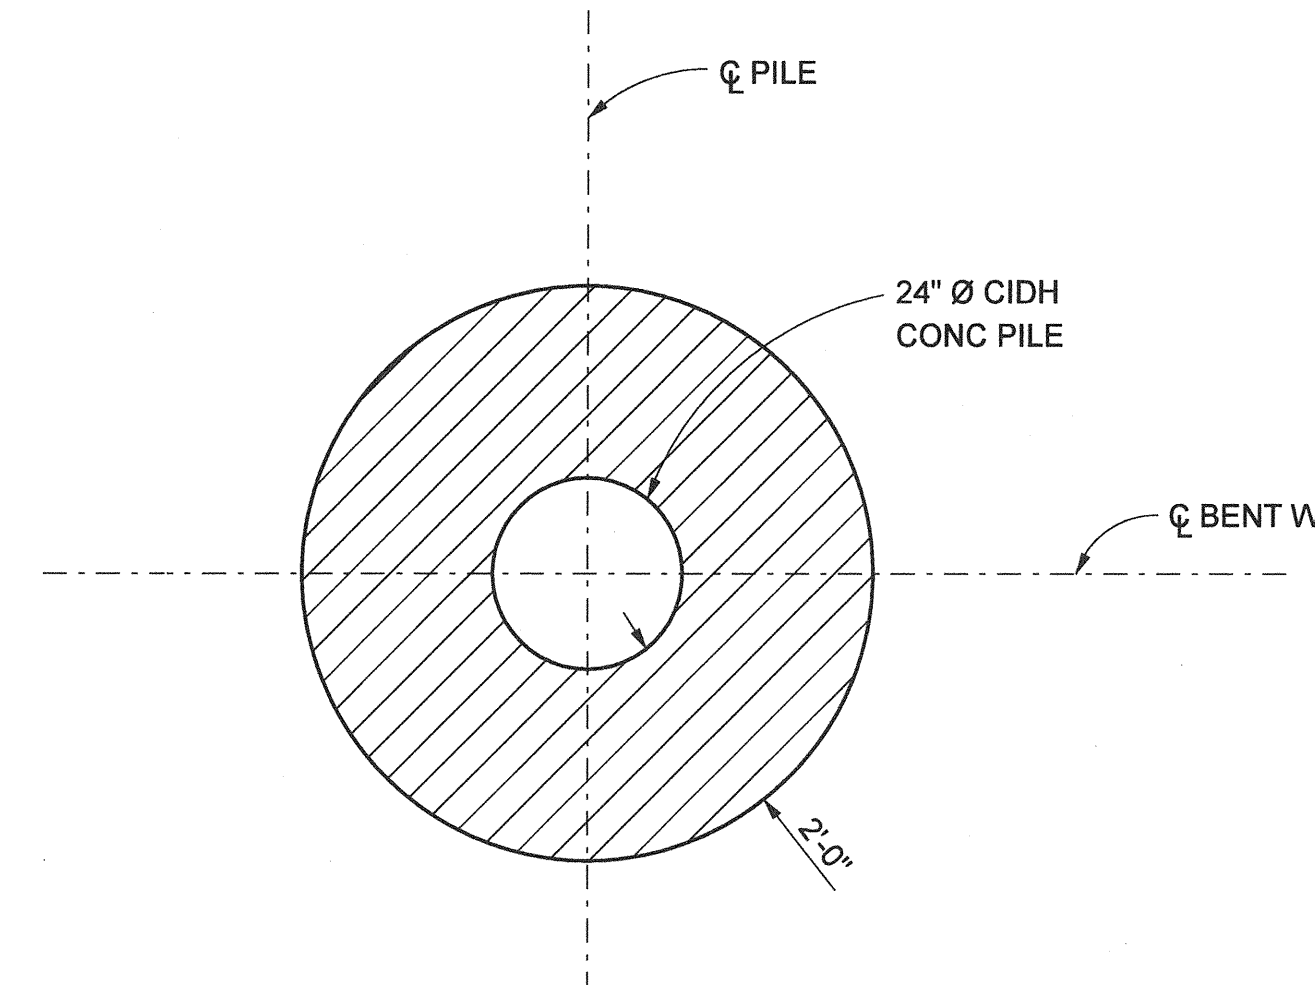


PLAN

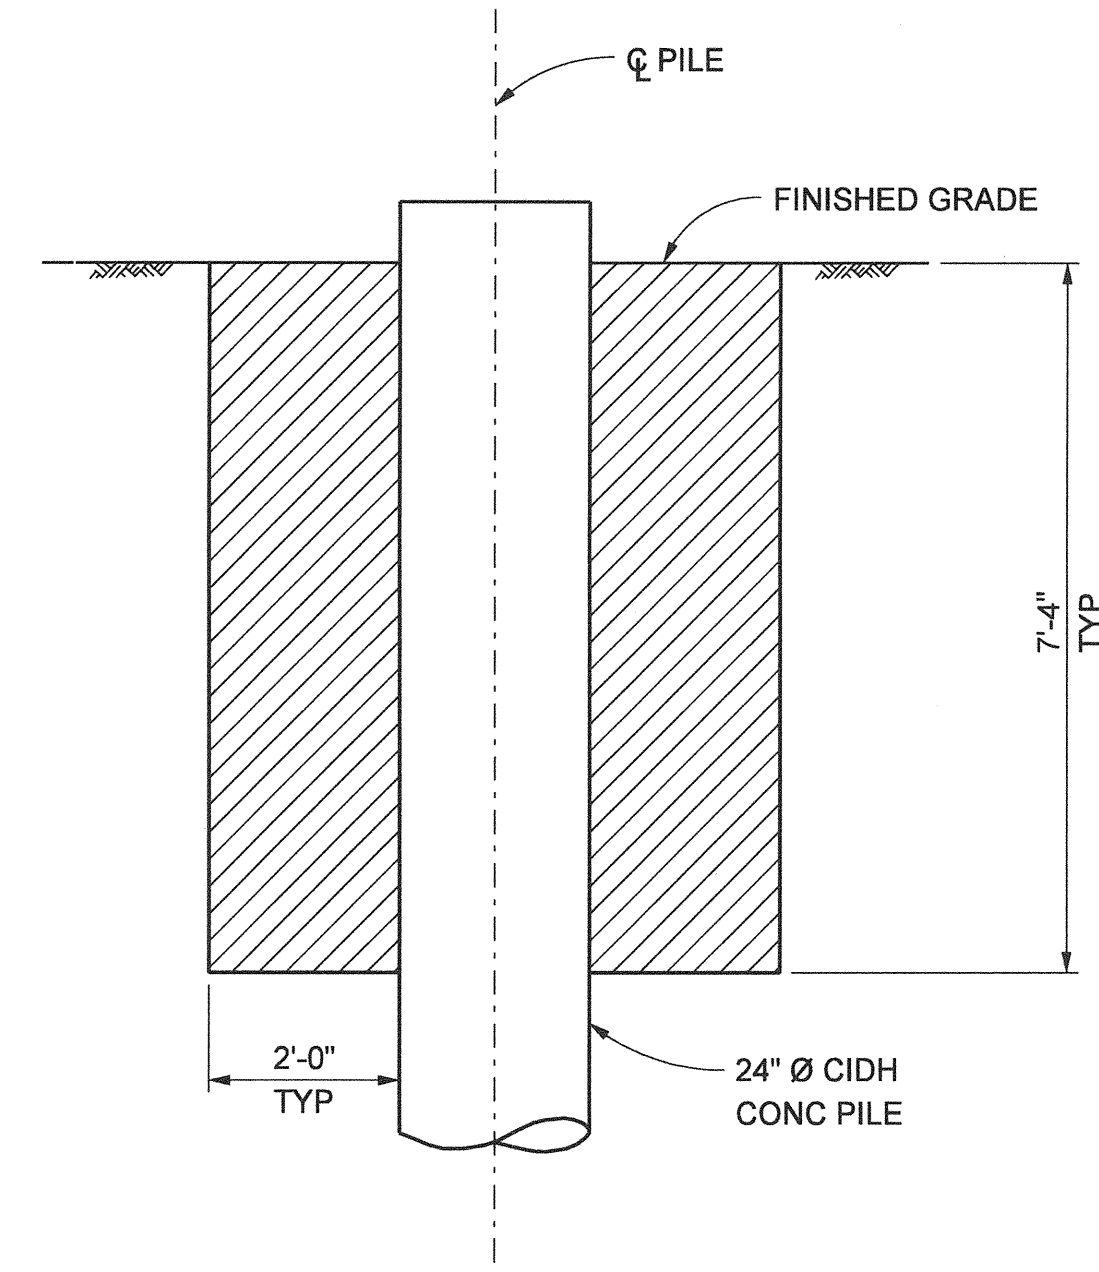


ELEVATION

STRUCTURE EXCAVATION
(PILE 1 & PILE 2 ONLY)

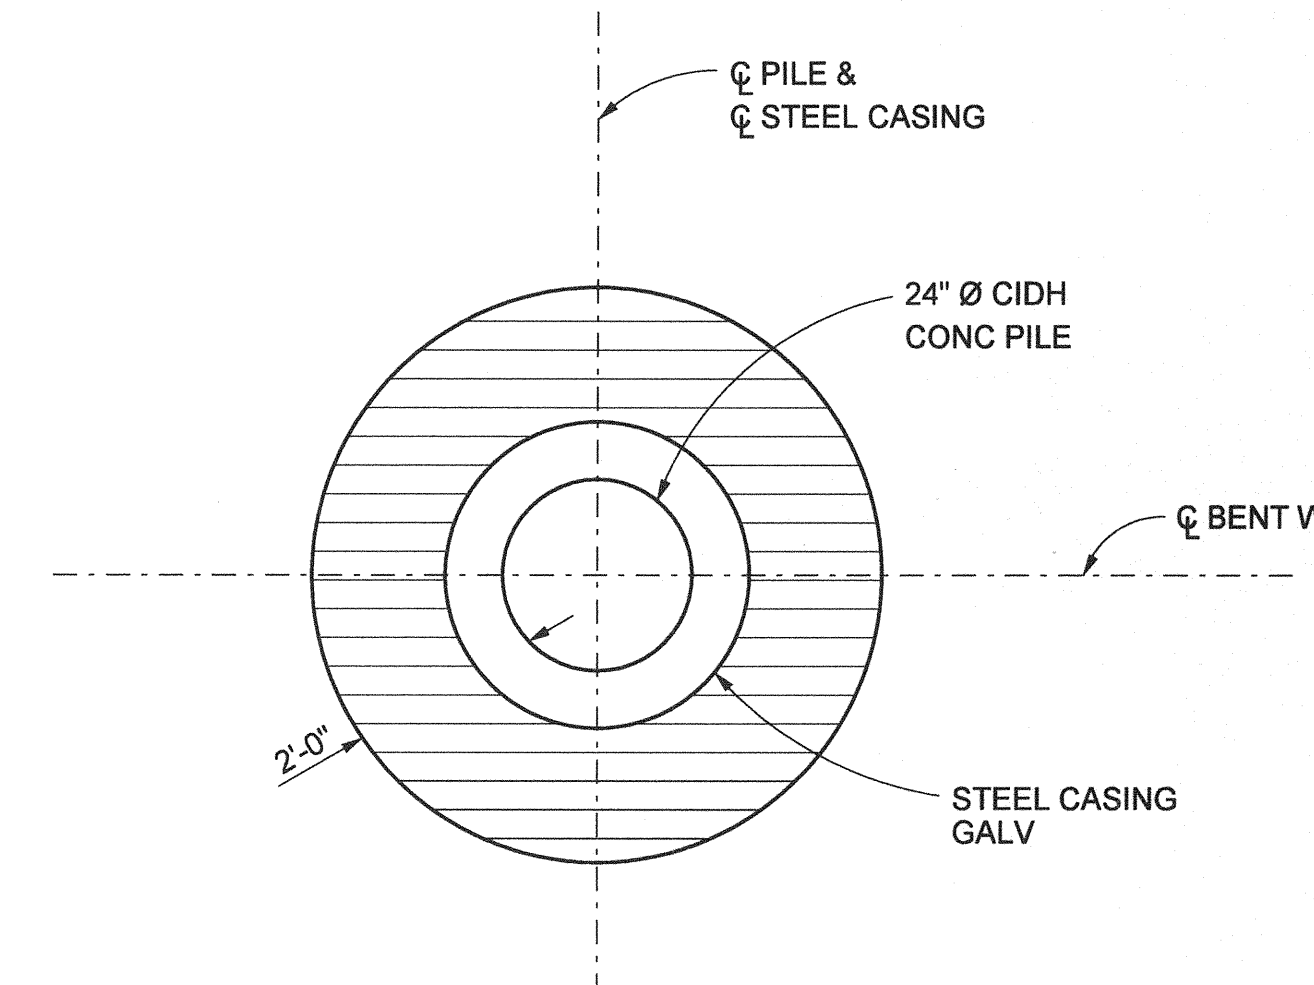

PLAN

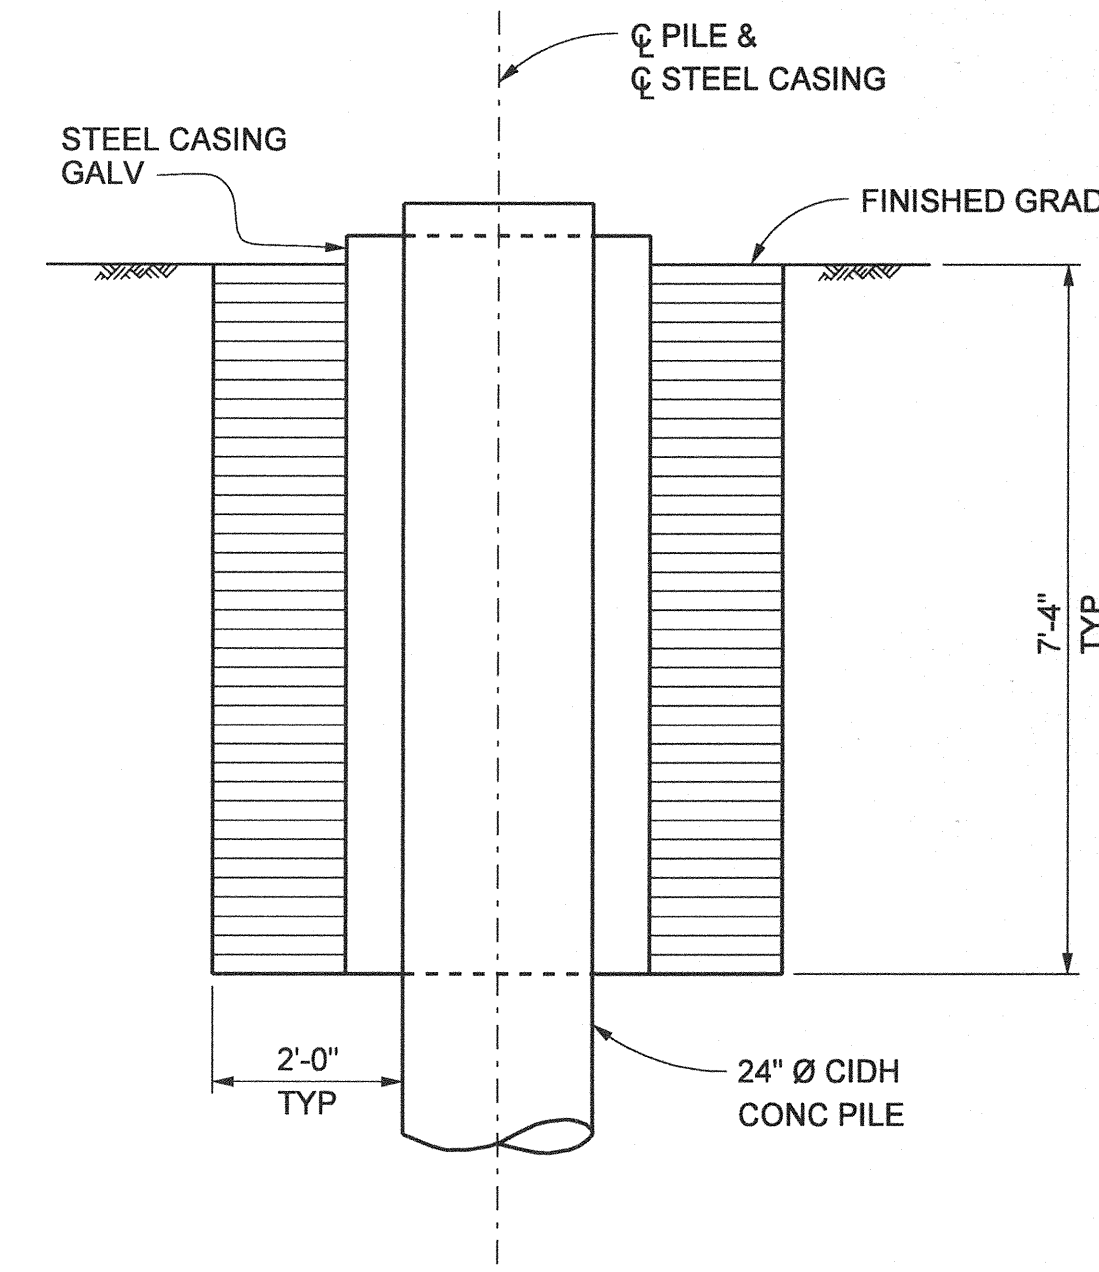

ELEVATION

STRUCTURE BACKFILL
(PILE 1 & PILE 2 ONLY)

STRUCTURAL EXCAVATION & BACKFILL - 24" Ø CIDH PILE
NO SCALE

LEGEND

- DENOTES EXISTING STRUCTURE
- DENOTES NEW STRUCTURE
- STRUCTURE EXCAVATION
- STRUCTURE BACKFILL

NO AS BUILT CHANGES

AS BUILT

CORRECTION BY: MN
CONTRACT NO.: ER28121
DATE: 12/30/2009

PLANS PREPARED BY:
HNTB
HNTB Corporation
200 E. SANDPOINT AVENUE, SUITE 200
SANTA ANA, CALIFORNIA 92707
TEL (714) 460-1600 FAX (714) 460-1610

ORANGE COUNTY RESOURCES & DEVELOPMENT MANAGEMENT DEPT		ANTONIO PARKWAY WILDLIFE UNDERCROSSING (WIDEN)	
ISOLATION CASING DETAILS		SHEET 71 OF 72	
DESIGNED: <u>J. WANG</u>	CHECKED: <u>E. JIANG</u>	DATE: <u>9/19/06</u>	
DRAWN: <u>J. WANG</u>	SCALE: <u>AS SHOWN</u>	DATE: <u>9/19/06</u>	

PREPARED UNDER RESPONSIBLE CHARGE OF:
Yung-Nien Wang
REGISTERED PROFESSIONAL ENGINEER
NO. C 43559
EXP. 6-30-08
CIVIL
STATE OF CALIFORNIA
Yung-Nien Wang
RCE C 43559 (EXP. 6-30-08)

Date Plotted:

File Name: J:\34092\CADD\Struct\sheet\antoniopkwy-S-30.dgn

Border sheet last modified 09-Nov-1999