


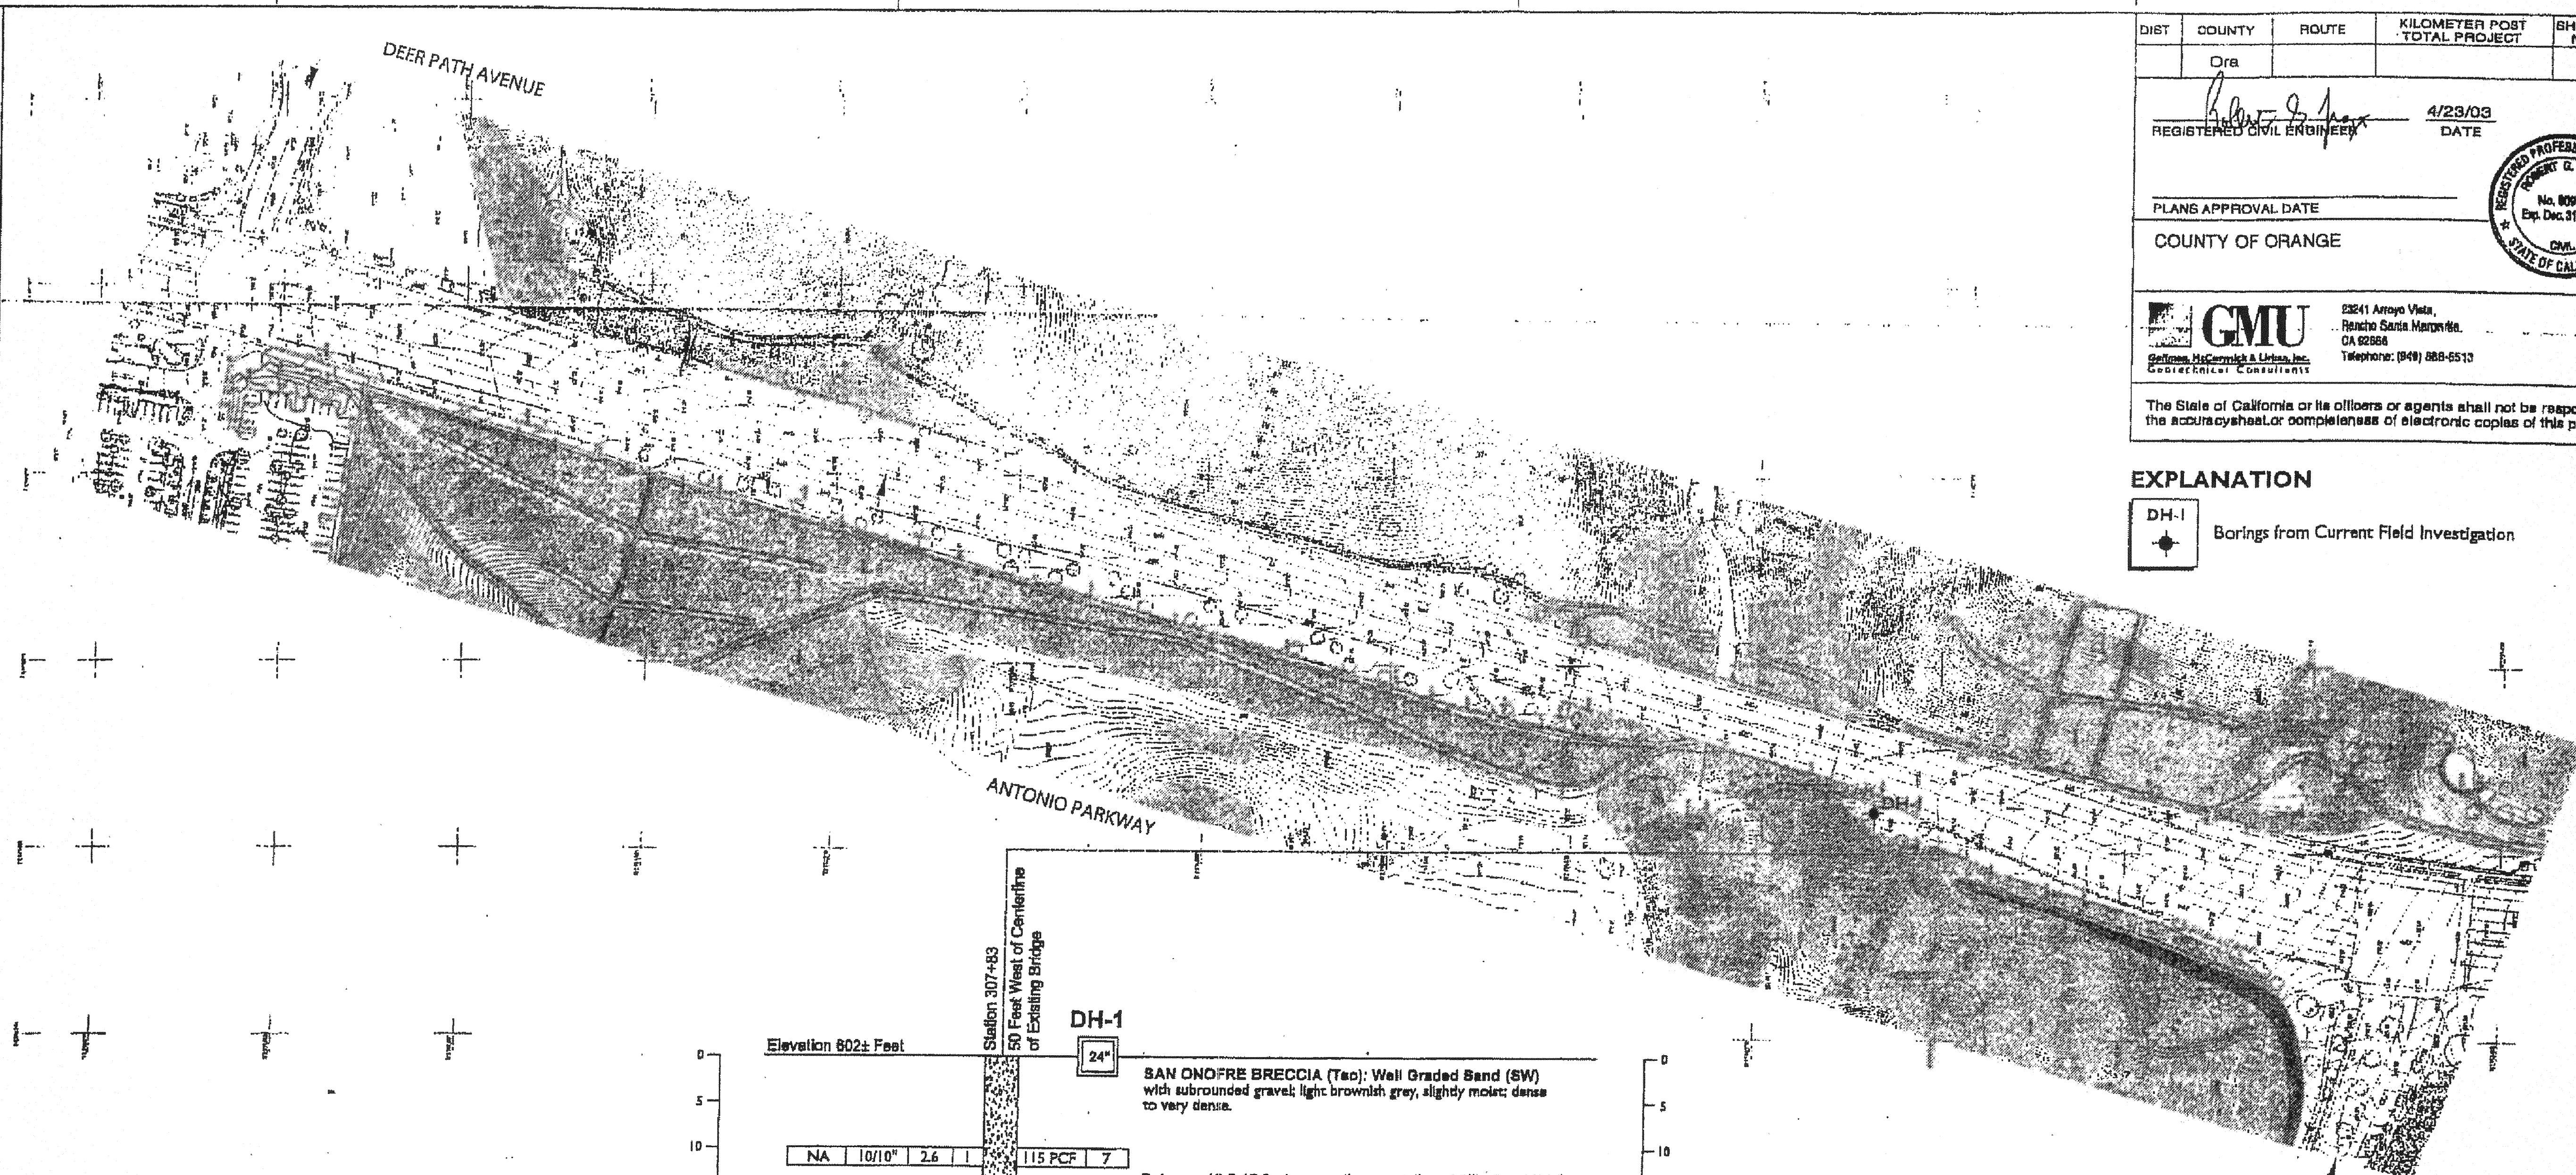

FILE'S ON CASES FROM MAY, 1971 TO PRESENT.