

ORANGE COUNTY ENVIRONMENTAL MANAGEMENT AGENCY


SANTA ANA, CALIFORNIA

JOHN W. SIBLEY, ACTING DIRECTOR


PLANS FOR CONSTRUCTION OF

ANTONIO PARKWAY

PHASE II
ORTEGA HIGHWAY
TO
8,340 FT NORTHERLY

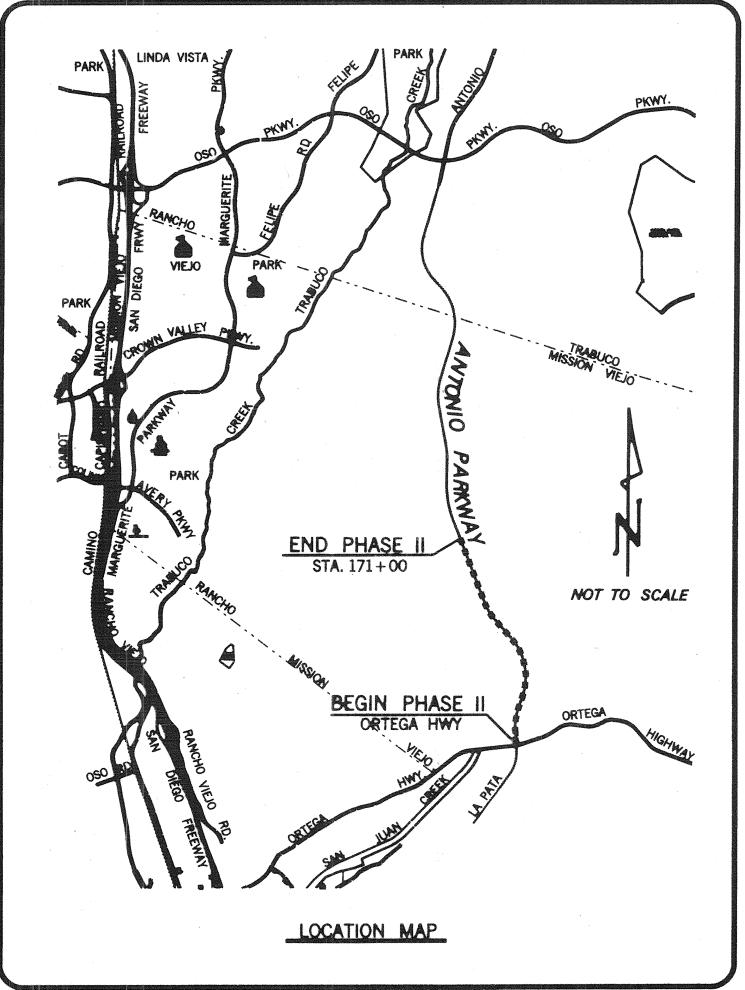

FUNDED BY: ROAD FUNDS

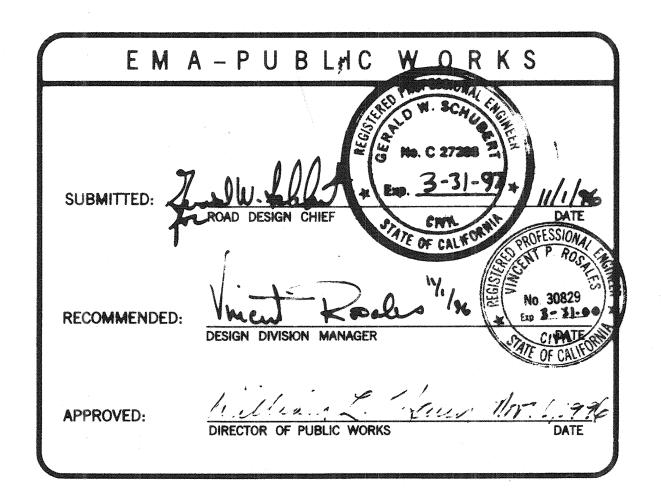

NO.	DESCRIPTION	SHEETS	APPROVED	DAT
Δ	REVISED HOTE	38,39,40,41,AND 42	411. Fotamen	12-2
	REVISED SECTION	38,39,40,41,42,46,AND47	4/4 blunsen	12-2
A	REVISED DETAIL	40,41, AHD 42	S.M. Lohonson	12-2
		ADDED 70,80,90,000,000	With James	8-14
\triangle		60 AND 63	Whomas	10-27.
<u>/6\</u>	AS BUILT SHOWN	51,52,54264	U	
		7.8.9,10,11,21,22,26		
odoniconomica nipologia		<i>27,31,32,33,37,44,86</i> &87		
			generalises contractores contractores contractores contractores contractores and contractores co	ļ
omenica de anticología de la constanta de la c				_
				-
				1
			Markanska asestanikan menengan kanan dari pendan kanan dari pendan dari pendan dari pendan dari pendan pendan	

				-

7	IN D E X O F S H E E T S
SHEET	DESCRIPTION
1	TITLE QUEET
	TITLE SHEET
2	TYPICAL SECTIONS
3	CONSTRUCTION NOTES
4	TYPICAL PAYLINE SECTIONS
5	INDEX MAPS
6–11	PLAN SHEETS
12–17	PROFILE SHEETS
18–19	DETAIL SHEETS
20–25	STORM DRAIN - PLAN
26–31	STORM DRAIN - PROFILE
32	SMWD ACCESS ROAD CULVERT
33–42	DETAIL SHEETS
43–44	CROSS DRAINAGE
45-48	DETAIL SHEETS
49–75	SAN JUAN CREEK BRIDGE
76–78	SDG&E UTILITY DETAILS
79–82	CVWD WATER LINE RELOCATION
83–85	SMWD LAND OUTFALL RELOCATION
86–87	SMWD ACCESS ROAD RELOCATION
88–119	CROSS SECTIONS
120–126	GEOTECHNICAL PLATES

UTILITY OWNER	PHONE NO.	CONTACT
SANTA FE PACIFIC PIPELINE PARTNERS	(714) 560-4944	GEORGE REED
SAN DIEGO GAS & ELECTRIC	(714) 361–8047	PATTI GOOD
THE GAS COMPANY	(714) 634–3041	JIM BEVANS
PACIFIC BELL	(714) 348–0595	SANDY WALTER
PACIFIC BELL	(714) 666–5707	BÎLL LOWING
COX COMMUNICATIONS	(714) 220–8828	MARTY ZUPANCIC
CAPISTRANO VALLEY WATER DISTRICT	(714) 493–1515	CRAIG HARRIS
SANTA MARGARITA WATER DISTRICT	(714) 459–6582	JAIME AGUILAR
SAN JUAN BASIN AUTHORITY	(714) 489–7735	MATT SMITH
SANTA MARGARITA RANCH OPERATIONS	(714) 493–1571	GARY JACKSON

BENCH MARK:

THE ELEVATIONS SHOWN HEREON ARE IN TERMS OF THE NATIONAL GEODETIC VERTICAL DATUM OF 1929, BASED LOCALLY UPON THE ORANGE COUNTY SURVEYOR'S 1995
ADJUSTMENT FOR BENCHMARKS OSO-C-91: ELEVATION 540.048' AND Y-312: ELEVATION 282.478'

OSO-C-91 IS AN OSC 3 3/4" ALUMINUM BENCHMARK DISK STAMPED "OSO-C-91" FLUSH IN A CONCRETE CATCH BASIN, ESTABLISHED BY OCS IN 1991

Y-312 IS STANDARD 3" BRONZE DISK ESTABLISHED BY USC & GS IN 1935

BASIS OF BEARINGS:

THE BEARINGS SHOWN HEREON ARE BASED ON THE BEARING BETWEEN OCS HORIZONTAL CONTROL STATION GPS #0198 AND STATION GPS #0742, BEING N 59°45'19" E, PER RECORDS ON FILE AT THE OFFICE OF THE ORANGE COUNTY SURVEYOR.

COORDINATES SHOWN ARE BASED ON THE CALIFORNIA COORDINATE SYSTEM (CCS83), ZONE VI, 1983 NAD (1991.35 EPOCH ADJUSTMENT).

DR. 3 (16158)

Sheet 1 Of 126

W. O. NO. <u>ER02775C</u> DWG. NO. _____ SHEET 1 OF 126