

7 8 9 10 11 12 13 14 15 16 17 18 19 20 21 22 23 24 25 26 27 28 29 30 31 32 33 34 35 36 37 38 39 40 41

EXACT®

STRAIGHT EDGE RULE SE-48

6 10 11 12 13 14 15 16 17 18 19 20 21 22 23 24 25 26 27 28 29 30 31 32 33 34 35 36 37 38 39 40 41

ORANGE COUNTY ROAD DEPT.

STATE OF CALIFORNIA

PLANS FOR CONSTRUCTION OF



BALL ROAD BRIDGE

SA-12

ACROSS SANTA ANA RIVER

(CHANNEL E01)

1967

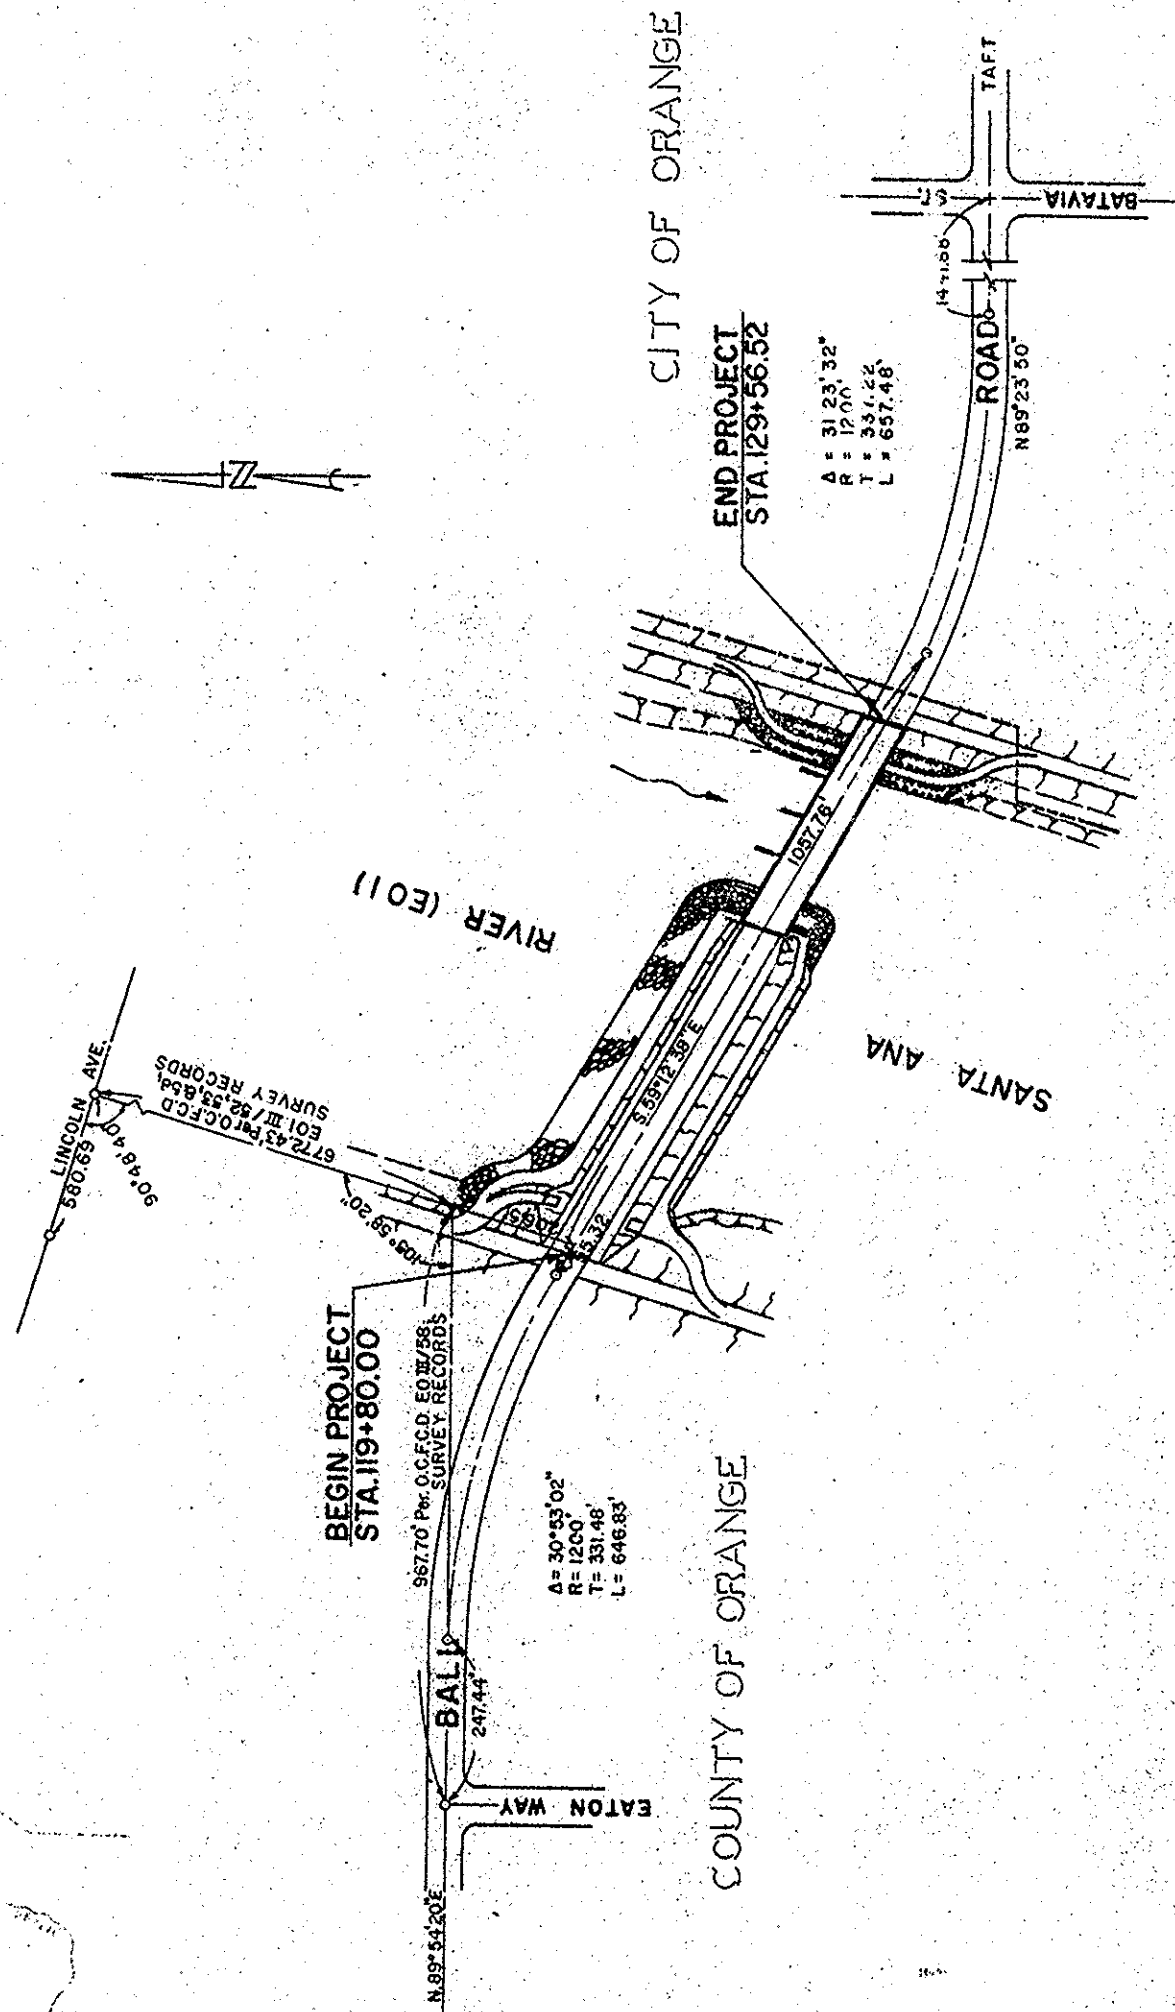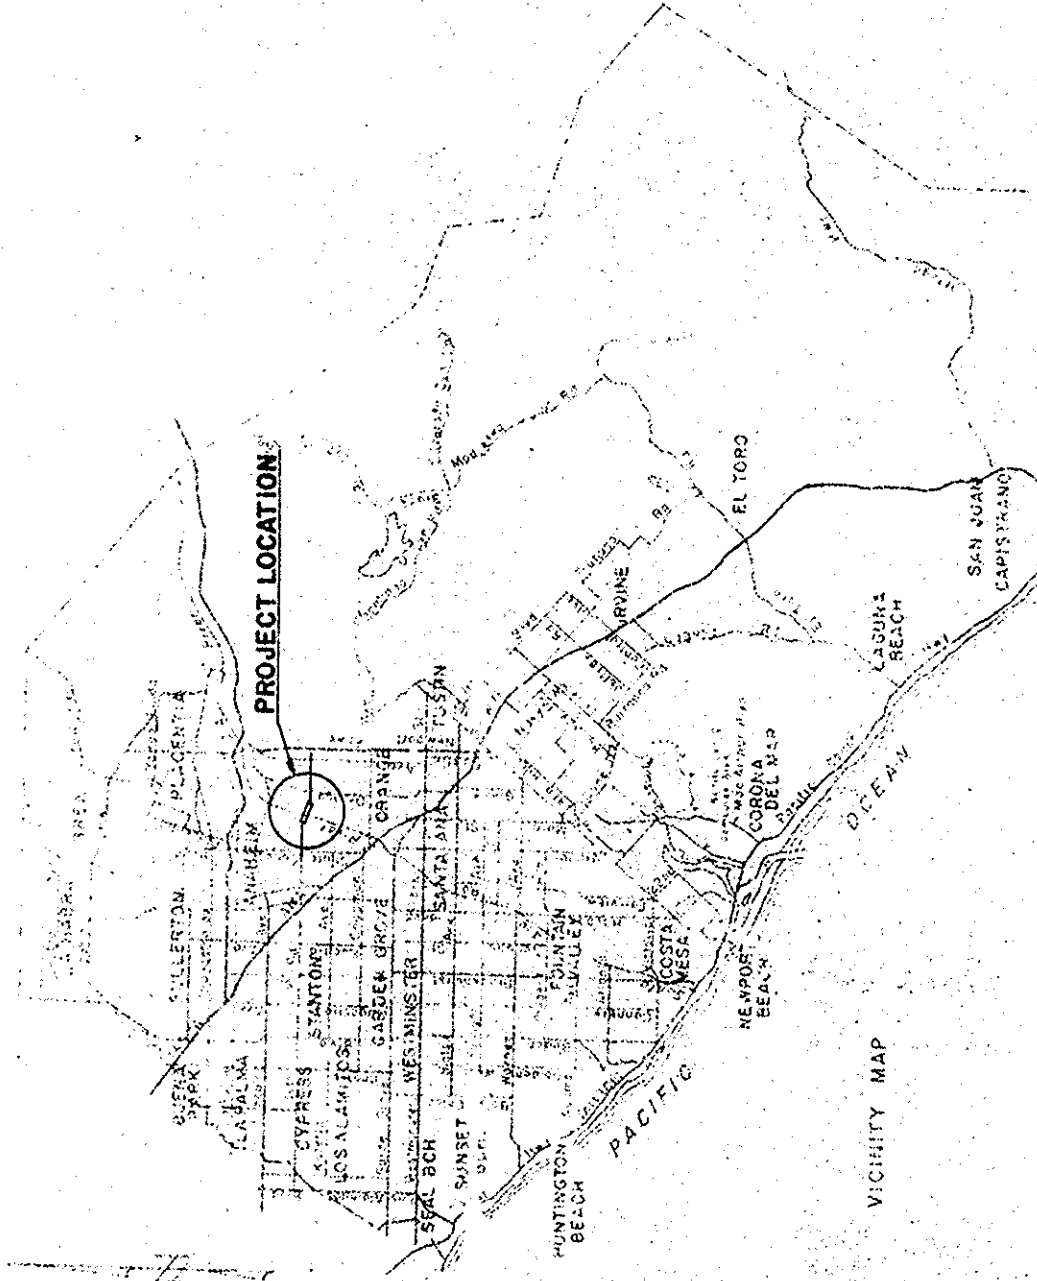

INDEX OF SHEETS

Sheet No	Description
1	TITLE SHEET
2	GENERAL PLAN
3	WEST LEVEE ACCESS ROAD & 14'x14' R.C.B. DETAILS
4	EAST LEVEE ACCESS ROAD & RIPRAP DETAILS
5	FOUNDATION PLAN
6	ABUTMENT #1 DETAILS
7	ABUTMENT #7 DETAILS
8	PIER DETAILS
9	PIER EXTENSION DETAILS
10-11	SUPERSTRUCTURE LAYOUT & REINFORCEMENT
12	TYPICAL SECTION
13	HINGE DETAILS
14	MISCELLANEOUS DETAILS
15	GUARD RAIL-EXCAVATION & BACKFILL DETAILS
16	PILE DETAILS
17-18	LOG OF TEST BORINGS

AS BUILT

APPROVED: *[Signature]* DATE: 5-1-67
ROAD COMMISSIONER R.C.E. 7672

RECEIVED: JUN 1 2 1967
OFFICE OF THE ROAD COMMISSIONER
SANTA ANA RIVER
SANTA ANA RIVER
SANTA ANA RIVER

BALL RD. BR.
OVERSAR
SA-12
55C-159
Th. 769-E7

1967