


EXACT®

EXACT LEVEL 2016 E.N.I., U.S.A.

STRAIGHT EDGE RULE SE-48

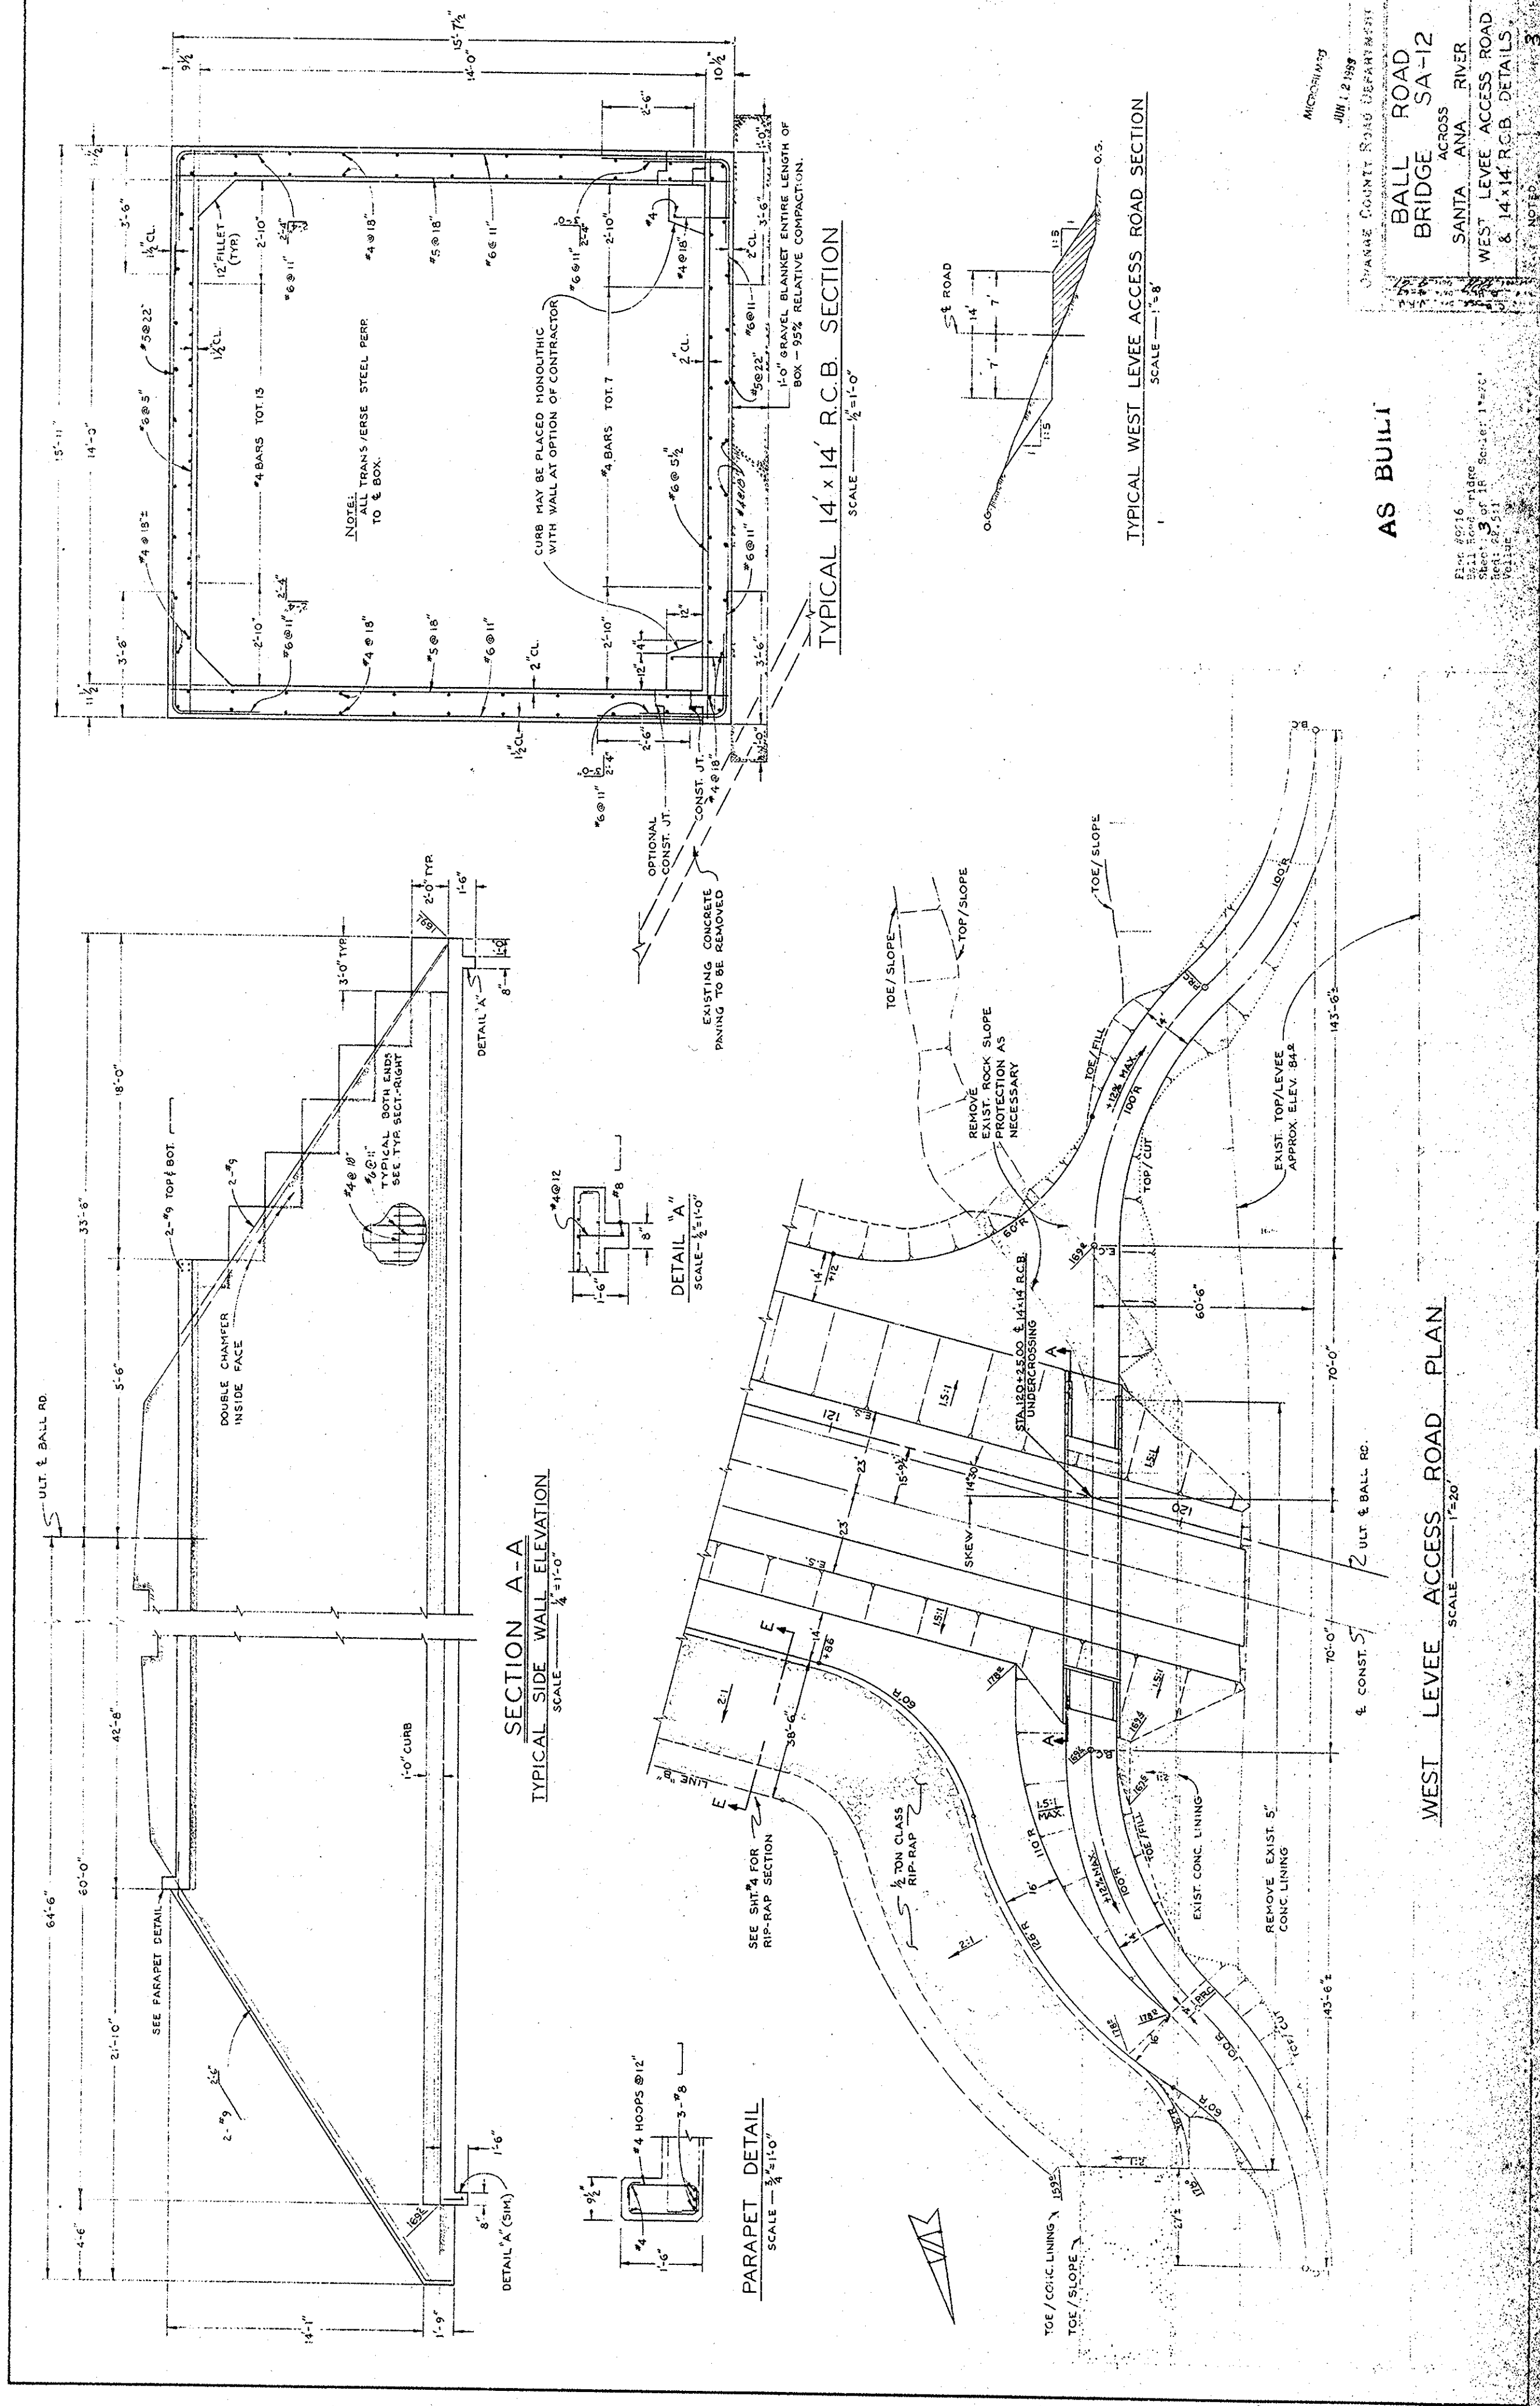

AS BUILT

CHARGE COUNTY ROAD DEPARTMENT
JULY 1, 1999
MICROFILM
BALL ROAD
BRIDGE SA-12
ACROSS
SANTA ANA RIVER
WEST LEVEE ACCESS ROAD
& 14' x 14' R.C.B. DETAILS

Plot #0716
Sheet #1 of 18
Date: 2/2/01
Volume: 3