




FOR TEST GROUP CUT-
OFF SEE PILE 1 AYCUT

1. PILE BEARING VALUE: 45 TONS.
2. PILE TEST GROUP TO BE LOCATED IN PIER #4, SEE SPECIAL PROVISIONS & SHT. #16.
3. EXISTING CONTOURS SHOWN (PER SURVEY 2/23/67)

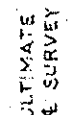

PIERS #23485

○ SIGNIFIES BATTER 1:6 AND DIRECTION OF BATTER
 — SIGNIFIES PILE REIN PER NOTE "C" SUB 2.0

PILE LAYOUT

0310
#5

ARBITRAMENTE
#7

ADDITIONAL /
SIGNIFIES RATED 1-4 AND DIRECTION OF RATED

3110

BALL ROAD
BRIDGE SA-12

SANTA ANA RIVER
FOUNDATION PLAN

44-5018