


EXACT


EXACT LEVEL, U.S.A.

STRAIGHT EDGE RULE


8 9 10 11 12 13 14 15 16 17 18 19 20 21 22 23 24 25 26 27 28 29 30 31 32 33 34 35 36 37 38 39 40 41

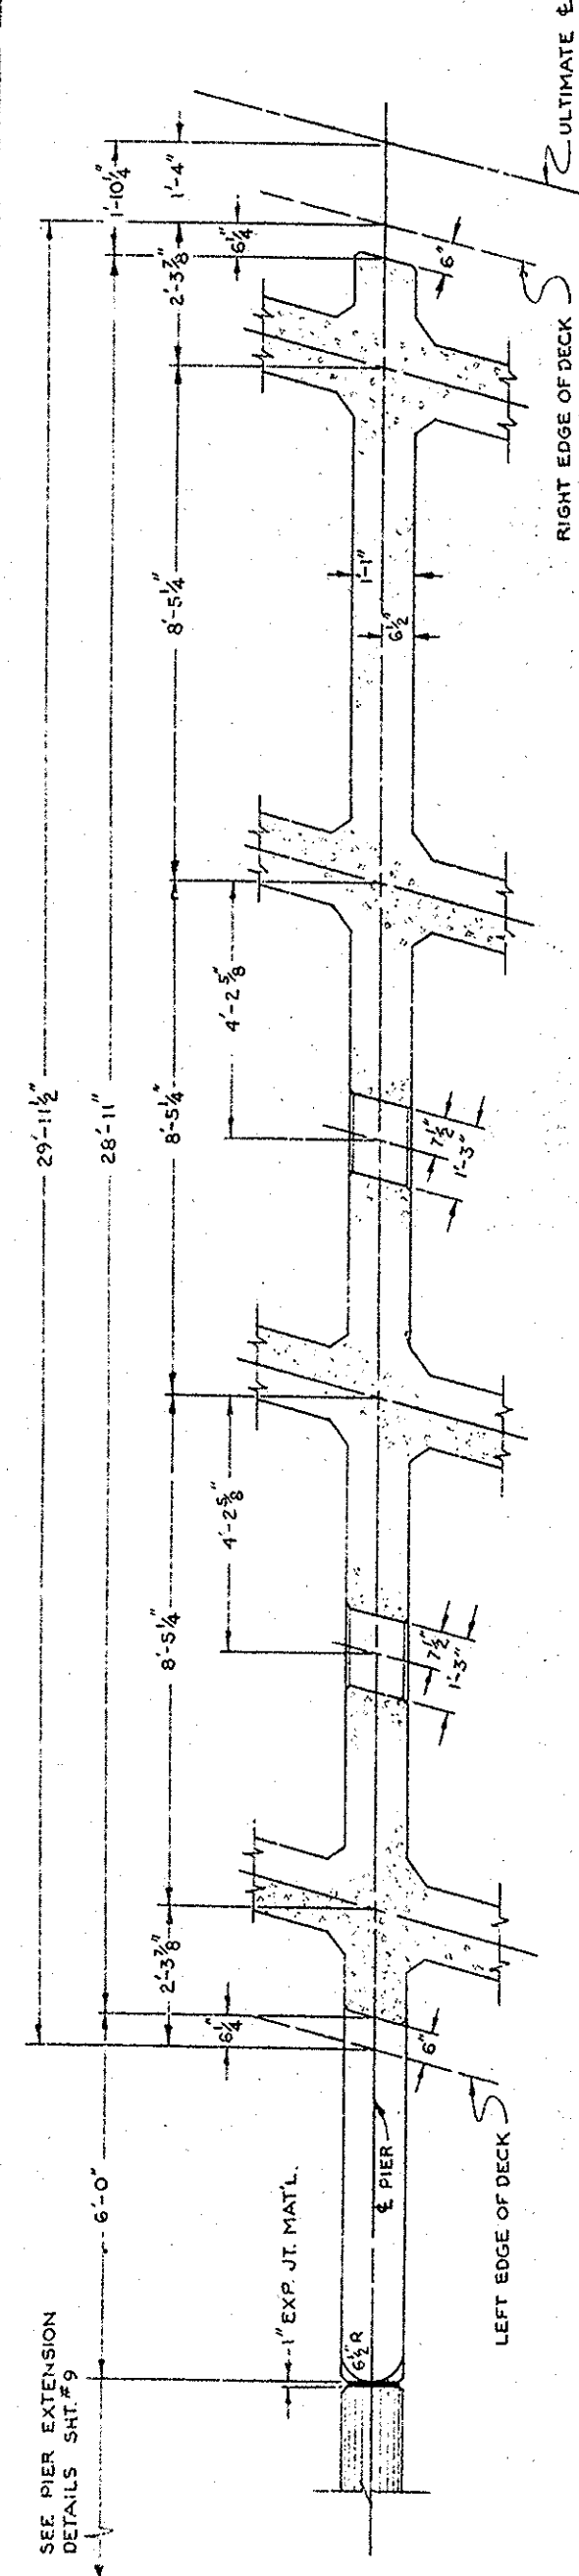


SECTION A-A
SCALE 1/2" = 1'-0"

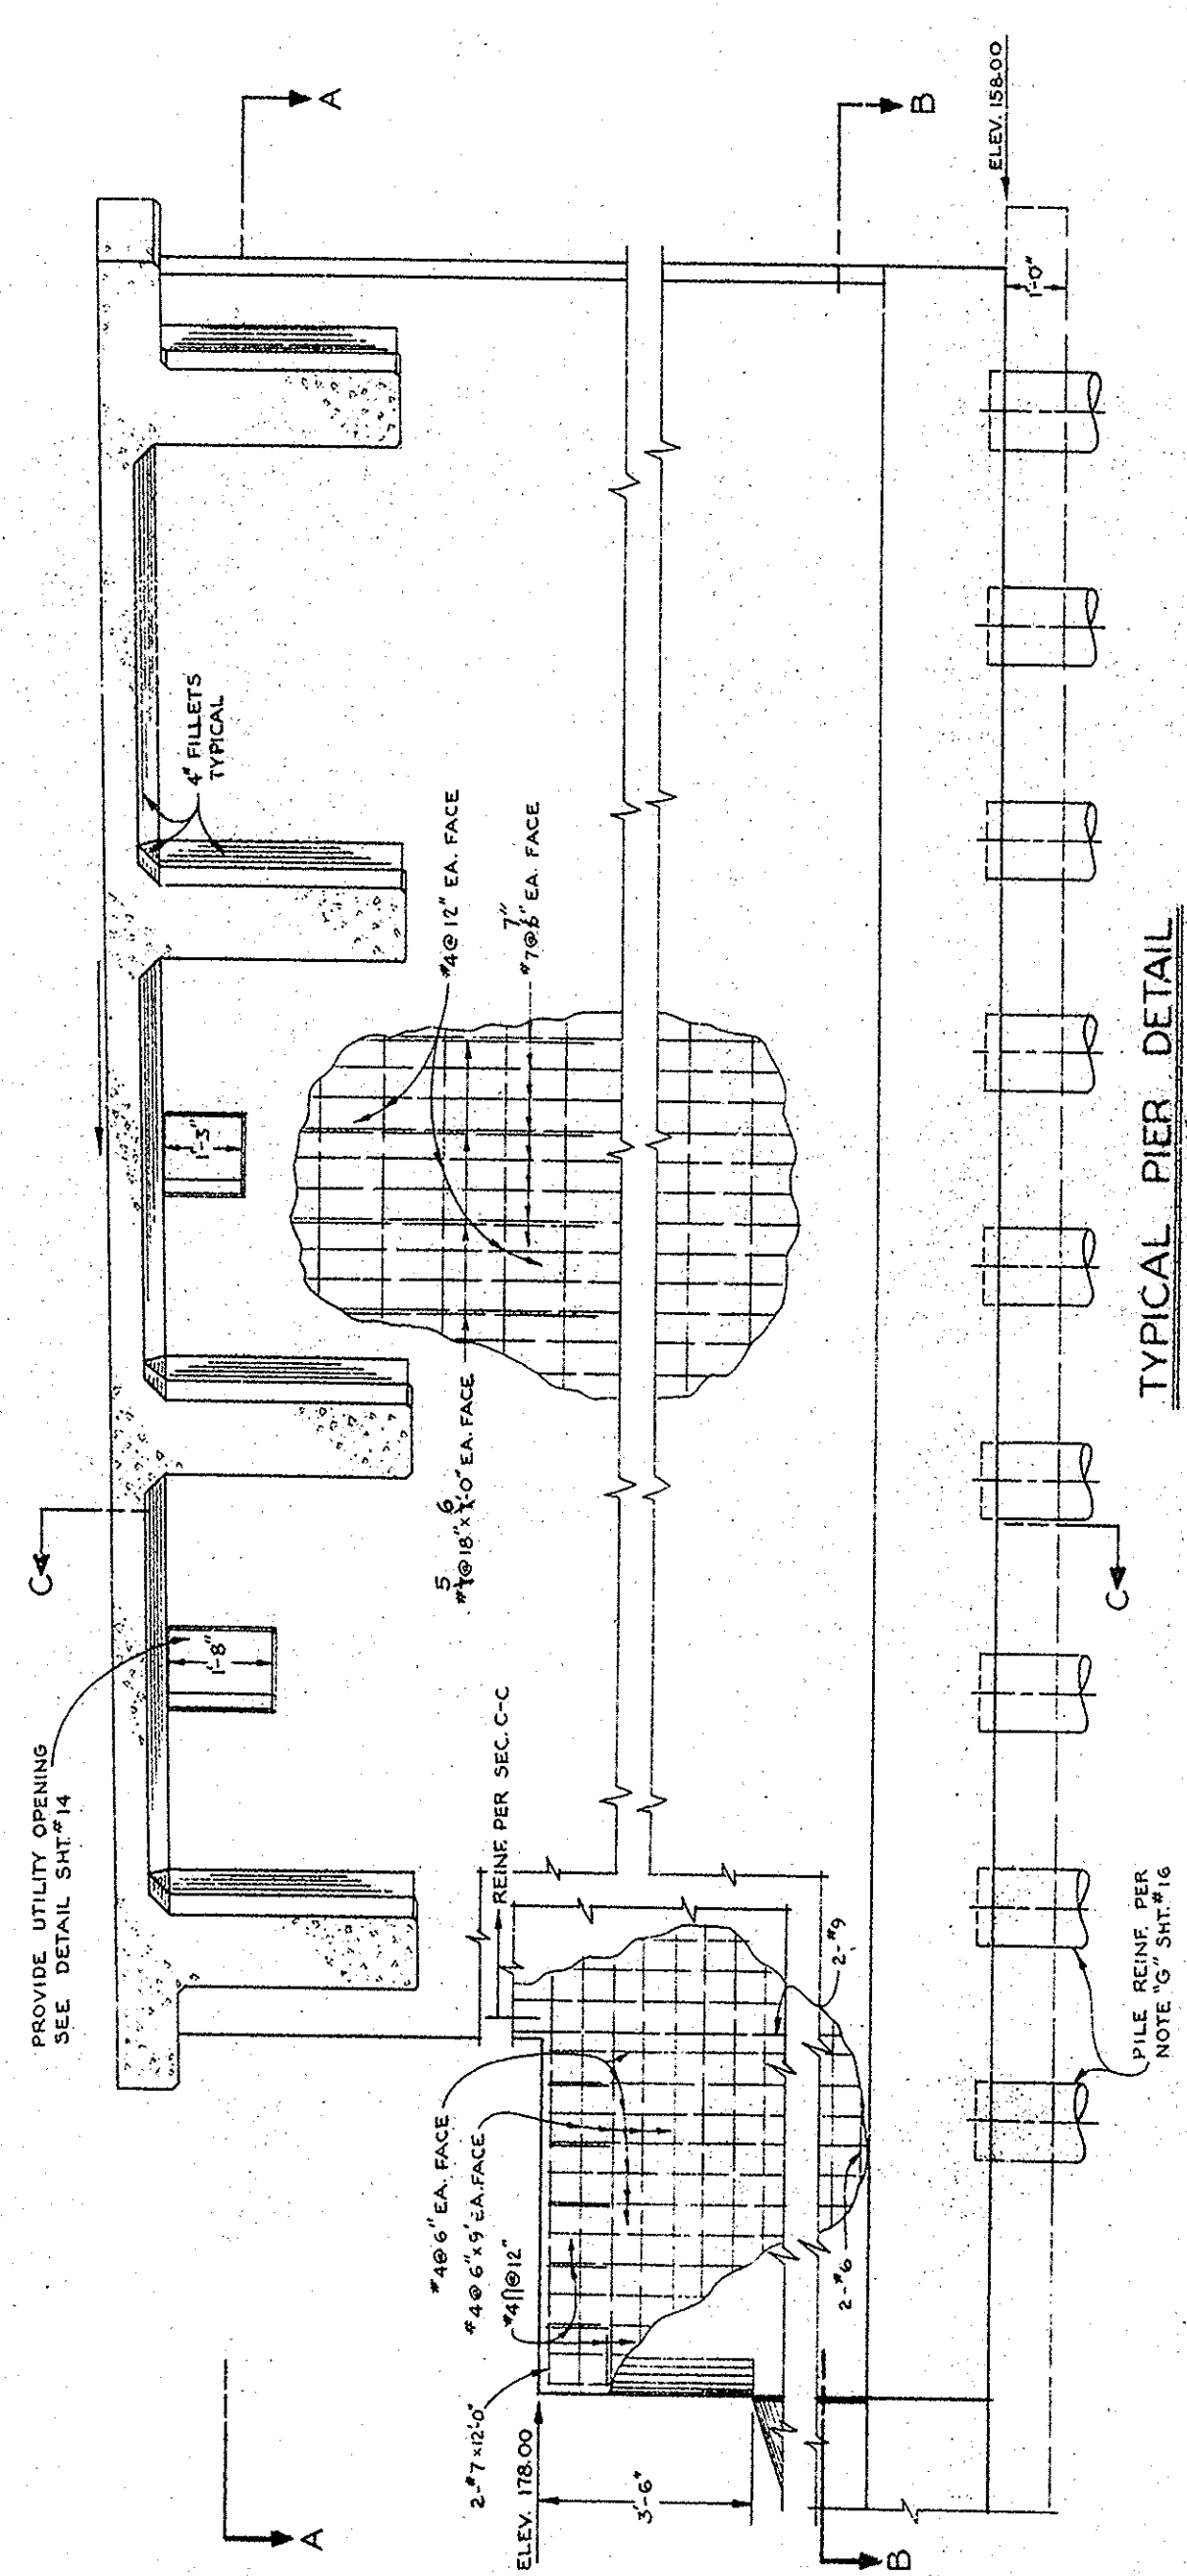

TYPICAL PIER DETAIL
SCALE 1/2" = 1'-0"

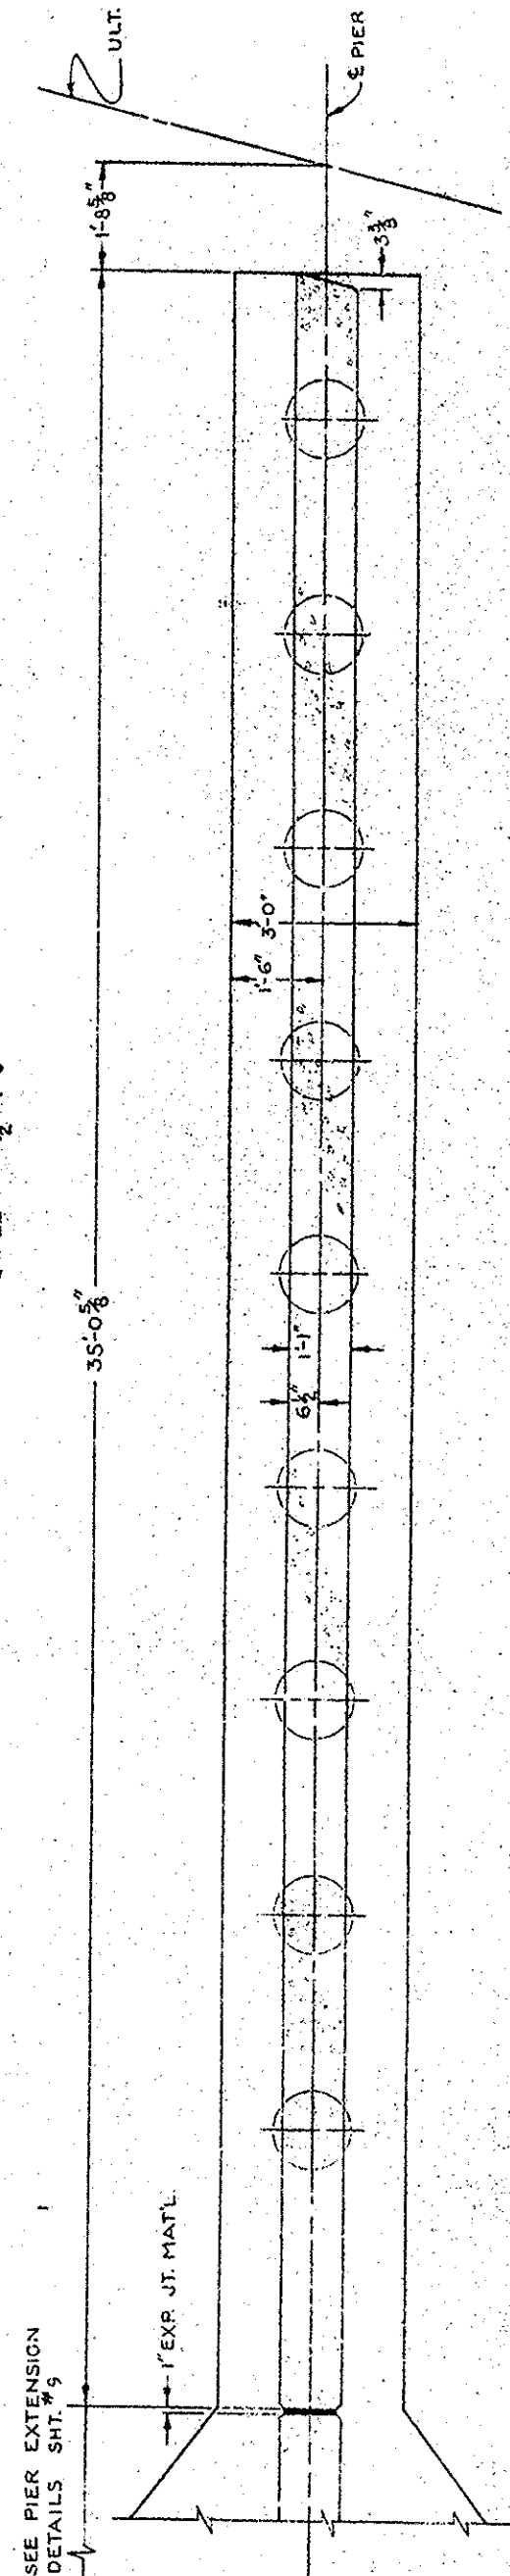

SECTION B-B
SCALE 1/2" = 1'-0"

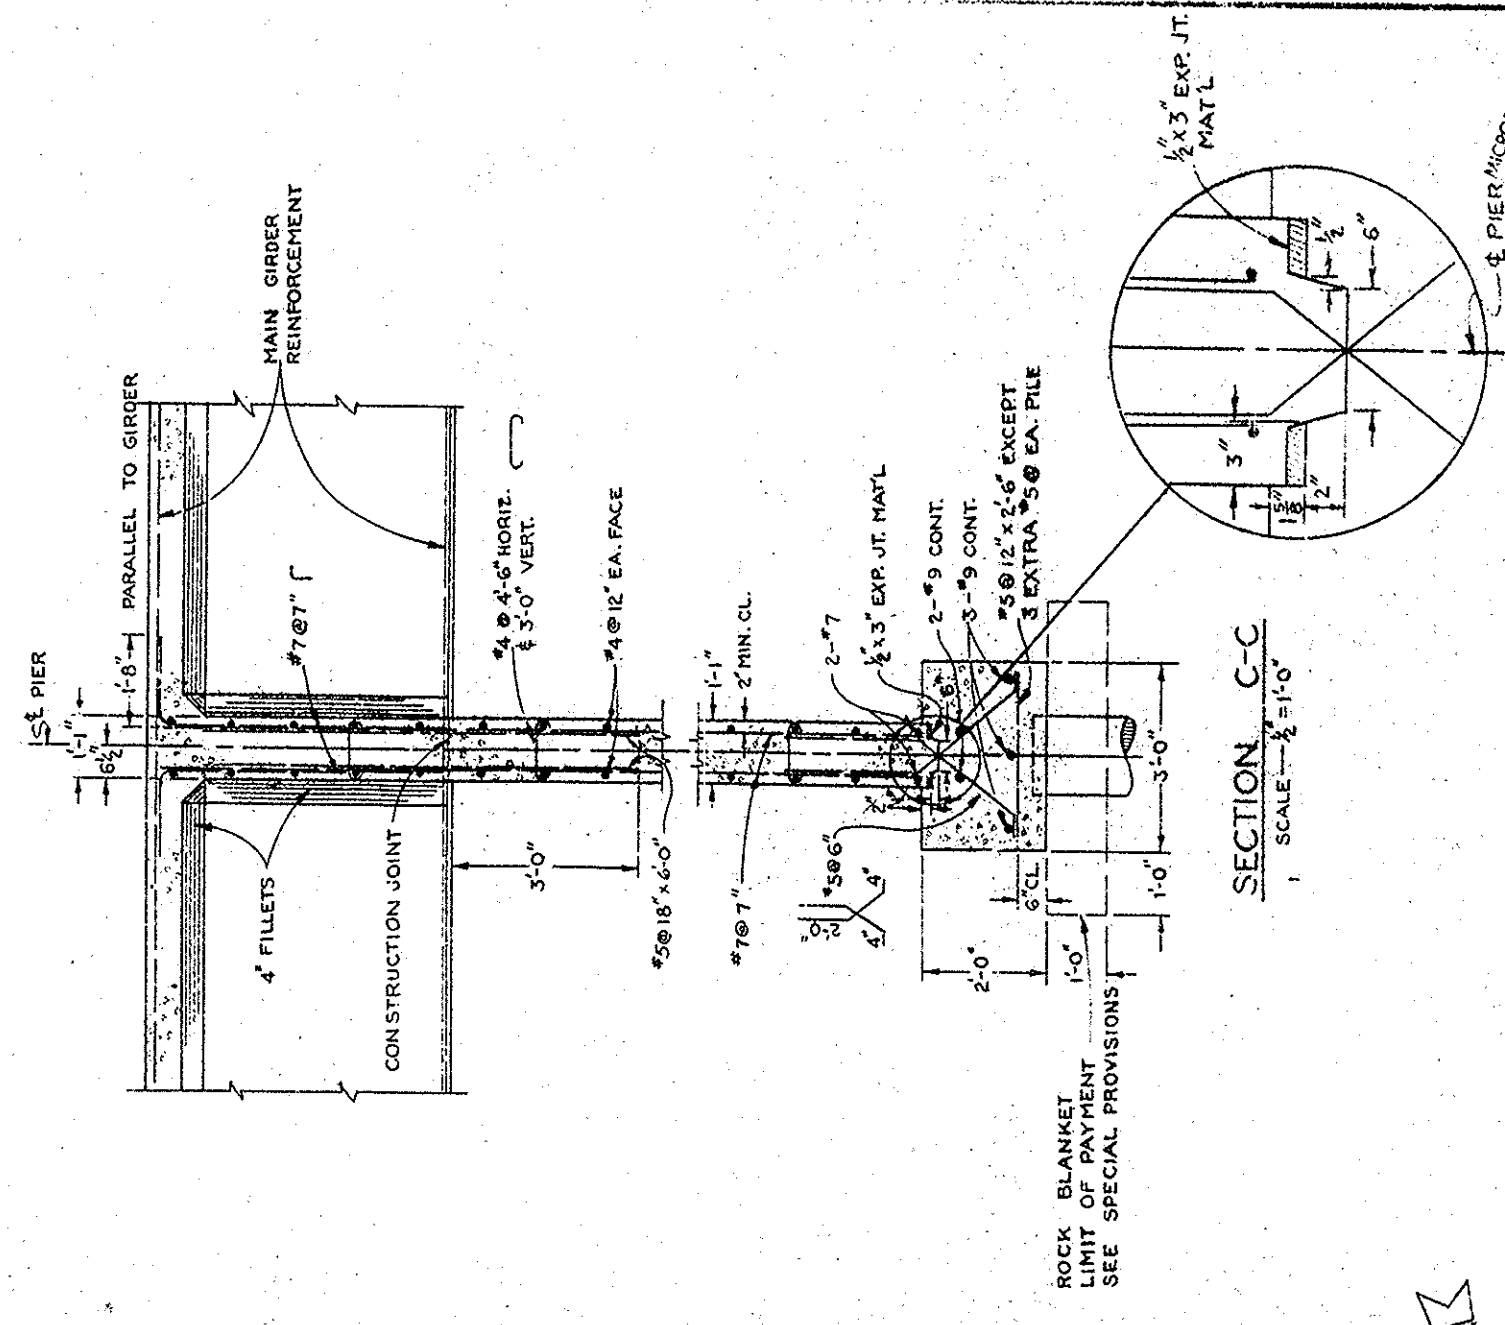

SECTION C-C
SCALE 1/2" = 1'-0"

KEY DETAIL
SCALE 1/2" = 1'-0"

ORANGE COUNTY ROAD DEPARTMENT
BALL ROAD
BRIDGE SA-12
ACROSS SANTA ANA RIVER
PIER DETAILS

AS BUILT

Plan No. 1016
Ball Road Bridge
Sheet 8 of 18
Roll 27-511
Volume