


EXACT®

EXACT LEVEL N.T.I., U.S.A.



STRAIGHT EDGE RULE SE-48

8 9 10 11 12 13 14 15 16 17 18 19 20 21 22 23 24 25 26 27 28 29 30 31 32 33 34 35 36 37 38 39 40 41

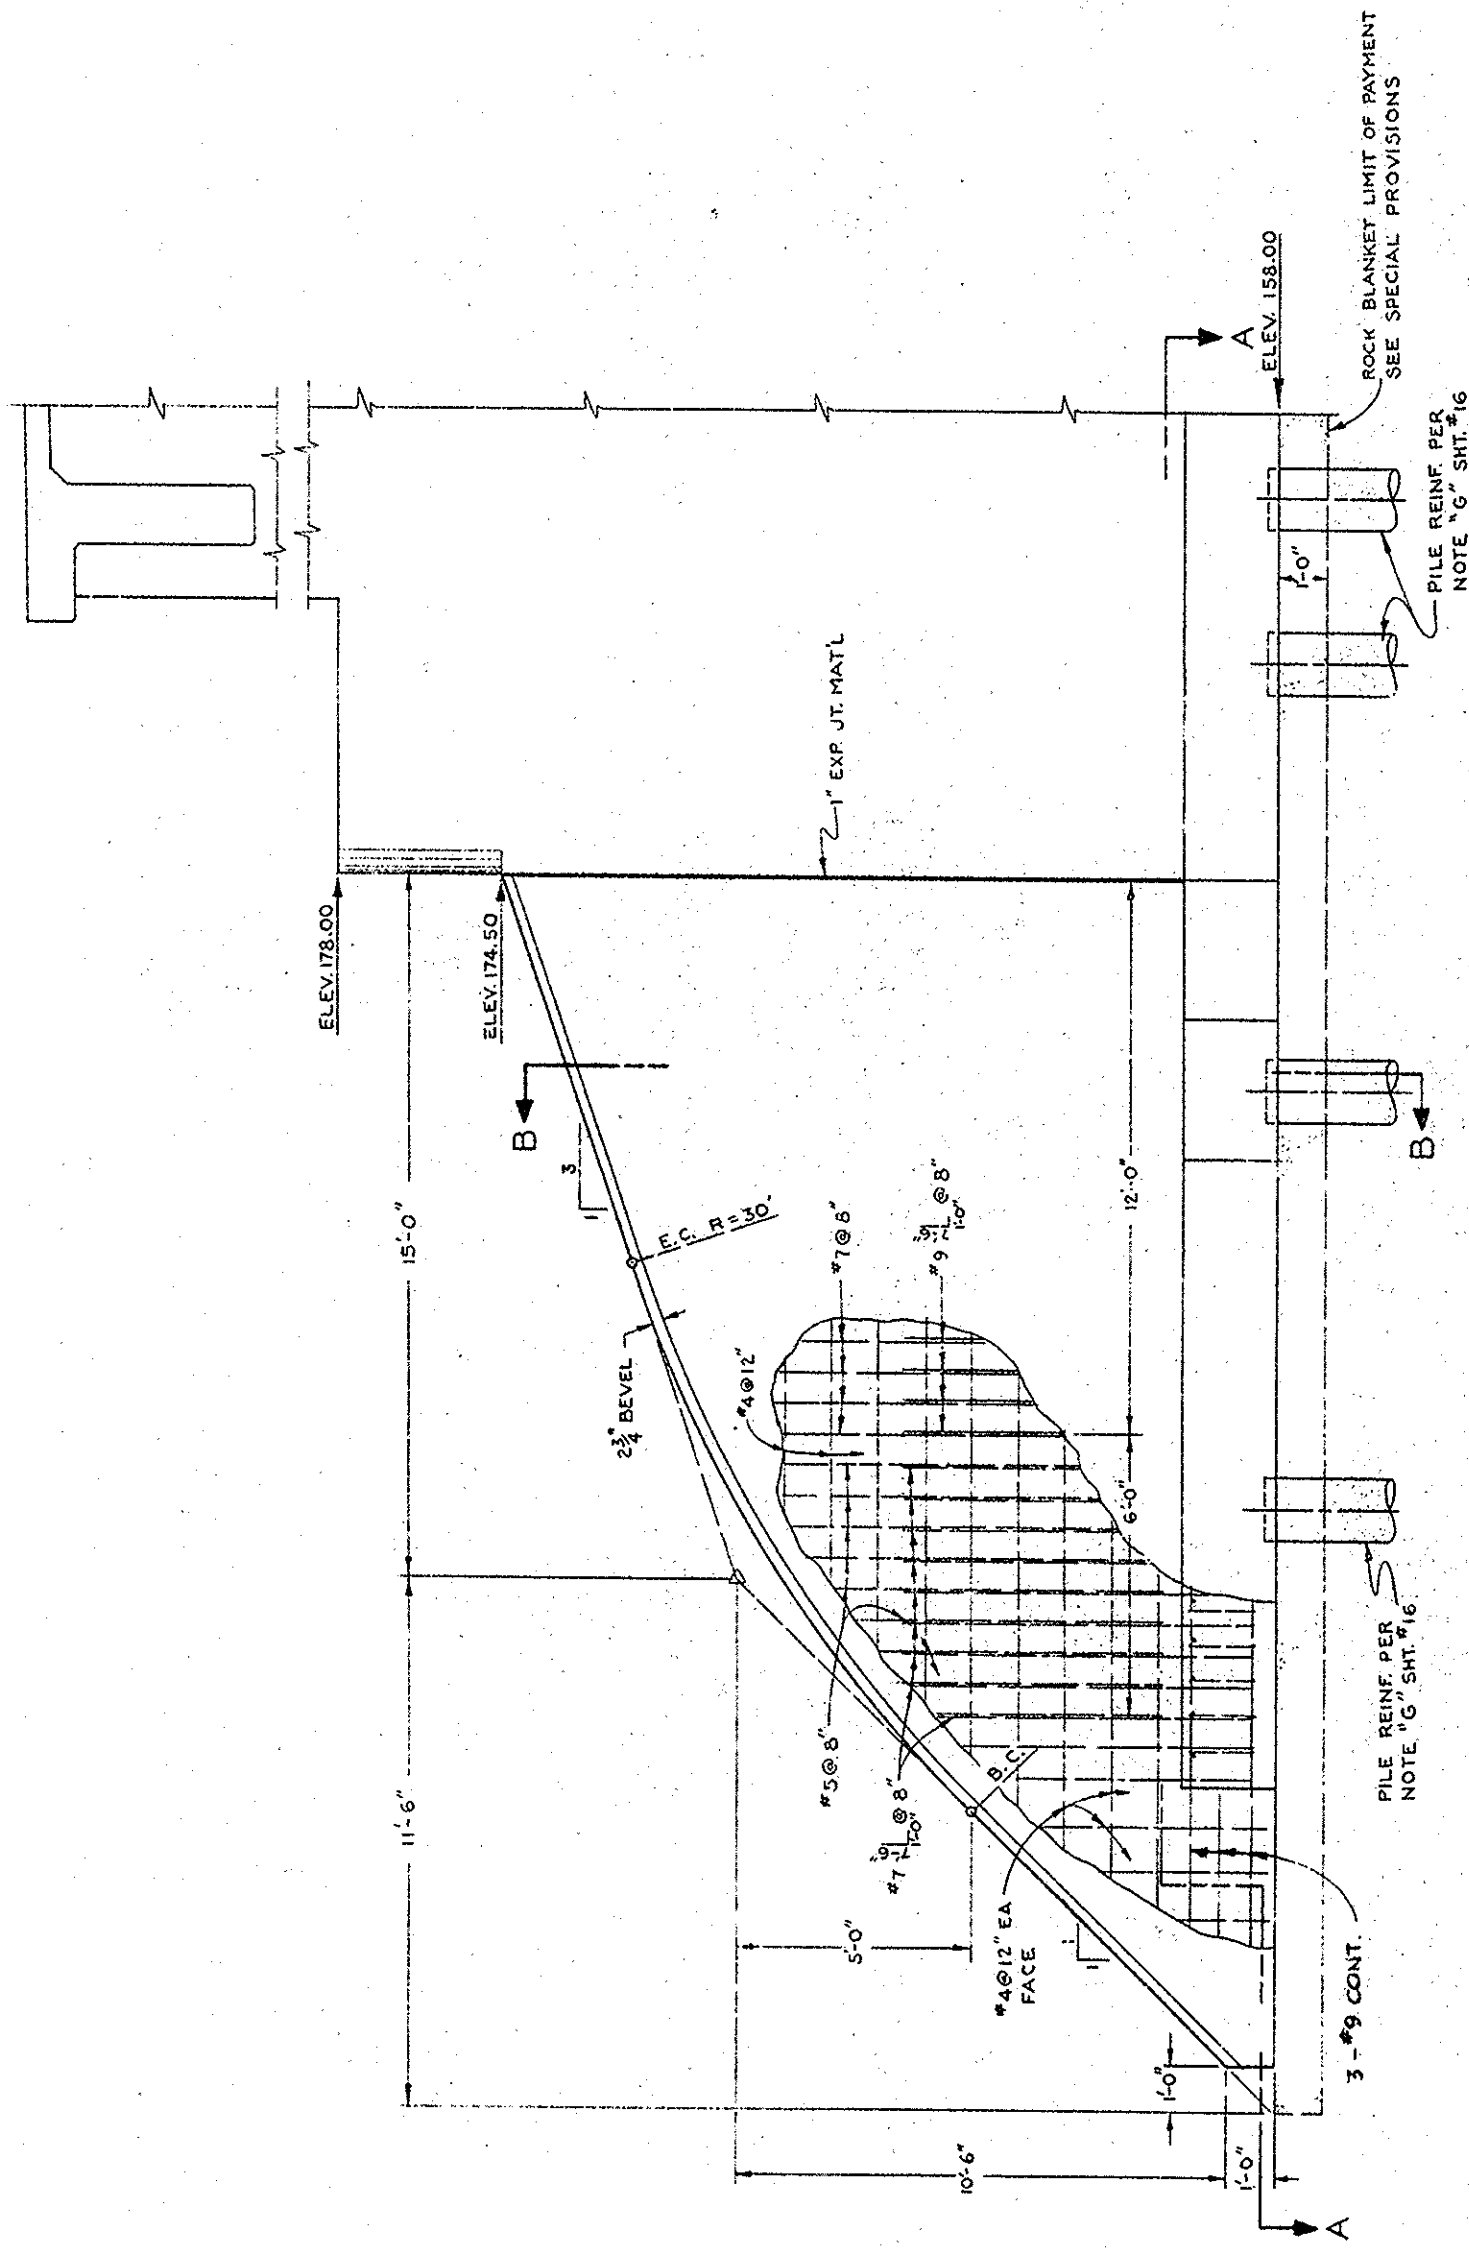

TYPICAL PIER EXTENSION ELEVATION

SCALE 1/8" = 1'-0"

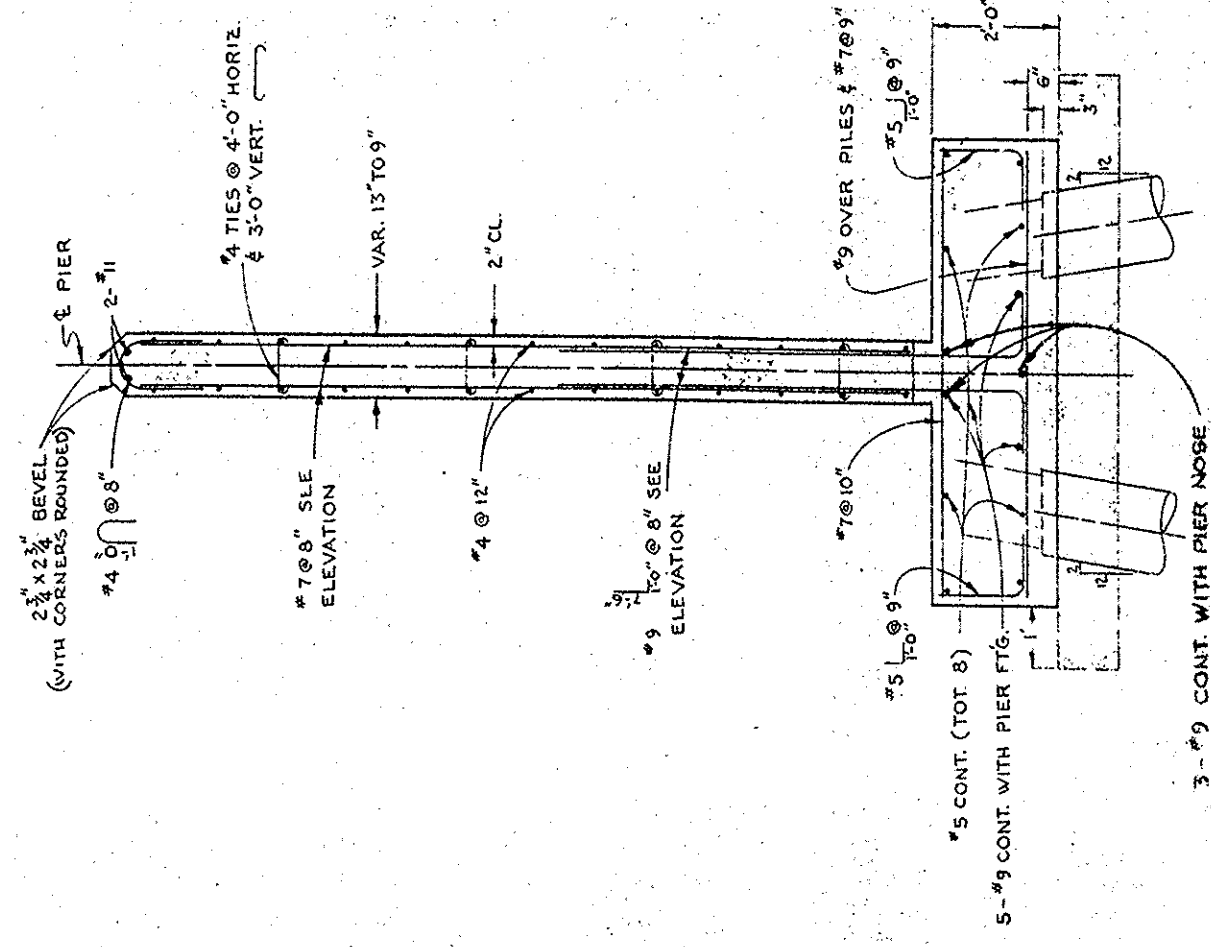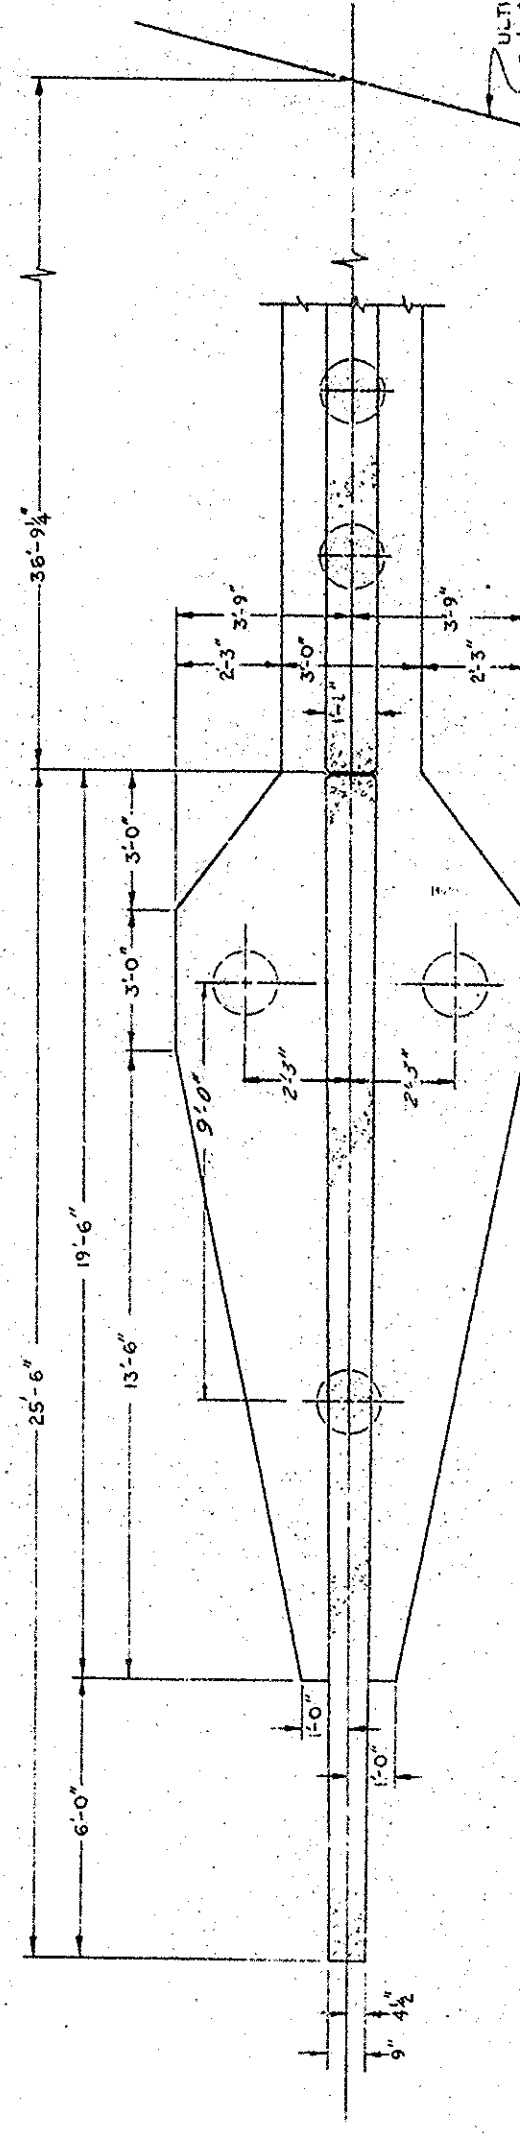

SECTION B-B

SCALE 1/8" = 1'-0"

SECTION A-A

SCALE 1/8" = 1'-0"

AS BUILT

ORANGE COUNTY ROAD DEPARTMENT
BALL ROAD
BRIDGE SA-12
ACROSS
SANTA ANA RIVER
PIER EXTENSION DETAIL

Plan 80214
Ball Road Bridge
Sheet 9 of 16 Series 13/14-1-0
Rev: 2/2/11
JUL 1 2 1988