



EXACT®

EXACT LEVEL & ELEVATION, N.I., U.S.A.



STRAIGHT EDGE RULE

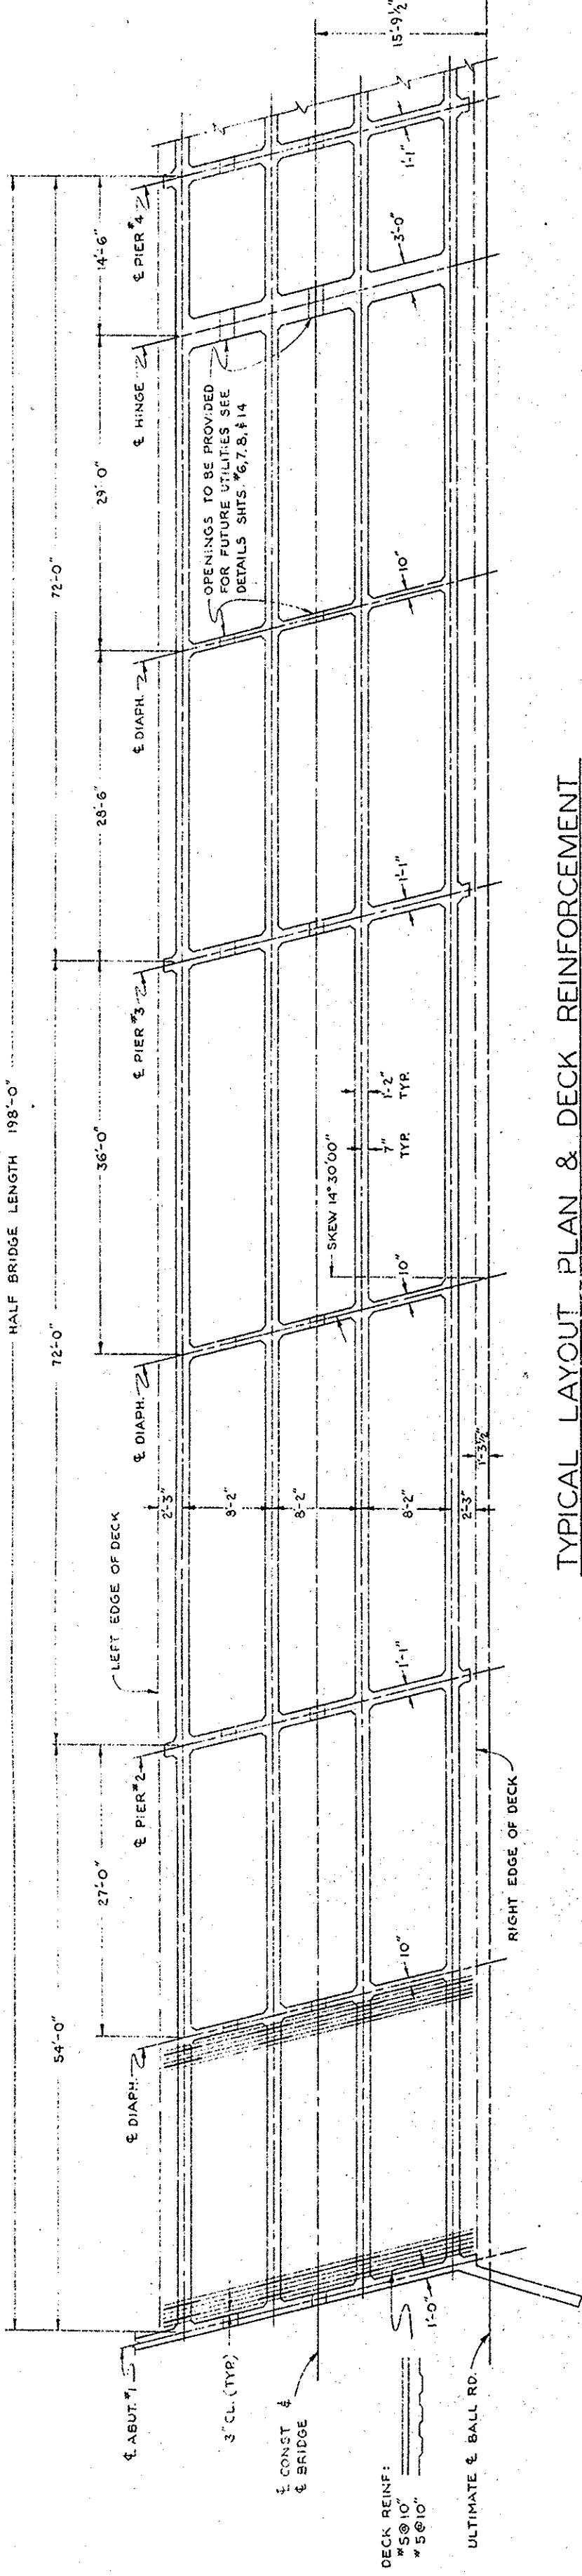

TYPICAL LAYOUT PLAN & DECK REINFORCEMENT

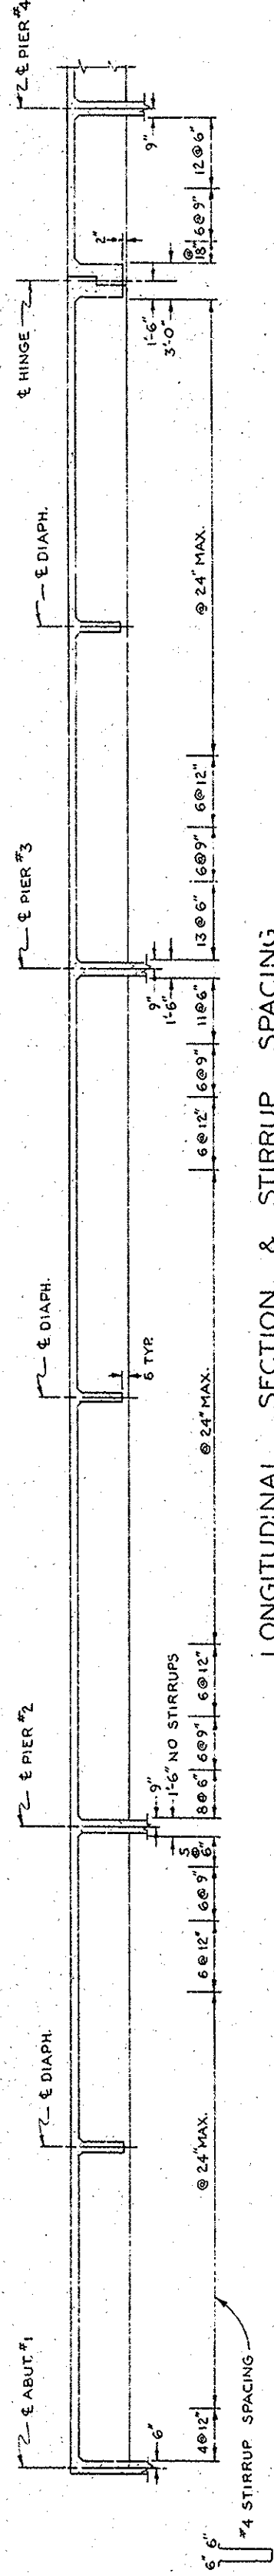

LONGITUDINAL SECTION & STIRRUP SPACING

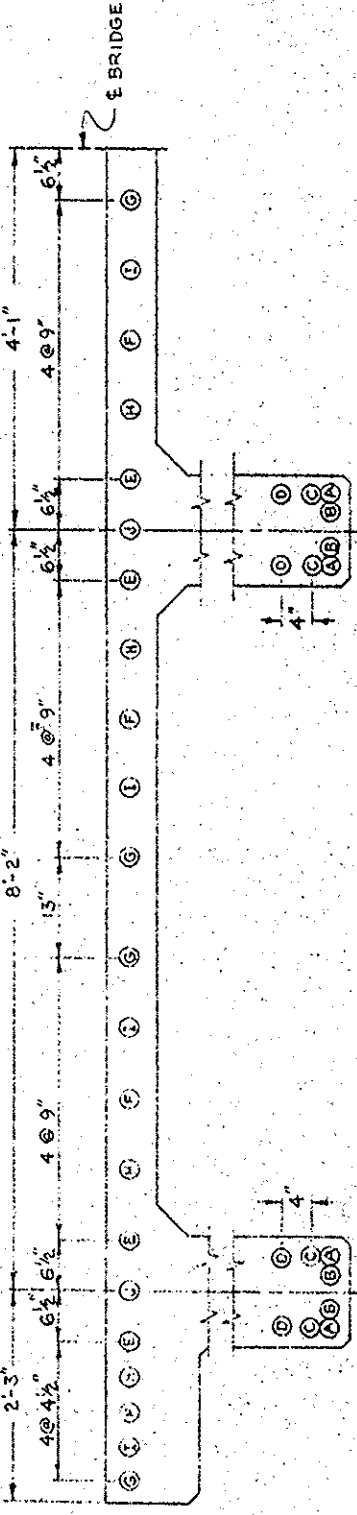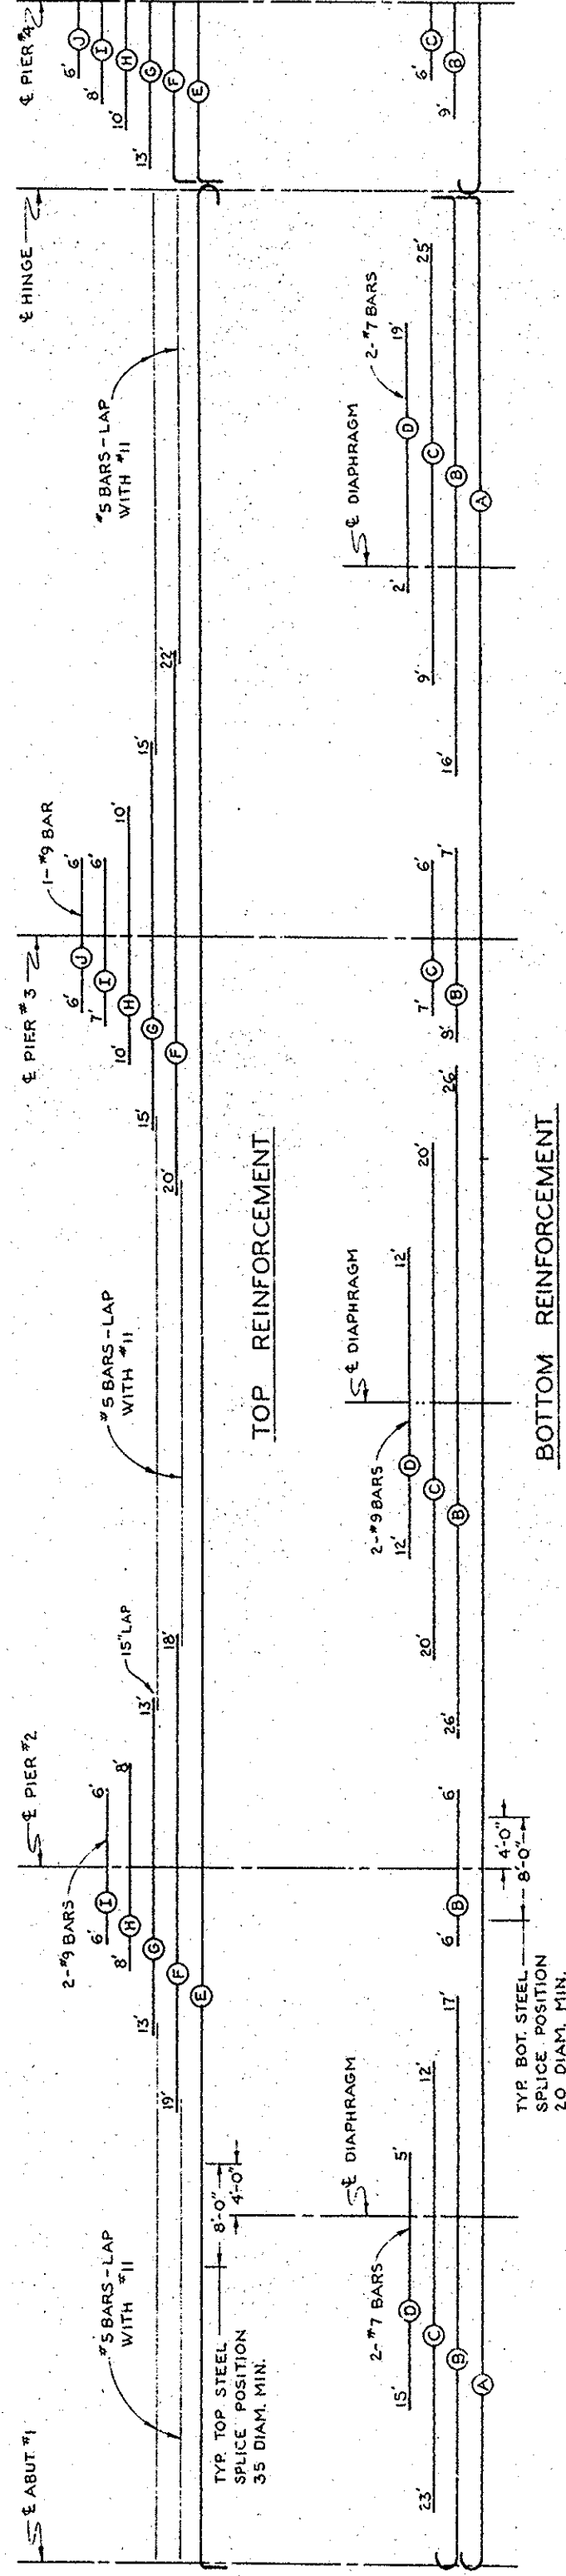

REINFORCEMENT PLACING DIAGRAM

NOTE:
ALL STEEL #11 BARS EXCEPT AS NOTED.
TOP BARS DIM. FROM E. PIER
BOTTOM BARS DIM. FROM E. DIAPHRAGM

AS BUILT

MECHANICAL
JUN 1 1959

CHAS. COUNTY ROAD DISTRICT
BALL ROAD
BRIDGE SA-12
ACROSS SANTA ANA RIVER
SUPERSTRUCTURE LAYOUT
& REINFORCEMENT

Plan #916
Full Road Bridge
Sheet 10 of 12
Scale: 1/8" = 1'-0"