

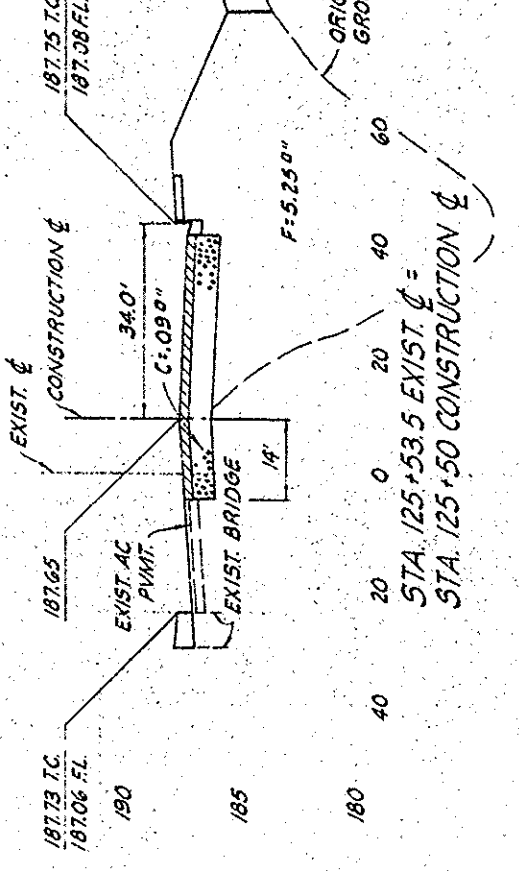
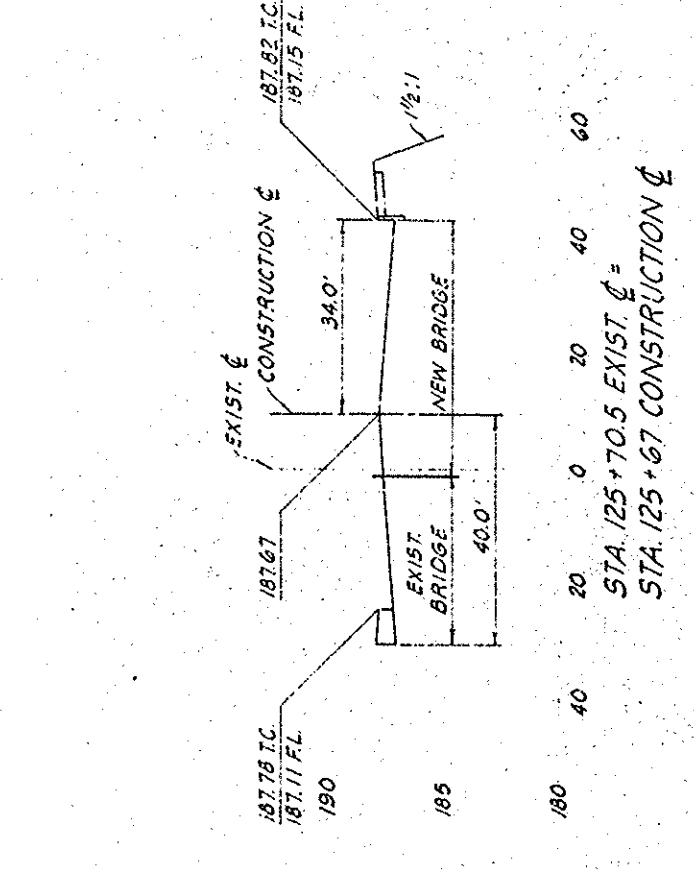


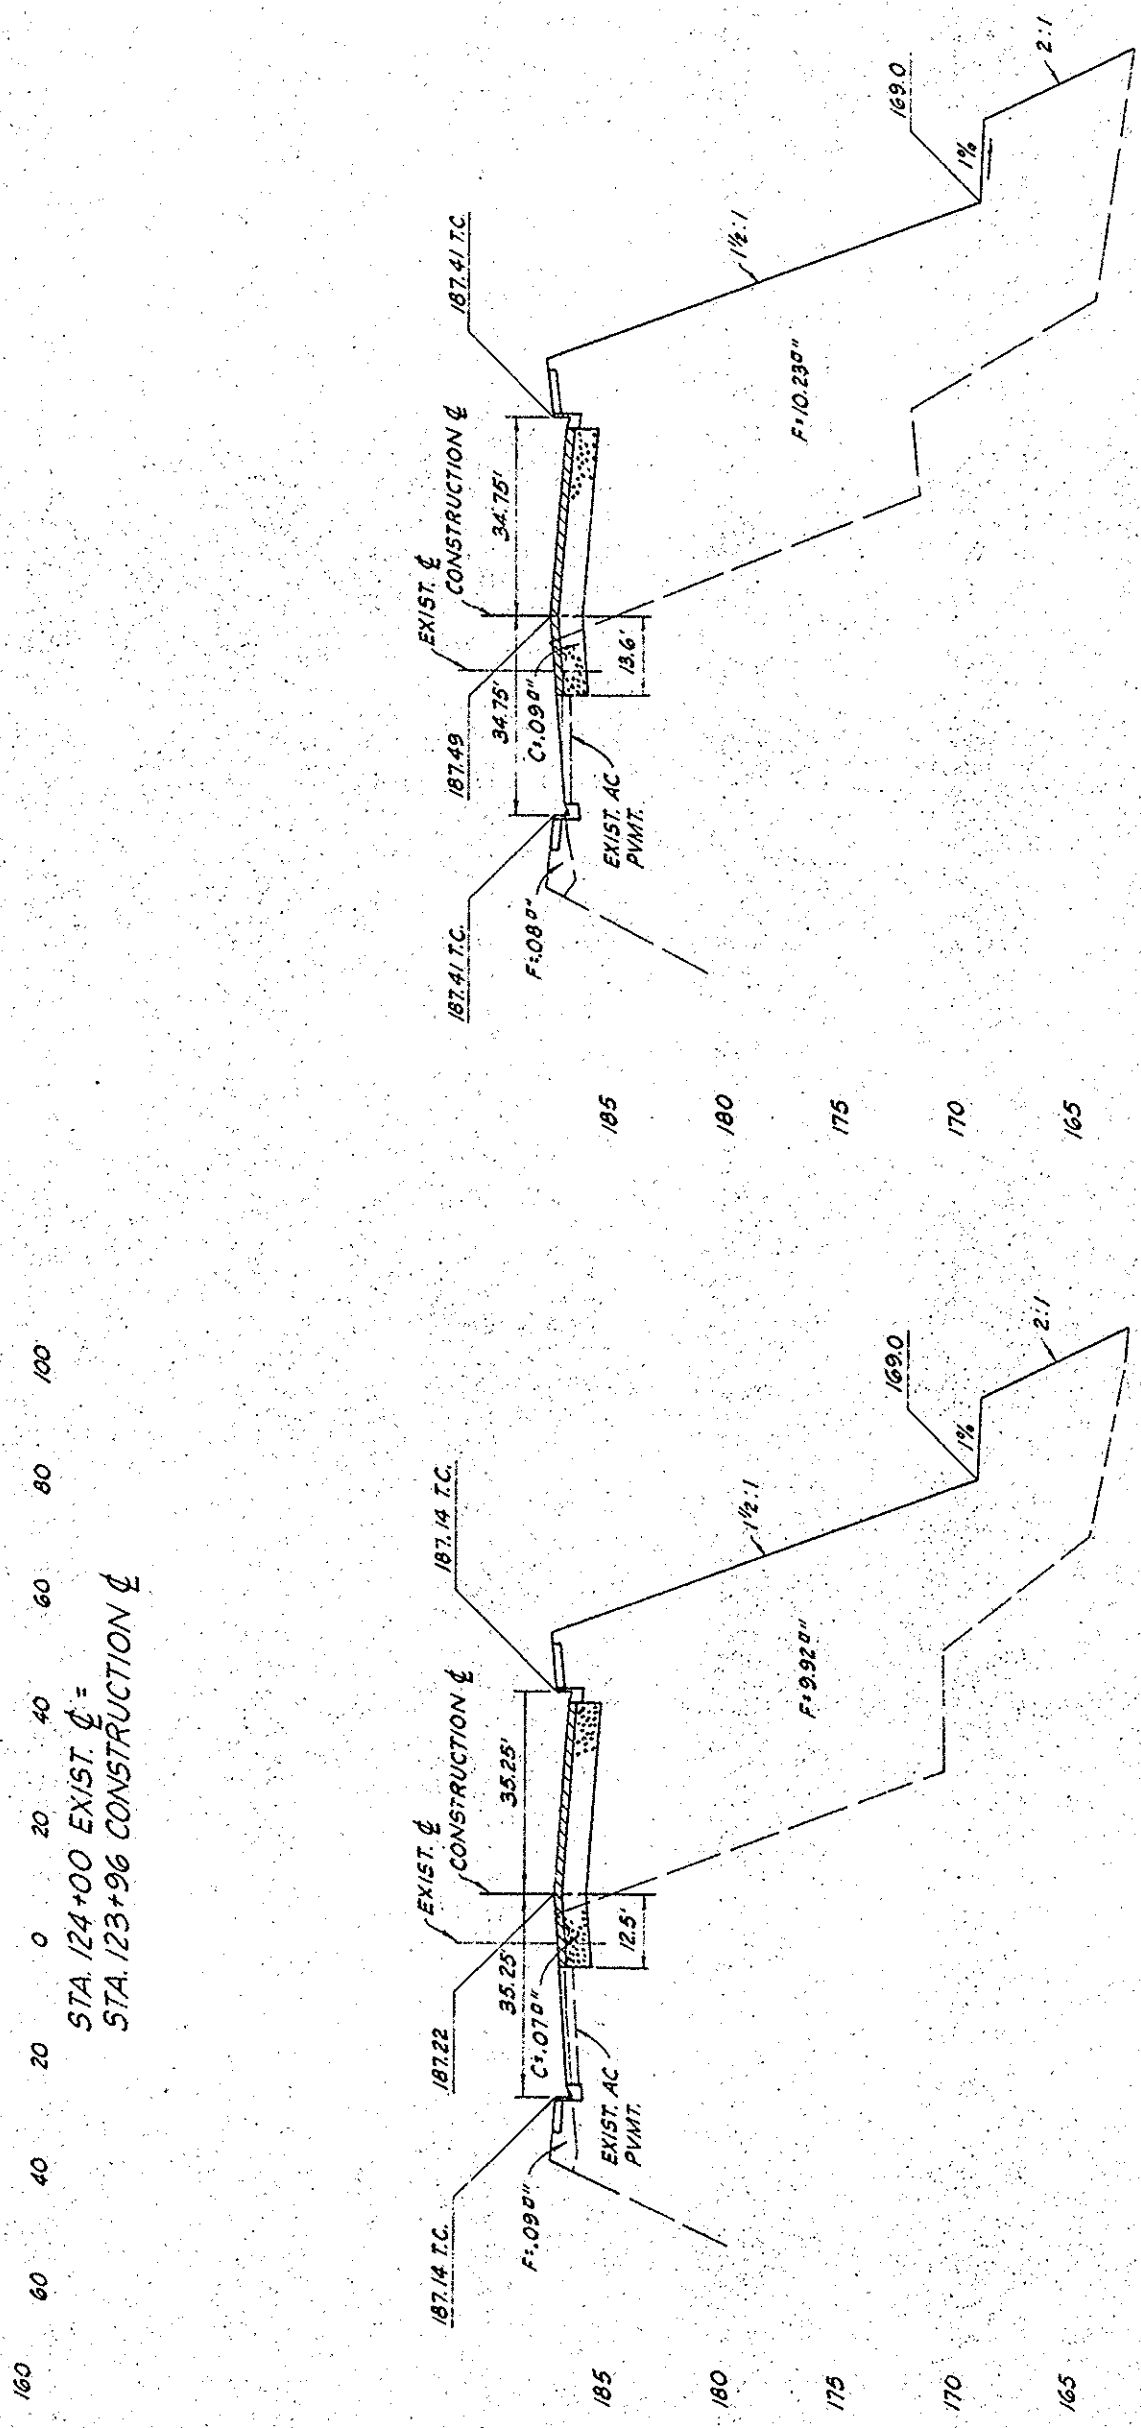

Sheet 5 of 31

DR. #2 (12241)

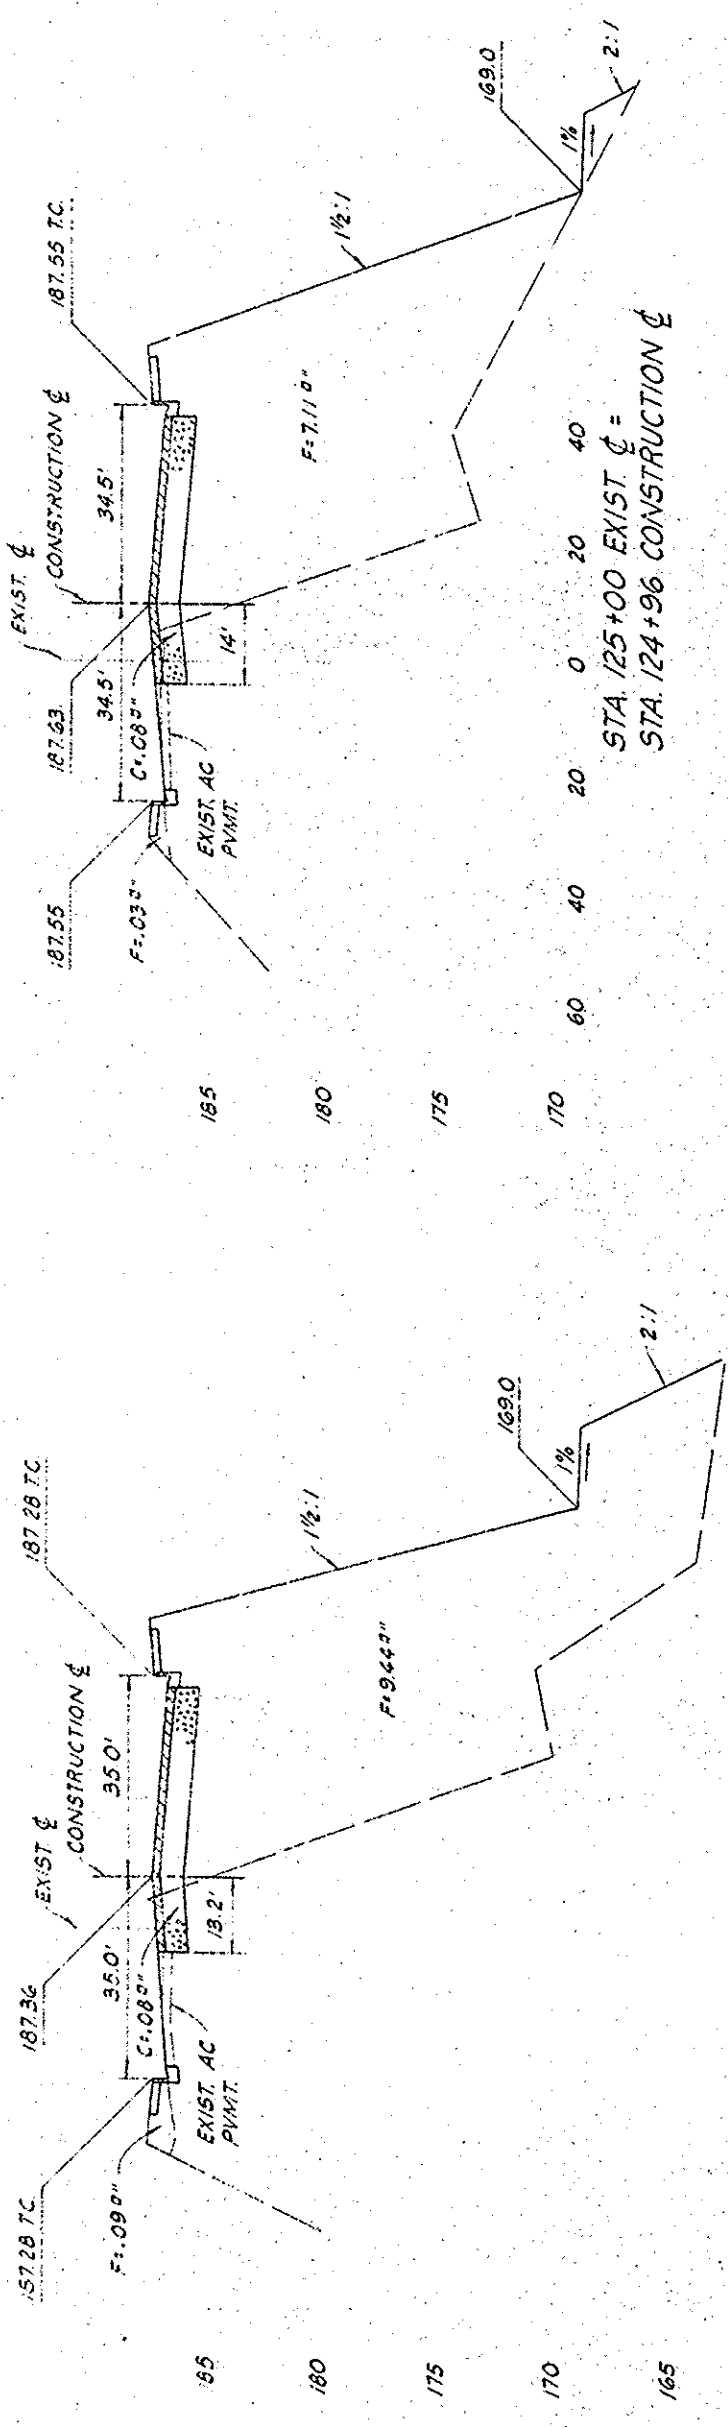