




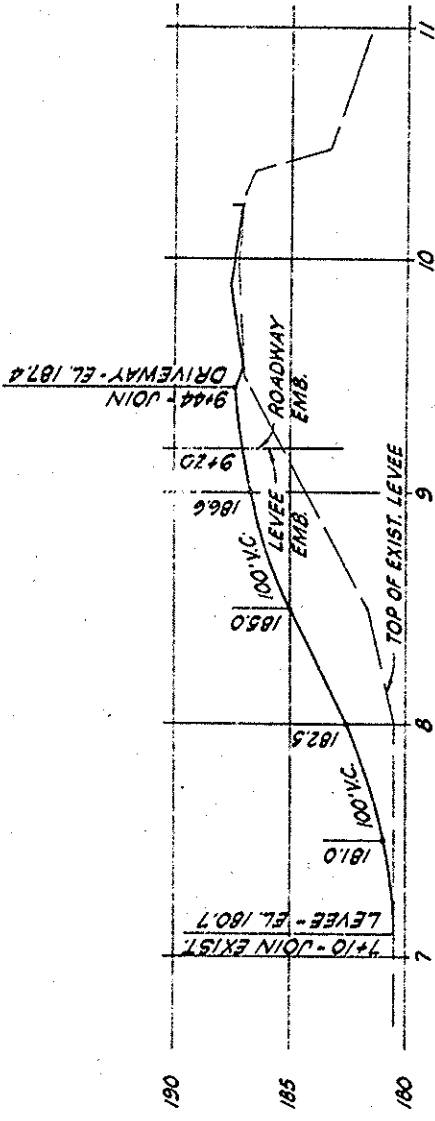


PROFILE - LEVEE WEST
SCALE: 1"=50'
VERT. 1"=5' HORIZ.

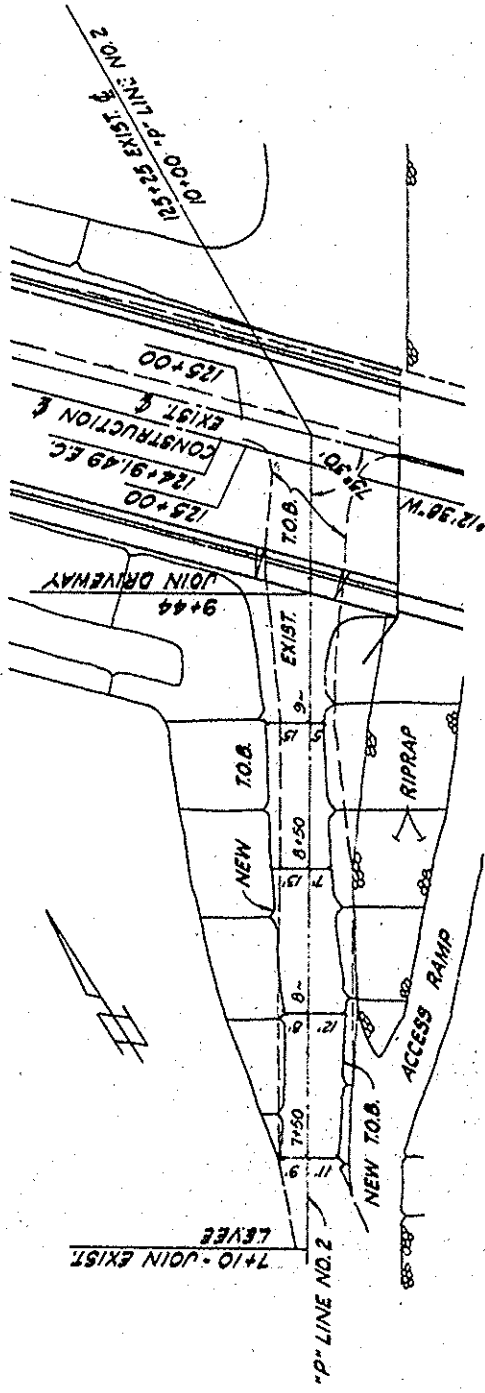

PLAN - LEVEE WEST
SCALE: 1"=40'

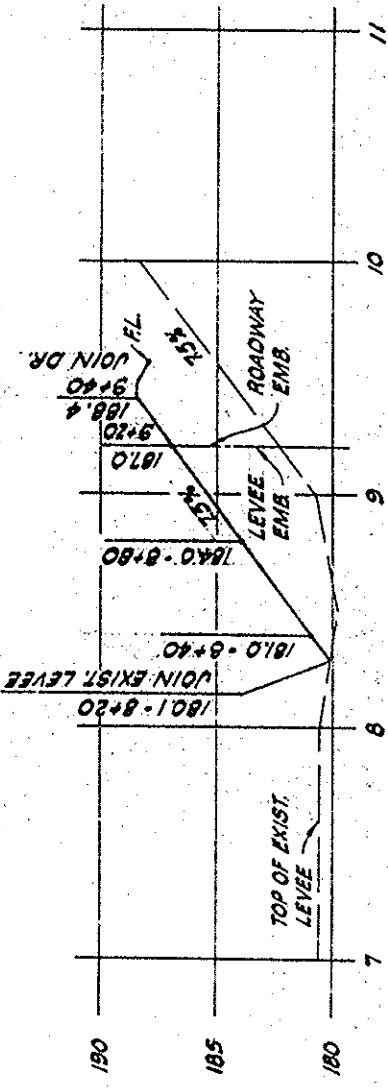


PROFILE - LEVEE EAST
SCALE: 1"=50'
VERT. 1"=5' HORIZ.

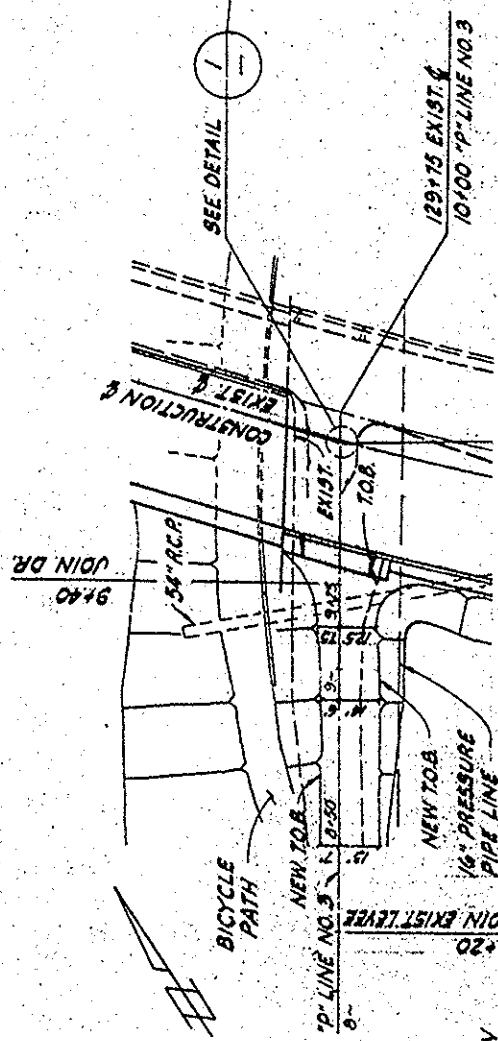


PLAN - LEVEE EAST
SCALE: 1"=40'

NOTE: SEE SHEET 5, DETAIL B FOR DETAILS OF LOCATION OF IRRIGATION LINES, VALVES, METERS, ETC.

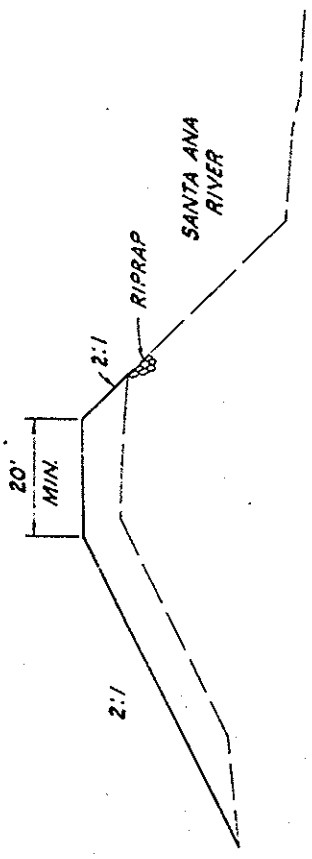


TYPICAL SECTION
LEVEE WEST
SCALE: 1"=20'

ROCK SIZES	MIN. PERCENTAGE LARGER THAN
ROUNDS	GRADED CLASSES
500	0
200	50
75	90

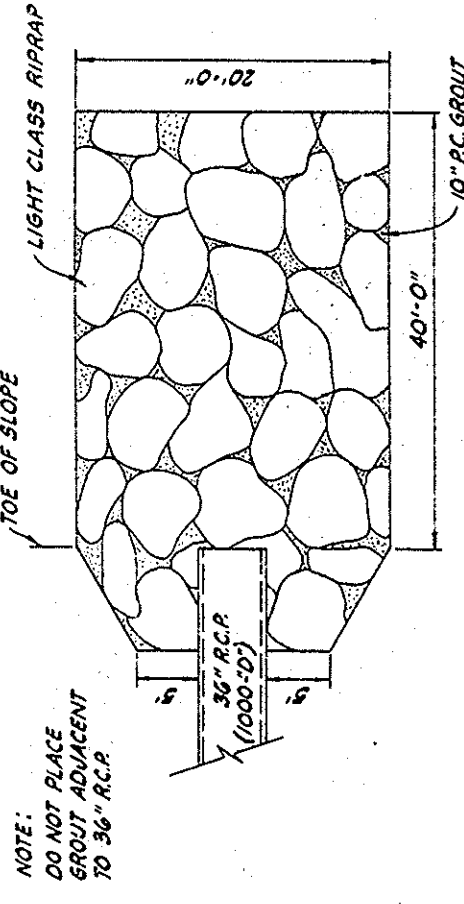


PLAN
N.T.S.


36" RCP WITH RIPRAP PROTECTION
(TO BE EXTENDED)

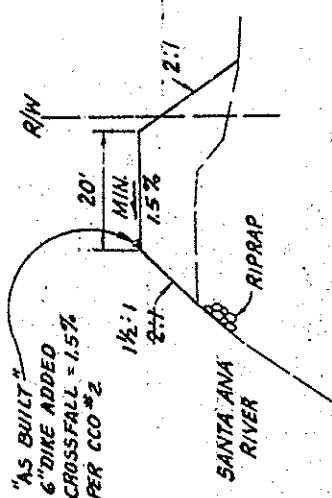

TYPICAL SECTION
LEVEE EAST
SCALE: 1"=40'

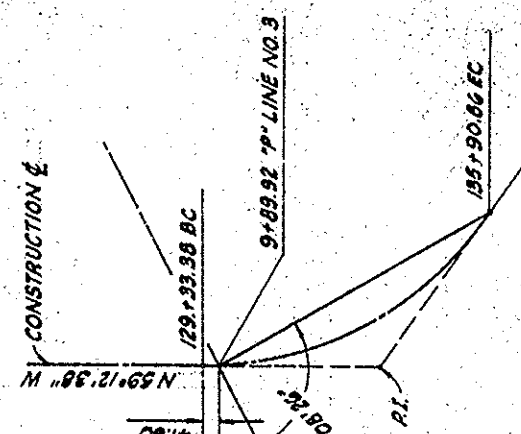

DETAIL 1
N.T.S.

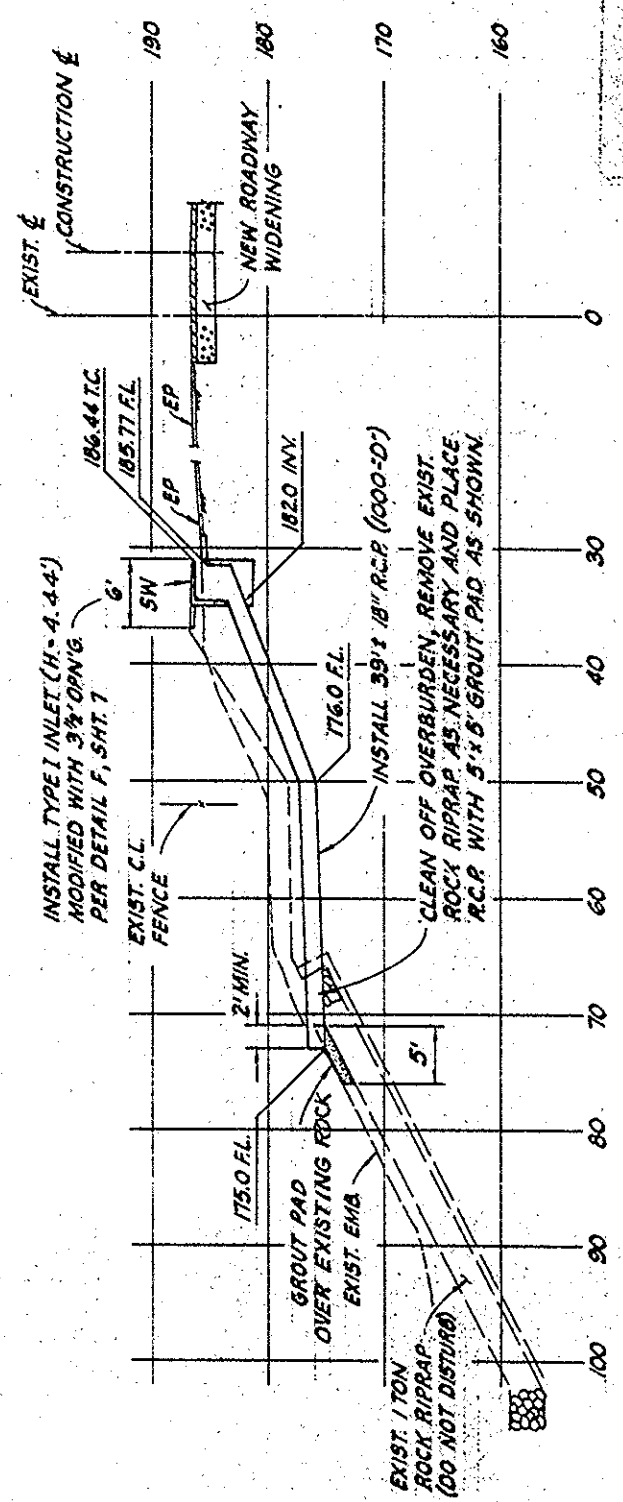

PROFILE - TYPE I INLET - DISCHARGE PIPE
SCALE: 1"=10'
HORIZ. 1"=10' VERT.

ORANGE COUNTY ROAD DEPARTMENT
BALL ROAD WIDENING
AT SANTA ANA RIVER
MISCELLANEOUS DETAILS
AS NOTED
SHEET 5 OF 31
12-2-41

DR 12-2-41

