





STA 120+50 EXIST. ∇ =
STA 120+47.75 CONSTRUCTION ∇

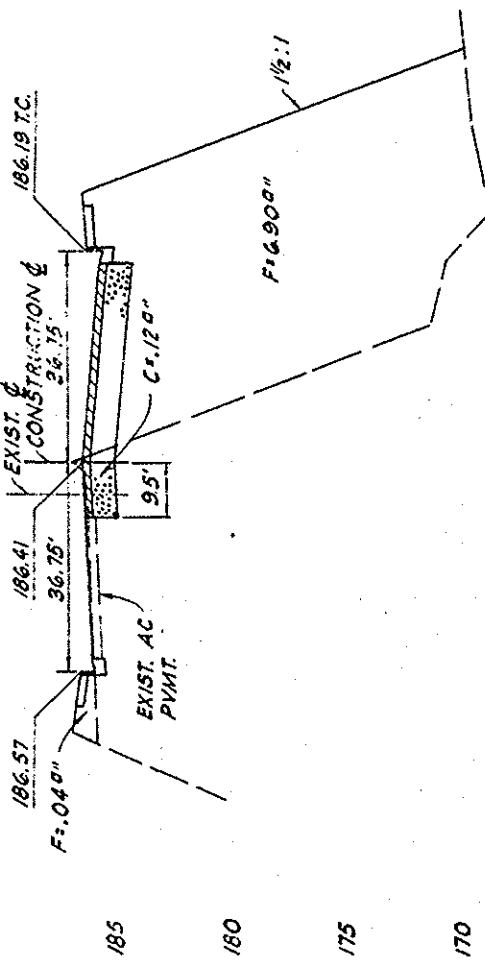

STA 120+00 EXIST. ∇ =
STA 119+98 CONSTRUCTION ∇

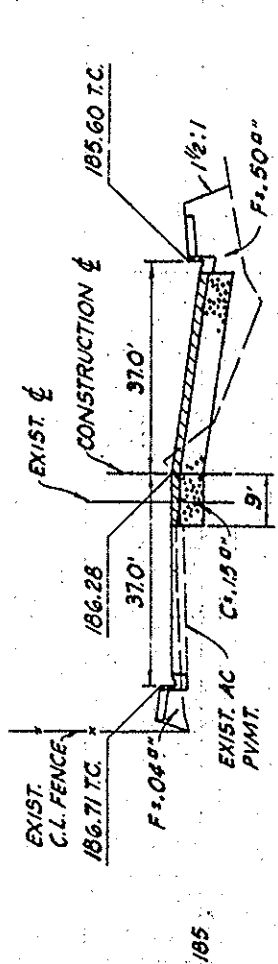


STA 119+50 EXIST. ∇ =
STA 119+48 CONSTRUCTION ∇




STA 119+00 EXIST. ∇ =
STA 118+50 EXIST. ∇




STA 118+00 EXIST. ∇ =
STA 118+00 EXIST. ∇

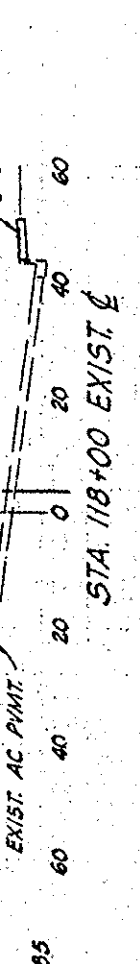

STA 121+00 EXIST. ∇ =
STA 120+97.5 CONSTRUCTION ∇

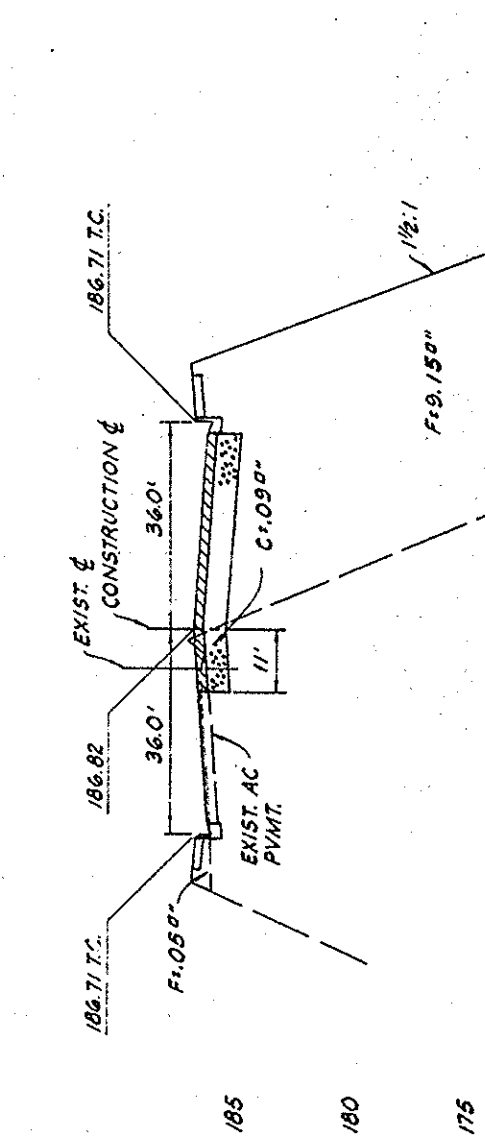


STA 122+00 EXIST. ∇ =
STA 121+97 CONSTRUCTION ∇

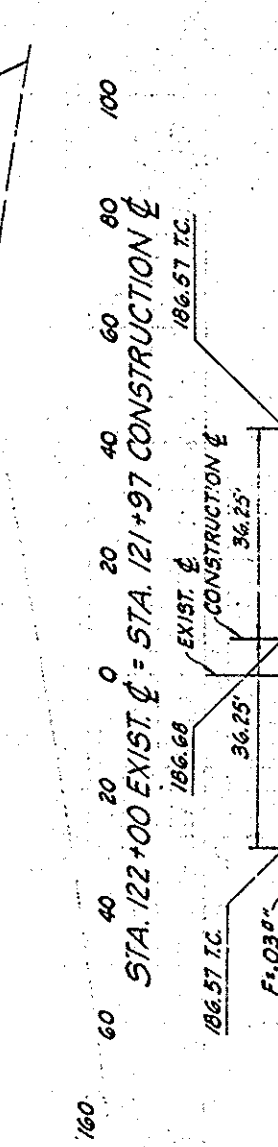


STA 122+00 EXIST. ∇ =
STA 121+97 CONSTRUCTION ∇




STA 121+50 EXIST. ∇ =
STA 121+47.25 CONSTRUCTION ∇

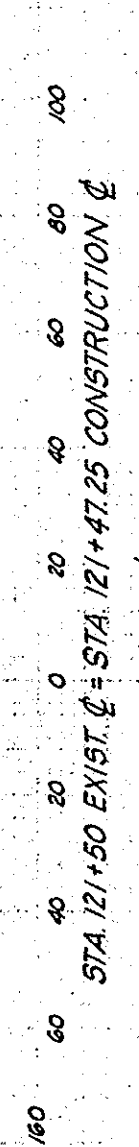


STA 122+50 EXIST. ∇ =
STA 122+46.75 CONSTRUCTION ∇

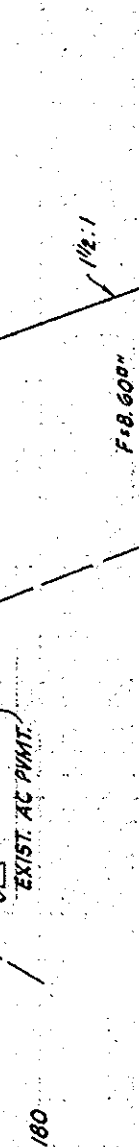


STA 122+50 EXIST. ∇ =
STA 122+46.75 CONSTRUCTION ∇

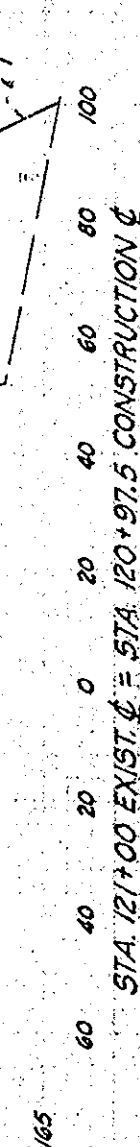

STA 122+50 EXIST. ∇ =
STA 122+46.75 CONSTRUCTION ∇

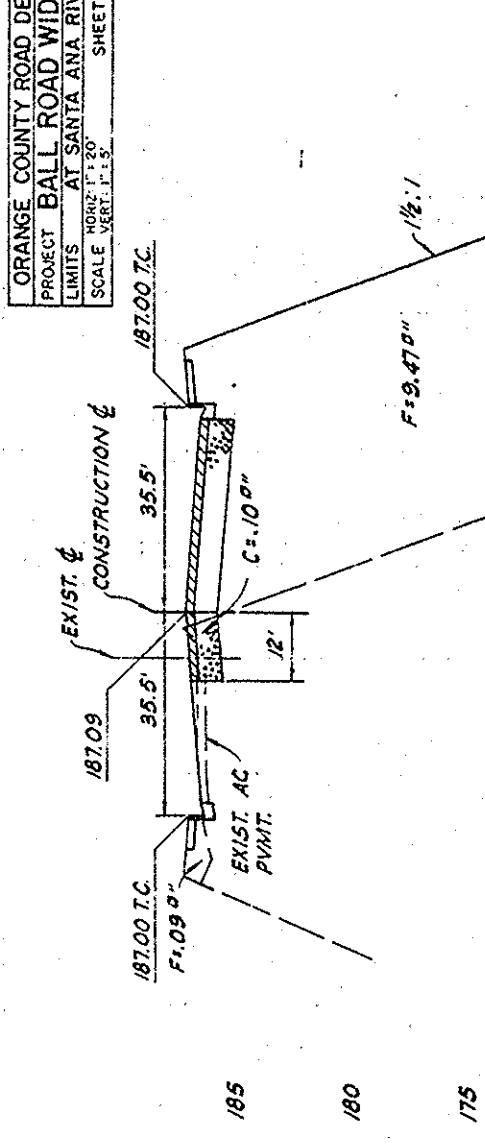


STA 123+00 EXIST. ∇ =
STA 122+96.5 CONSTRUCTION ∇

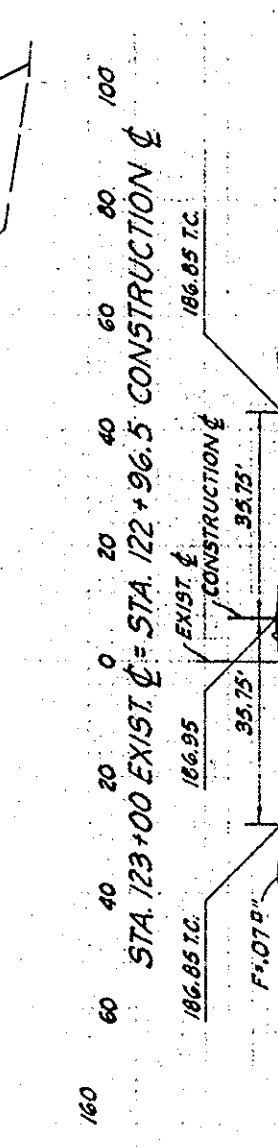

STA 123+00 EXIST. ∇ =
STA 122+96.5 CONSTRUCTION ∇



STA 123+00 EXIST. ∇ =
STA 122+96.5 CONSTRUCTION ∇

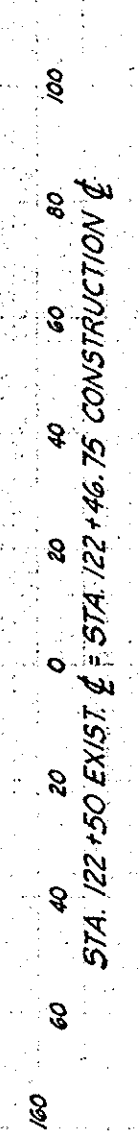

STA 123+00 EXIST. ∇ =
STA 122+96.5 CONSTRUCTION ∇



STA 123+00 EXIST. ∇ =
STA 122+96.5 CONSTRUCTION ∇



STA 123+00 EXIST. ∇ =
STA 122+96.5 CONSTRUCTION ∇

ORANGE COUNTY ROAD DEPARTMENT
PROJECT BALL ROAD WIDENING
LIMITS AT SANTA ANA RIVER
SCALE HORIZ. 1" = 20'
VERT. 1" = 5'
SHEET 8 OF 31

AS BUILT

APPROX.
BALL ROAD WIDENING
LIMITS AT SANTA ANA RIVER
SCALE HORIZ. 1" = 20'
VERT. 1" = 5'
SHEET 8 OF 31

DR. #2 C12241

