

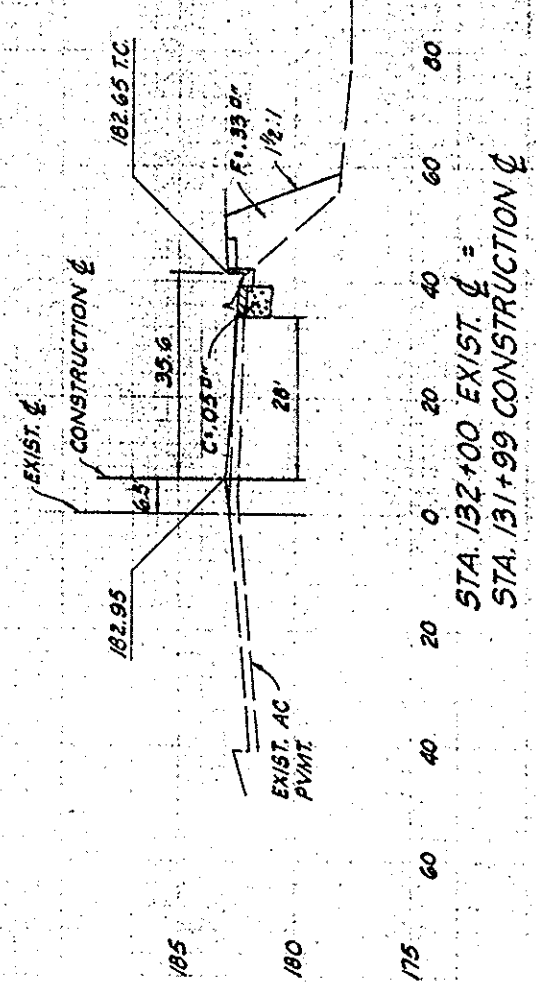
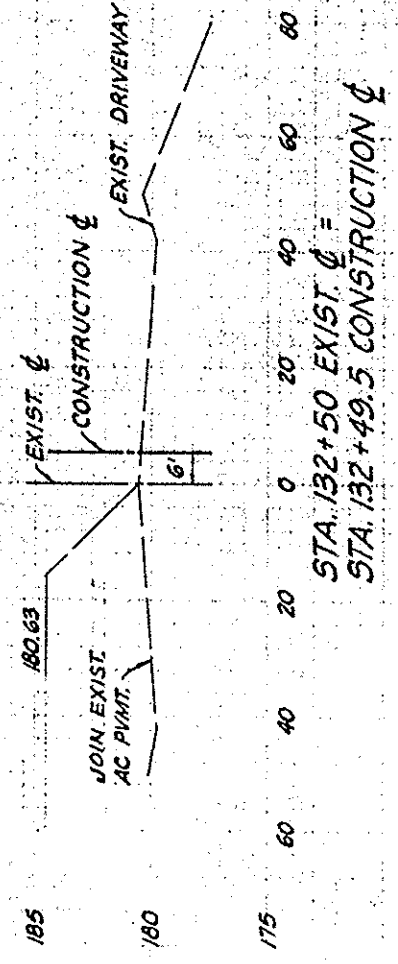
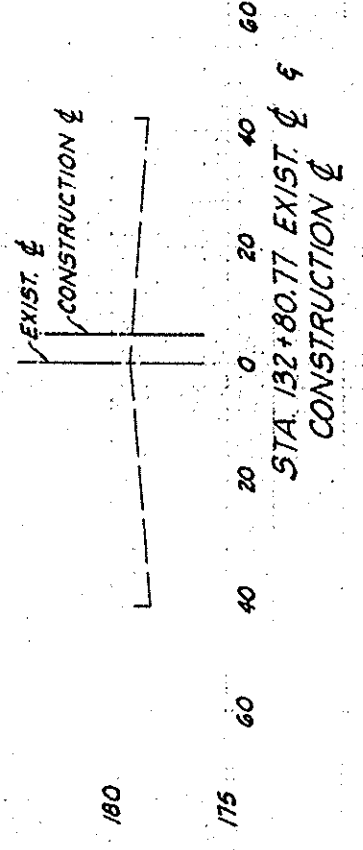
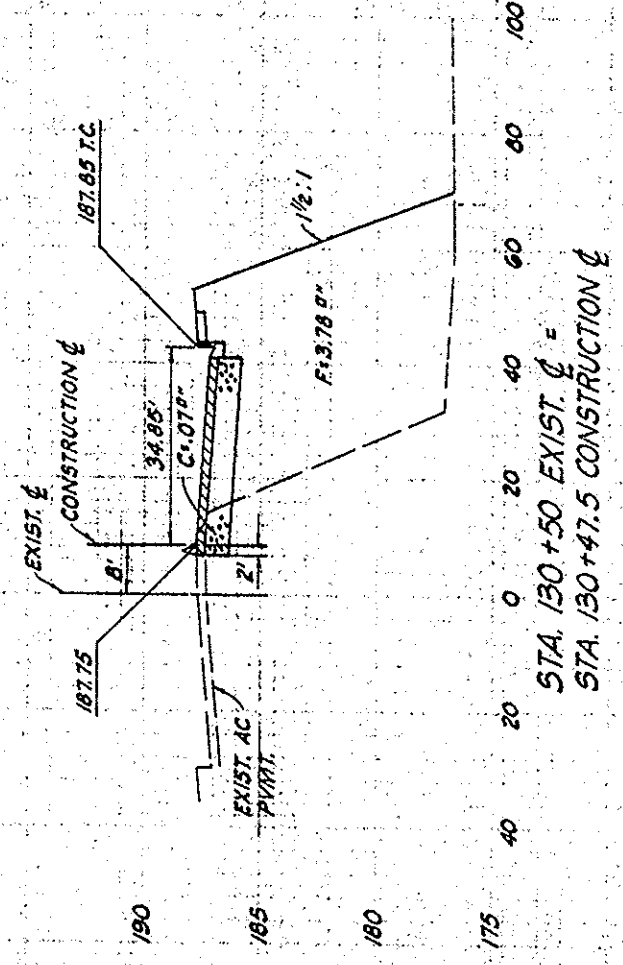
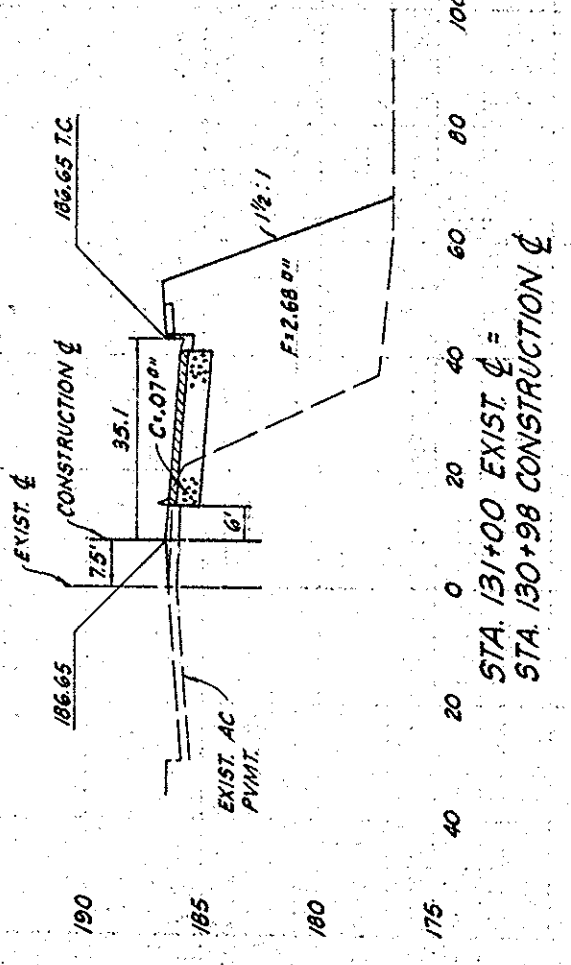
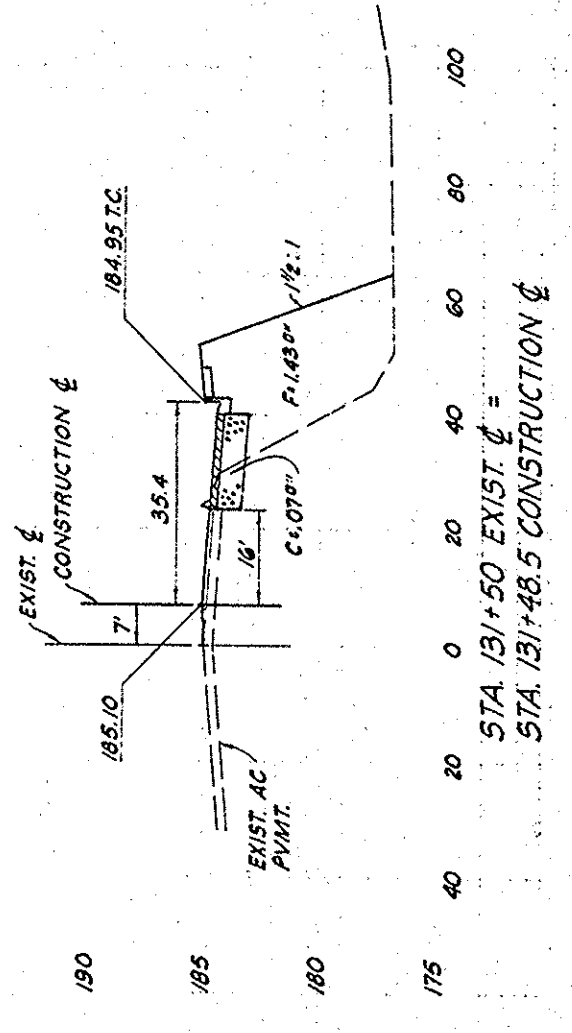
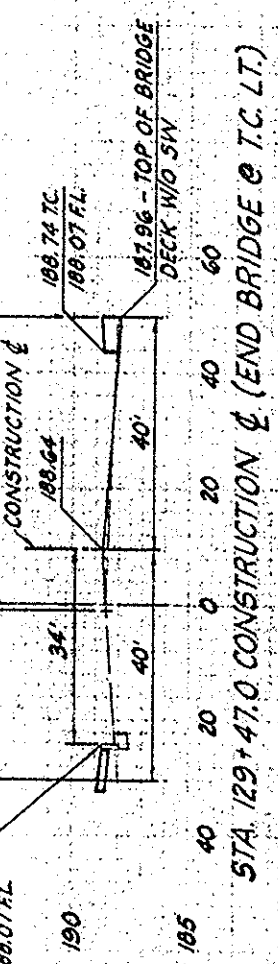


ORANGE COUNTY ROAD DEPARTMENT
 PROJECT BALL ROAD WIDENING
 LIMITS AT SANTA ANA RIVER
 SCALE HORIZONTAL 1" = 20'
 SHEET 10 OF 31

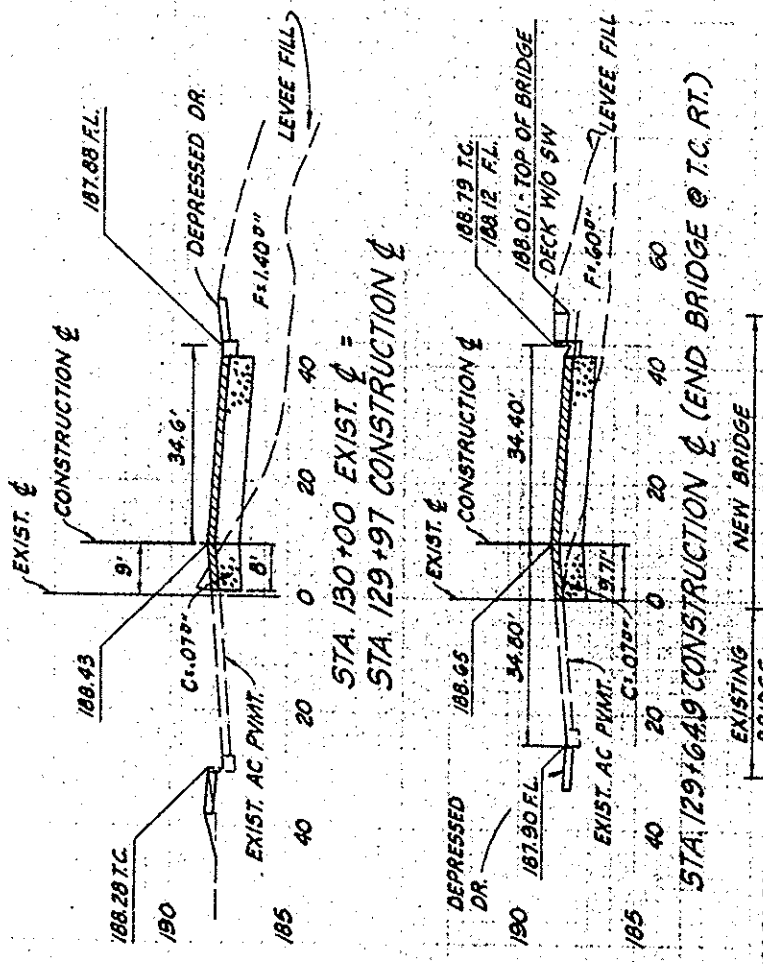

AS BUILT
 SHEET 10 OF 31
 CROSS SECTION

DR. #2 (12241)

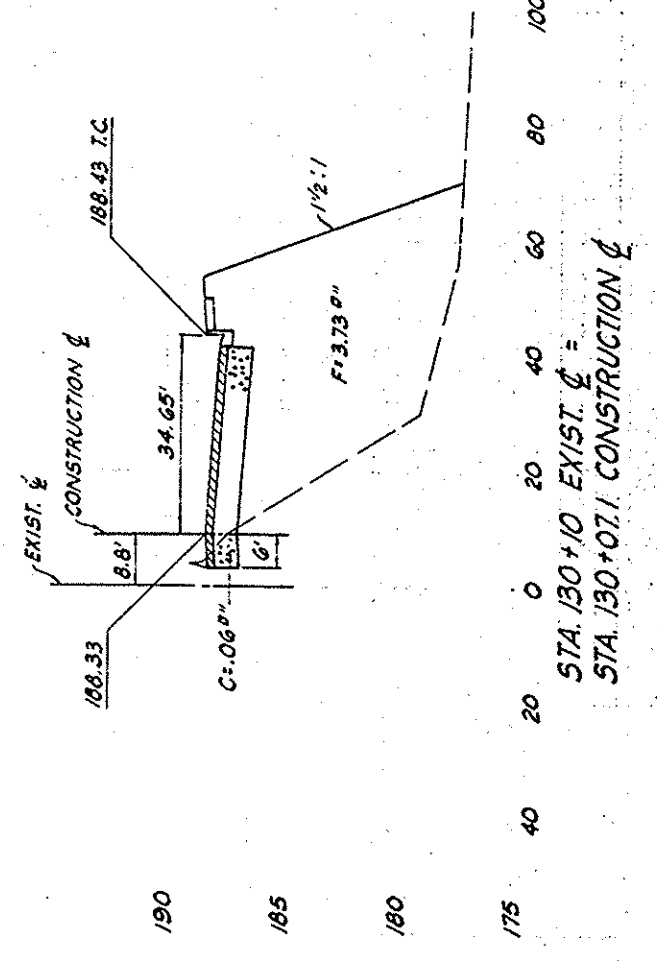