




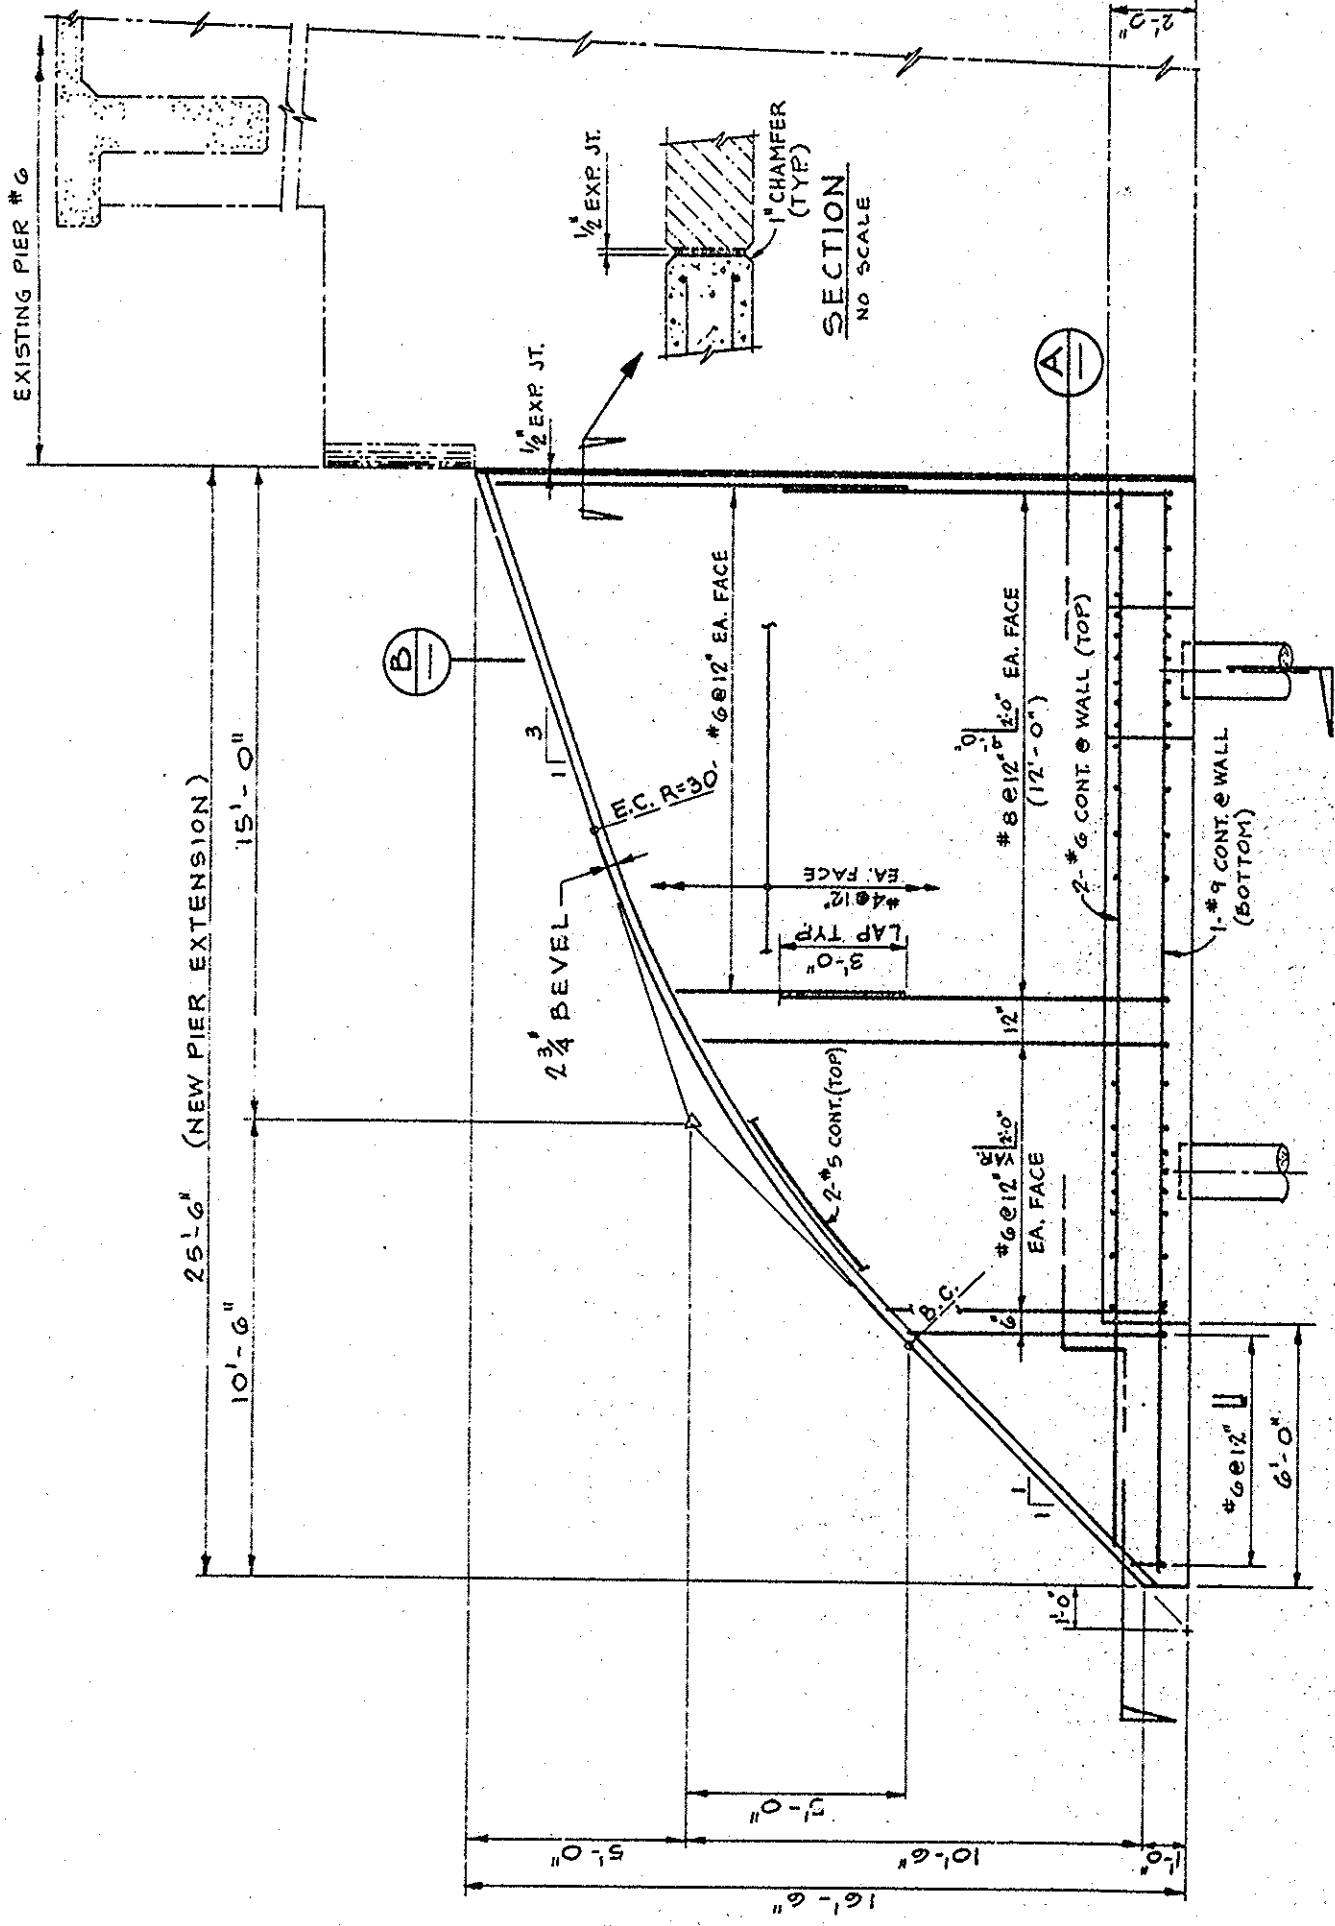


PIER No. 6 EXTENSION ELEVATION
SCALE: $\frac{3}{8}'' = 1'-0''$

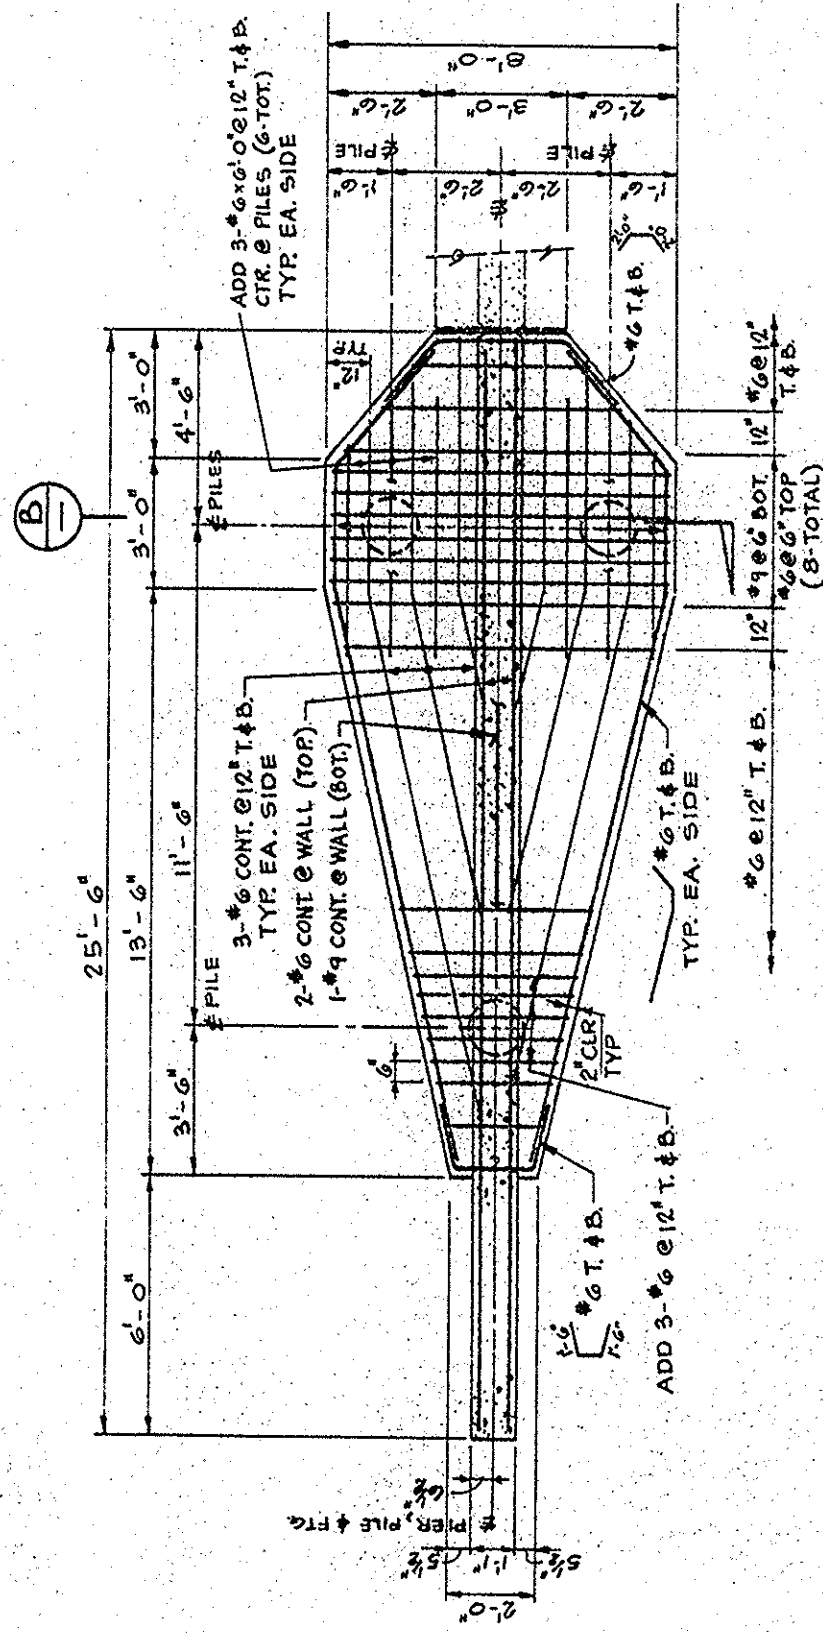


FOOTING-PLAN
PLAN SECTION A-A
SCALE: $\frac{3}{8}'' = 1'-0''$

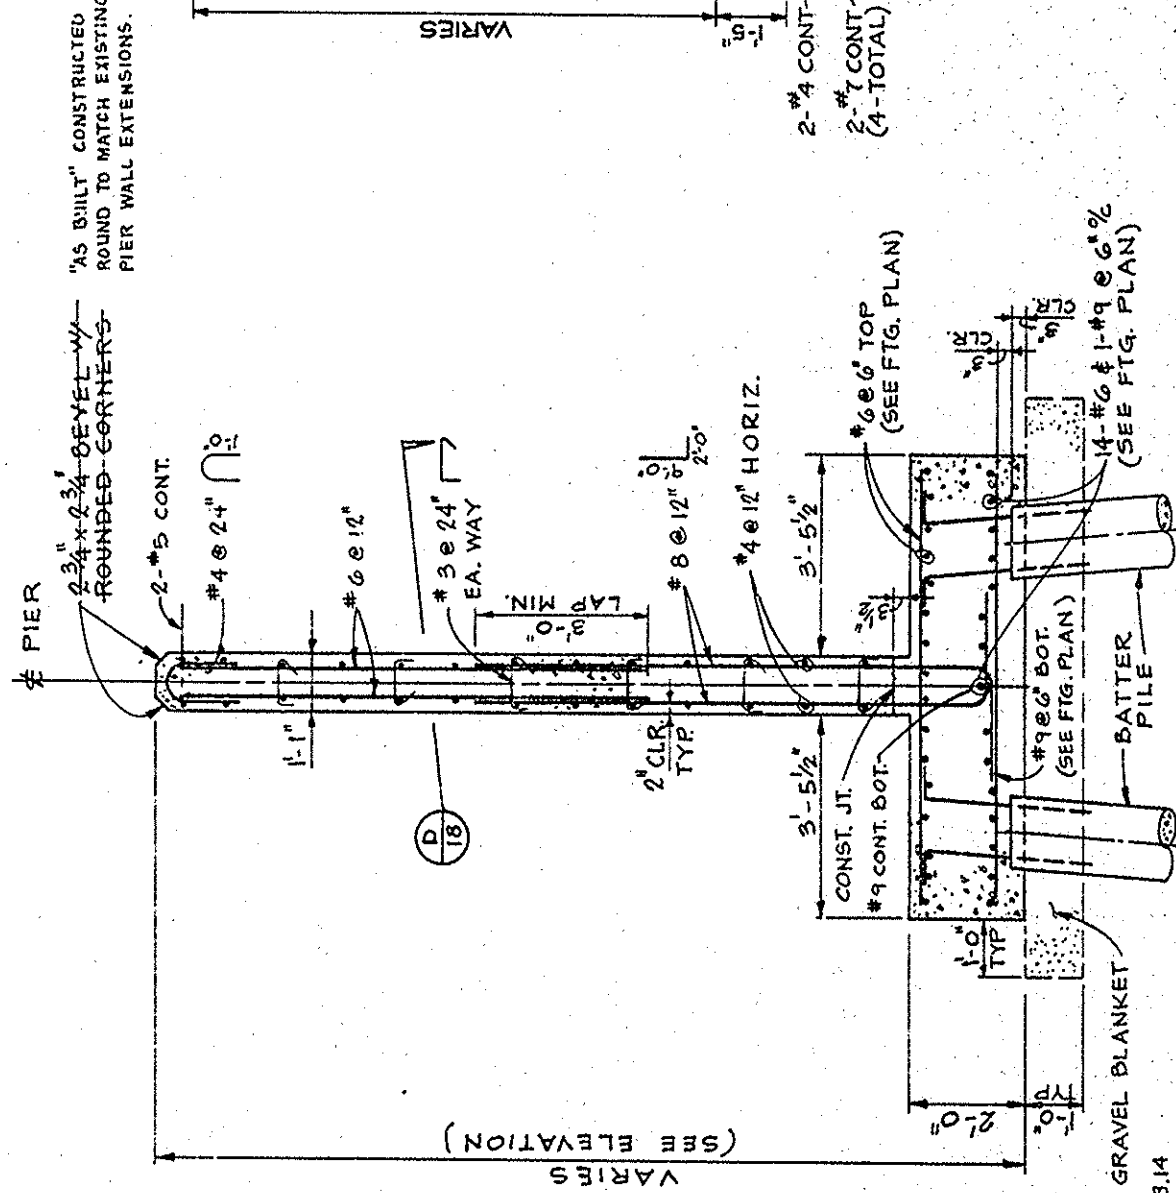

SECTION B-B
SCALE: $\frac{1}{2}'' = 1'-0''$

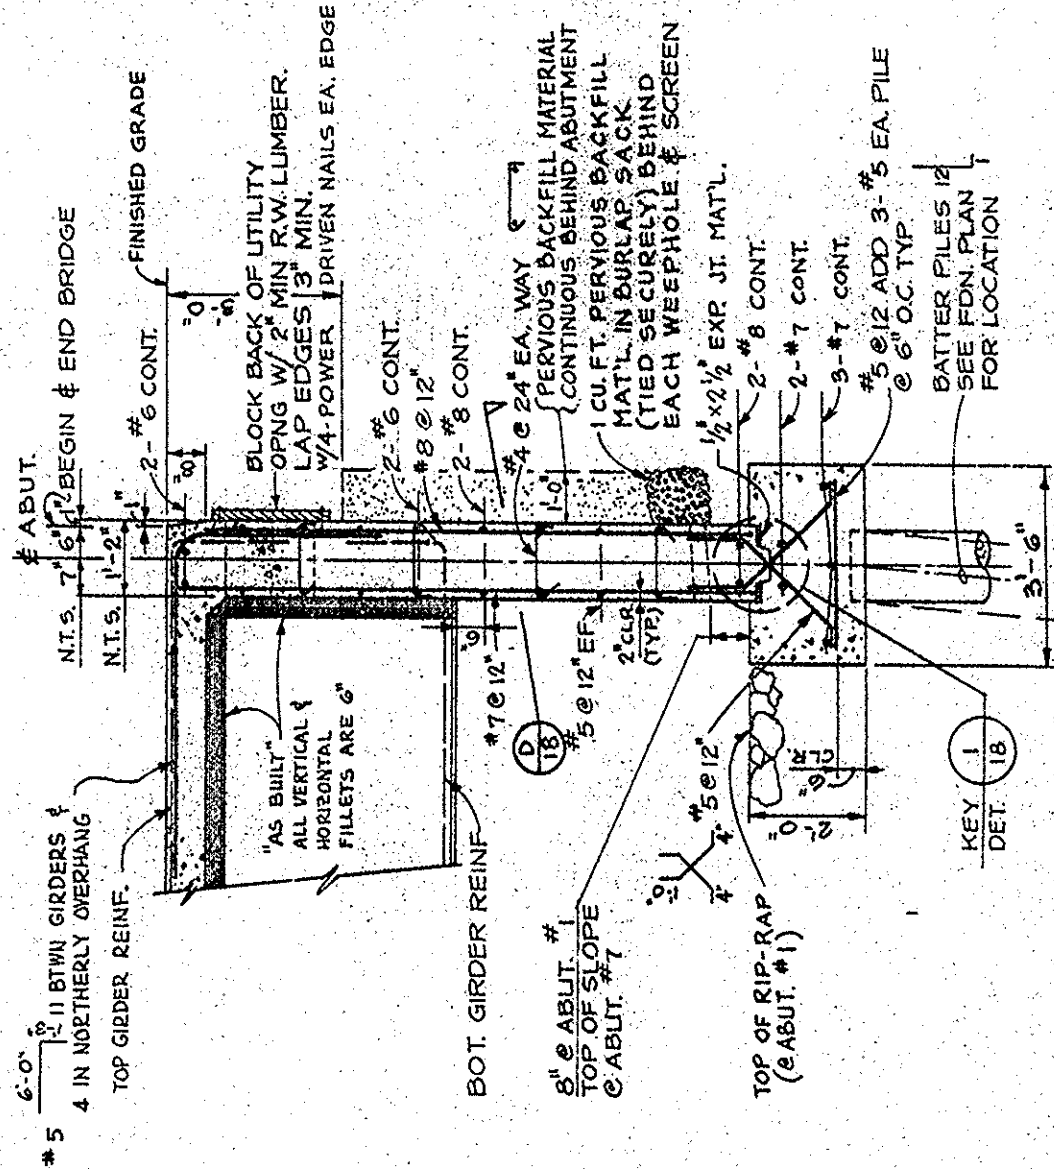

TYP ABUTMENT SECTION C-C
SCALE: $\frac{1}{2}'' = 1'-0''$

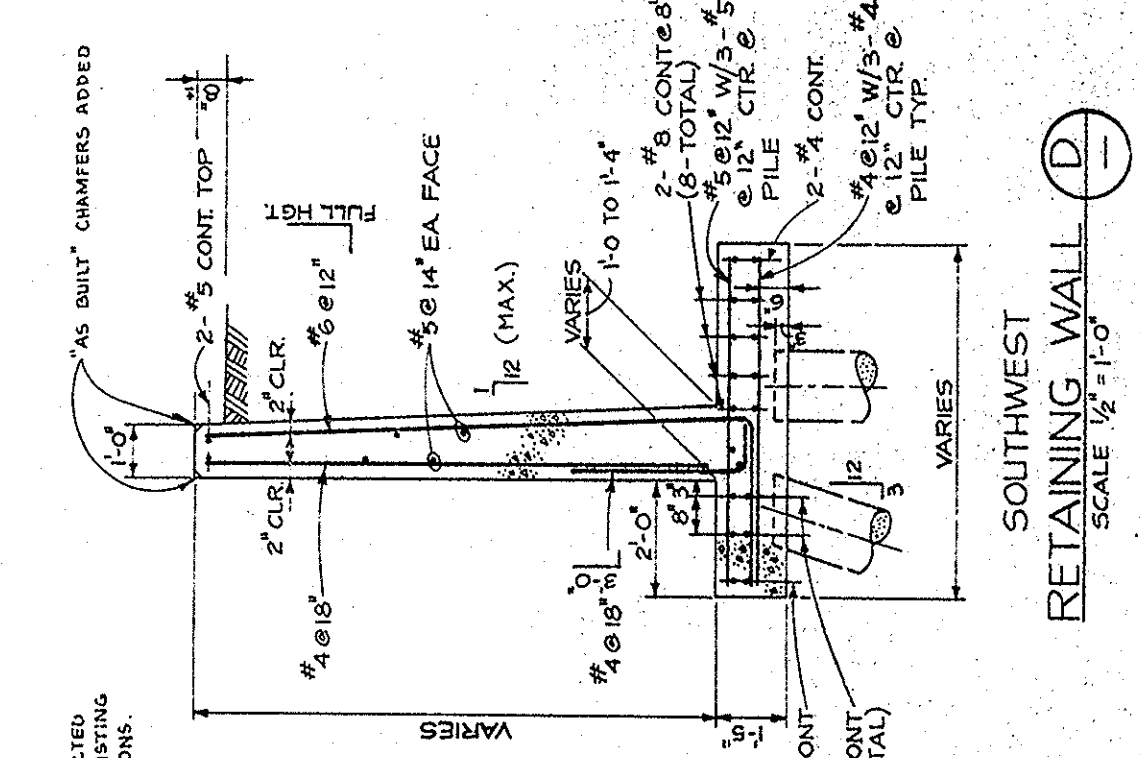

SOUTHWEST
RETAINING WALL
SCALE: $\frac{1}{2}'' = 1'-0''$

FILED
BALL ROAD BRIDGE
SANTA ANA RIVER
JUL 17 1931

ORANGE COUNTY ROAD DEPARTMENT
BALL ROAD BRIDGE
WIDENING SA-12
OVER
SANTA ANA RIVER
PIER NO. 6 NOSING EXTENSION
& MISC. DETAILS
AS NOTED
JUL 17 1931

DR 2 (12241)

