
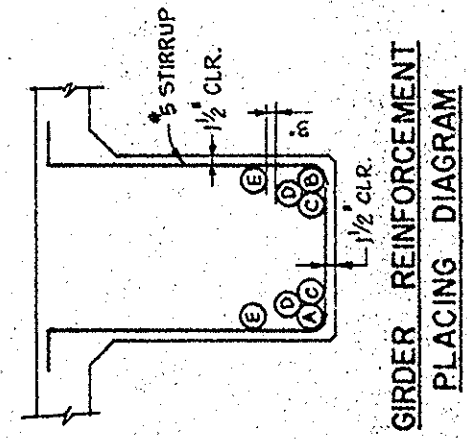


NOTE: NUMBER AT END OF BARS INDICATES DISTANCE FROM $\frac{1}{4}$ OF PIER, ABUTMENT OR $\frac{1}{4}$ OF SPAN ALL BARS NO. 11 UNLESS NOTED OTHERWISE.

GIRDER REINFORCEMENT

ORANGE COUNTY ROAD DEPARTMENT	BALL ROAD BRIDGE WIDENING SA-12	SANTA ANA RIVER	#2 GIRDER LAYOUT & REINF. - #2	AS NOTED	sheet 21 of 31
-------------------------------	------------------------------------	-----------------	-----------------------------------	----------	----------------

DR: 2 (12241)

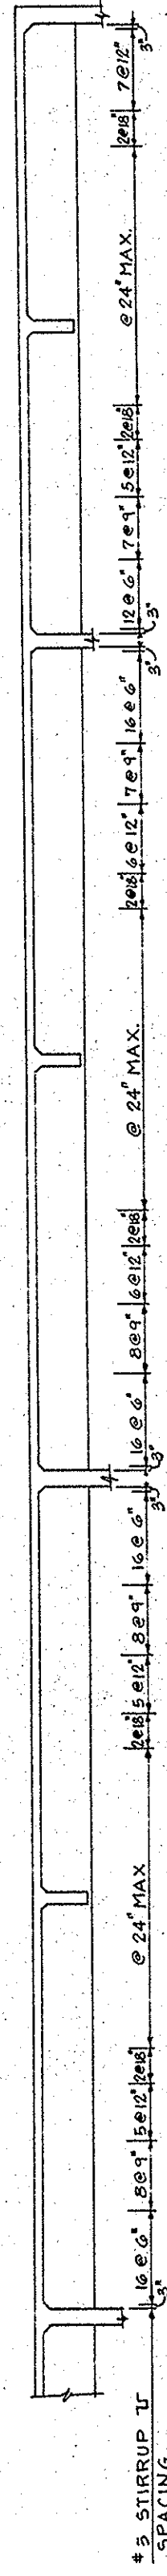