


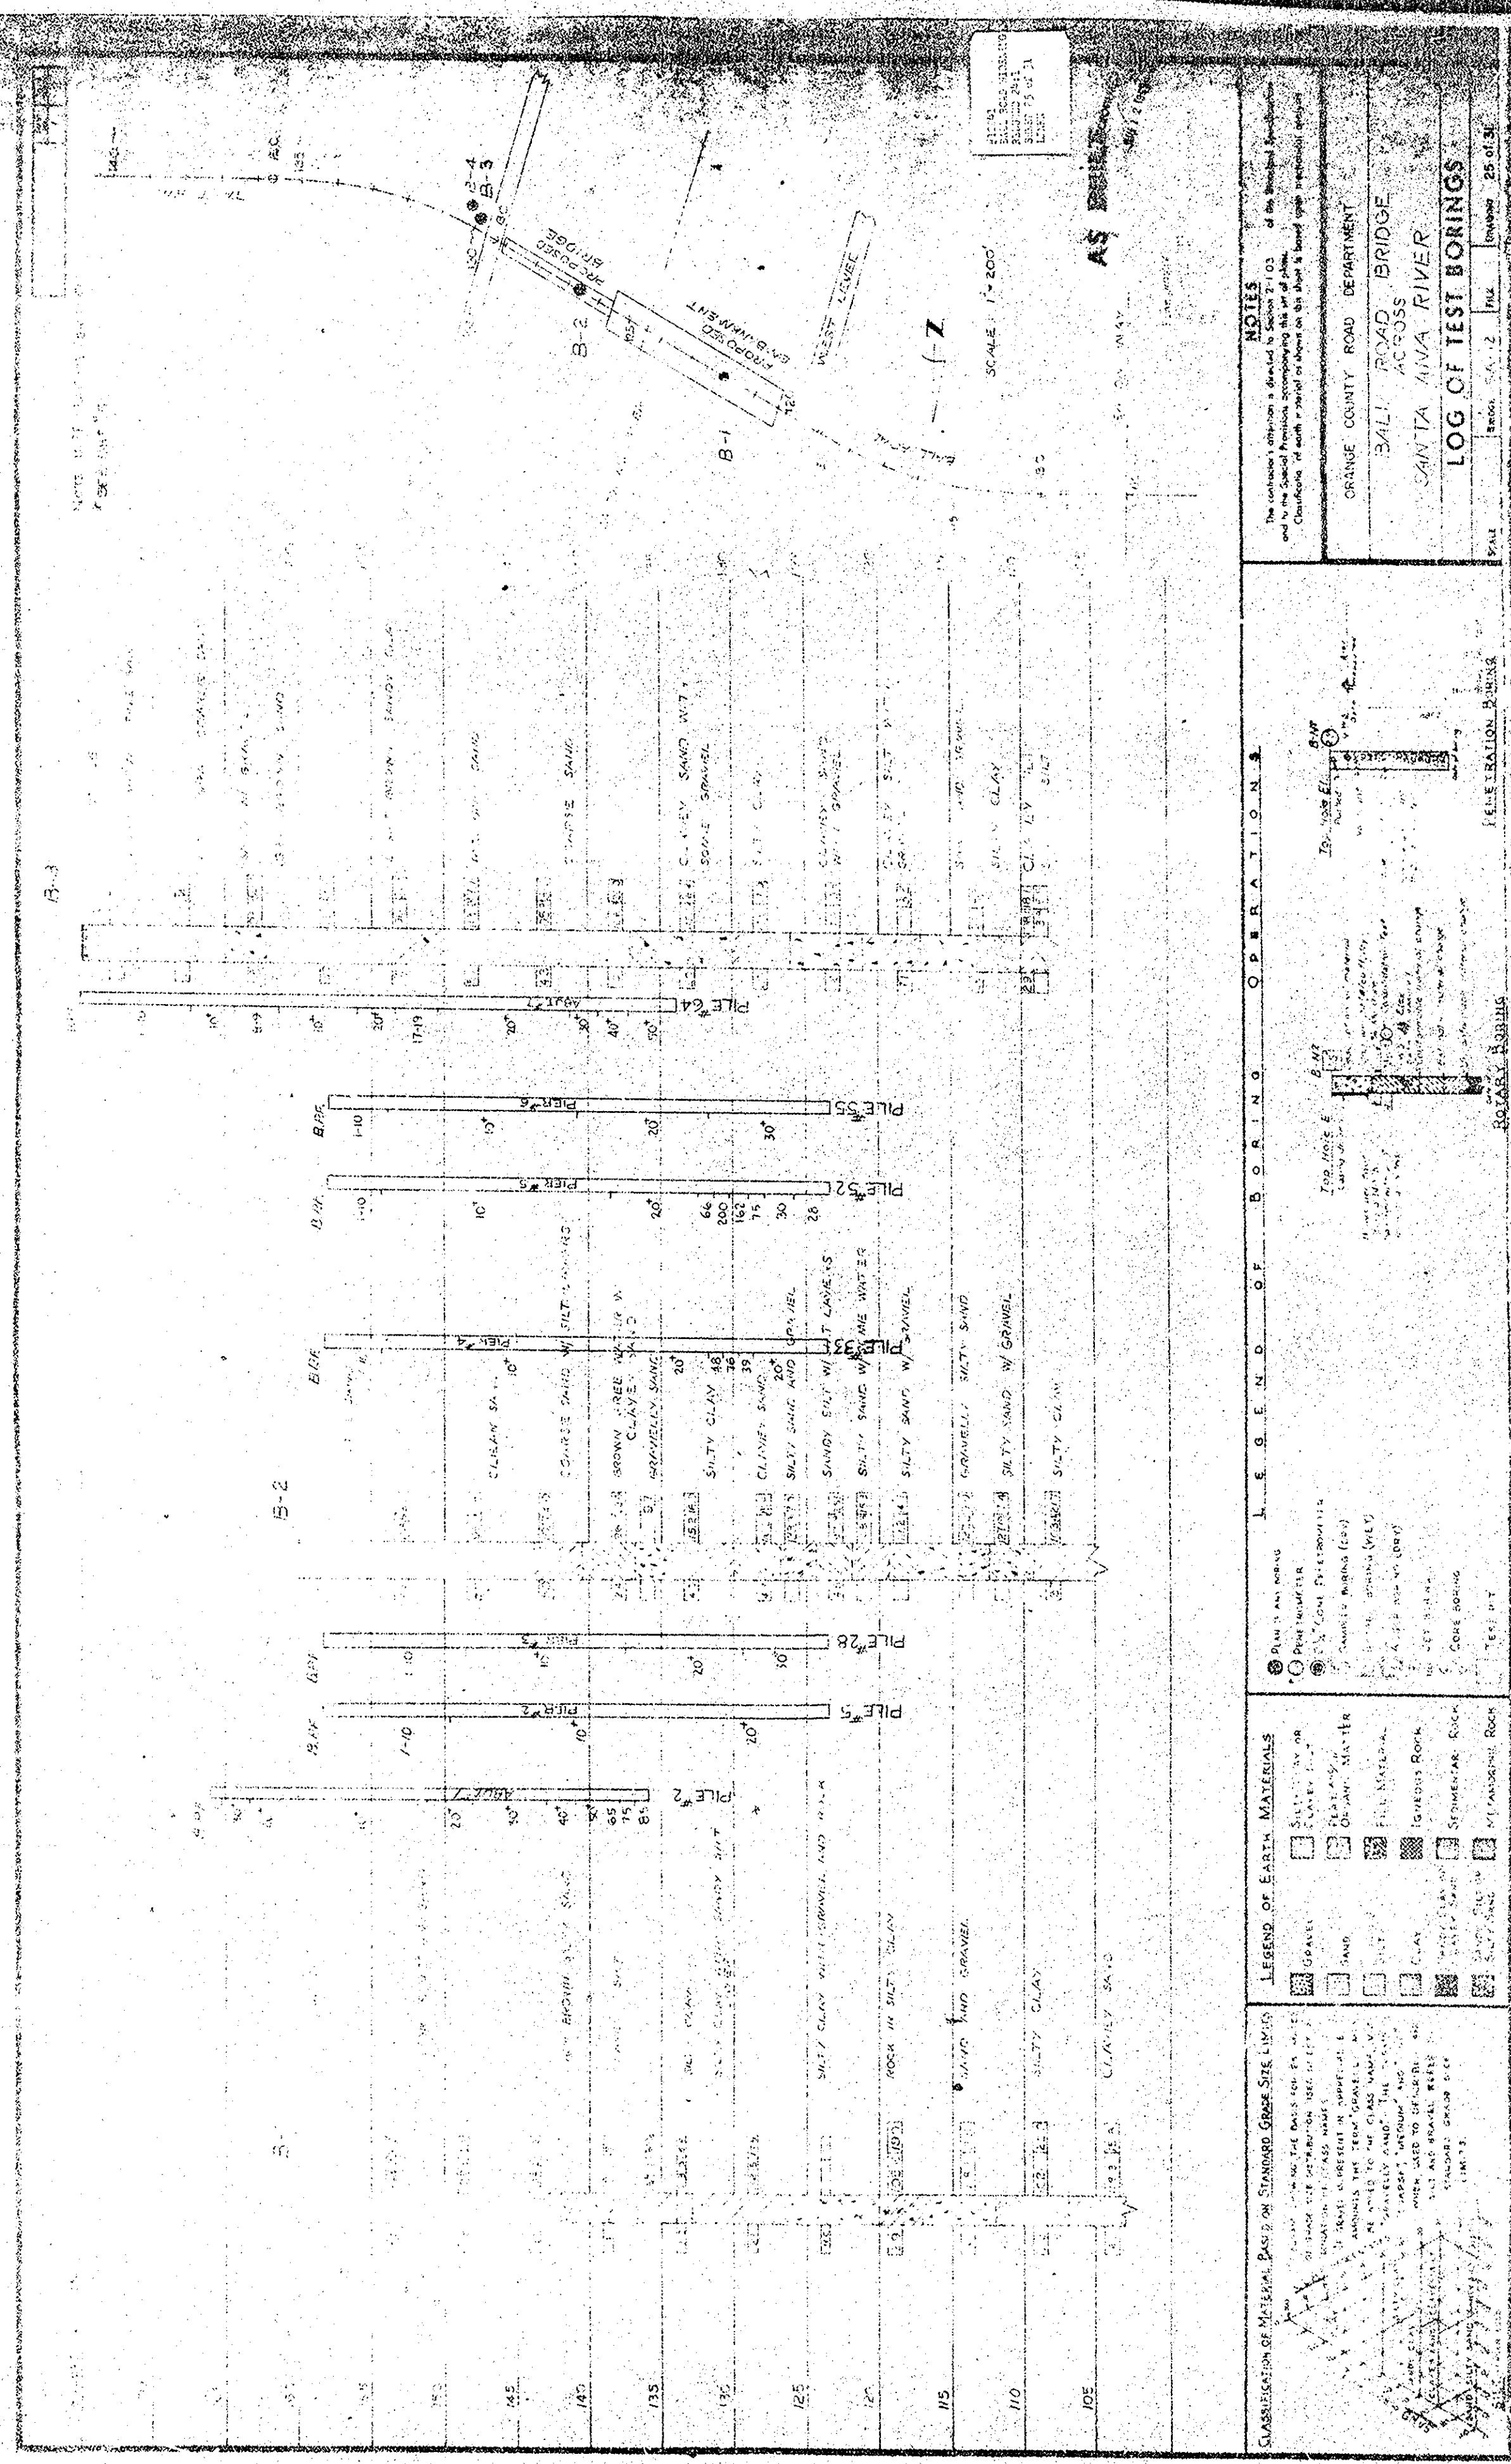

NOTES
The contractor shall be responsible for the accuracy of the data and the classification of the soil material shown on this sheet is based upon the available information.

ORANGE COUNTY ROAD DEPARTMENT
BAILL ROAD BRIDGE
SANTA ANA RIVER
LOG OF TEST BORINGS

DATE: 5-1-2
INCH: 25 OF 31

LEGEND OF EARTH MATERIALS									
GRAVEL	CLAY	SAND	GRAVEL	CLAY	SAND	GRAVEL	CLAY	SAND	GRAVEL
CLAY	SAND	GRAVEL	CLAY	SAND	GRAVEL	CLAY	SAND	GRAVEL	CLAY
CLAY	SAND	GRAVEL	CLAY	SAND	GRAVEL	CLAY	SAND	GRAVEL	CLAY
DR. #2 (12241)

