

DIST	COUNTY	ROUTE	POST MILES TOTAL PROJECT	SHEET NO.	TOTAL SHEETS
12	ORA				


Wen K. Yu
REGISTERED CIVIL ENGINEER

WEN K. YU
No. C-051952
Exp 06/30/98
CIVIL
STATE OF CALIFORNIA

PLANS APPROVAL DATE

LIM & NASCIMENTO ENGINEERING
1971 East Fourth Street, Suite 200
Santa Ana, California 92705

Brown & Root, INC.
1000 South Fremont Avenue
Alhambra, California 91803-1300

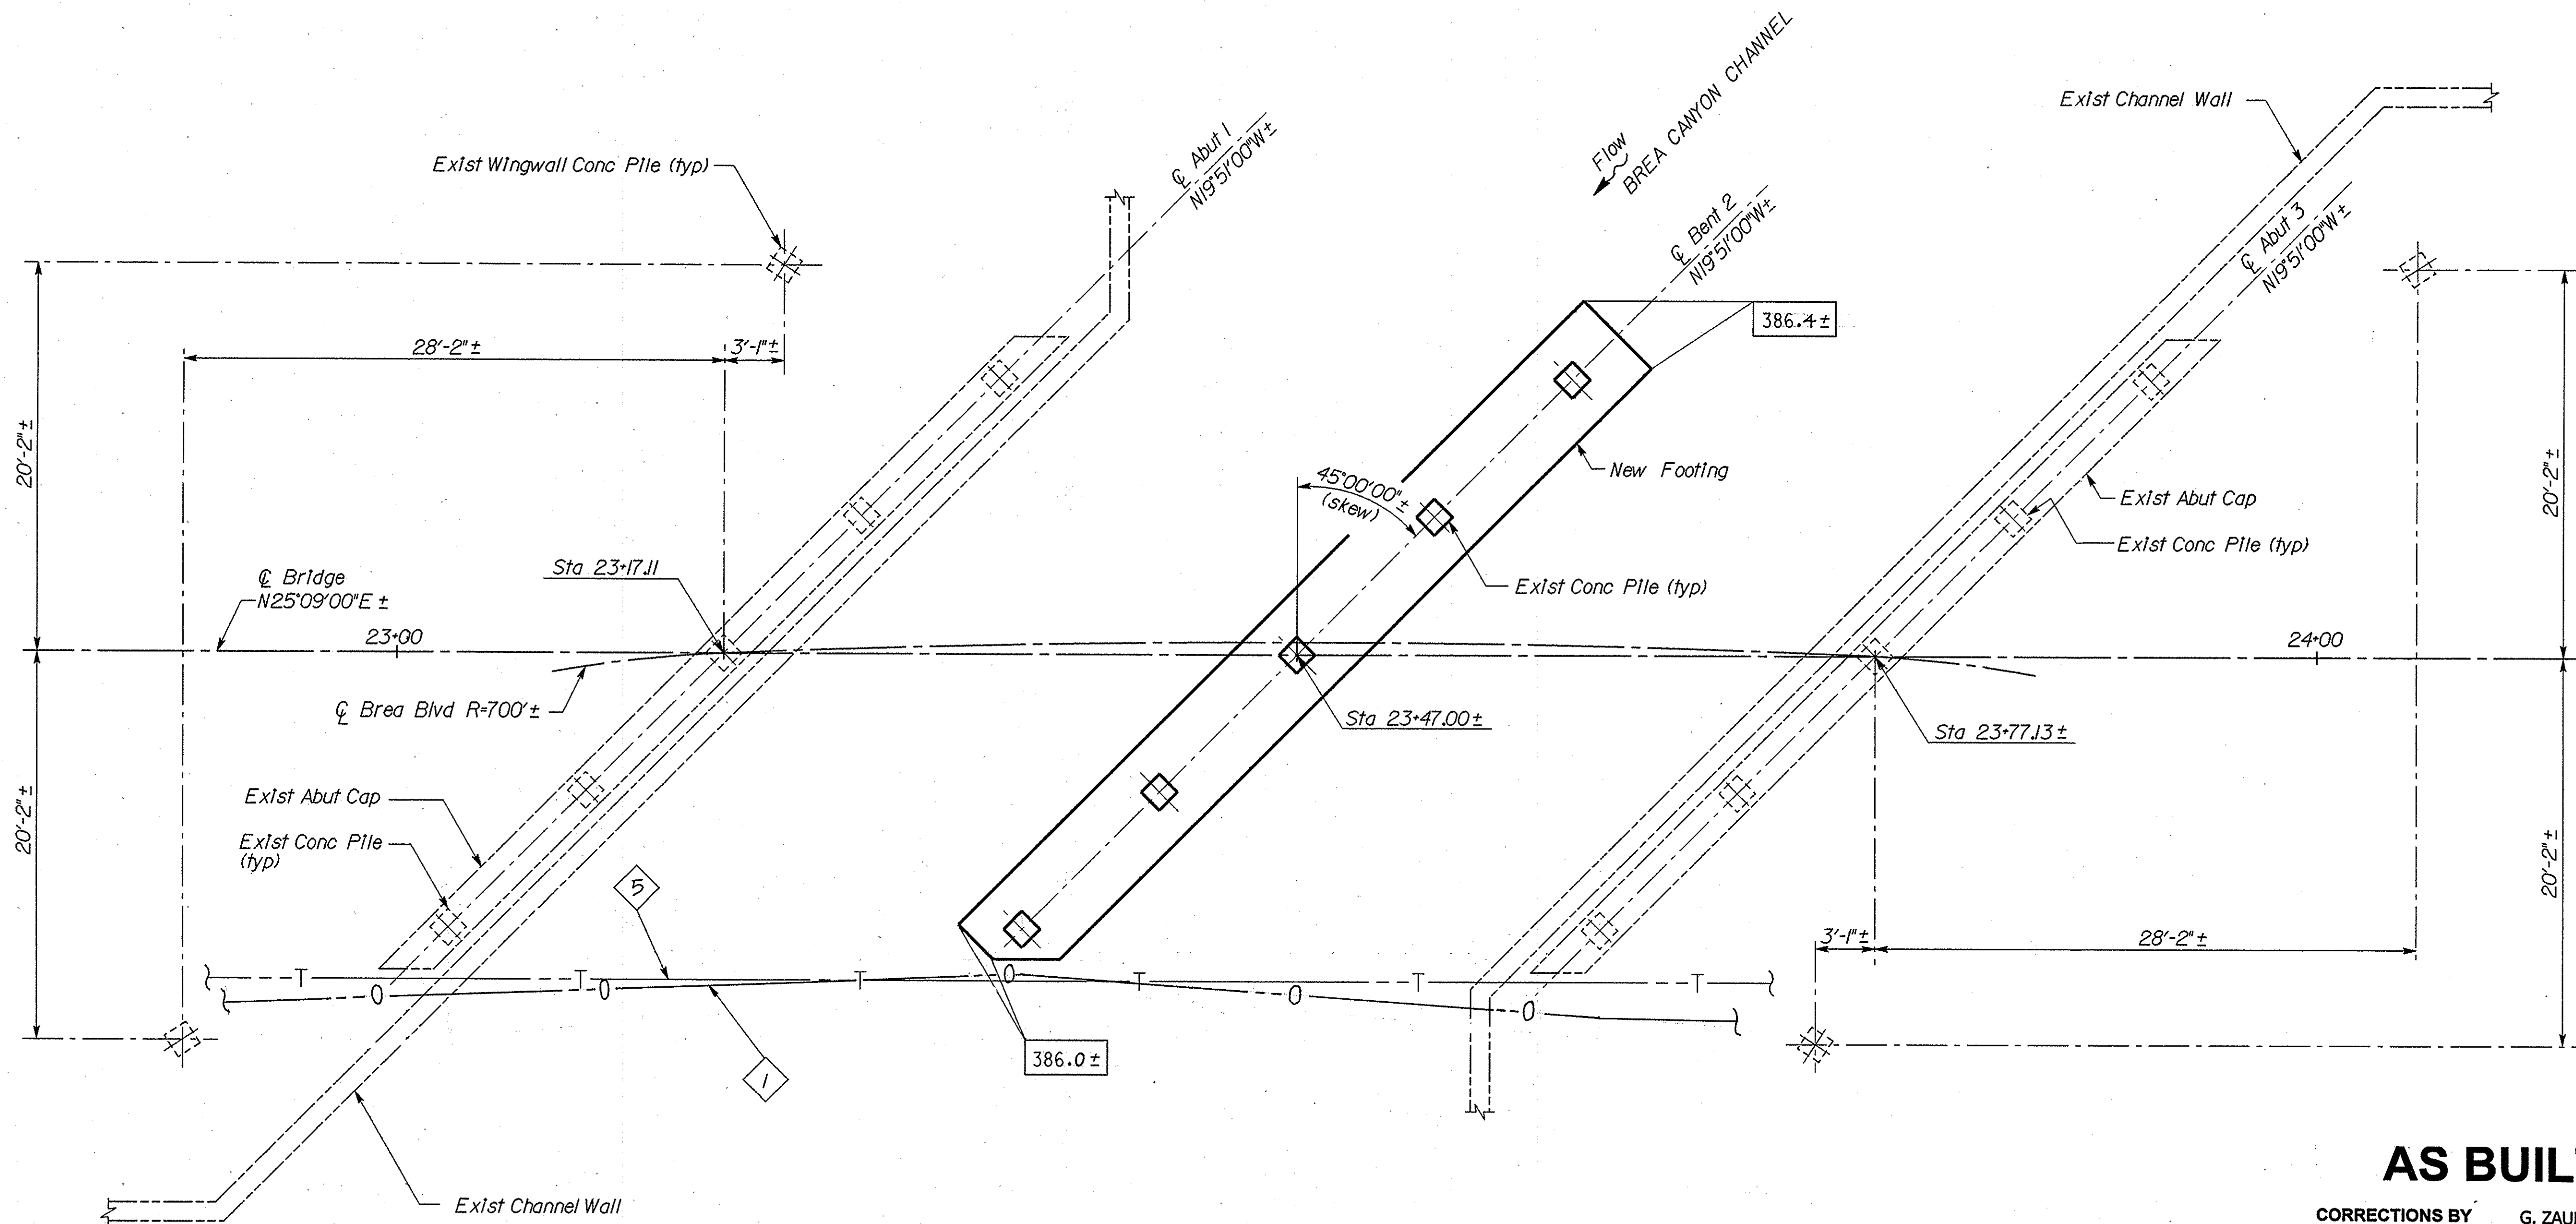

NOTE:
The top of new footing to match bottom of existing channel lining, see "BENT 2 RETROFIT DETAILS NO. 1" sheet.

- LEGEND:**
- Indicates bottom of footing elevation
 - Denotes exist underground 8"± Dia Shell oil line
 - Denotes exist underground Pacific Bell 20"± Dia steel pipe casing with 10-duet system inside

AS BUILT

CORRECTIONS BY G. ZAUN / RWH
CONTRACT NO. 59Y021
DATE 2-8-02 / 10-24-02

NO AS BUILT CHANGES

Note:
The Contractor shall verify all controlling field dimensions before ordering or fabricating any material.

PLAN
Scale: 1" = 5'

22-SEP-1997 14:20		Lino Chong GEOTECHNICAL PROFESSIONAL 07-09-97 APPROVAL DATE		PHOTOGRAMMETRY AS OF:		DRAWN BY		DESIGN BY		CHECKED BY		PREPARED FOR THE COUNTY OF ORANGE		TIM McGRADY PROJECT ENGINEER		BRIDGE NO. 55C-0122 POST MILE		EARTHQUAKE RETROFIT BREA CANYON BRIDGE NO. 2 FOUNDATION PLAN	
SHAWN SUN DESIGN OVERSIGHT 10/2/97 SIGN OFF DATE		BY		BY		BY		BY		BY		CU 12 152 EA L02105		DISREGARD PRINTS BEARING EARLIER REVISION DATES		REVISION DATES (PRELIMINARY STAGE ONLY)		SHEET OF 2 8	
15FN1122.DGN-9 09-20-97 RF: 55CPLN.BDR.BDR		FIELD CHKD		CHECKED		QUANTITIES		BY W. YU		CHECKED A. TRUONG									