




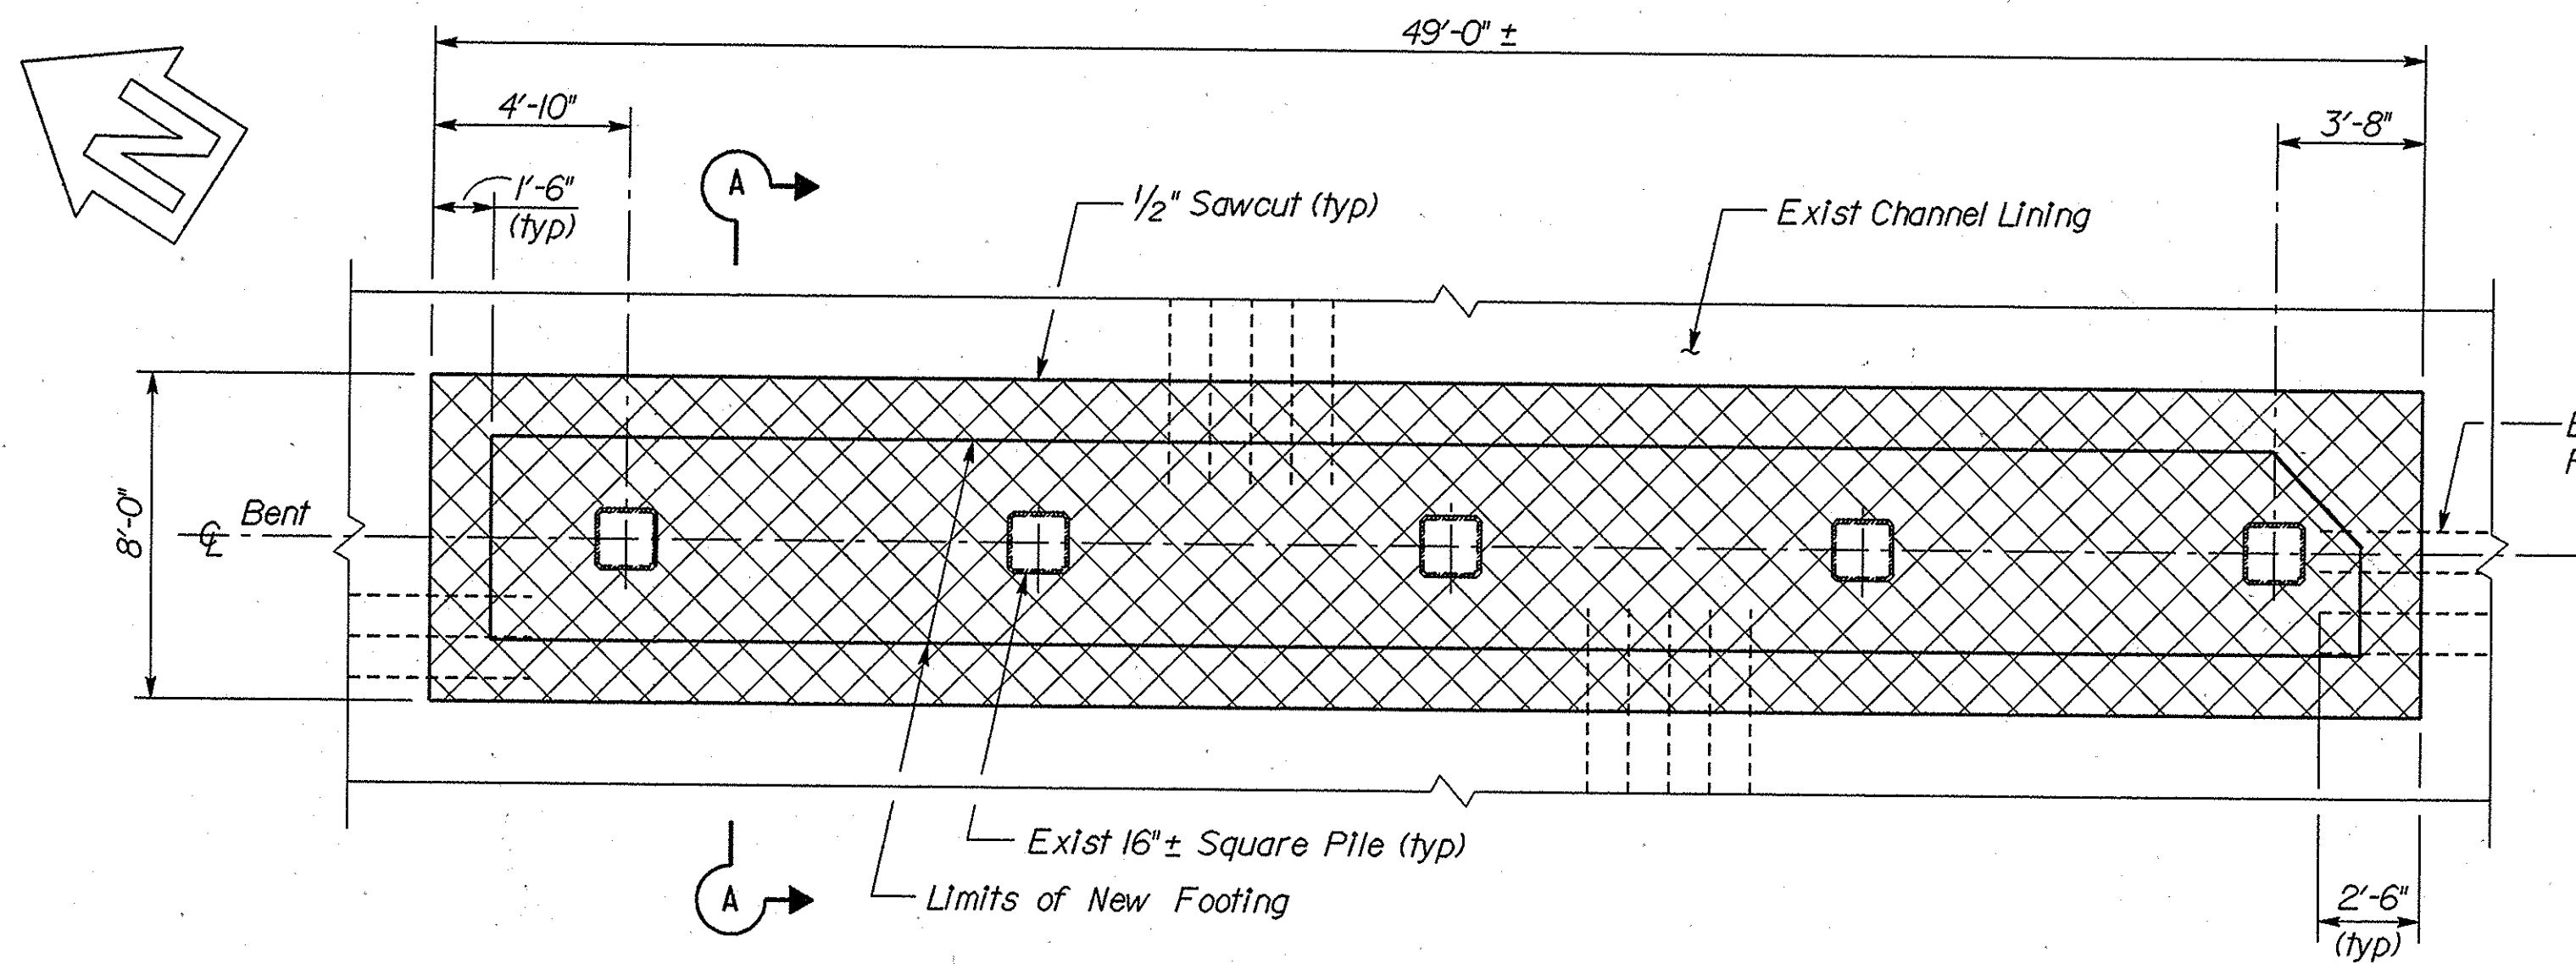

PLAN - LIMITS OF PAYMENT FOR CONCRETE REMOVAL
Scale: 1/4" = 1'-0"

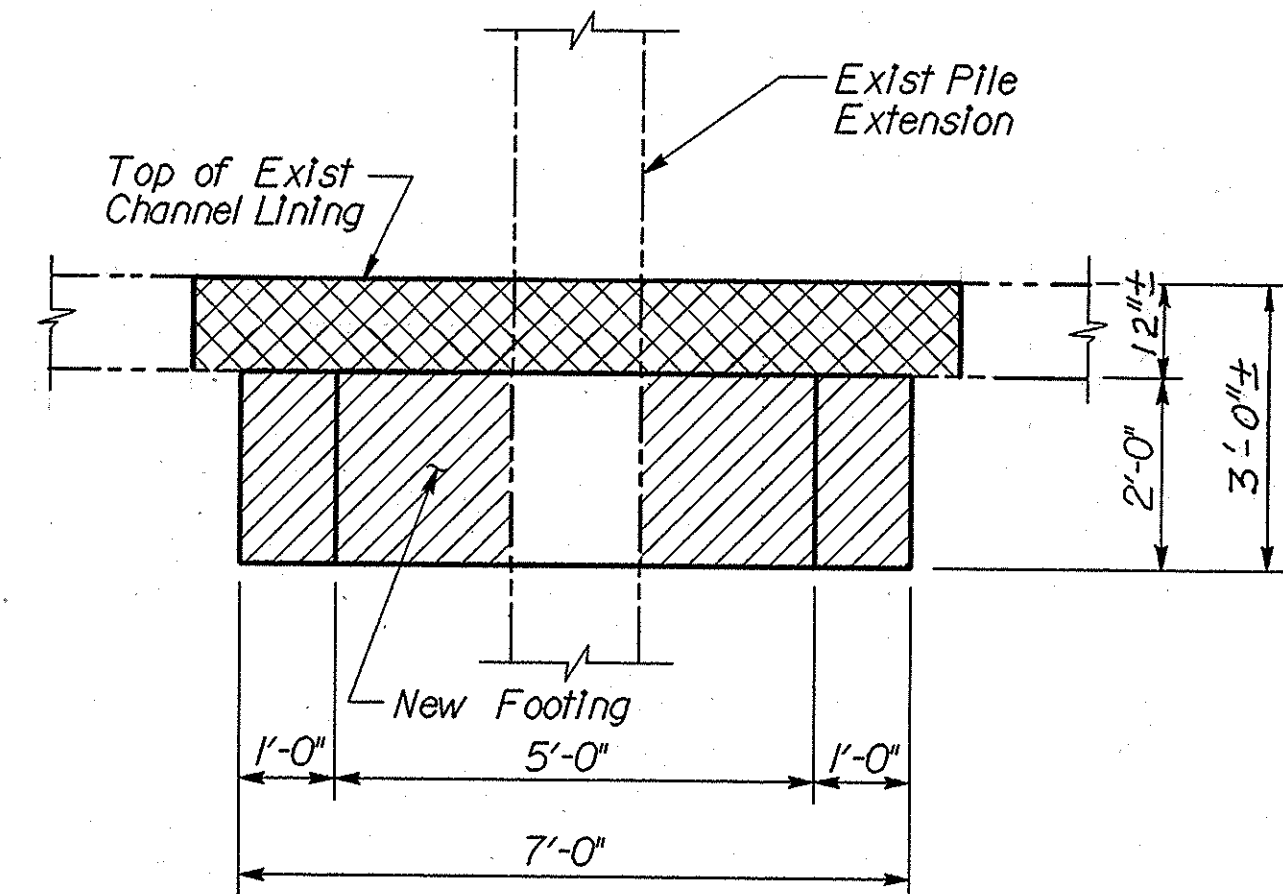


EXCAVATION

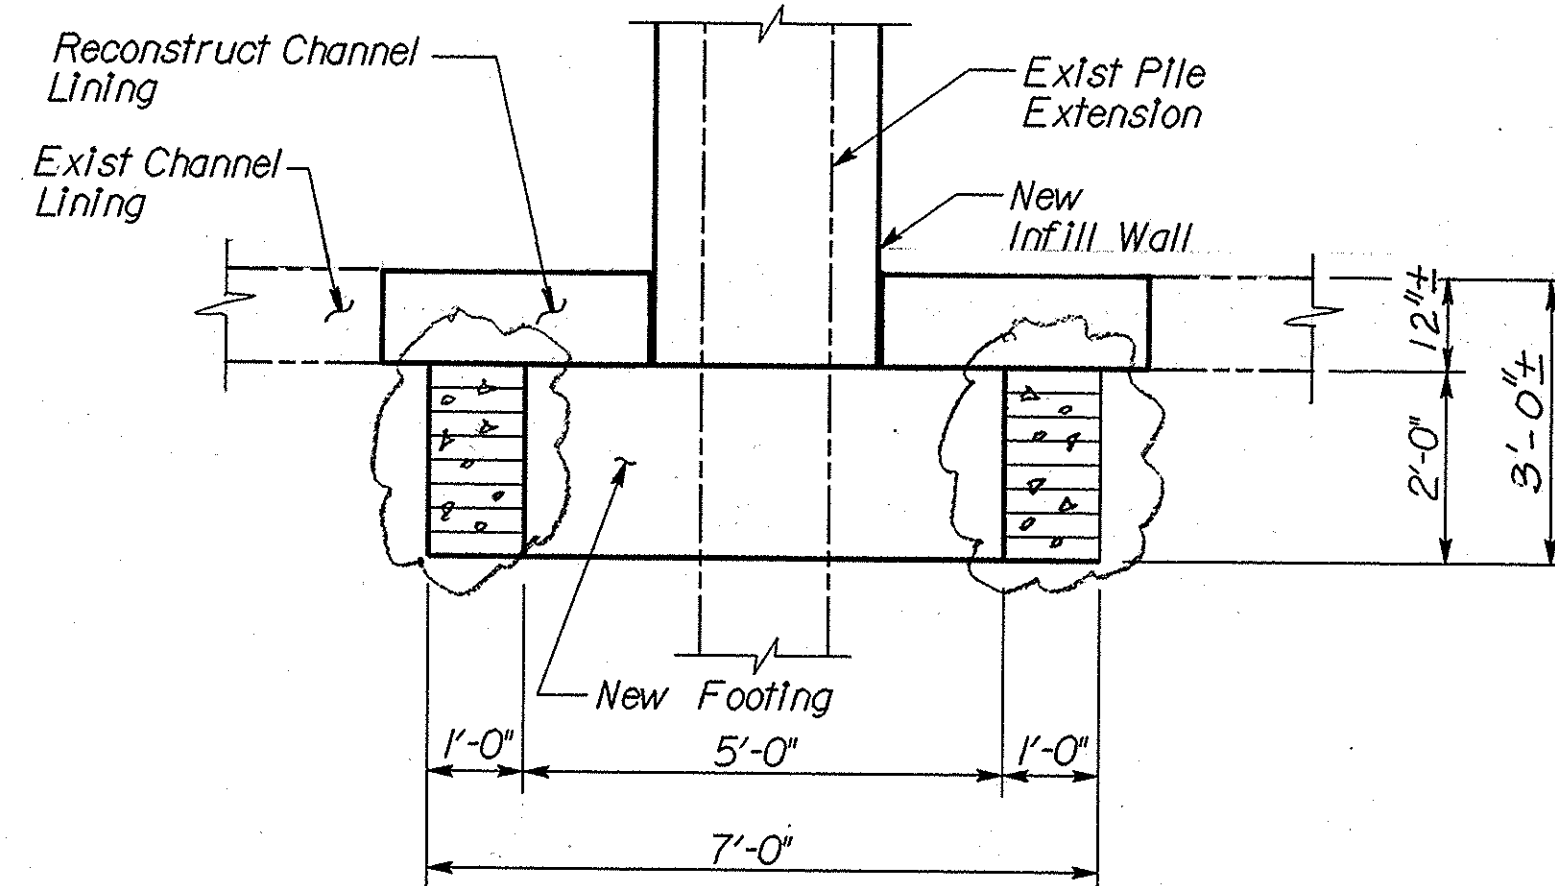


BACKFILL

LIMITS OF PAYMENT
BENT FOOTING EXCAVATION AND BACKFILL
Scale: 1/2" = 1'-0"

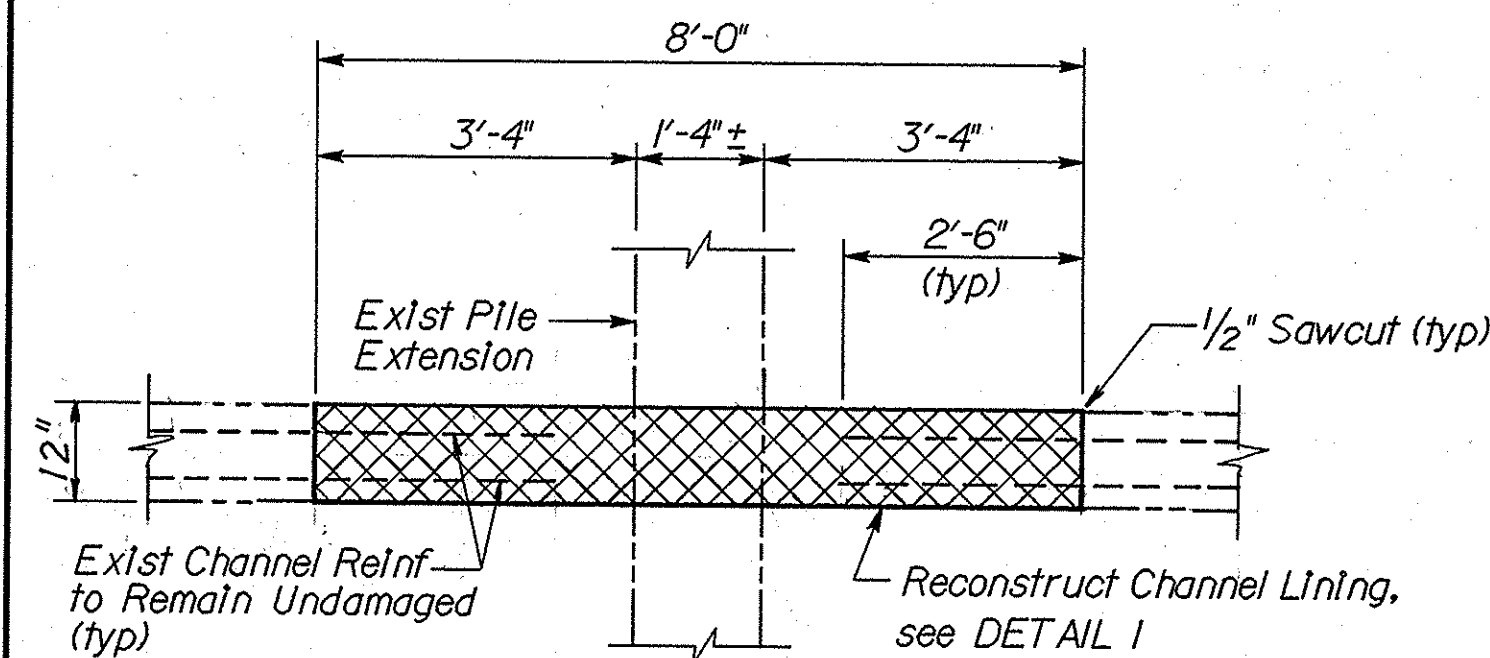

SECTION A-A
Scale: 1/2" = 1'-0"

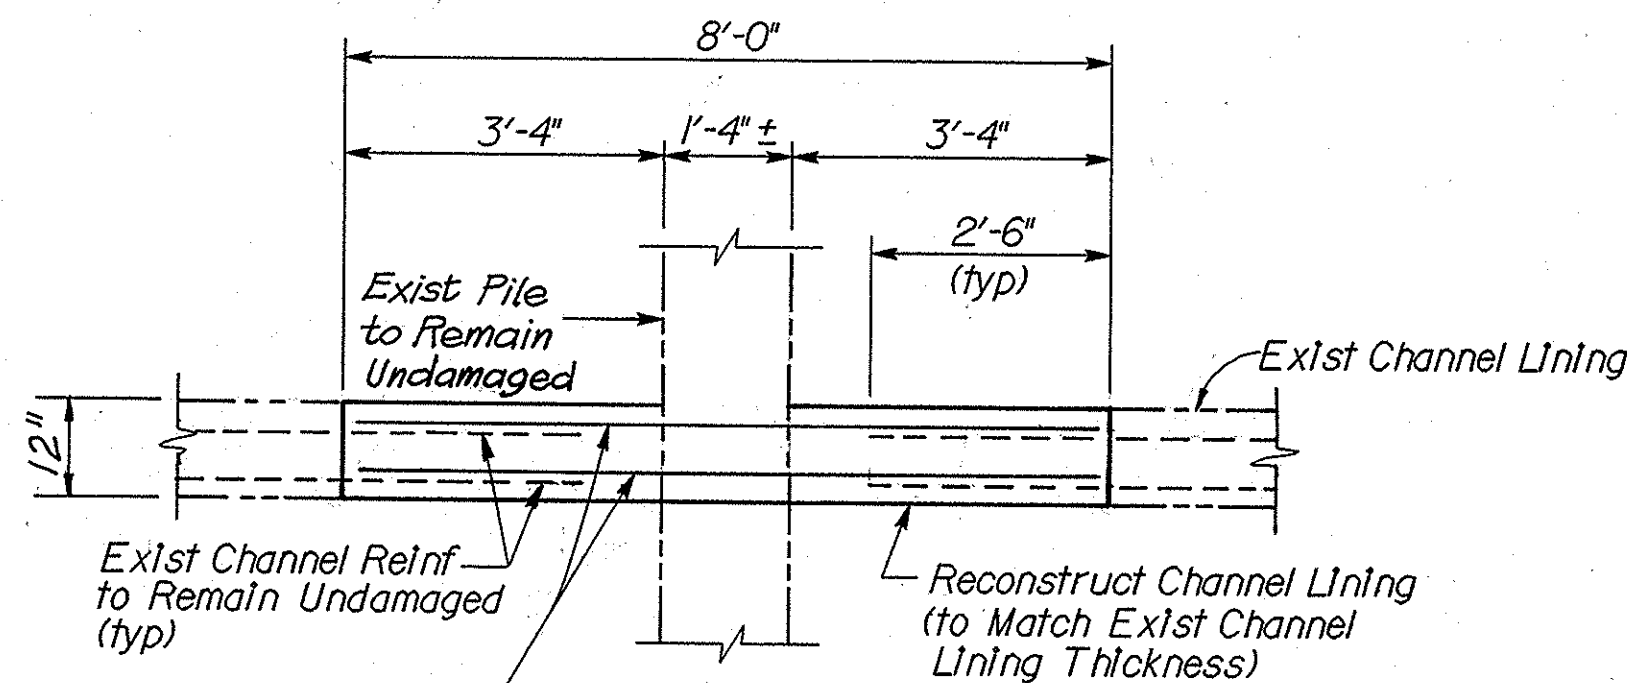

DETAIL I
Scale: 1/2" = 1'-0"

Note:

The Contractor shall verify all controlling field dimensions before ordering or fabricating any material.

SHAWN SUN *Shawn Sun*

DESIGN OVERSIGHT

10/2/97

SIGNOFF DATE

15MD1122.DGN-6 09-20-97 RF=55CPLN.BDR.BDR

DESIGN	BY	W. YU	CHECKED	G. CHU
DETAILS	BY	AVO E.	CHECKED	G. CHU
QUANTITIES	BY	W. YU	CHECKED	A. TRUONG

PREPARED FOR THE
COUNTY OF
ORANGE

TIM McGRADY
PROJECT ENGINEER


CU 12 152
EA L02105

ORIGINAL SCALE IN INCHES
FOR REDUCED PLANS


0 1 2 3

LEGEND:


- Indicates Structure Excavation (Type D)
- Indicates Structure Backfill (Bridge)
- Indicates Concrete Removal
- Indicates Structure Excavation (Bridge)
- Indicates Structure Backfill (Bridge) - Portland Cement Concrete

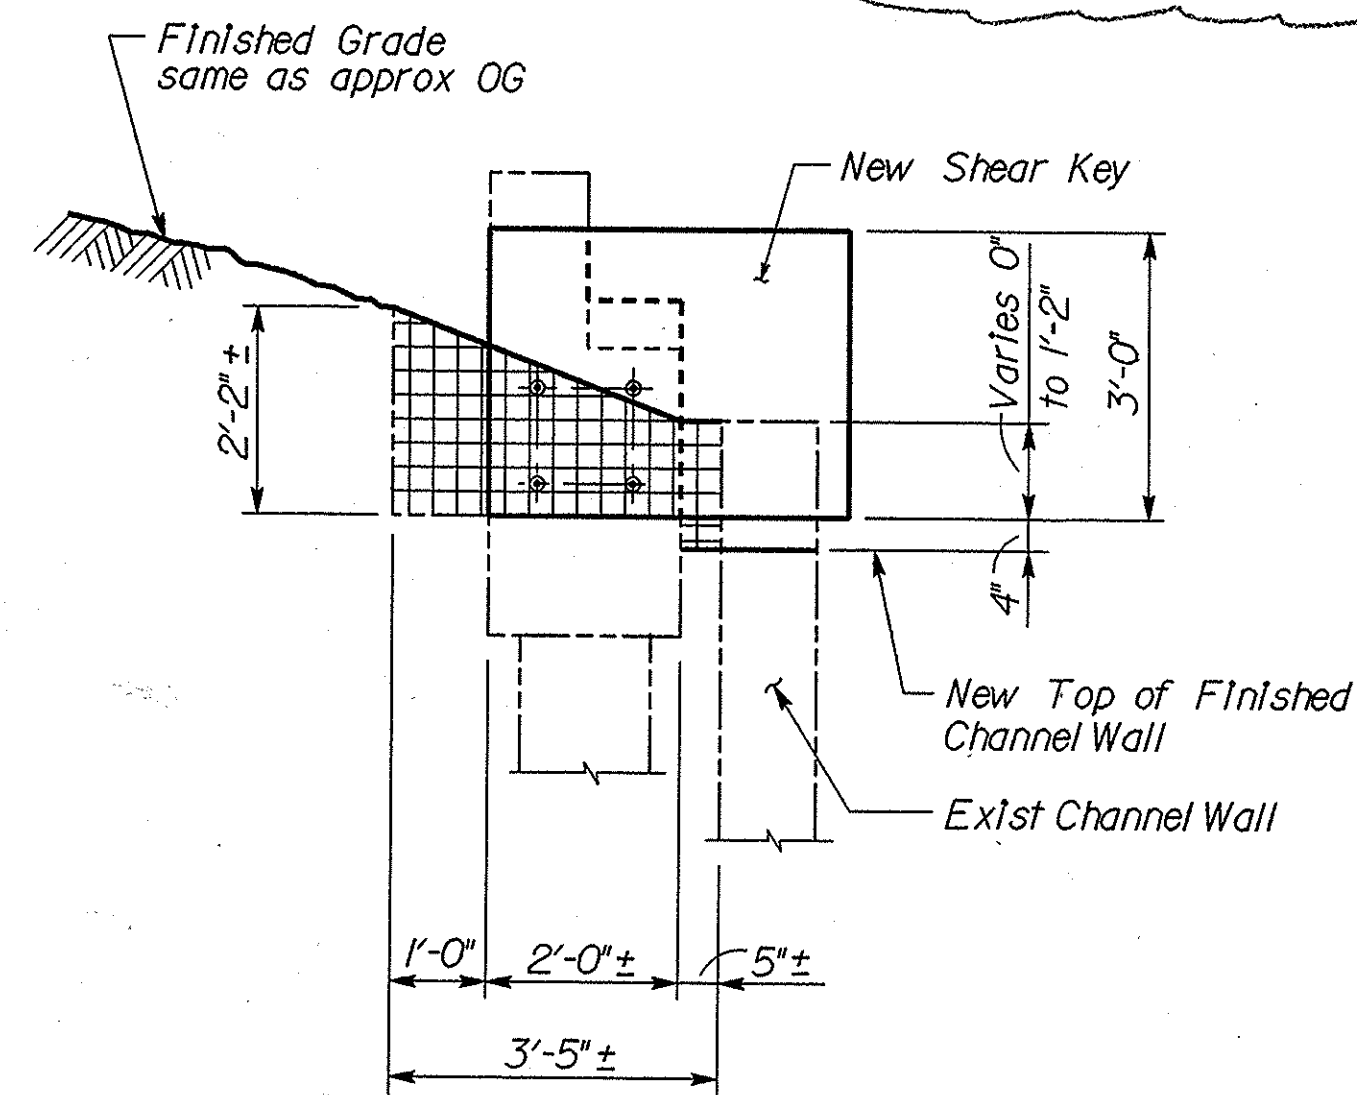


SECTION B-B
Scale: 1/2" = 1'-0"

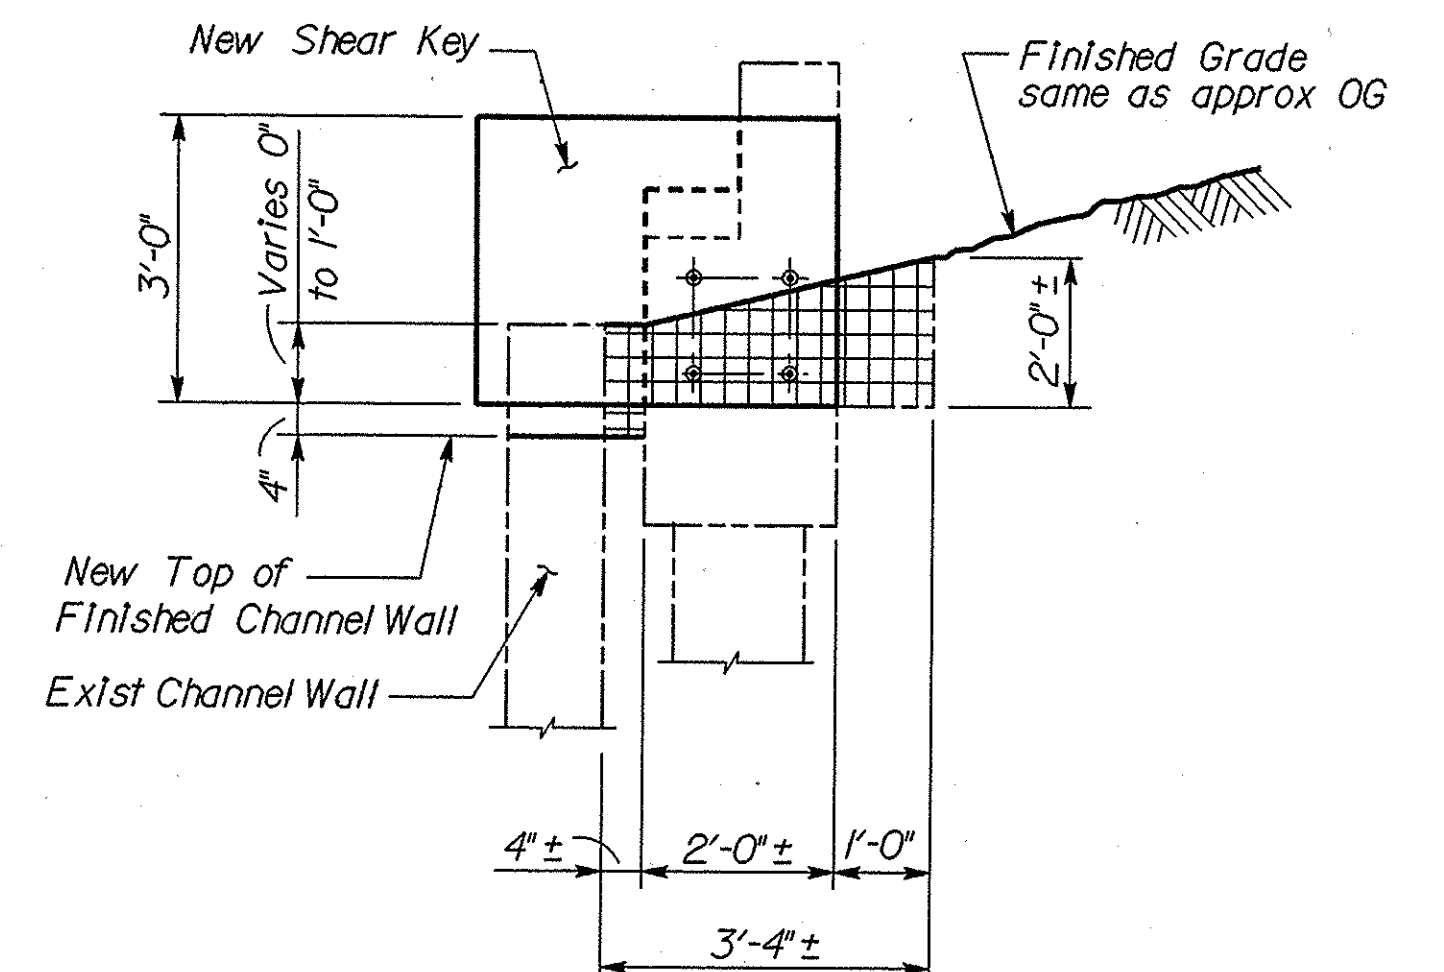

SECTION C-C
Scale: 1/2" = 1'-0"

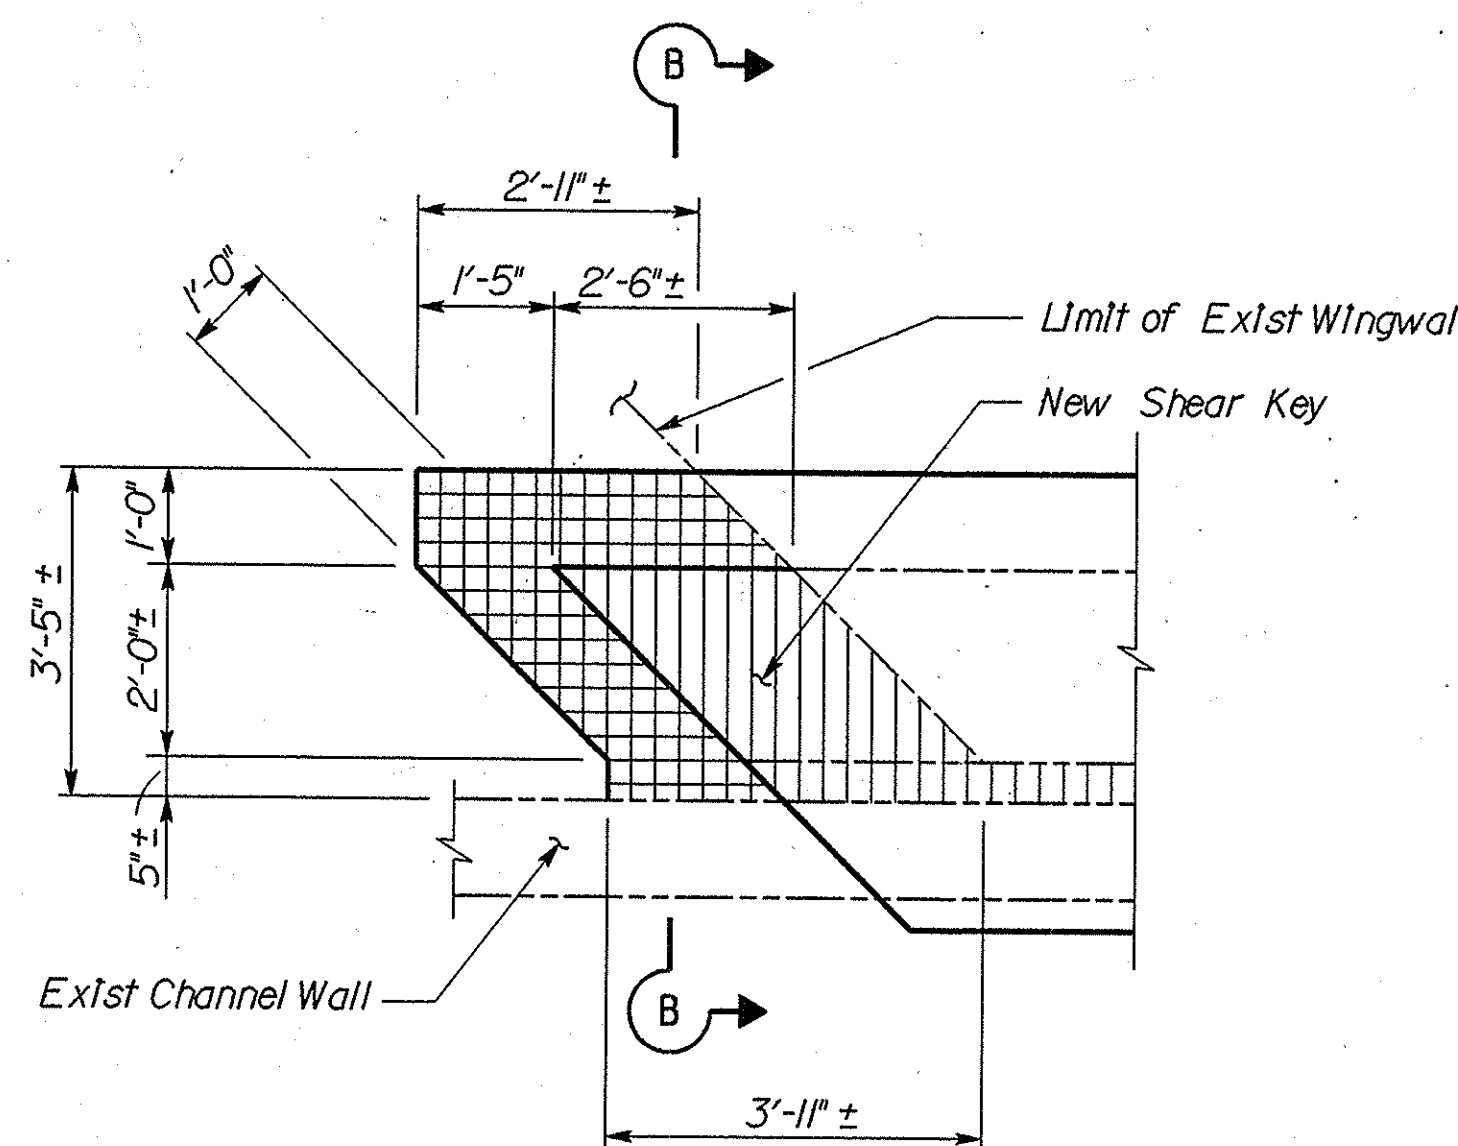

PLAN - ABUTMENT 1 (Southeast Corner)

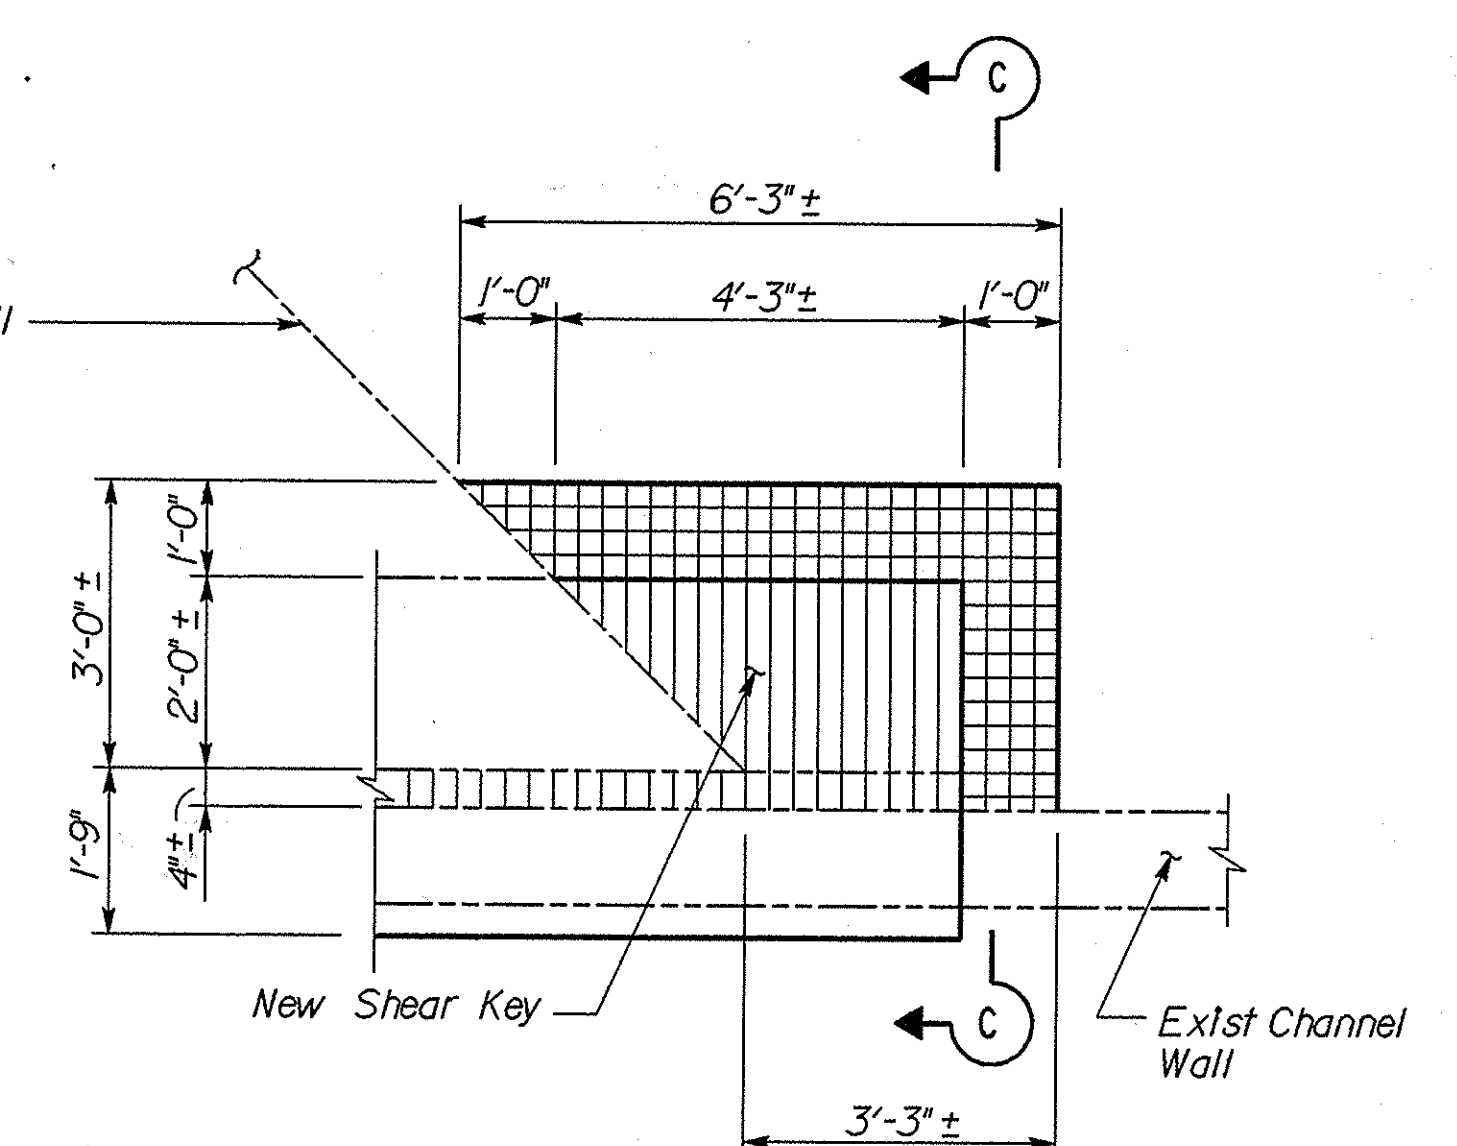

PLAN - ABUTMENT 3 (Northeast Corner)

LIMITS OF PAYMENT
ABUTMENT EXCAVATION AND BACKFILL
Scale: 1/2" = 1'-0"

AS BUILT

CORRECTIONS BY G. ZAUN / RWH

CONTRACT NO. 59Y021

EARTHQUAKE RETROFIT 2-8-02 / 10-24-02

BREA CANYON BRIDGE NO. 2
MISCELLANEOUS DETAILS

DISREGARD PRINTS BEARING
EARLIER REVISION DATES

REVISION DATES (PRELIMINARY STAGE ONLY)

SHEET OF

8 8