


|                |                   |
|----------------|-------------------|
| CORRECTIONS BY | G. ZAUN / RWH     |
| CONTRACT NO.   | 59Y021            |
| DATE           | 2-8-02 / 10-24-02 |

## NO AS BUILT CHANGES



- [illegible]

For "General Notes"  
see "Bent Retrofit Details No. 1" sheet.

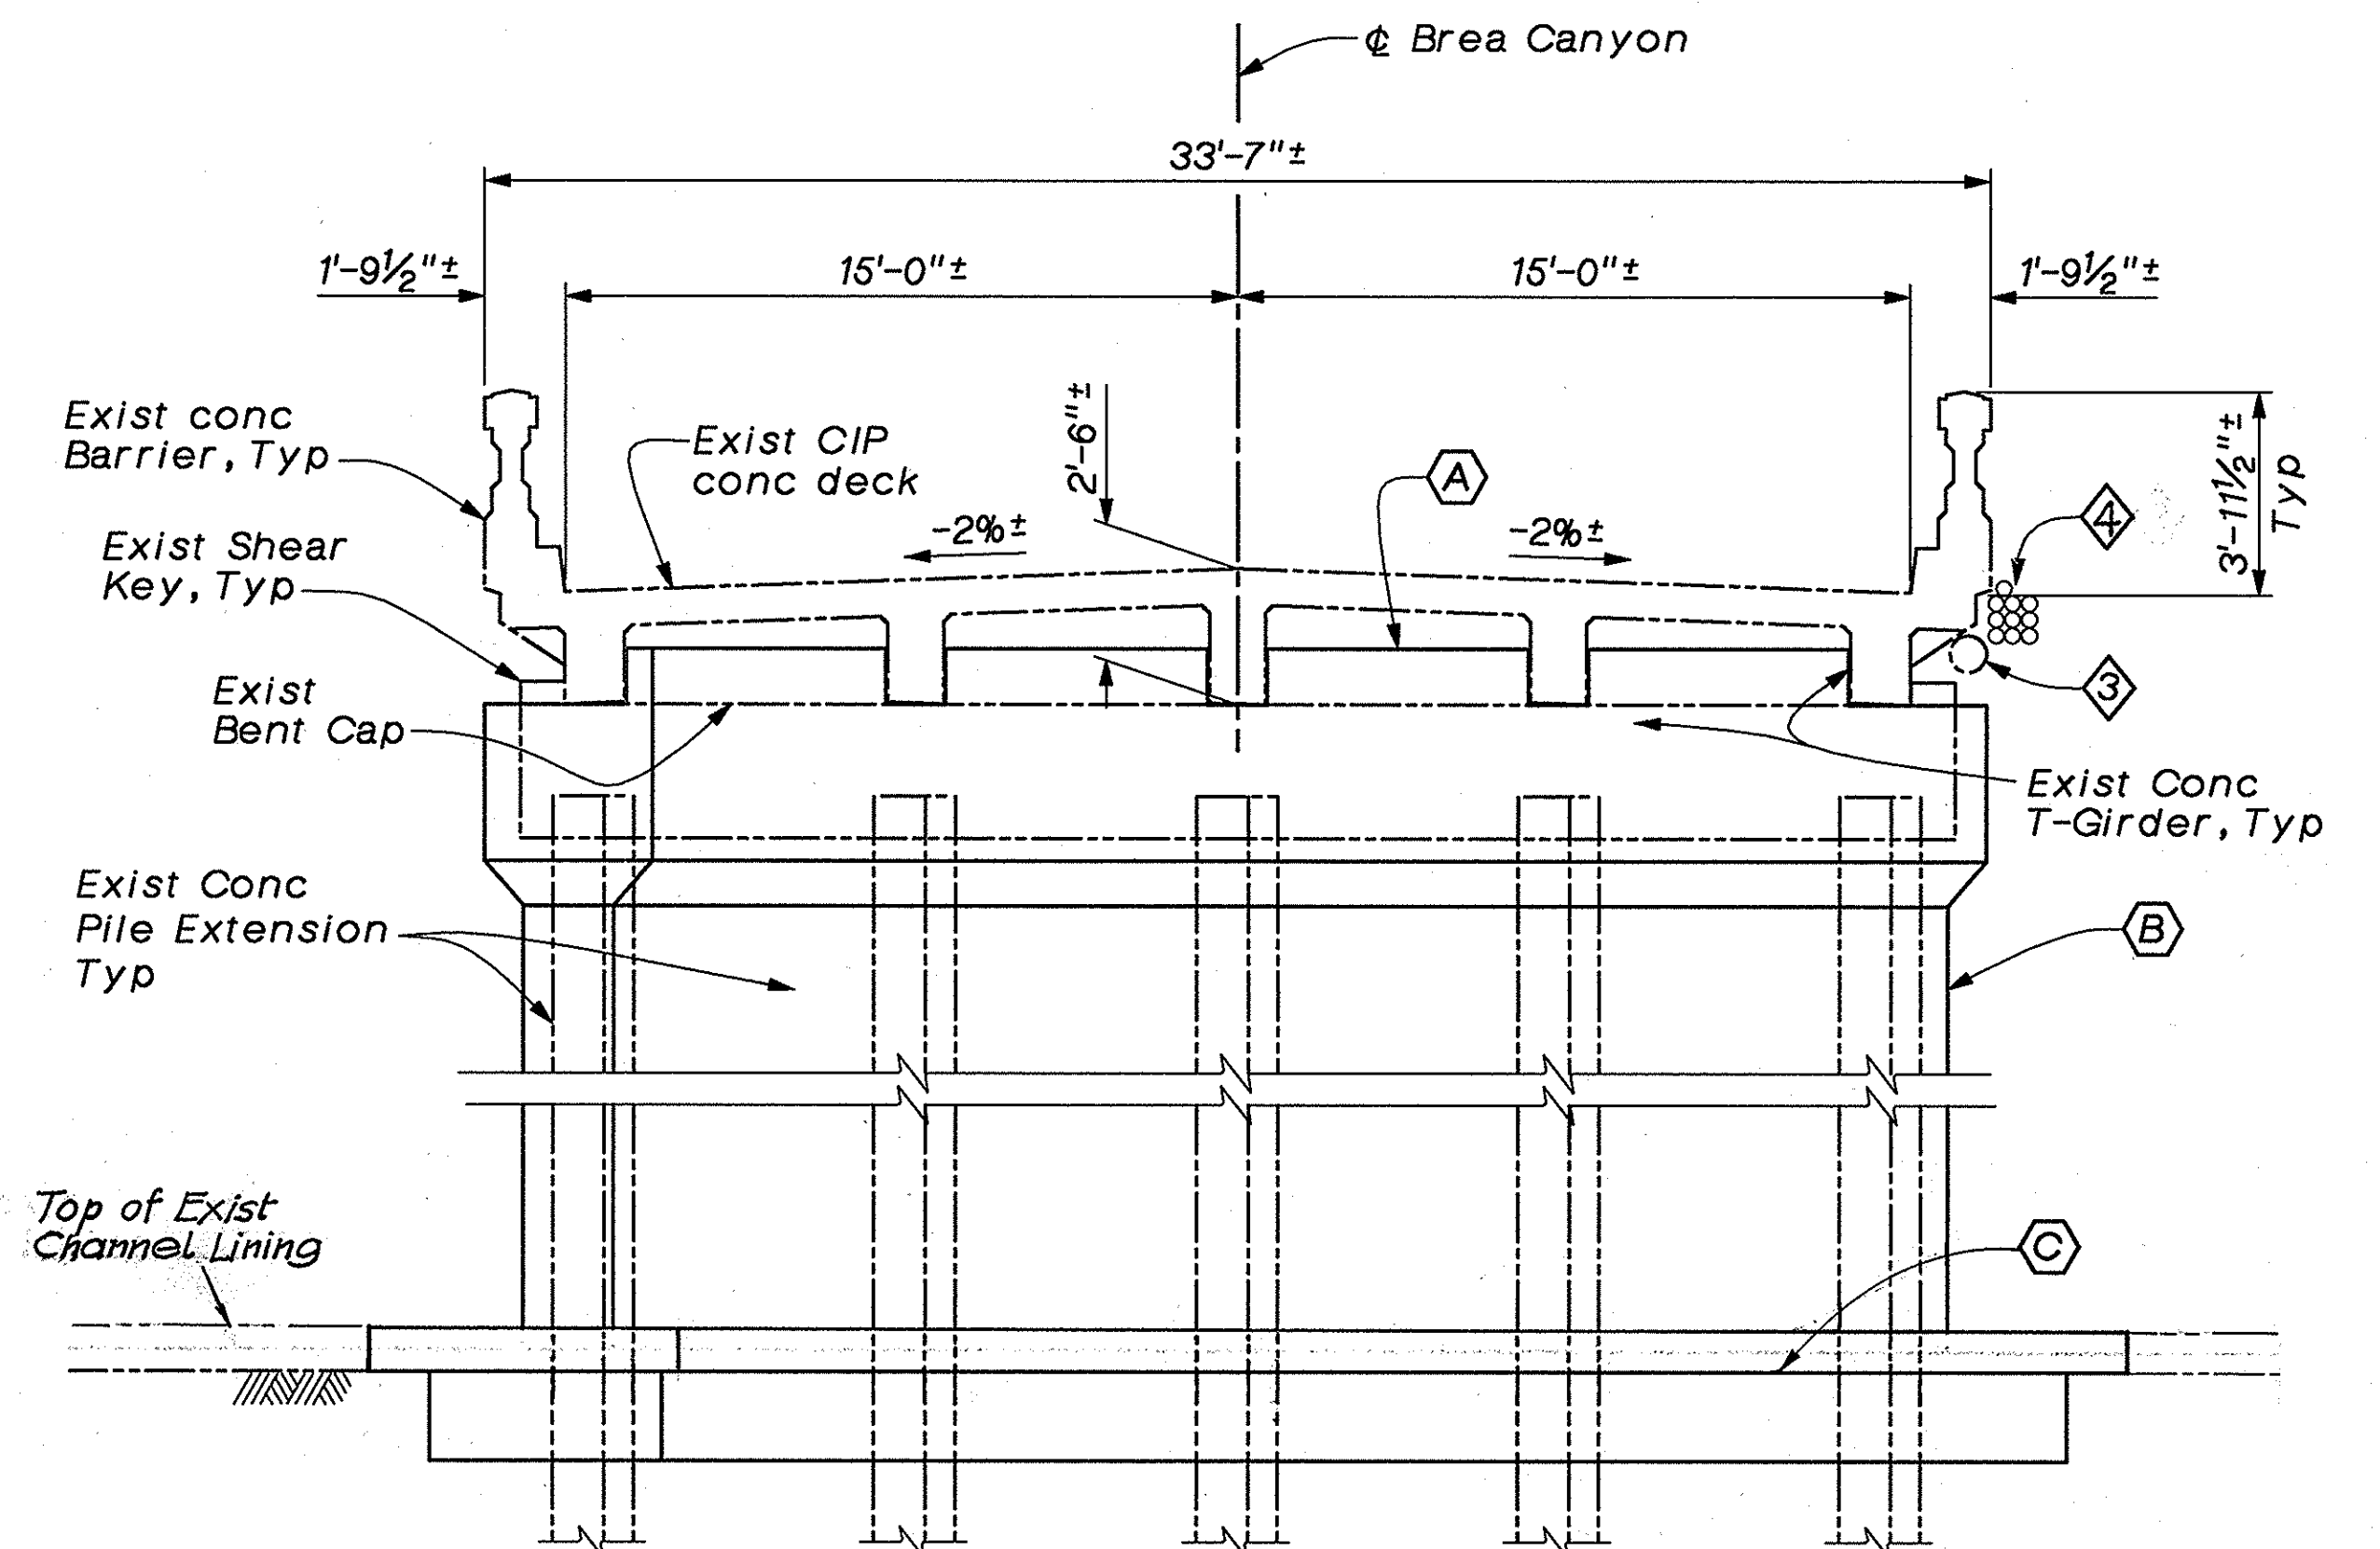

TYPICAL SECTION  
 $\frac{1}{4}" = 1'-0"$

| <u>SHEET No.</u> | <u>TITLE</u>                    |
|------------------|---------------------------------|
| 1.               | GENERAL PLAN                    |
| 2.               | FOUNDATION PLAN                 |
| 3.               | ABUTMENT RETROFIT DETAILS No. 1 |
| 4.               | ABUTMENT RETROFIT DETAILS No. 2 |
| 5.               | BENT RETROFIT DETAILS No. 1     |
| 6.               | BENT RETROFIT DETAILS No. 2     |
| 7.               | BENT RETROFIT DETAILS No. 3     |
| 8.               | MISCELLANEOUS DETAILS           |

- ☐ A Shear Key
- ☐ B Infill Wall
- ☐ C Infill Wall Footing
- ☐ D Seat Extension

A10A      ABBREVIATIONS  
A10B      SYMBOLS  
B0-1      BRIDGE DETAILS

**LEGEND**

----- Denotes existing structure

————— Denotes new construction

➡ Denotes direction of traffic

➡ Denotes direction of flow

0 of 17