

DIST	COUNTY	ROUTE	POST MILES TOTAL PROJECT	SHEET NO.	TOTAL SHEETS
12					


REGISTERED CIVIL ENGINEER




PLANS APPROVAL DATE
LIM & NASCIMENTO ENGINEERING
1971 East Fourth Street, Suite 200
Santa Ana, California 92705

- Notes:
1. Top of new footing to match bottom of existing channel lining.
 2. Existing wingwall piles not shown for clarity.

AS BUILT

CORRECTIONS BY G. ZAUN / RWH
CONTRACT NO. 59Y021
DATE 2-8-02 / 10-24-02

NO AS BUILT CHANGES

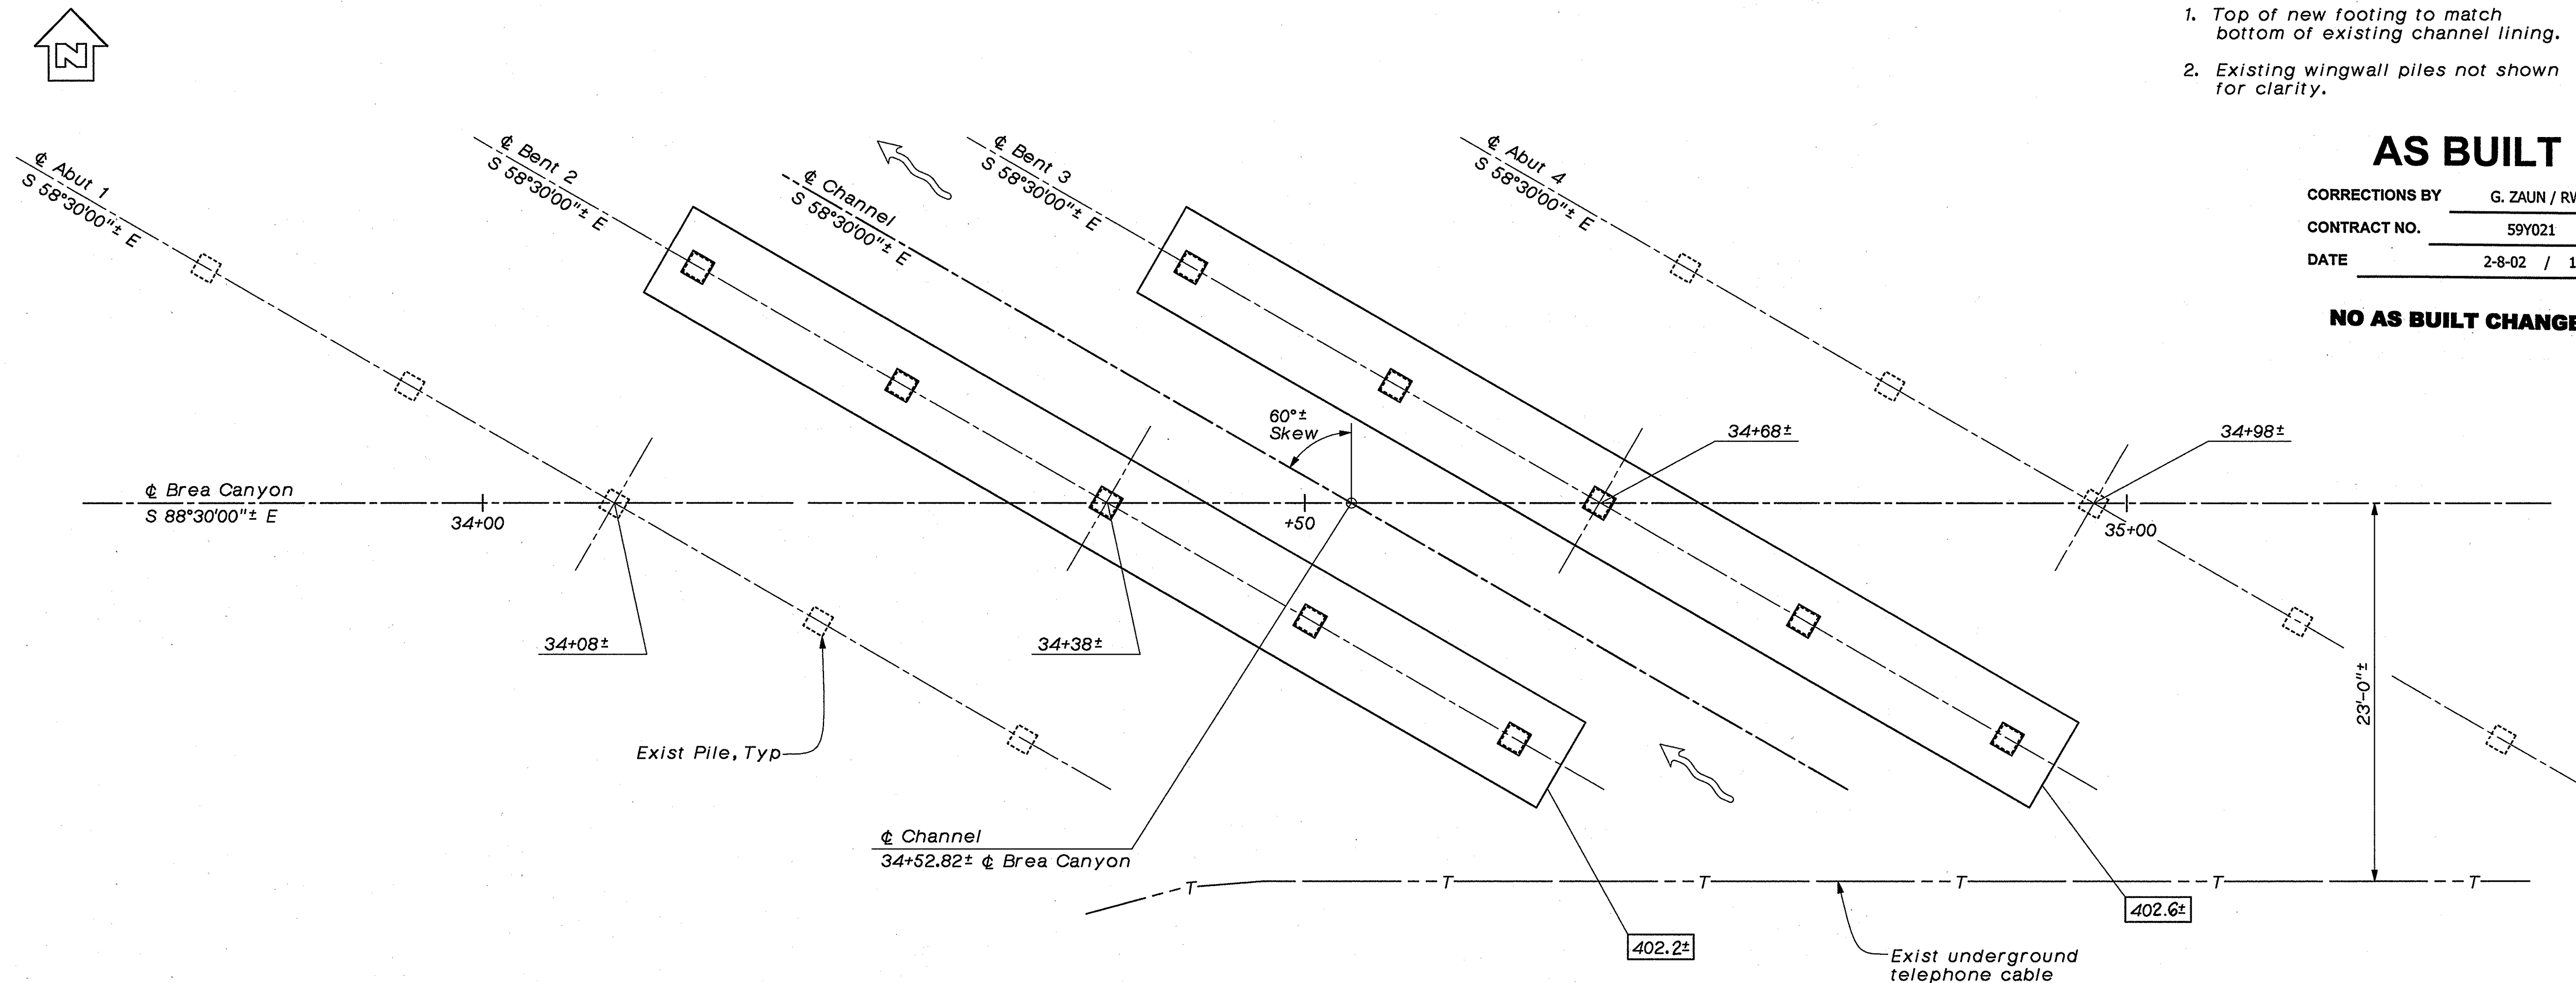


PLAN
1" = 5'

Note:
The Contractor shall verify all
controlling field dimensions before
ordering or fabricating any material.

Note:
Existing channel lining not shown

LEGEND

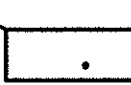-  Denotes bottom of footing elevation
 Denotes direction of flow

 SHAWN SUN DESIGN OVERSIGHT 10/1/97 SIGN OFF DATE		PHOTOGRAMMETRY AS OF: SURVEYED BY FIELD CHKD BY		DRAWN BY TRACED BY CHECKED BY	DESIGN BY DETAILS BY QUANTITIES BY	BY G.J.N. / H. LAM BY R. ANDRASEK BY H. LAM	CHECKED R. CHAN CHECKED R. CHAN/J. LU CHECKED R. CHAN	PREPARED FOR THE COUNTY OF ORANGE	G.J. NASCIMENTO PROJECT ENGINEER	BRIDGE NO. 55C-0123 POST MILE	EARTHQUAKE RETROFIT BREA CANYON BRIDGE No. 1 FOUNDATION PLAN				
ORIGINAL SCALE IN INCHES FOR REDUCED PLANS										CU 12 152 EA L02105	DISREGARD PRINTS BEARING EARLIER REVISION DATES		REVISION DATES (PRELIMINARY STAGE ONLY)		SHEET 2 OF 8