

DIST	COUNTY	ROUTE	POST MILES TOTAL PROJECT	SHEET NO.	TOTAL SHEETS
12					


REGISTERED CIVIL ENGINEER
 G.J. NASCIMENTO
 No. 44871
 Exp. 3/31/98
 CIVIL
 STATE OF CALIFORNIA

PLANS APPROVAL DATE
 LIM & NASCIMENTO ENGINEERING
 1971 East Fourth Street, Suite 200
 Santa Ana, California 92705


AS BUILT

CORRECTIONS BY G. ZAUN / RWH
 CONTRACT NO. 59Y021
 DATE 2-8-02 / 10-24-02

NO AS BUILT CHANGES

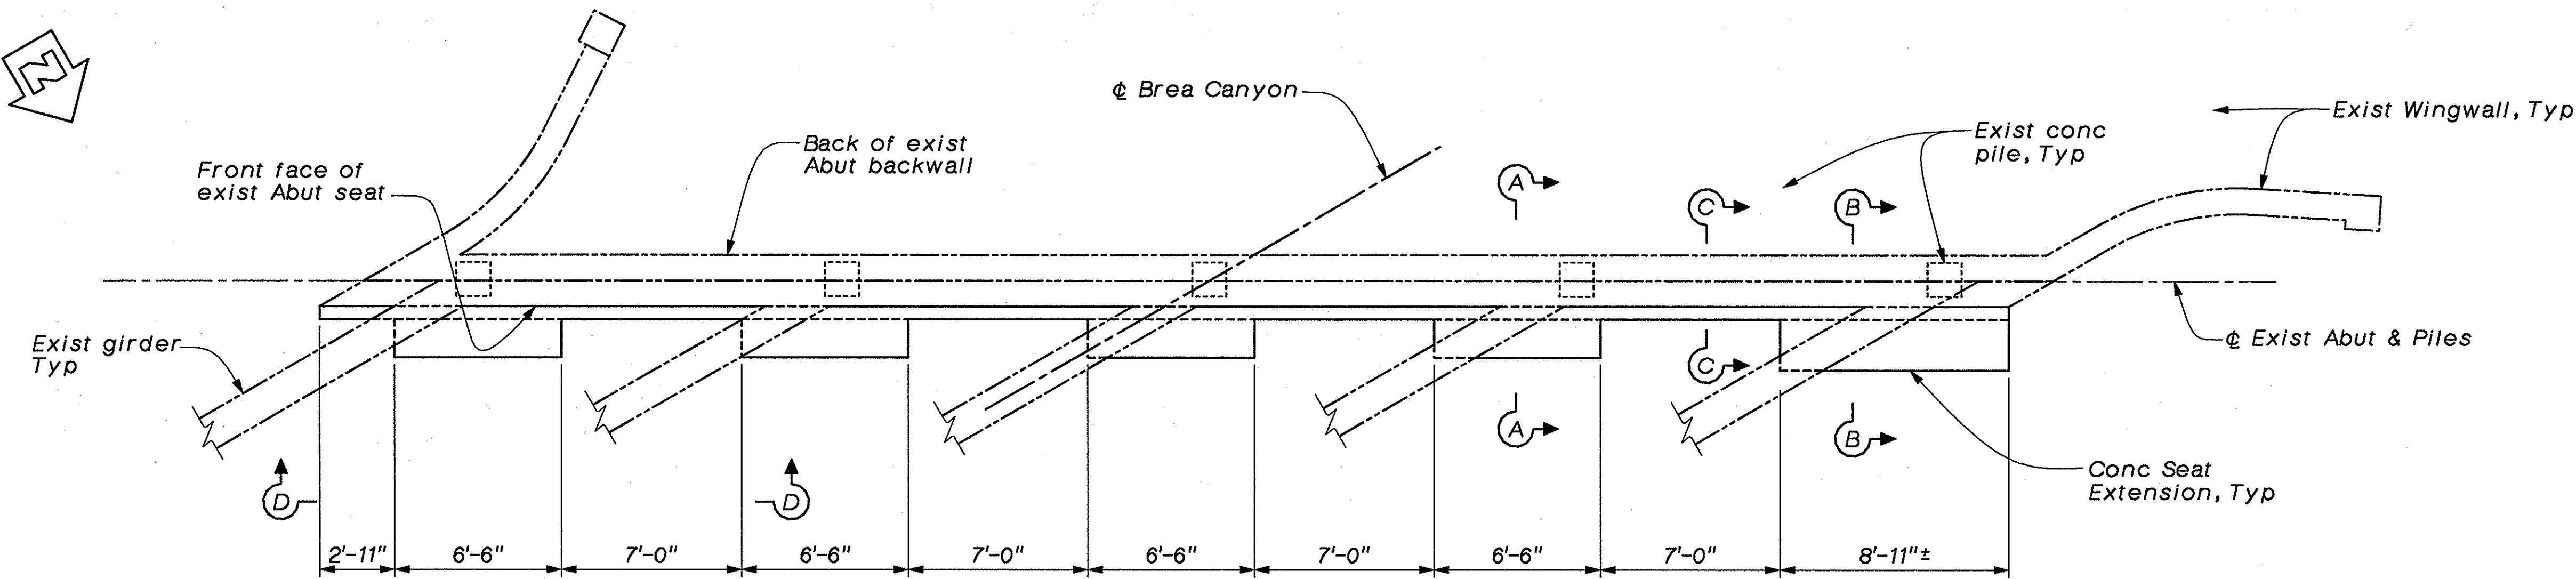


Note: Exist deck slab not shown for clarity.
 PLAN
 1/4" = 1'-0"
 Abutment 1 shown
 Abutment 4 similar

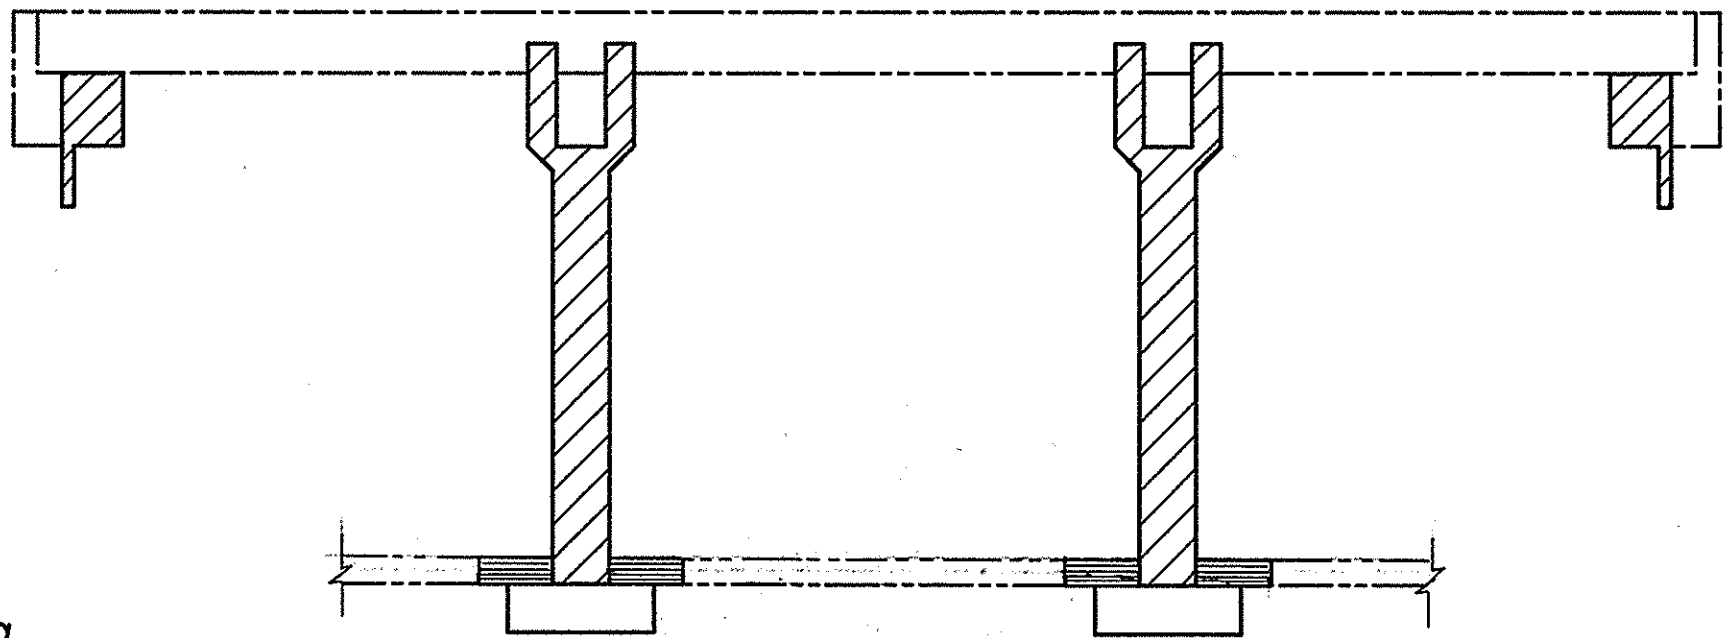

CONCRETE STRENGTH AND TYPE LIMITS

No Scale

- Structural Concrete, Bridge
- Structural Concrete, Bridge Footing
- Concrete, Channel Lining
- Indicates Existing Structure

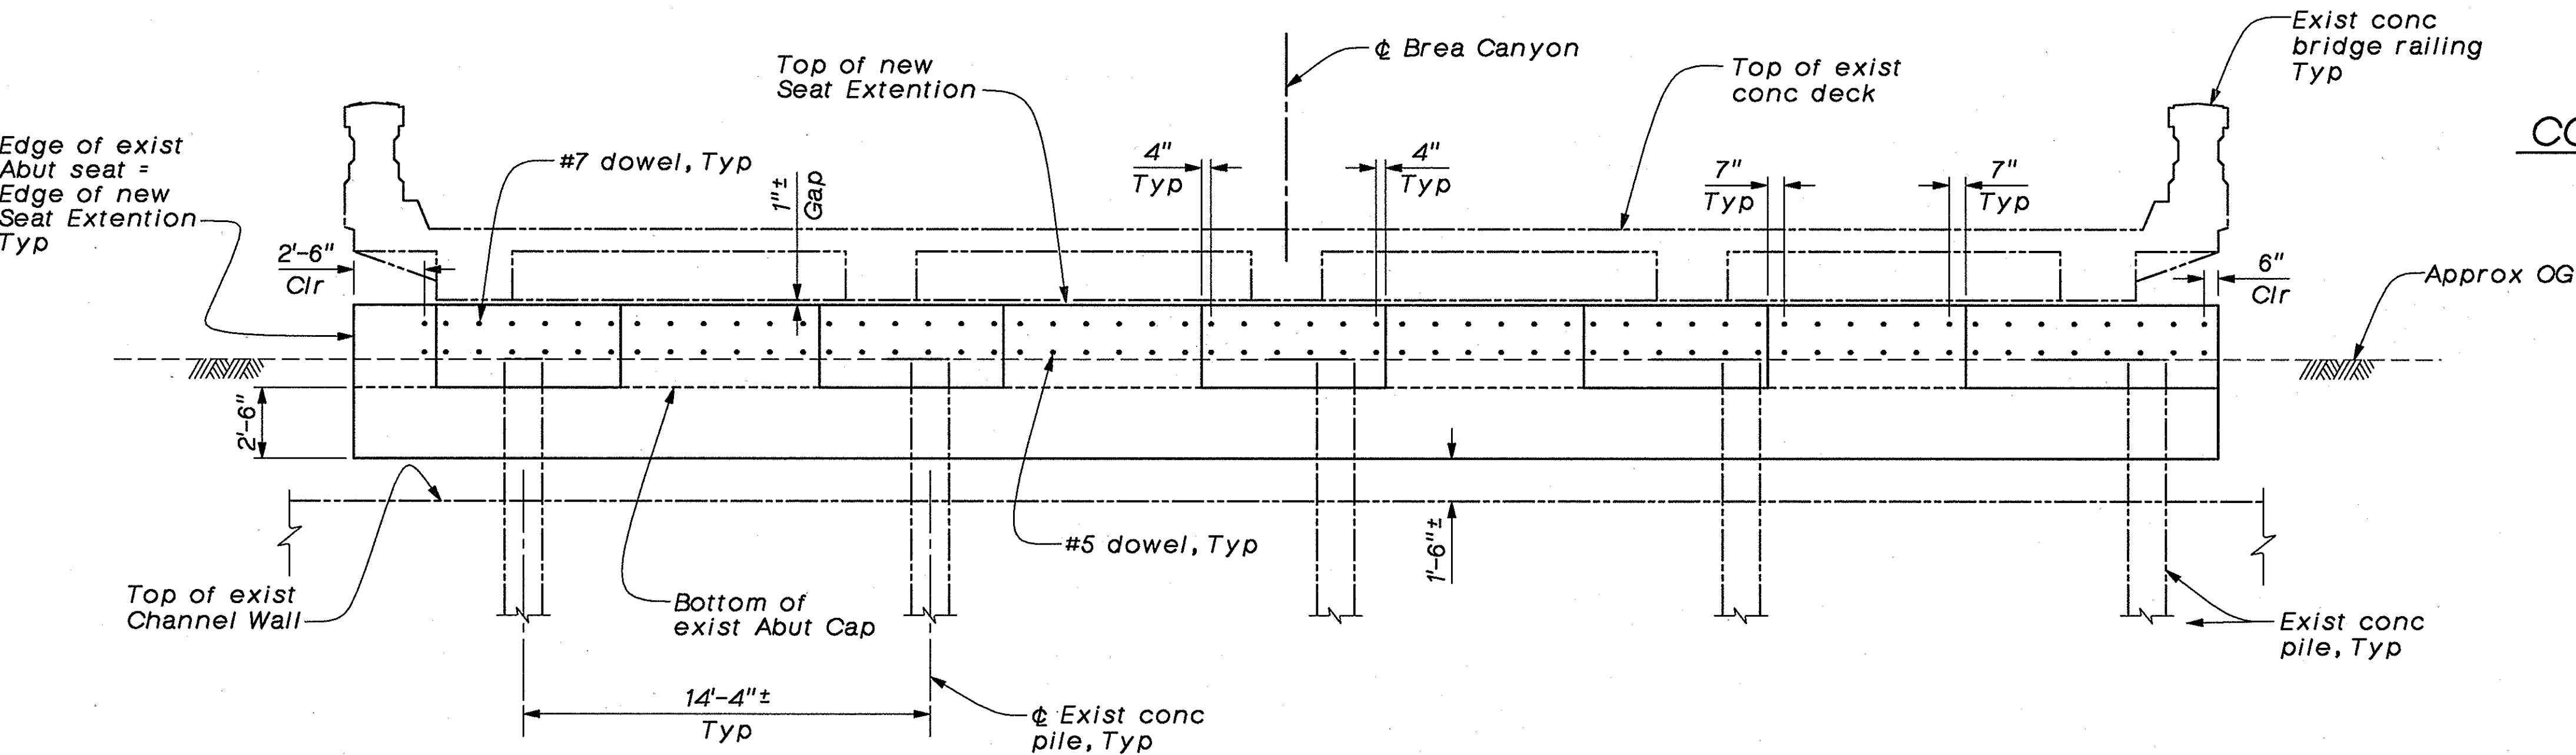

ELEVATION
 1/4" = 1'-0"
 Abutment 1 shown
 Abutment 4 similar

Note:
 The Contractor shall verify all controlling field dimensions before ordering or fabricating any material.

- Notes:
- For Sections A-A, B-B, C-C, & "View D-D", see "Abutment Retrofit Details No. 2" sheet.

SHAWN SUN DESIGN OVERSIGHT 10/1/97 SIGN OFF DATE		DESIGN BY G.J.N. / H. LAM DETAILS BY R. ANDRASEK QUANTITIES BY H. LAM	CHECKED R. CHAN CHECKED R. CHAN/J. LU CHECKED R. CHAN	PREPARED FOR THE COUNTY OF ORANGE	G.J. NASCIMENTO PROJECT ENGINEER	BRIDGE NO. 55C-0123 POST MILE	EARTHQUAKE RETROFIT BREA CANYON BRIDGE No. 1 ABUTMENT RETROFIT DETAILS No. 1
ORIGINAL SCALE IN INCHES FOR REDUCED PLANS		0 1 2 3		CU 12 152 EA L02105	DISREGARD PRINTS BEARING EARLIER REVISION DATES		REVISION DATES (PRELIMINARY STAGE ONLY) SHEET 3 OF 8