
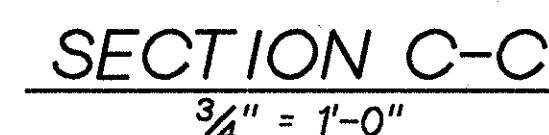
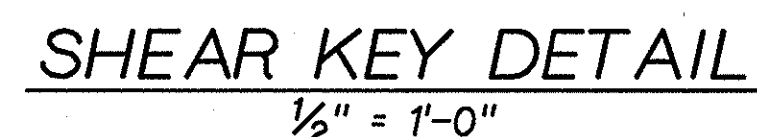


AS BUILT

NO AS BUILT CHANGES

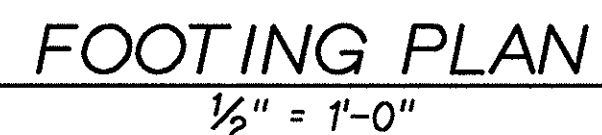

Note:
The Contractor shall verify all
controlling field dimensions before
ordering or fabricating any material.

16 of 17