



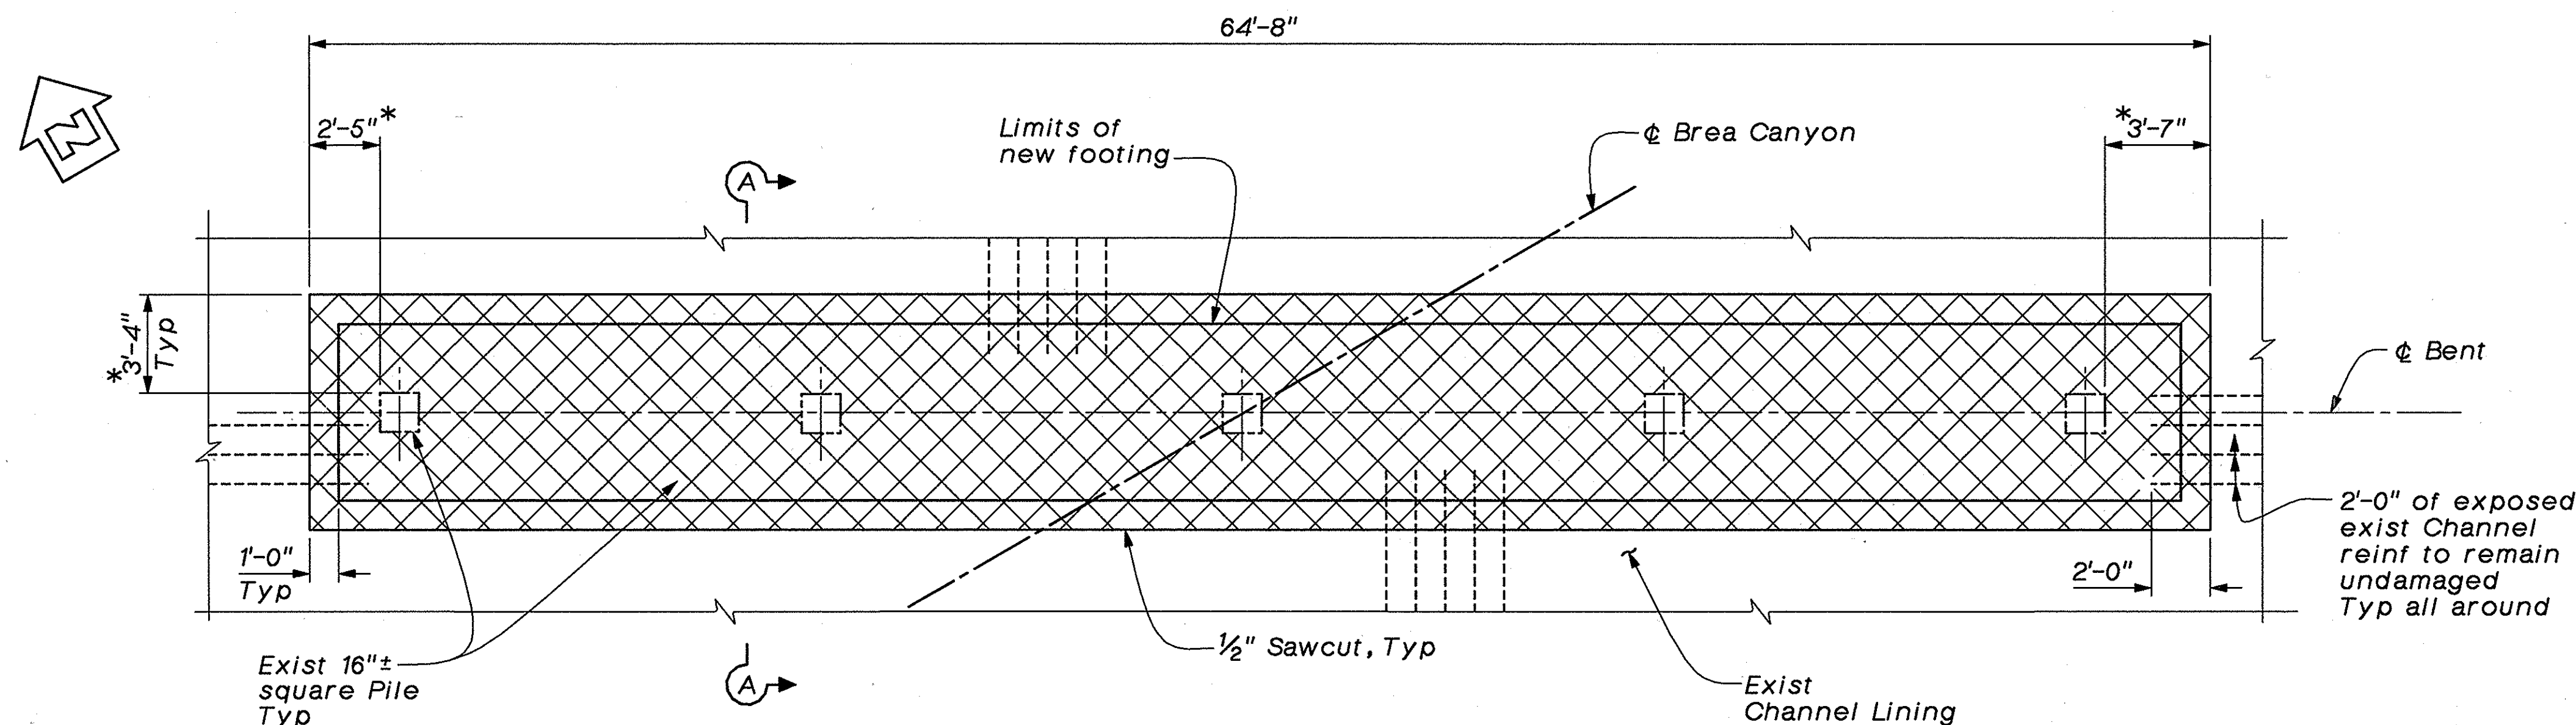


LIMITS OF PAYMENT FOR CONCRETE REMOVAL
 $\frac{1}{4}" = 1'-0"$

* Measured from edge of exist pile

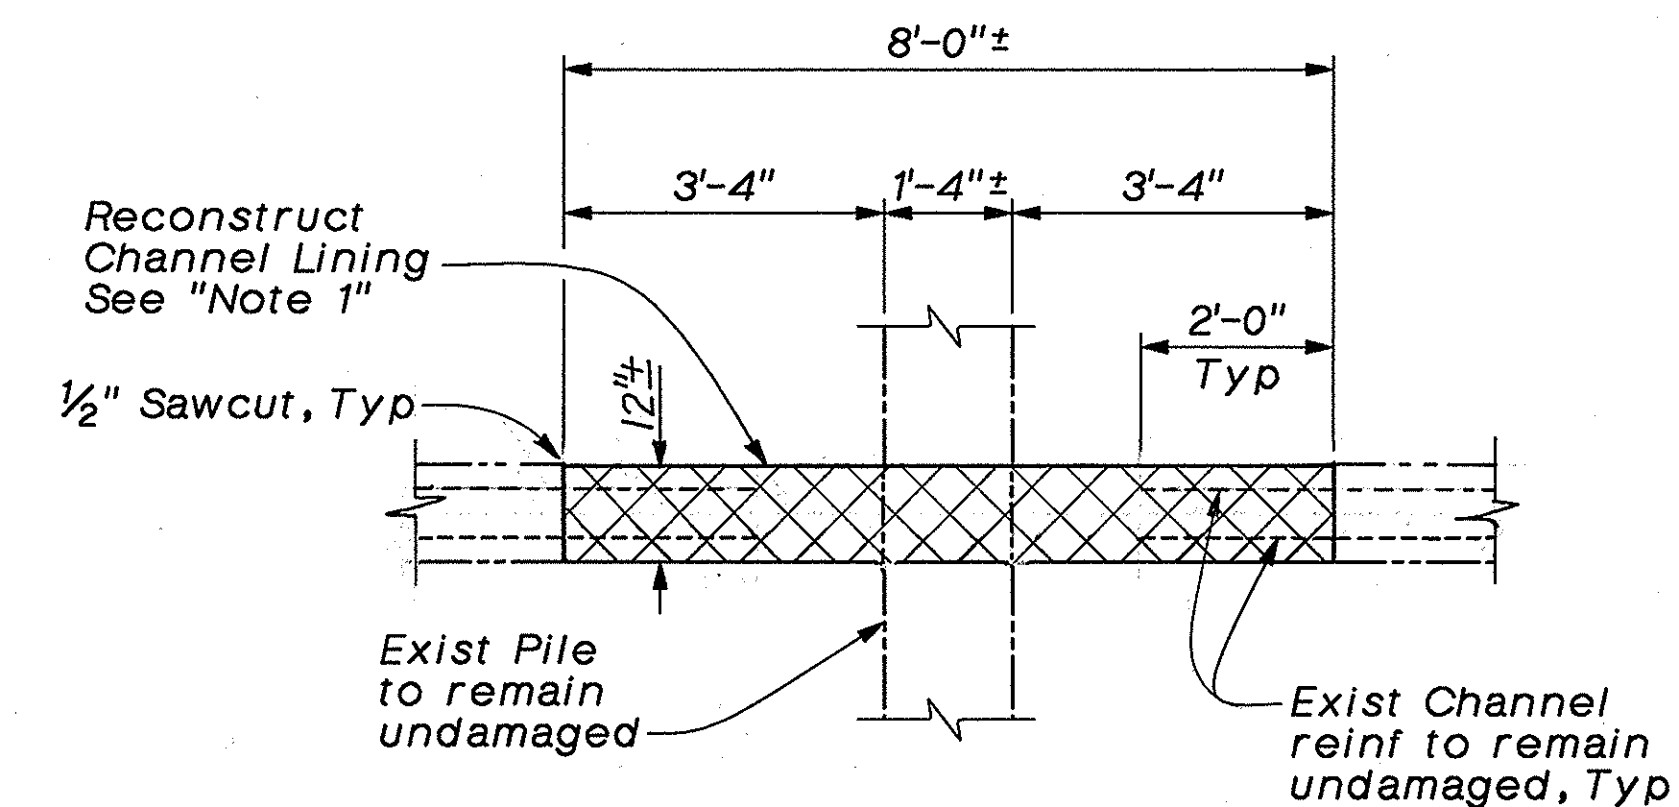


SECTION A-A
 $\frac{1}{2}" = 1'-0"$


- LEGEND**
- Structure Excavation (Type D)
 - Structure Backfill
 - Concrete Removal
 - Structure Excavation (Bridge)
 - Structure Backfill - Portland Cement Concrete

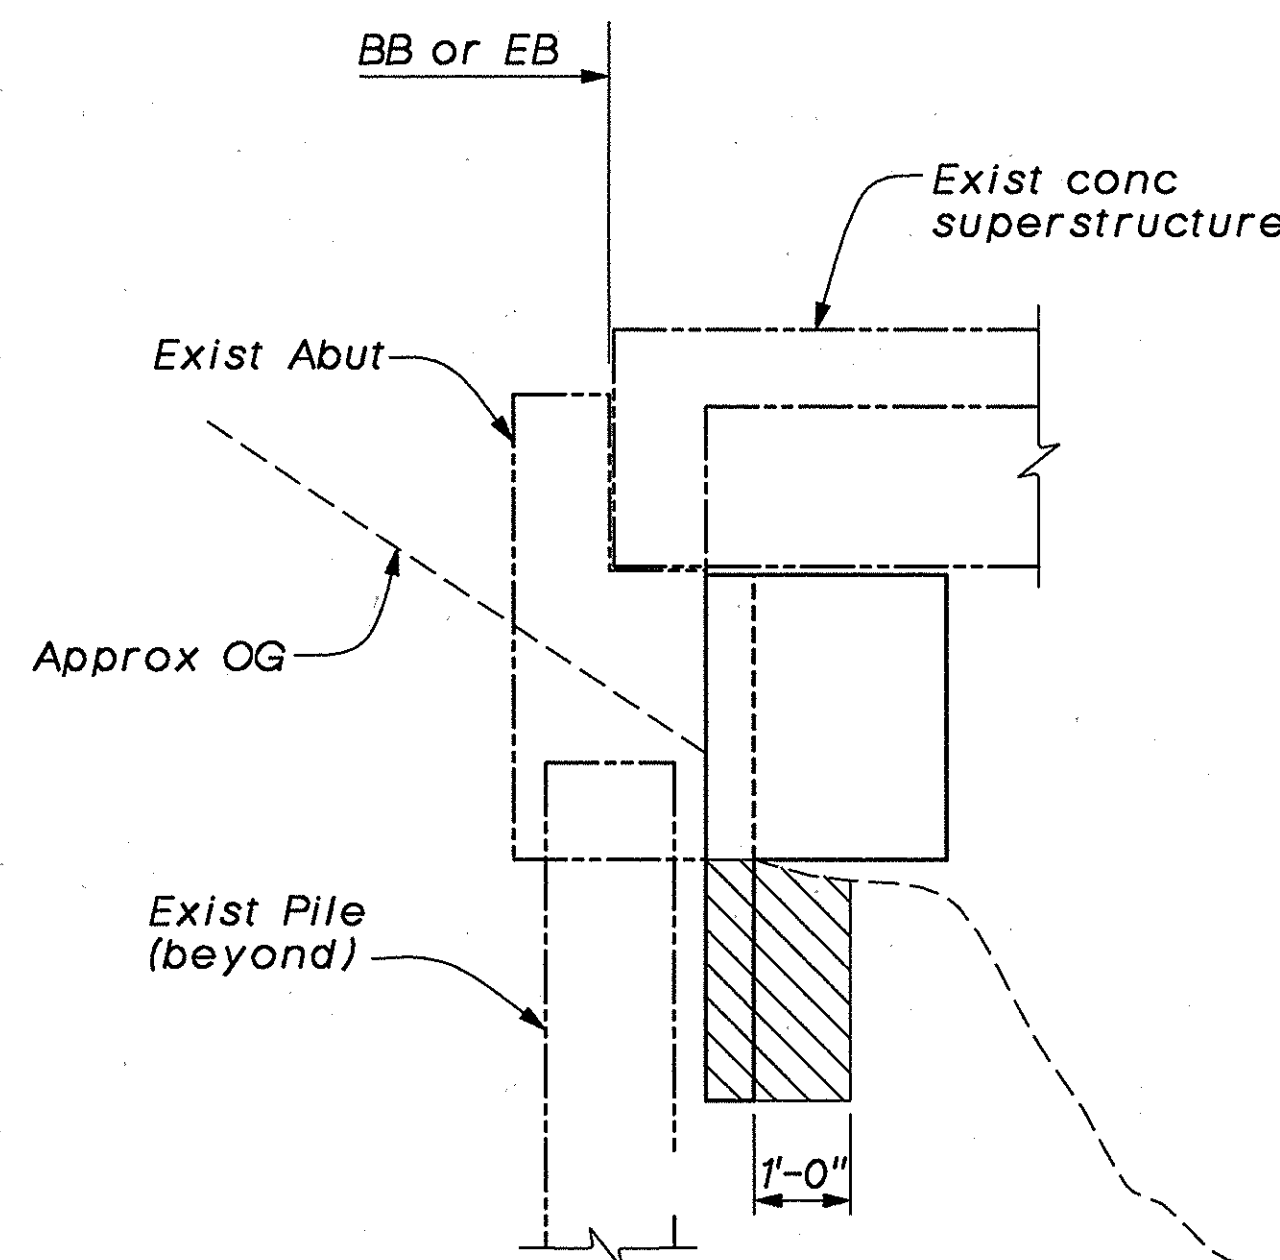


EXCAVATION

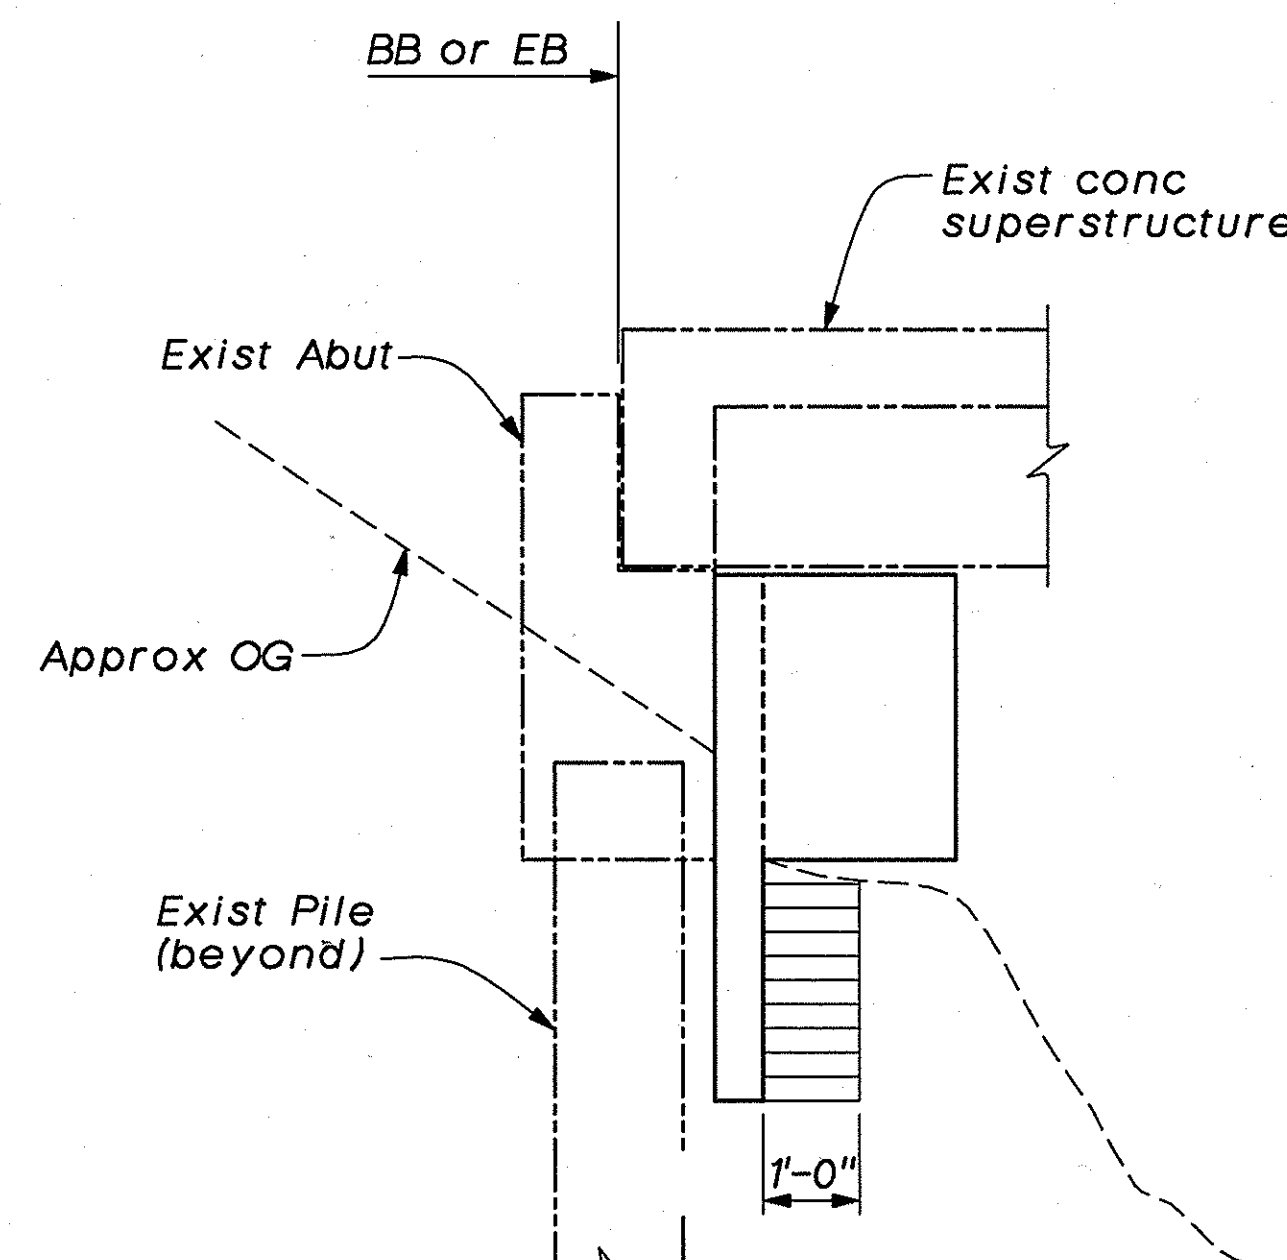

BACKFILL

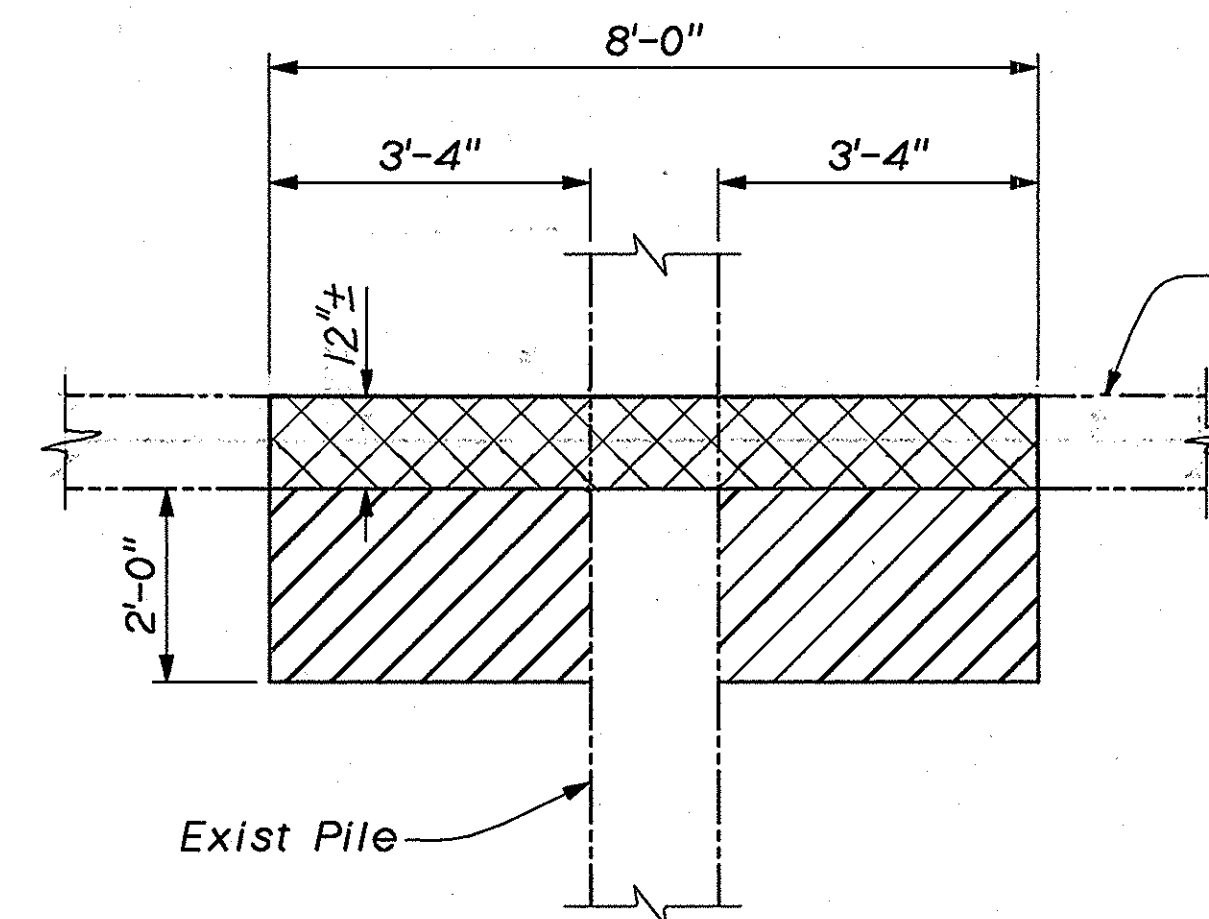

EXCAVATION

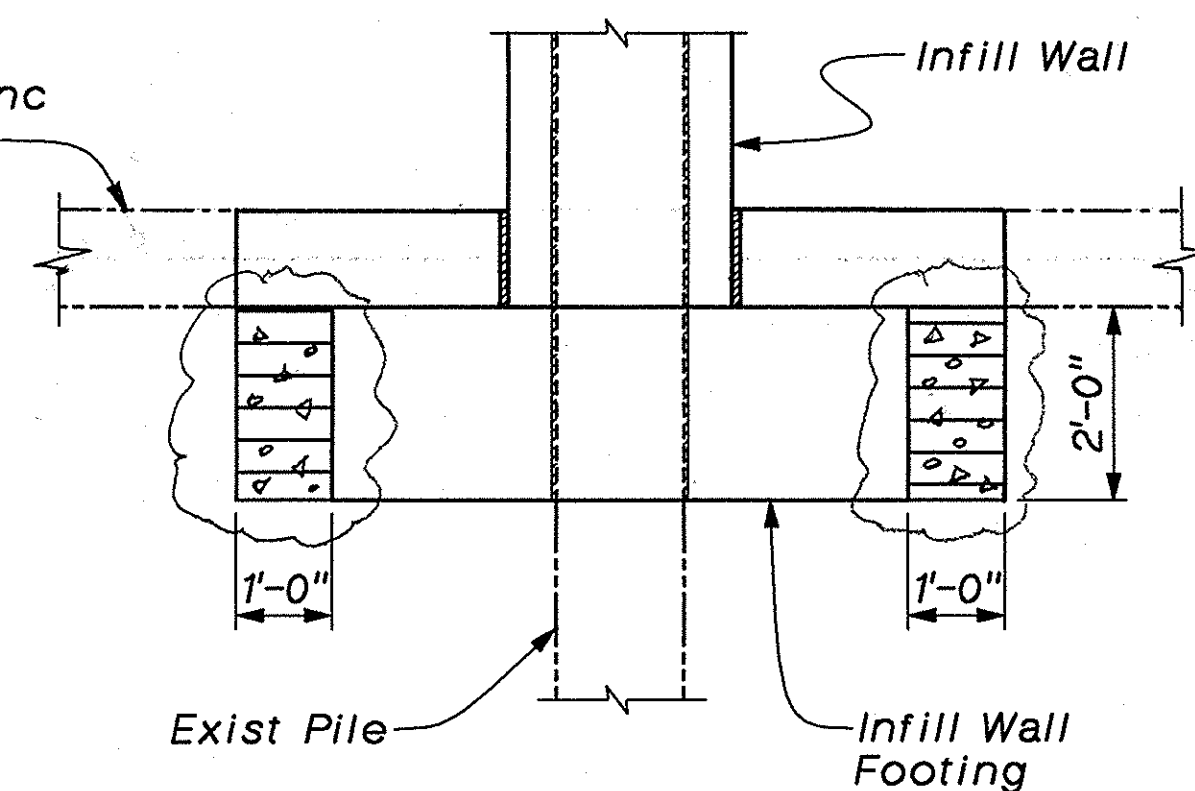

BACKFILL

AS BUILT

Note:
 1. For new Channel Lining details, see "Channel Lining Detail" on "Bent Retrofit Details No. 2" sheet.

CORRECTIONS BY	G. ZAUN / RWH
CONTRACT NO.	59Y021
DATE	2-8-02 / 10-24-02

Note:
 The Contractor shall verify all controlling field dimensions before ordering or fabricating any material.

SHAWN SUN
 DESIGN OVERSIGHT
 10/1/97

DESIGN	BY G.J.N. / H. LAM	CHECKED R. CHAN
DETAILS	BY R. ANDRASEK	CHECKED R. CHAN/J. LU
QUANTITIES	BY H. LAM	CHECKED R. CHAN

PREPARED FOR THE
 COUNTY OF
 ORANGE

G.J. NASCIMENTO
 PROJECT ENGINEER

BRIDGE NO.
 55C-0123
 POST MILE

EARTHQUAKE RETROFIT

BREA CANYON BRIDGE No. 1

MISCELLANEOUS DETAILS

ORIGINAL SCALE IN INCHES
 FOR REDUCED PLANS

0 1 2 3

CU 12 152
 EA L02105

DISREGARD PRINTS BEARING
 EARLIER REVISION DATES

REVISION DATES (PRELIMINARY STAGE ONLY)

SHEET 8 OF 8

17 OF 17