



CONSTRUCTION NOTES

- 1- CONST. GABION SLOPE PROTECTION AS SHOWN IN THESE PLANS AND SPECIAL PROVISIONS.
- 2- PROTECT
- 3- BACKFILL WITH COMPACTED NATIVE MATERIAL
- 4- BACKFILL WITH NATIVE MATERIAL AND JOIN ADJACENT GROUND WITH 2:1 SLOPE OVER THE U/S END OF THE GABION STRUCTURE
- 5- SALVAGE AND REPLACE EXIST. GUARD RAIL
- 6- SAWCUT REMOVE AND RECONSTRUCT A.C. SHOULDER PAVEMENT 24'X2'X3" AS SHOWN
- 7- PLACE FILTER FABRIC AS SHOWN
- 8- CUT AND TIE GABION BASKETS AS NECESSARY TO CONSTRUCT THE GABION STRUCTURE AS SHOWN
- 9- PLACE SALVAGED WASTE ROCK AT TOE OF BULKHEAD

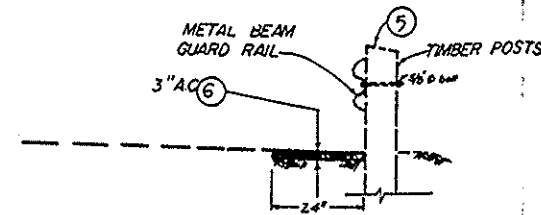


A.C. SHOULDER REPAIR
STRUCTURAL SECTION
NO SCALE

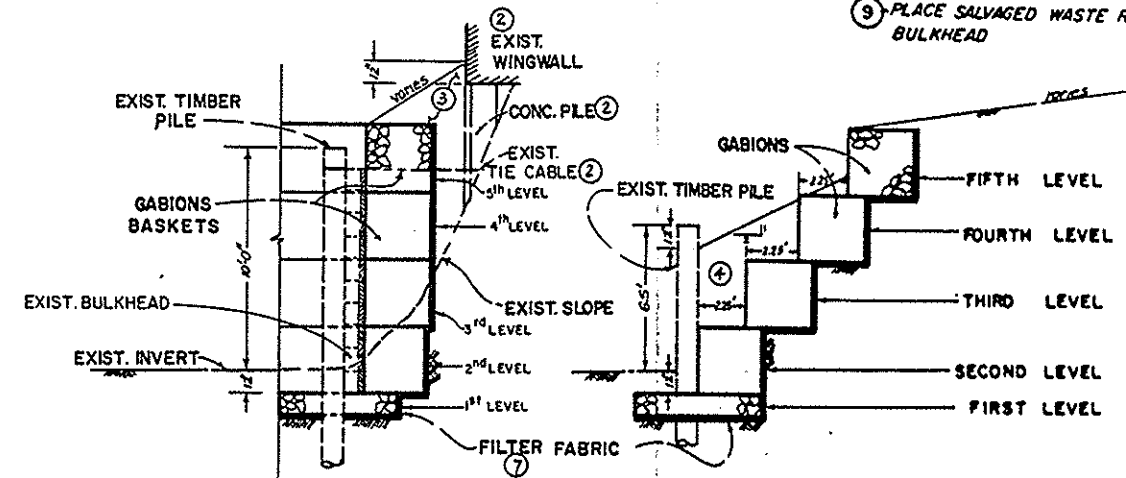

SECTION-AA
SCALE 1"=4'-0"





SECTION-BB
SCALE 1"=4'-0"

FOR THE LAYOUT OF THE INDIVIDUAL GABION LEVELS SEE PLAN VIEWS GABION STRUCTURES BELOW

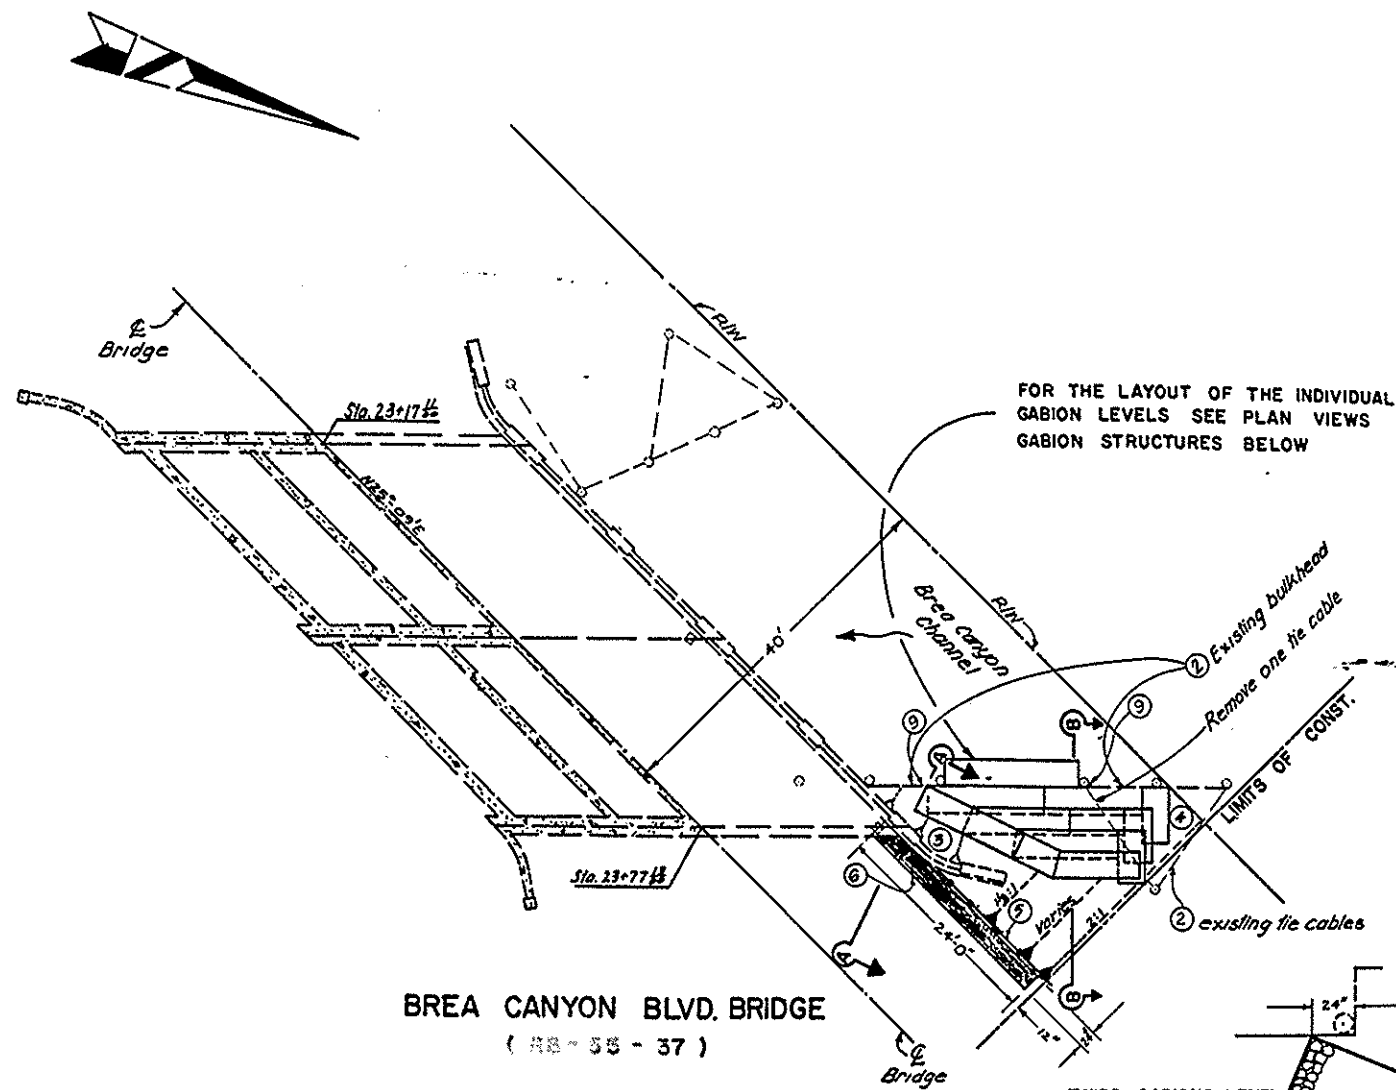


BREA CANYON BLVD. BRIDGE
(RB-55-37)

LEFT HALF SECTIONAL PLAN
SCALE 1"=10'-0"

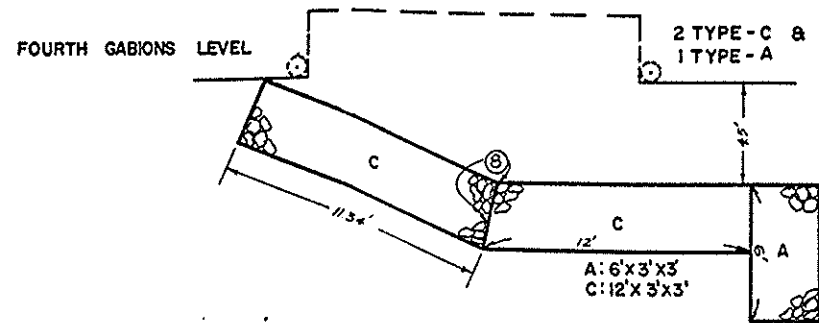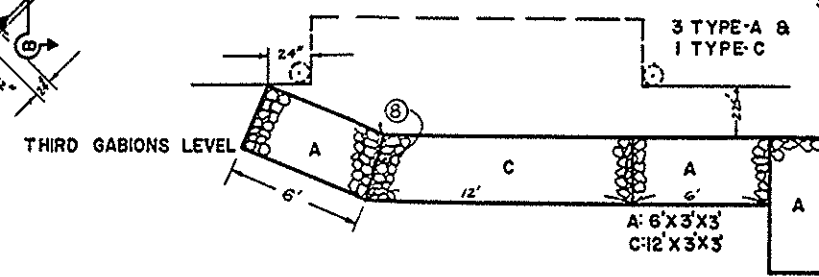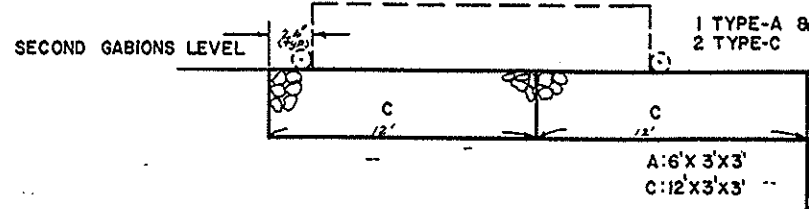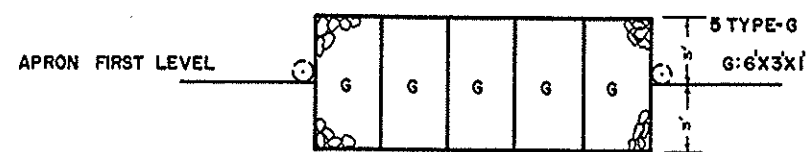

PLAN VIEWS
GABIONS STRUCTURES
NO SCALE

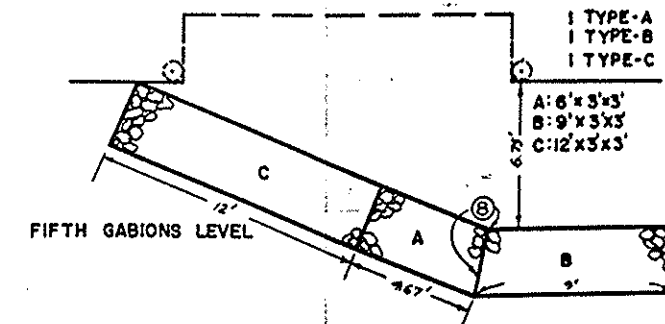

1/2 0 1 2
3 inches on original drawing

ORANGE COUNTY ENVIRONMENTAL MANAGEMENT AGENCY			
BREA CANYON BLVD BRIDGE RB-55-37			
GABIONS SLOPE PROTECTION			
DATE	DESCRIPTION	REVISIONS	SHEET
DESIGNED	SCALE	DATE	2
DRAWN	AS SHOWN	DATE	2