




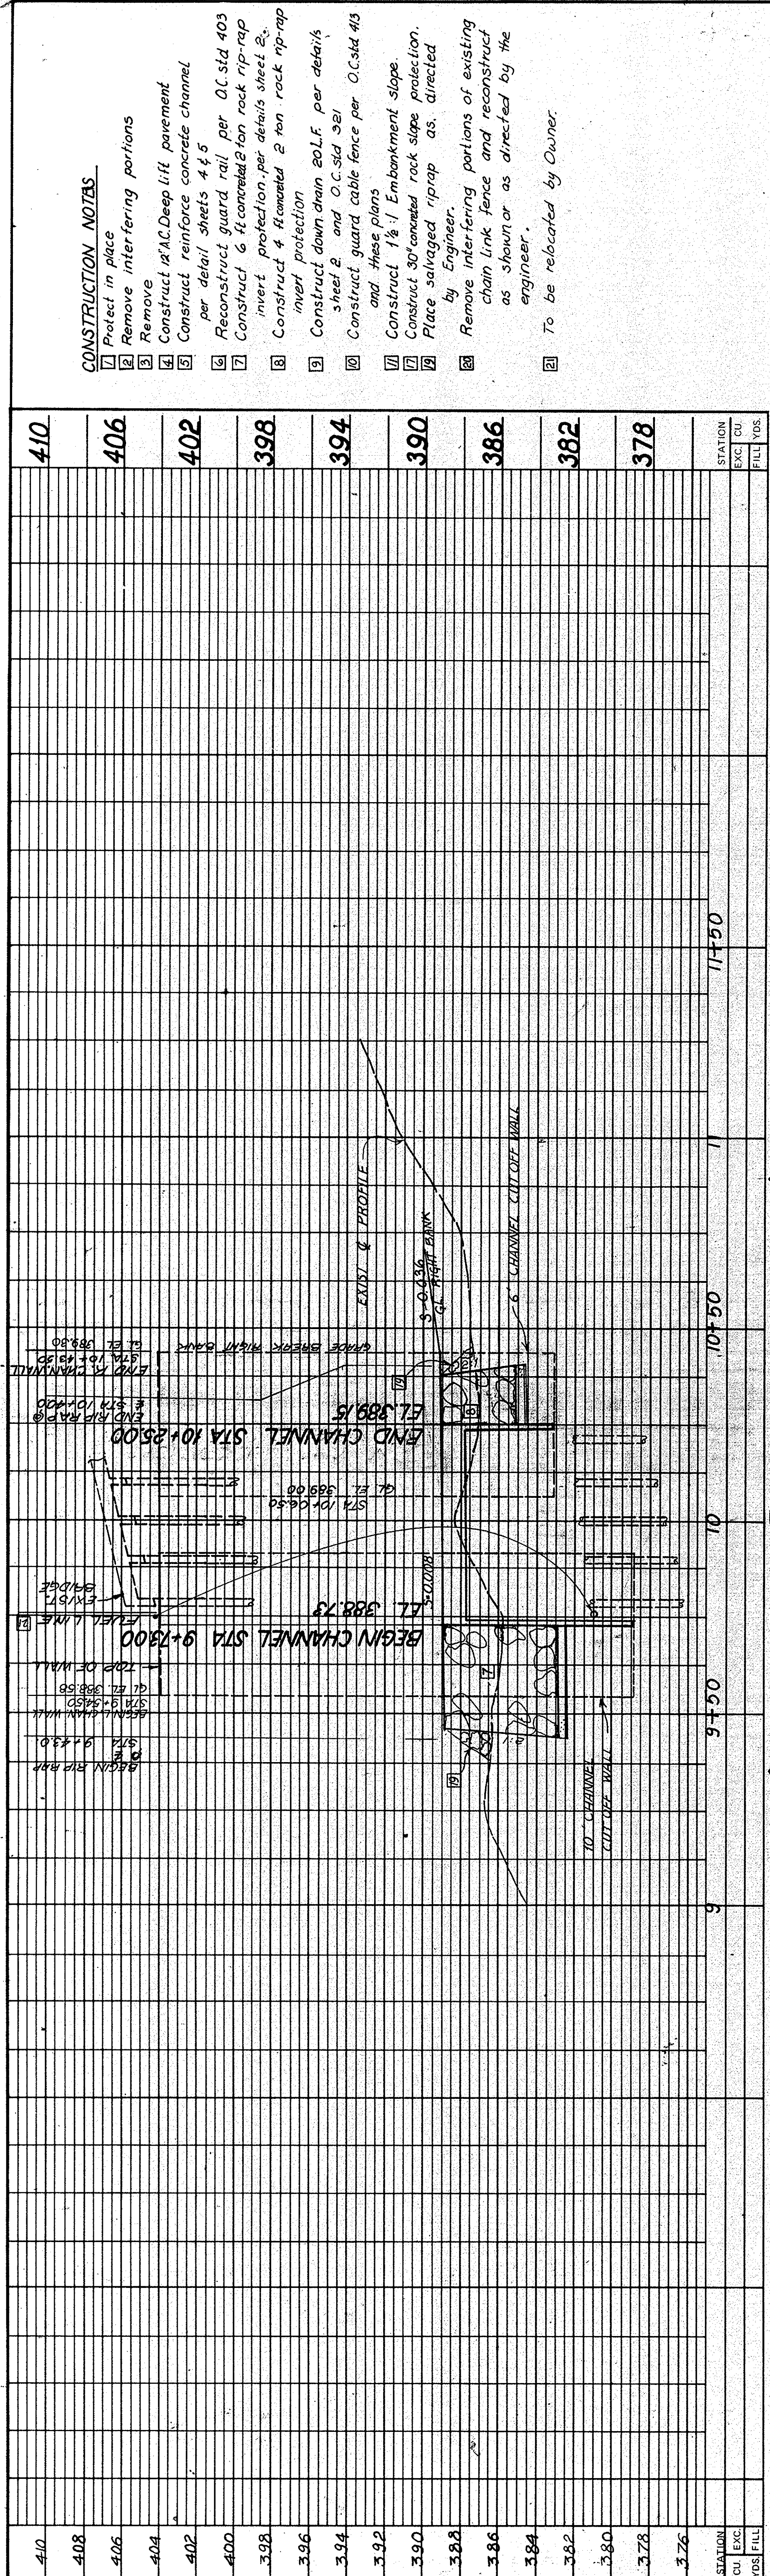

HYDRAULIC DATA	C_{100}	n	b	s	d_m	d_c	Z	V_m	V_c	F_n
D/S	11500	0.05	36	0.036	9.72	11.50	25.1	19.60	15.44	1.31
CHANNEL	11500	0.014	37	0.008	9.62	14.43	0	3230	2154	1.80
L/S	11500	0.05	24	0.036	9.84	11.28	4.1	18.40	14.80	1.31

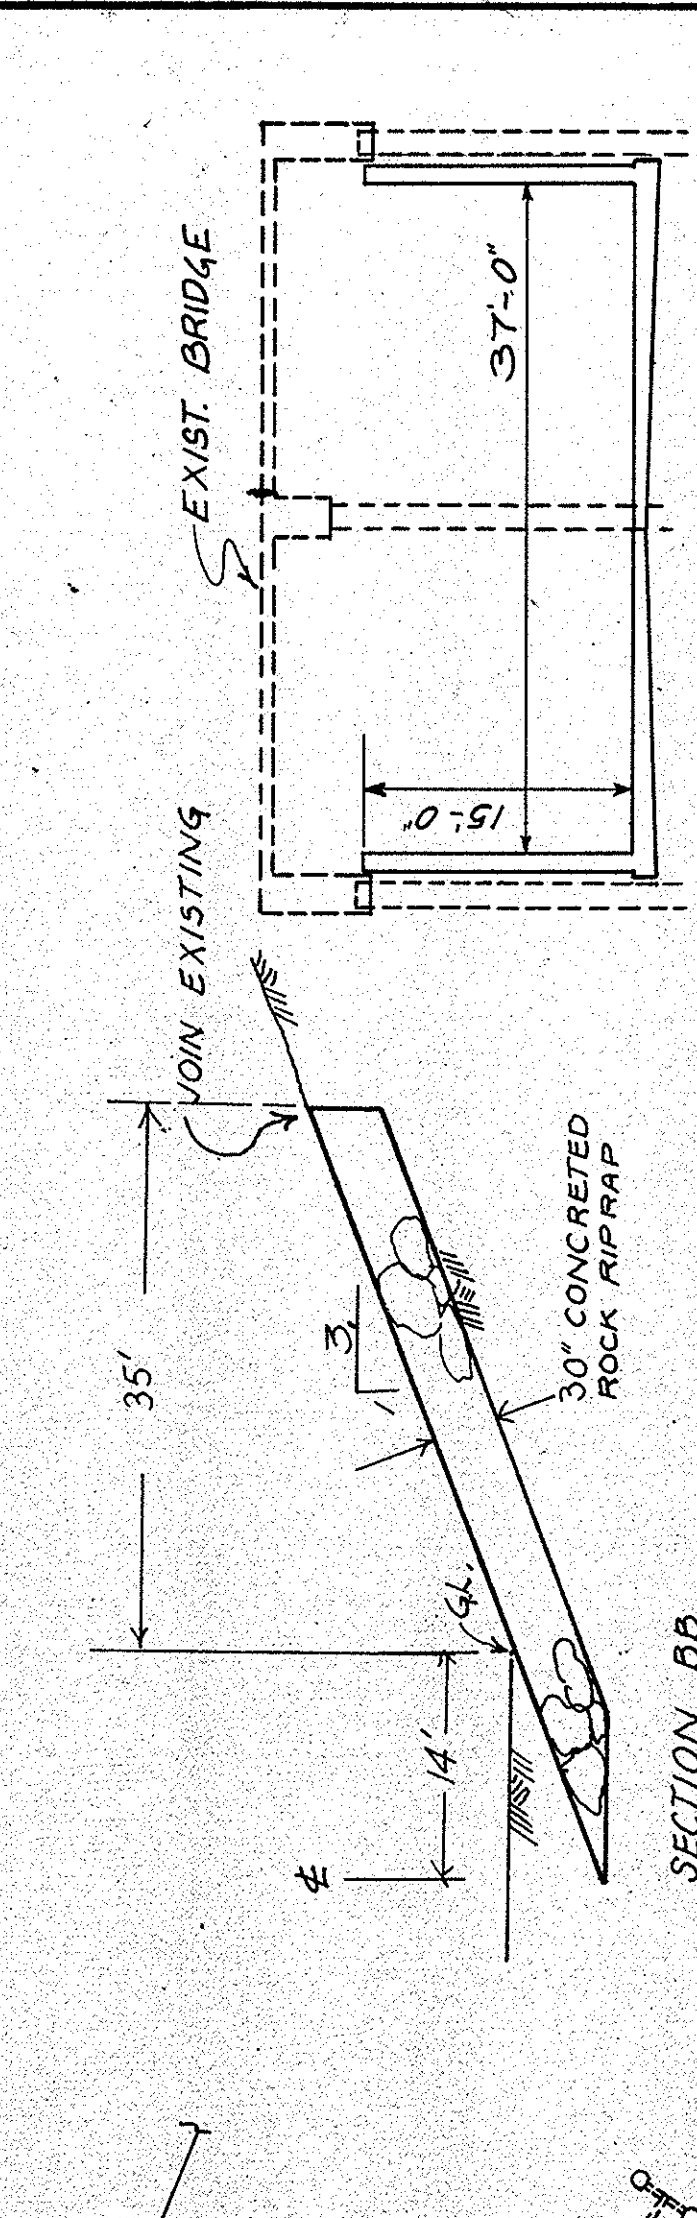


NOTE: SEE SHEET 2 FOR ROAD WORK

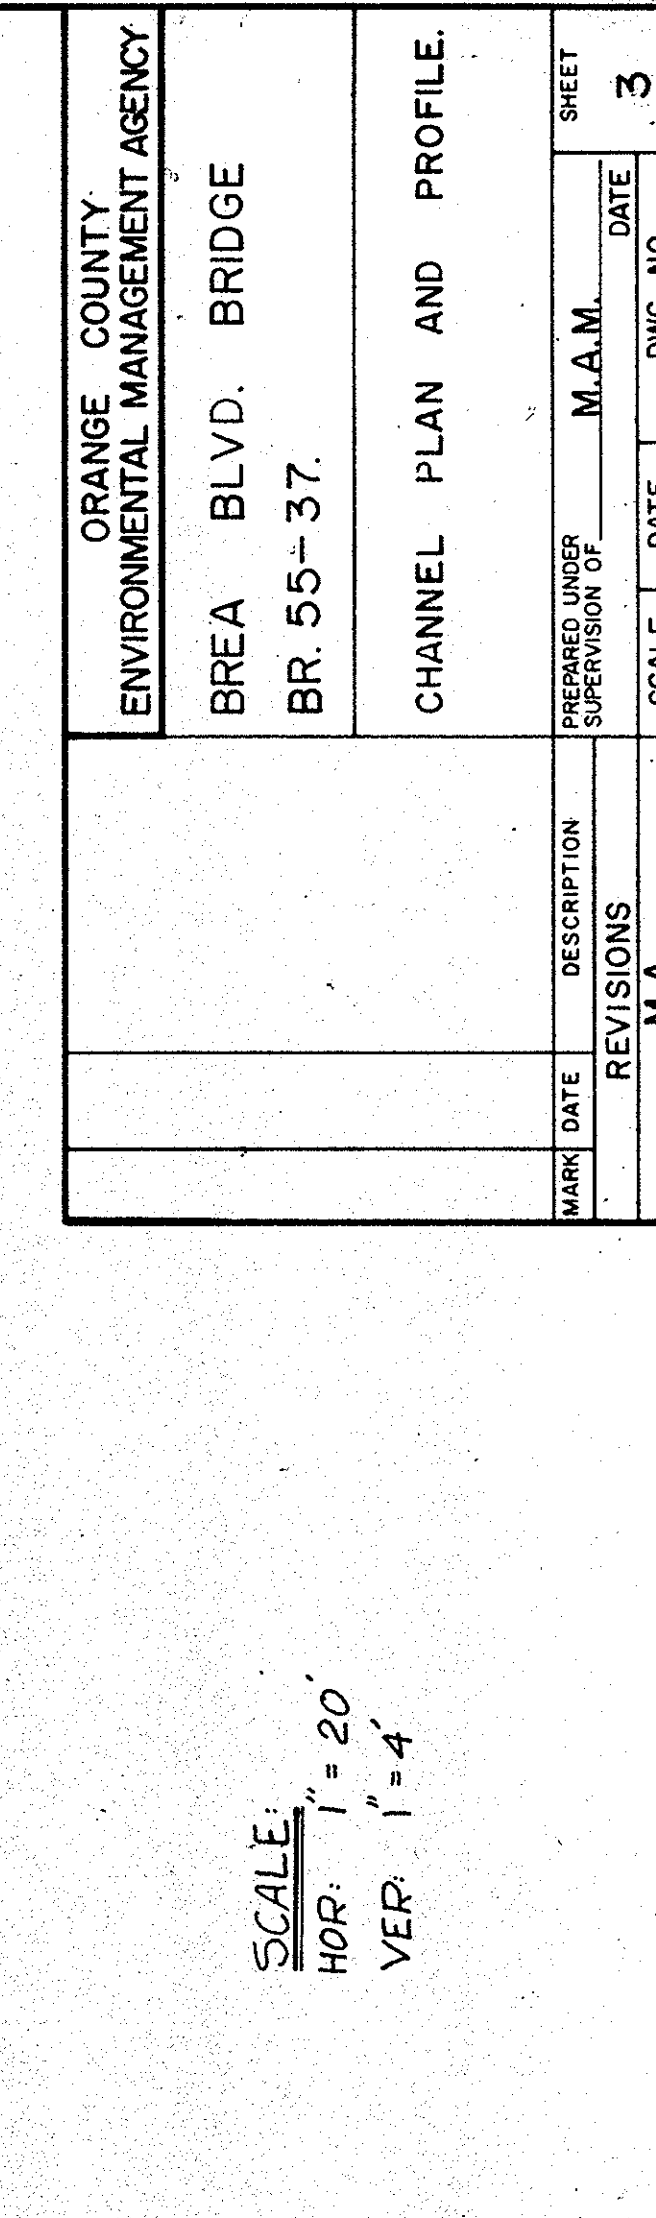


DESIGNED	DATE	SCALE	DATE	DWG. NO.	SHEET
M.A.	3-80	3-80	9/13/23	3	3

STATION	CUT	EXC.	FILL	YDS.
410				
408				
406				
HYDRAULIC DATA	C_{100}	n	b	s	d_m	d_c	Z	V_m	V_c	F_n
D/S	11500	0.05	36	0.036	9.72	11.50	25.1	19.60	15.44	1.31
CHANNEL	11500	0.014	37	0.008	9.62	14.43	0	3230	2154	1.80
L/S	11500	0.05	24	0.036	9.84	11.28	4.1	18.40	14.80	1.31

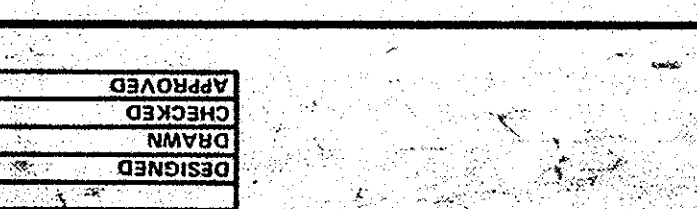

NOTE: SEE SHEET 2 FOR ROAD WORK

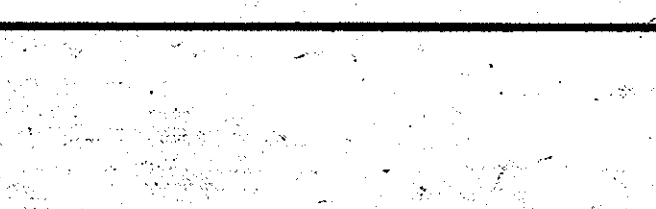

DESIGNED	DATE	SCALE	DATE	DWG. NO.	SHEET
M.A.	3-80	3-80	9/13/23	3	3