




Channel slope notes

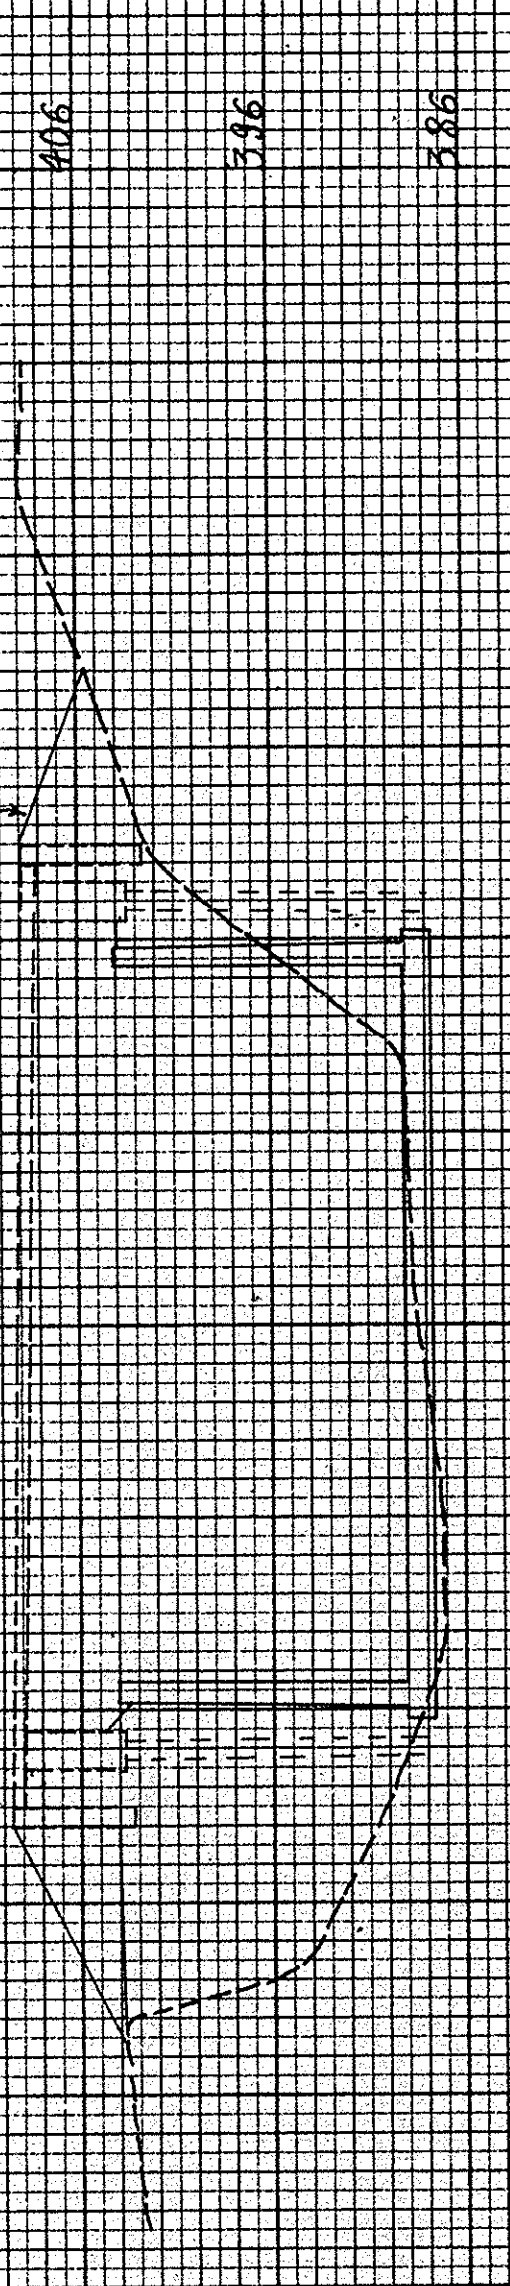


STA 9+00

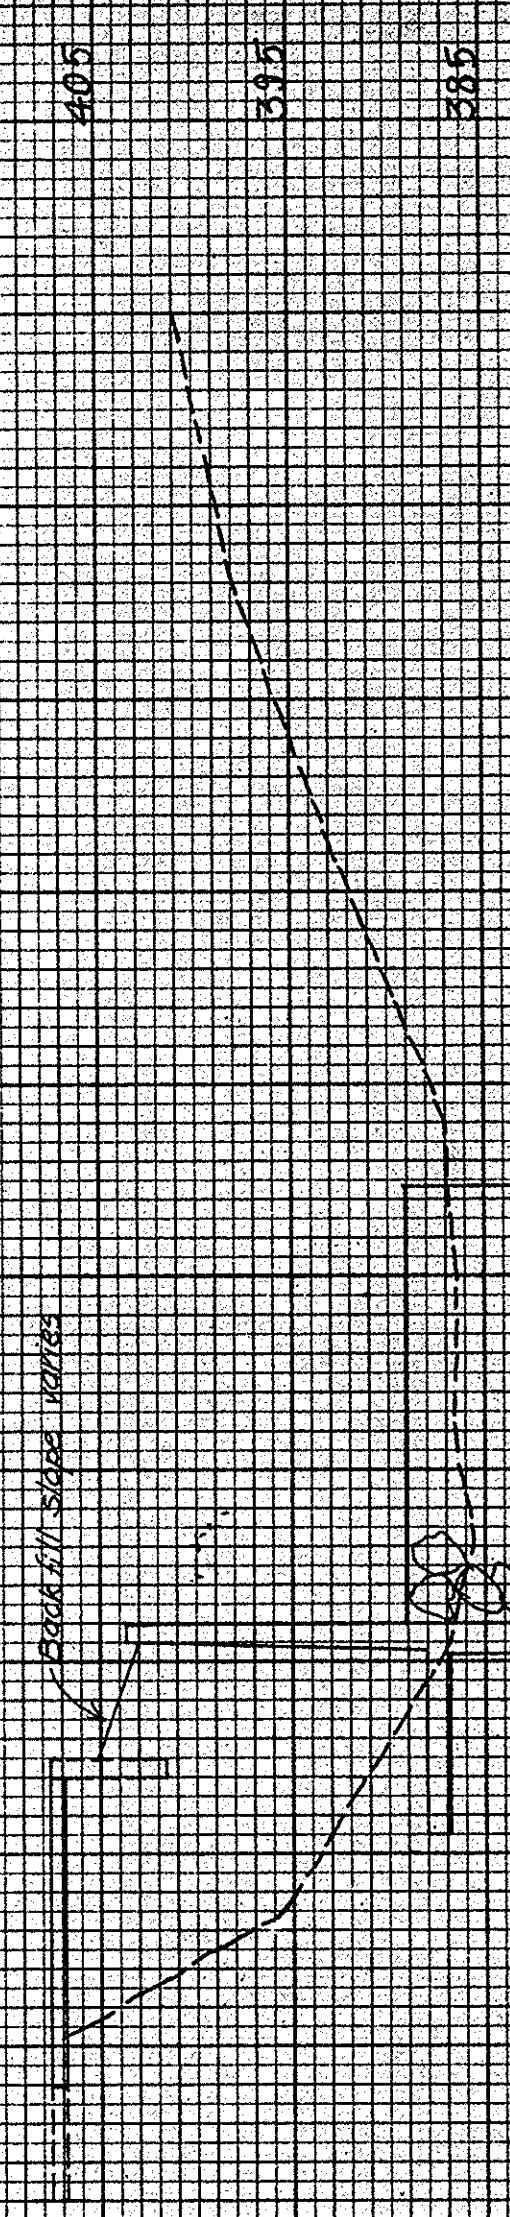

STA 9+00

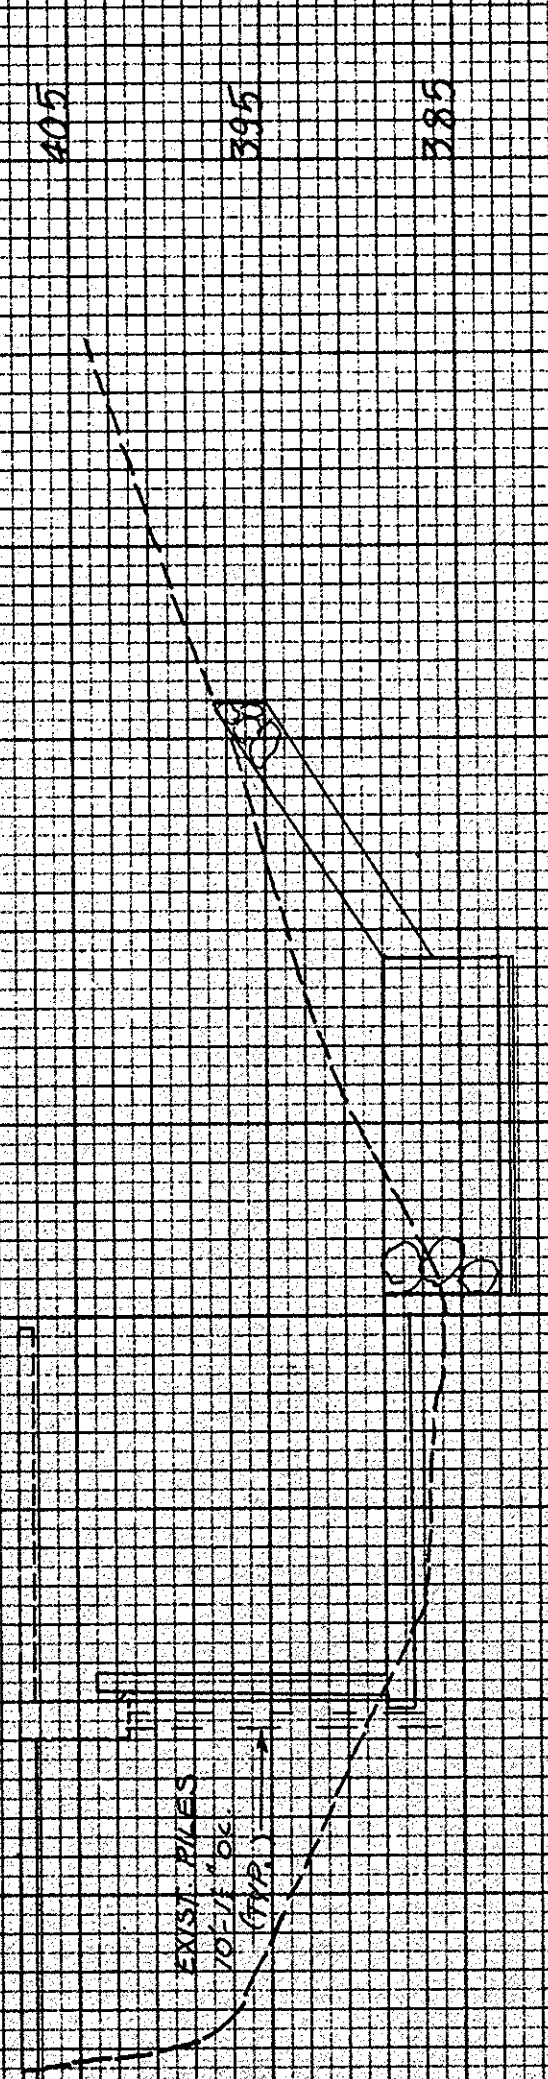


STA 9+75

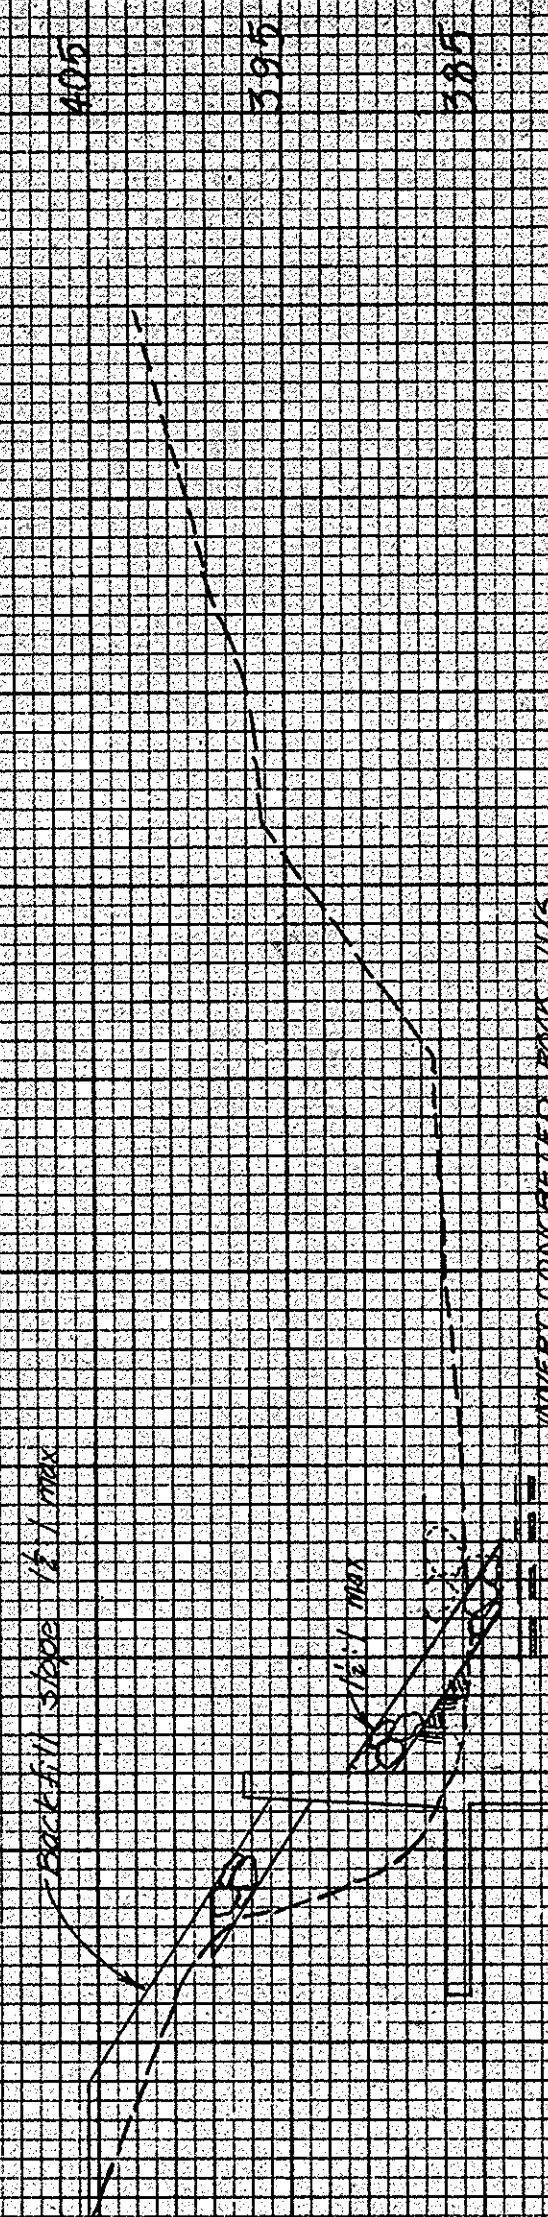

STA 9+75

Wing Wall No. 1
Excavation for rock mass (included in grouted rock mass)

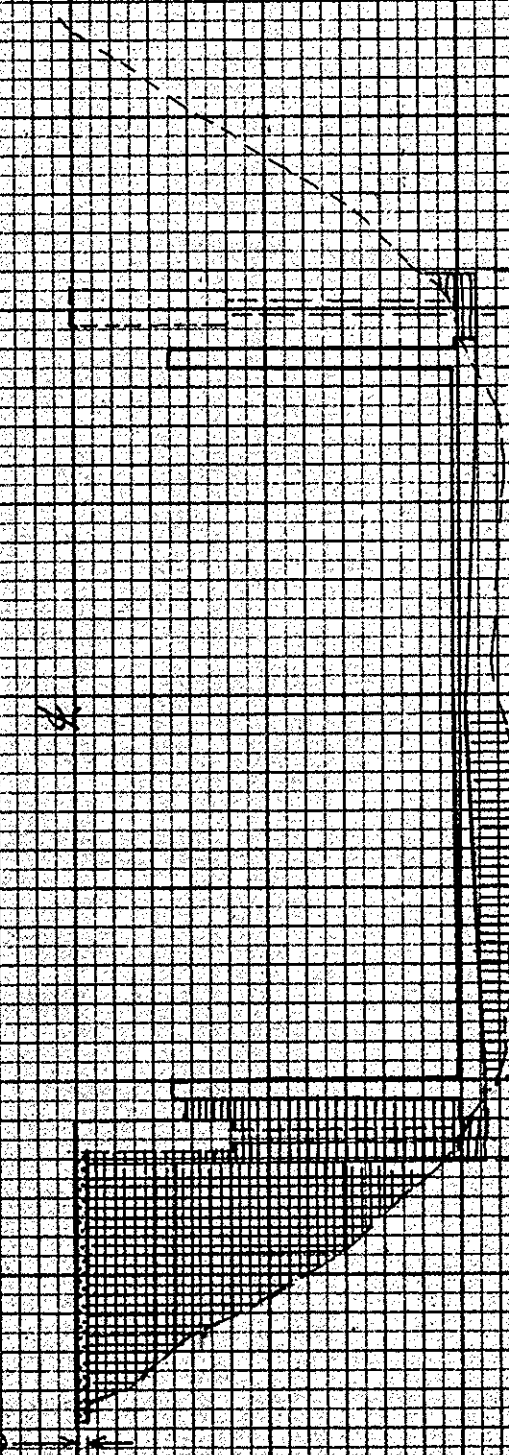

STA 9+18
END WING WALL

- Imported concrete
- Structural backfill (95% compaction rel min)
- Structural backfill (90% compaction rel min)
- Asphalt concrete
- Structural excavation
- Channel section
- PAY LIMITS

SCALE
HOR 1"=60'
VER 1"=0'

ORANGE COUNTY ENVIRONMENTAL MANAGEMENT AGENCY		BRE A BLVD. BRIDGE	
BR. 55-37.		CHANNEL CROSS SECTIONS.	
MARK	DATE	DESCRIPTION	M.A.M.
REVISIONS		DATE	DATE
DESIGNED M.A.		SCALE	DWG NO.
DRAWN H.S.H.		AS SHOWN	911323
PREPARED UNDER SUPERVISION OF		SHEET	
		6	

THIS SECTION SHOWS
POSITION OF BACK AND
FRONT OF EMBANKMENT
ELEVATION AND WING WALL
SLOPE

WING WALL NO. 1
OF THIS SECTION IS SHOWN DASHED
STA 9+18
END WING WALL