




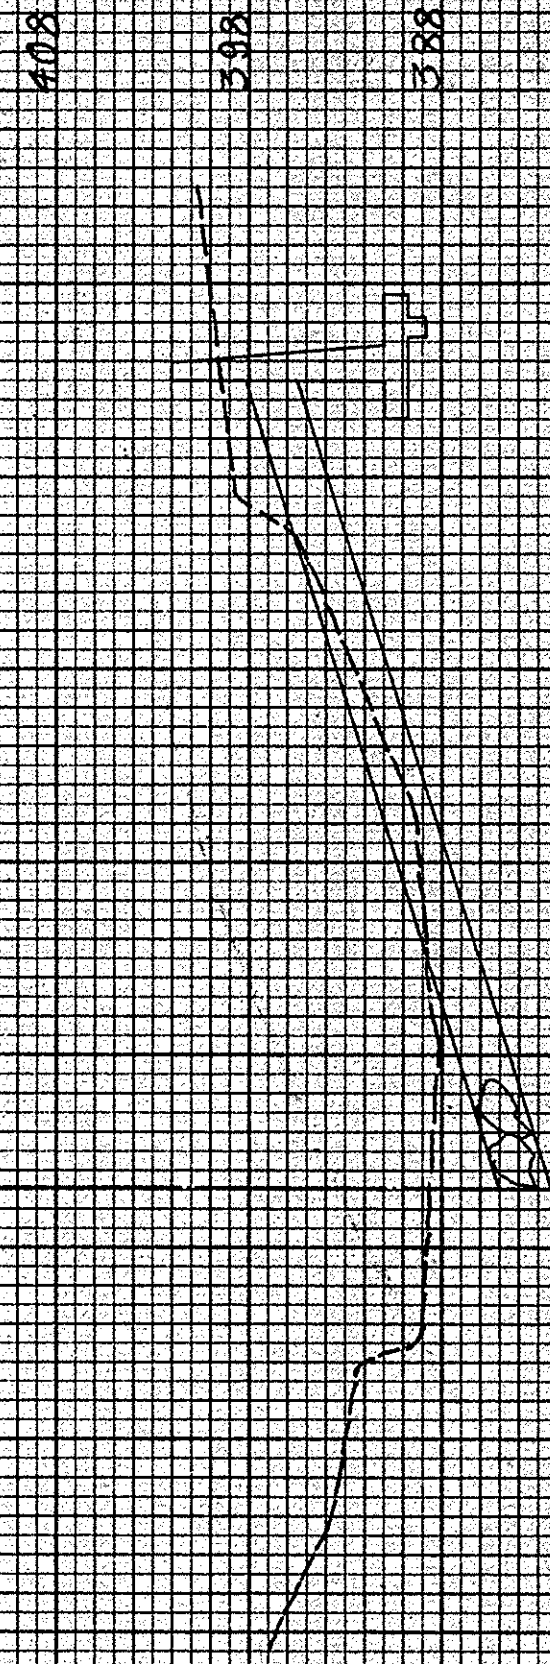


STA 10+16.86 SKewed 30°

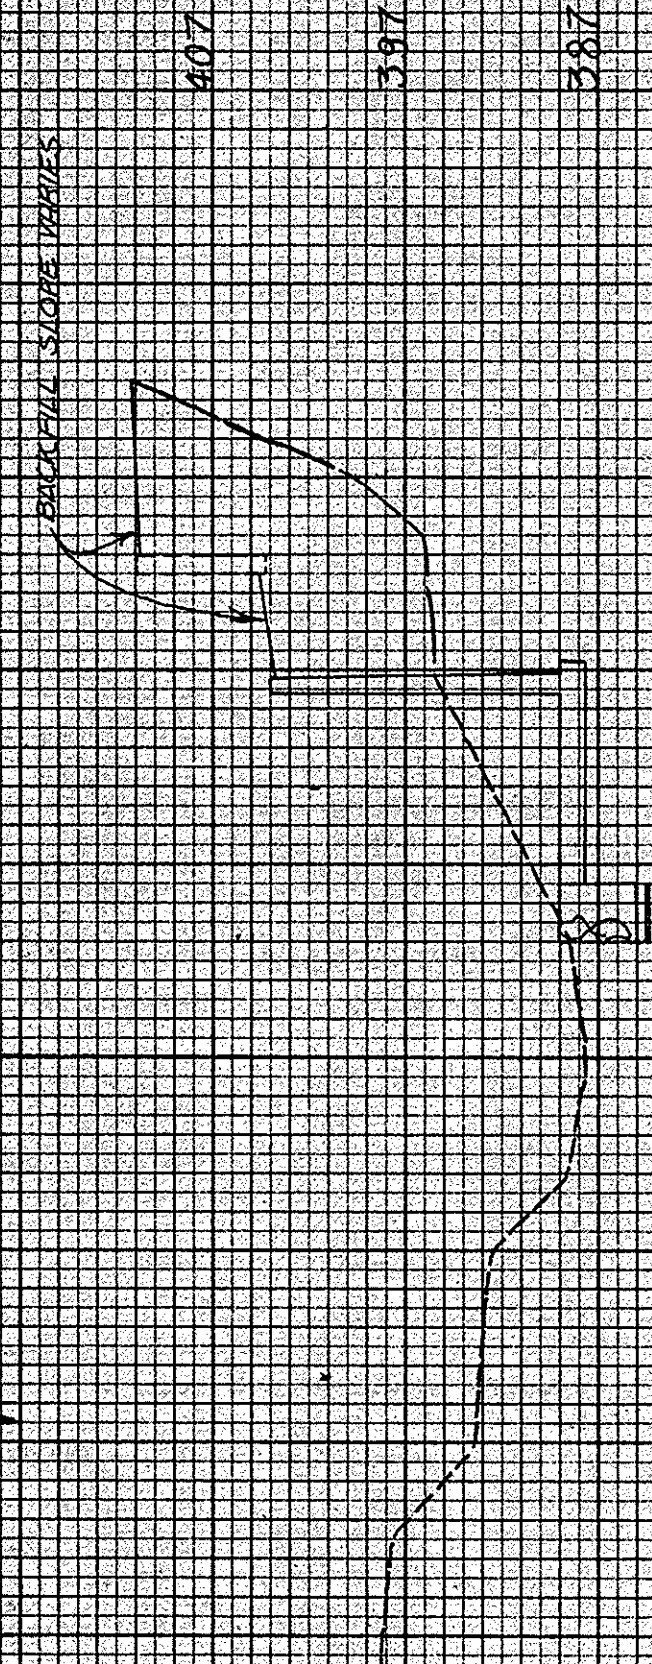


STA 10+50

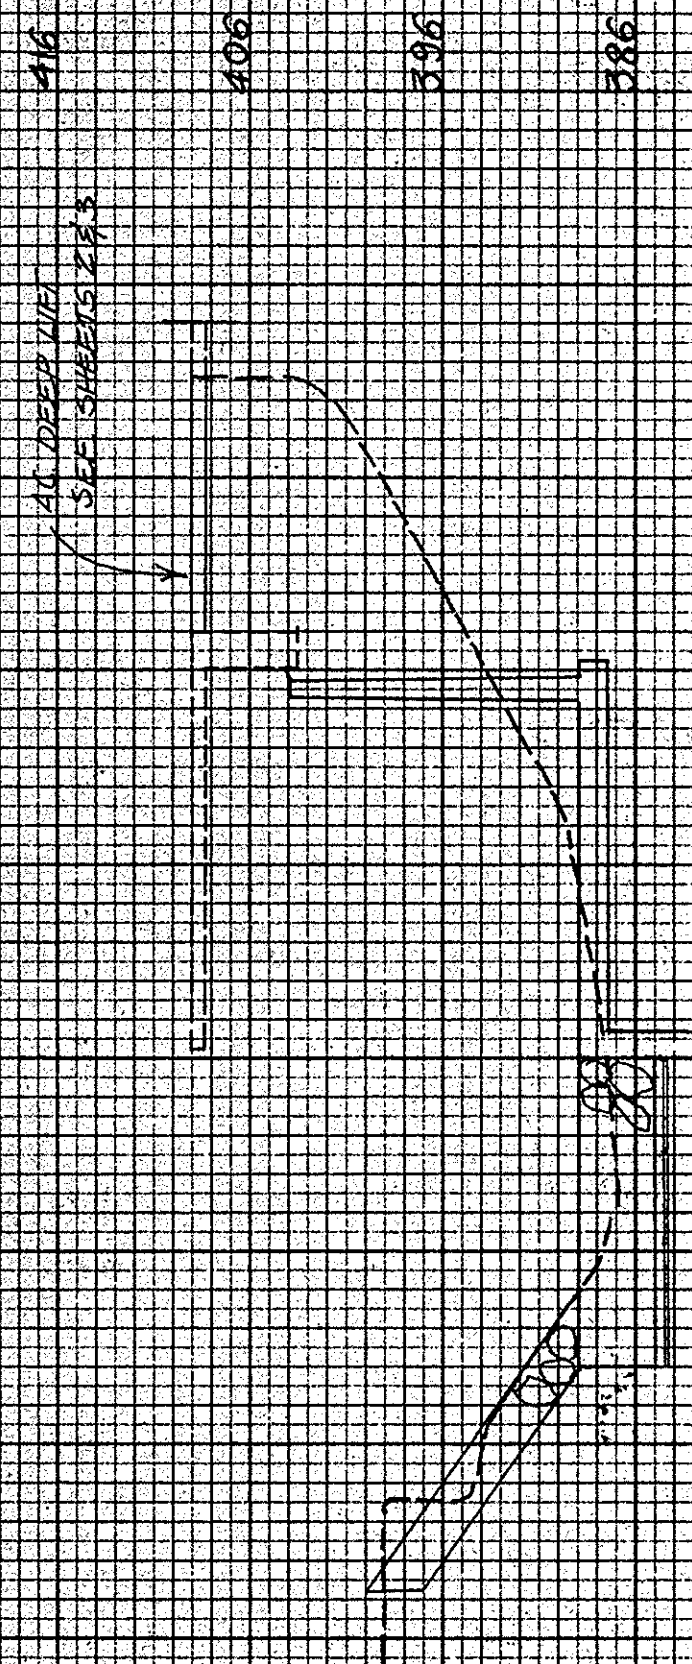

STA 10+25

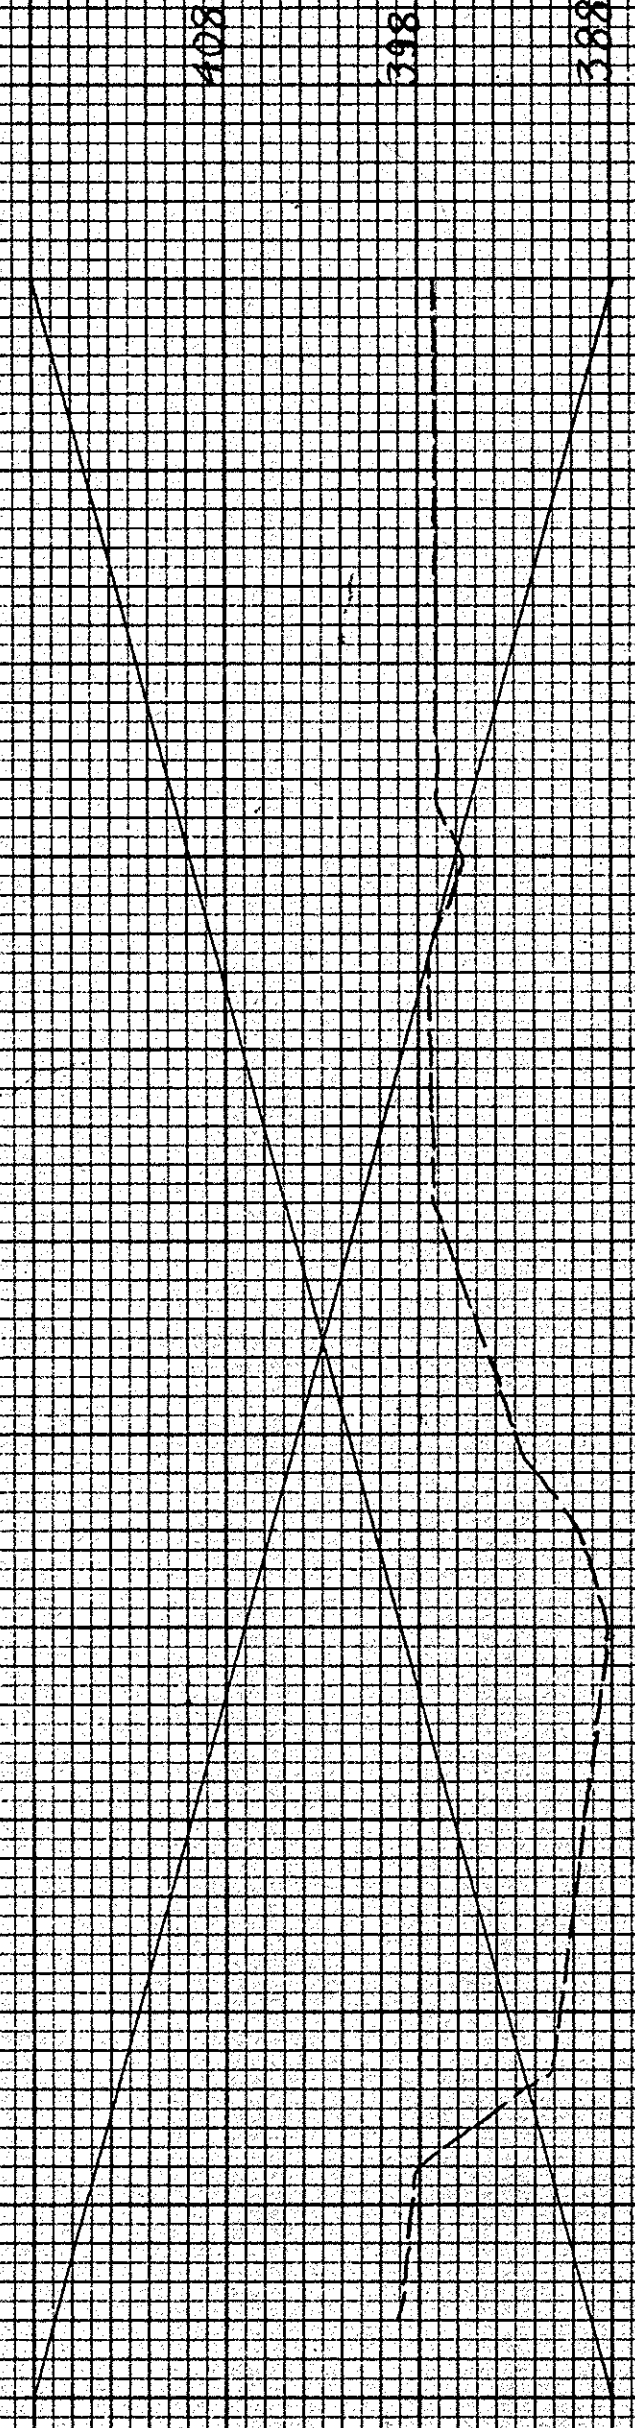

STA 11+54.59 SKewed 30°

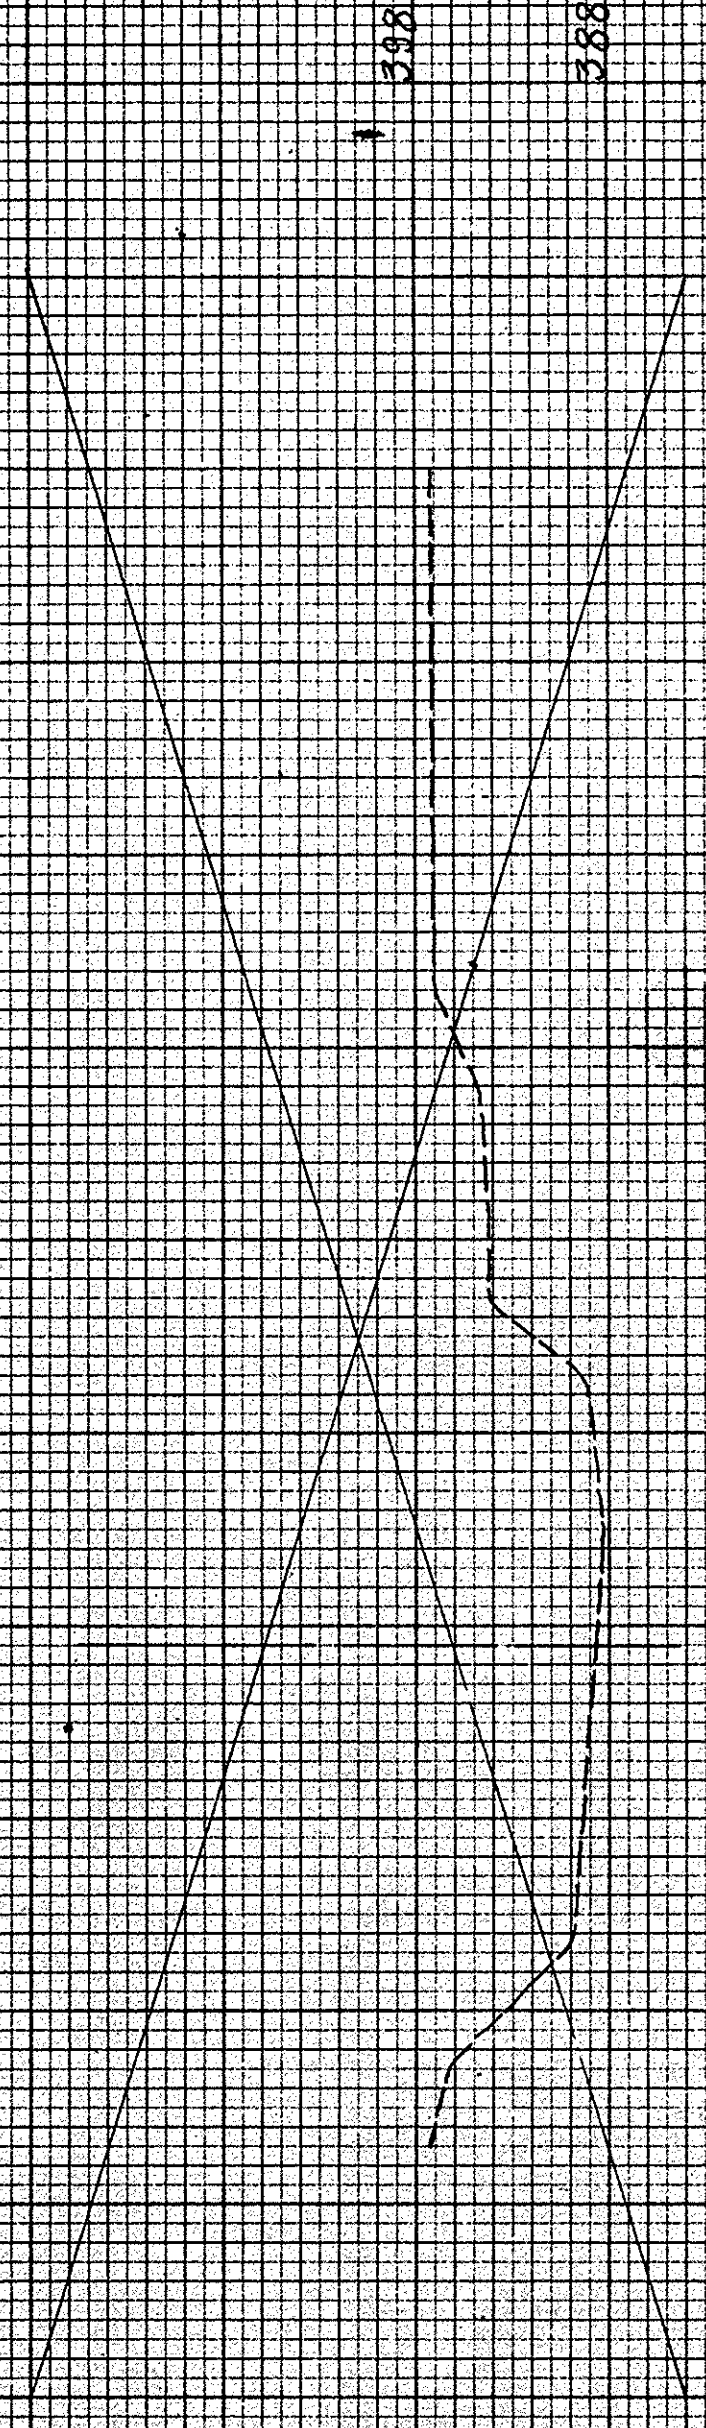

STA 11+05.72 SKewed 30°

SCALE:
HOR. 1"=80'
VER. 1"=10'

ORANGE COUNTY ENVIRONMENTAL MANAGEMENT AGENCY		PREPARED UNDER SUPERVISION OF	M.A.M.	SHEET
BREA BLVD. BRIDGE		SCALE	DATE	DWG. NO.
BR. 55-37.		AS SHOWN	4-80	9(13123)
CHANNEL CROSS SECTIONS.		DESIGNED	DATE	DWG. NO.
		M.A.	4-80	9(13123)
		DRAWN	H.S.H. (checked)	7