


5

BREA CANON ROAD

Approved *P. H. J. J. J.*
Chief Engineer


T. 3 S. R. 10 W.

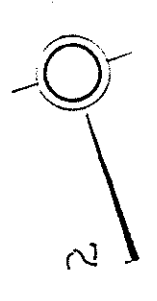

S. E. C. 2


SCALES
HORIZONTAL VERT. INCHES

1/4" = 100'
1/8" = 200'
1/16" = 400'
1/32" = 800'

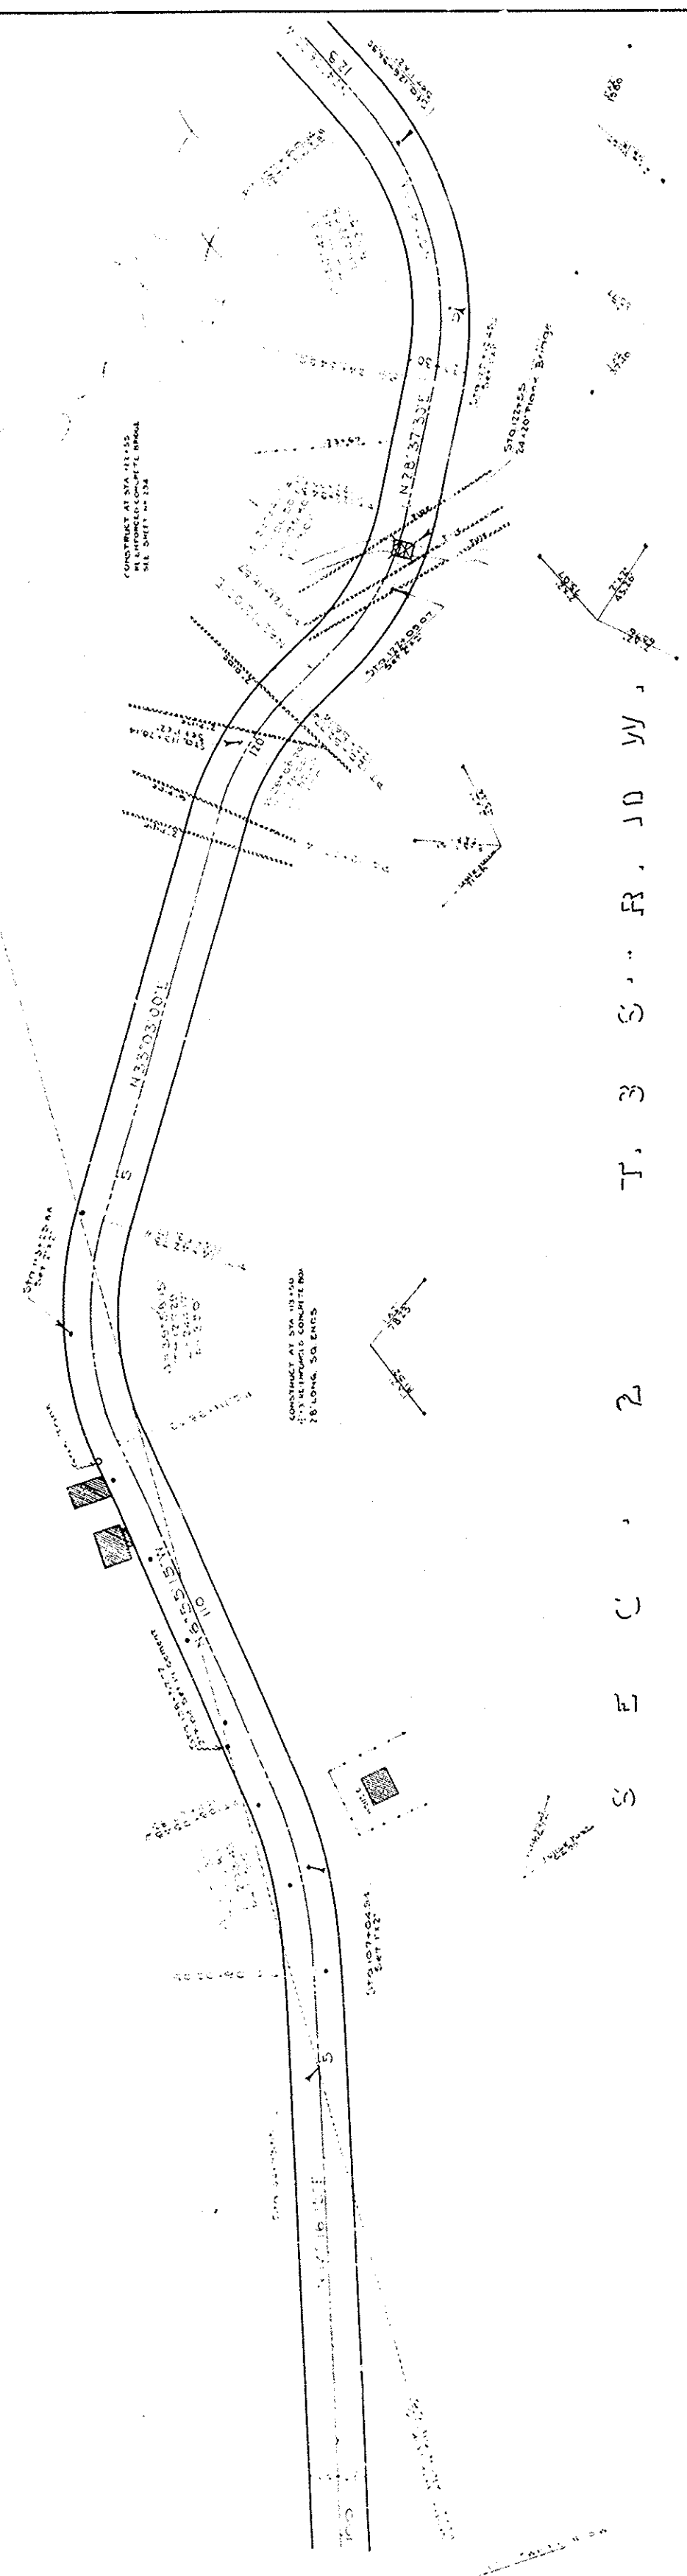

T. 3 S. R. 10 W.

S. E. C. 2

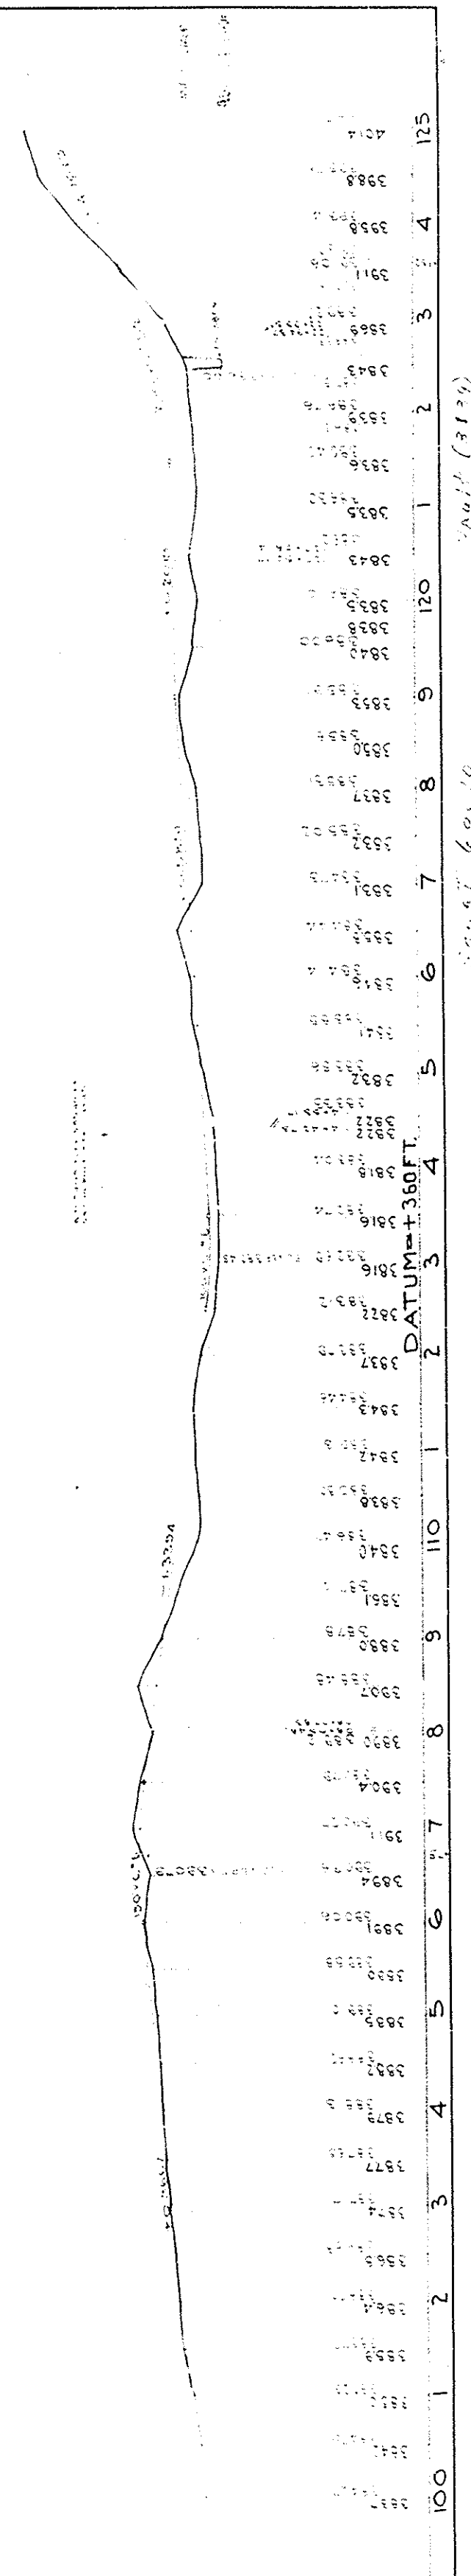

125

120

115

-5

-10

-100