

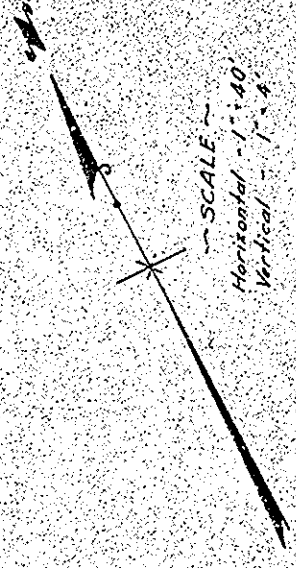


14 15 16 17 18 19 20 21 22 23 24 25 26 27 28 29 30 31 32 33 34 35 36 37 38 39 40 41 42 43 44 45 46 47 48 49

BREA CAÑON ROAD
ORANGE COUNTY CALIFORNIA
SHEET 3 OF 3 SHEETS

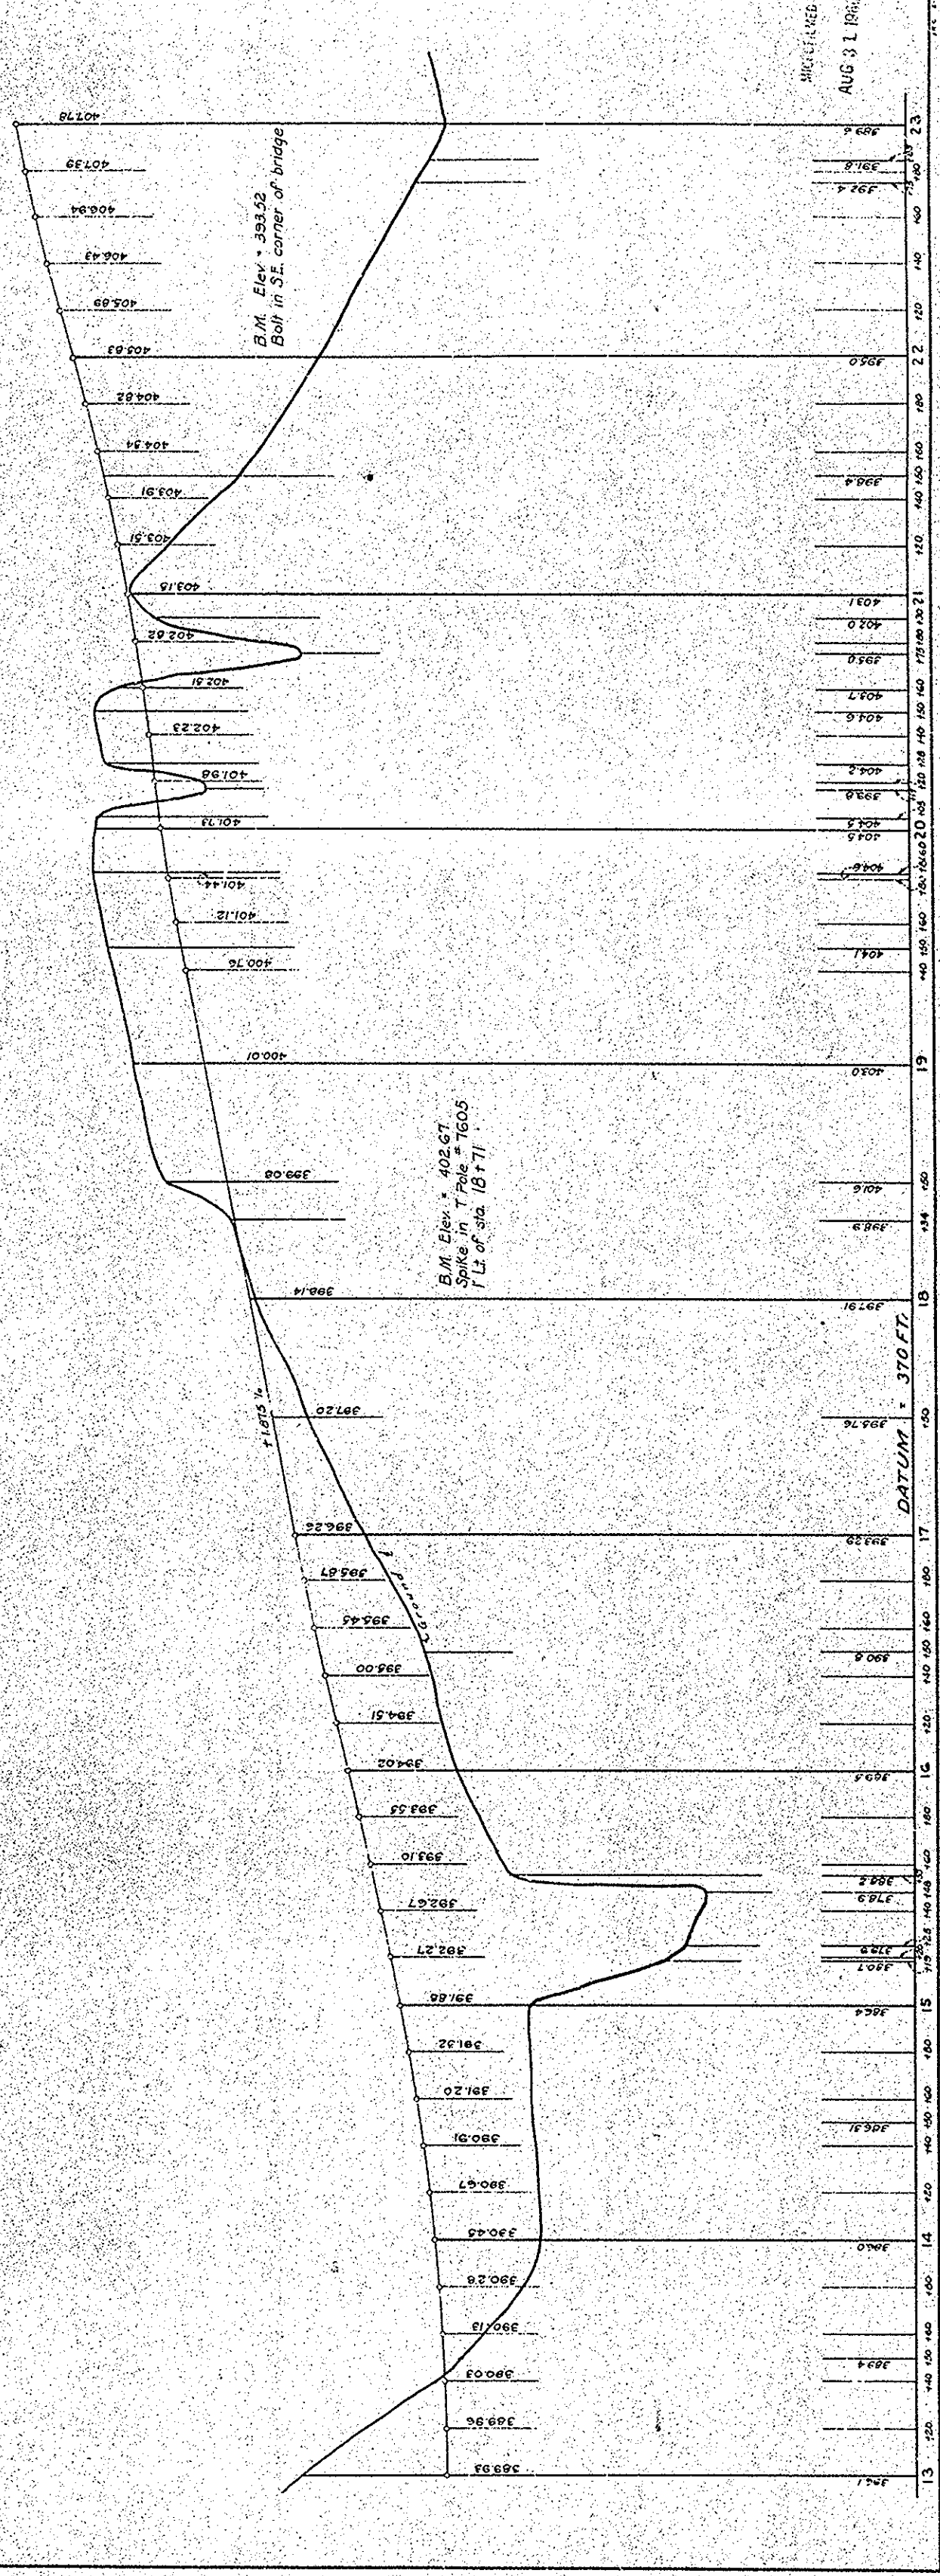

SCALE -
Horizontal - 1" = 40'
Vertical - 1" = 4'

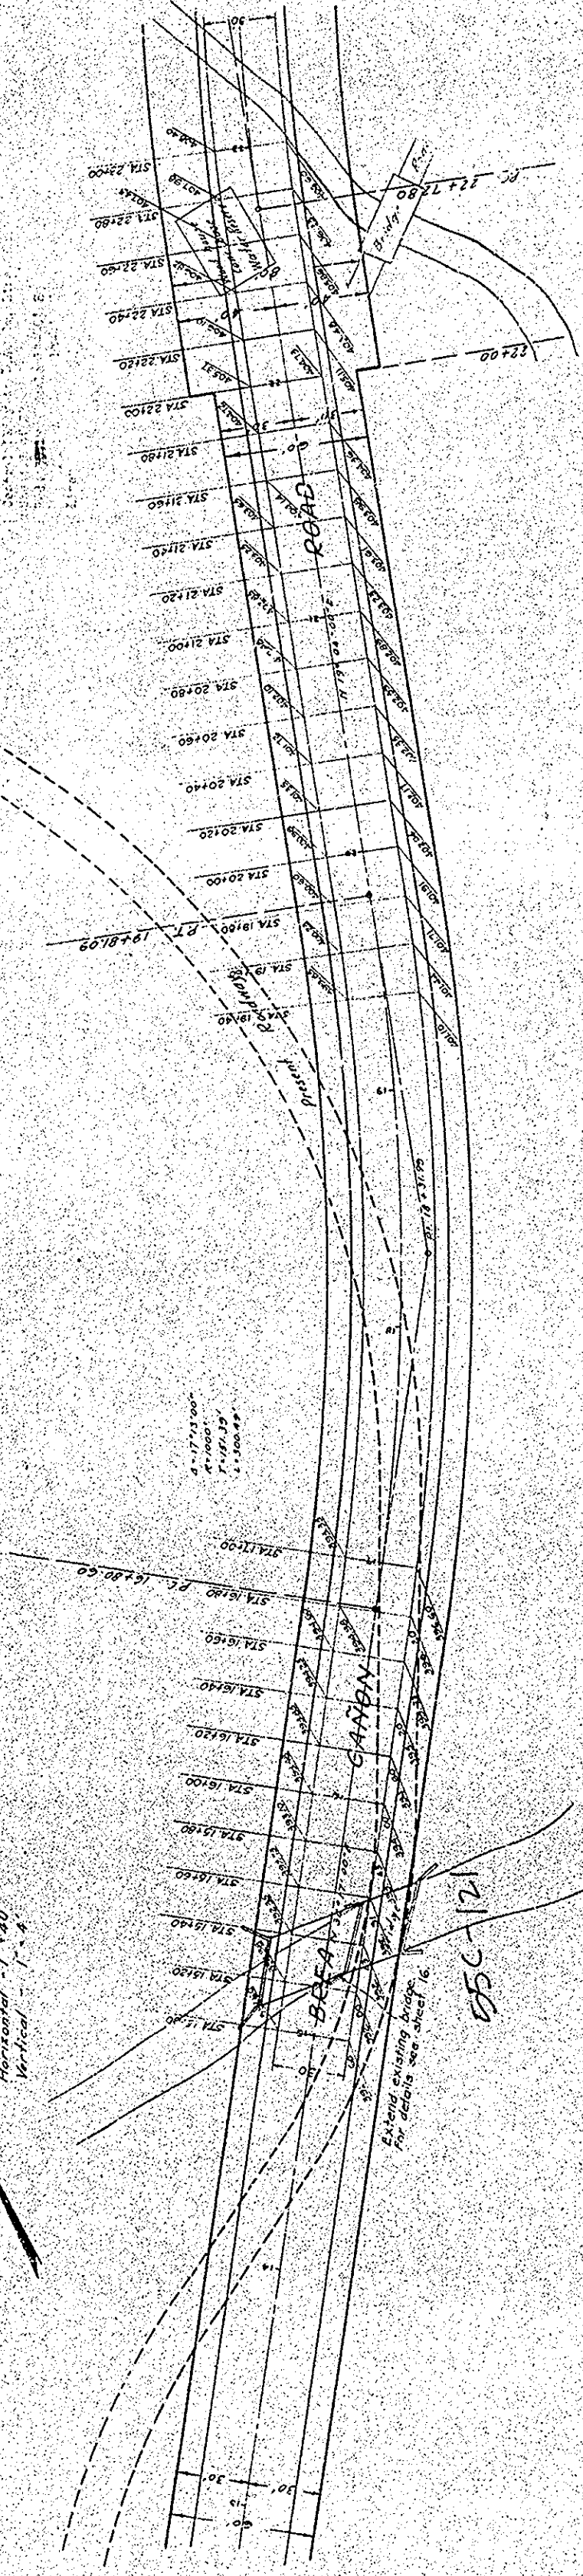

SHEET 3 OF 3

1441 (3870)

APPROVED
AUG 31 1964