


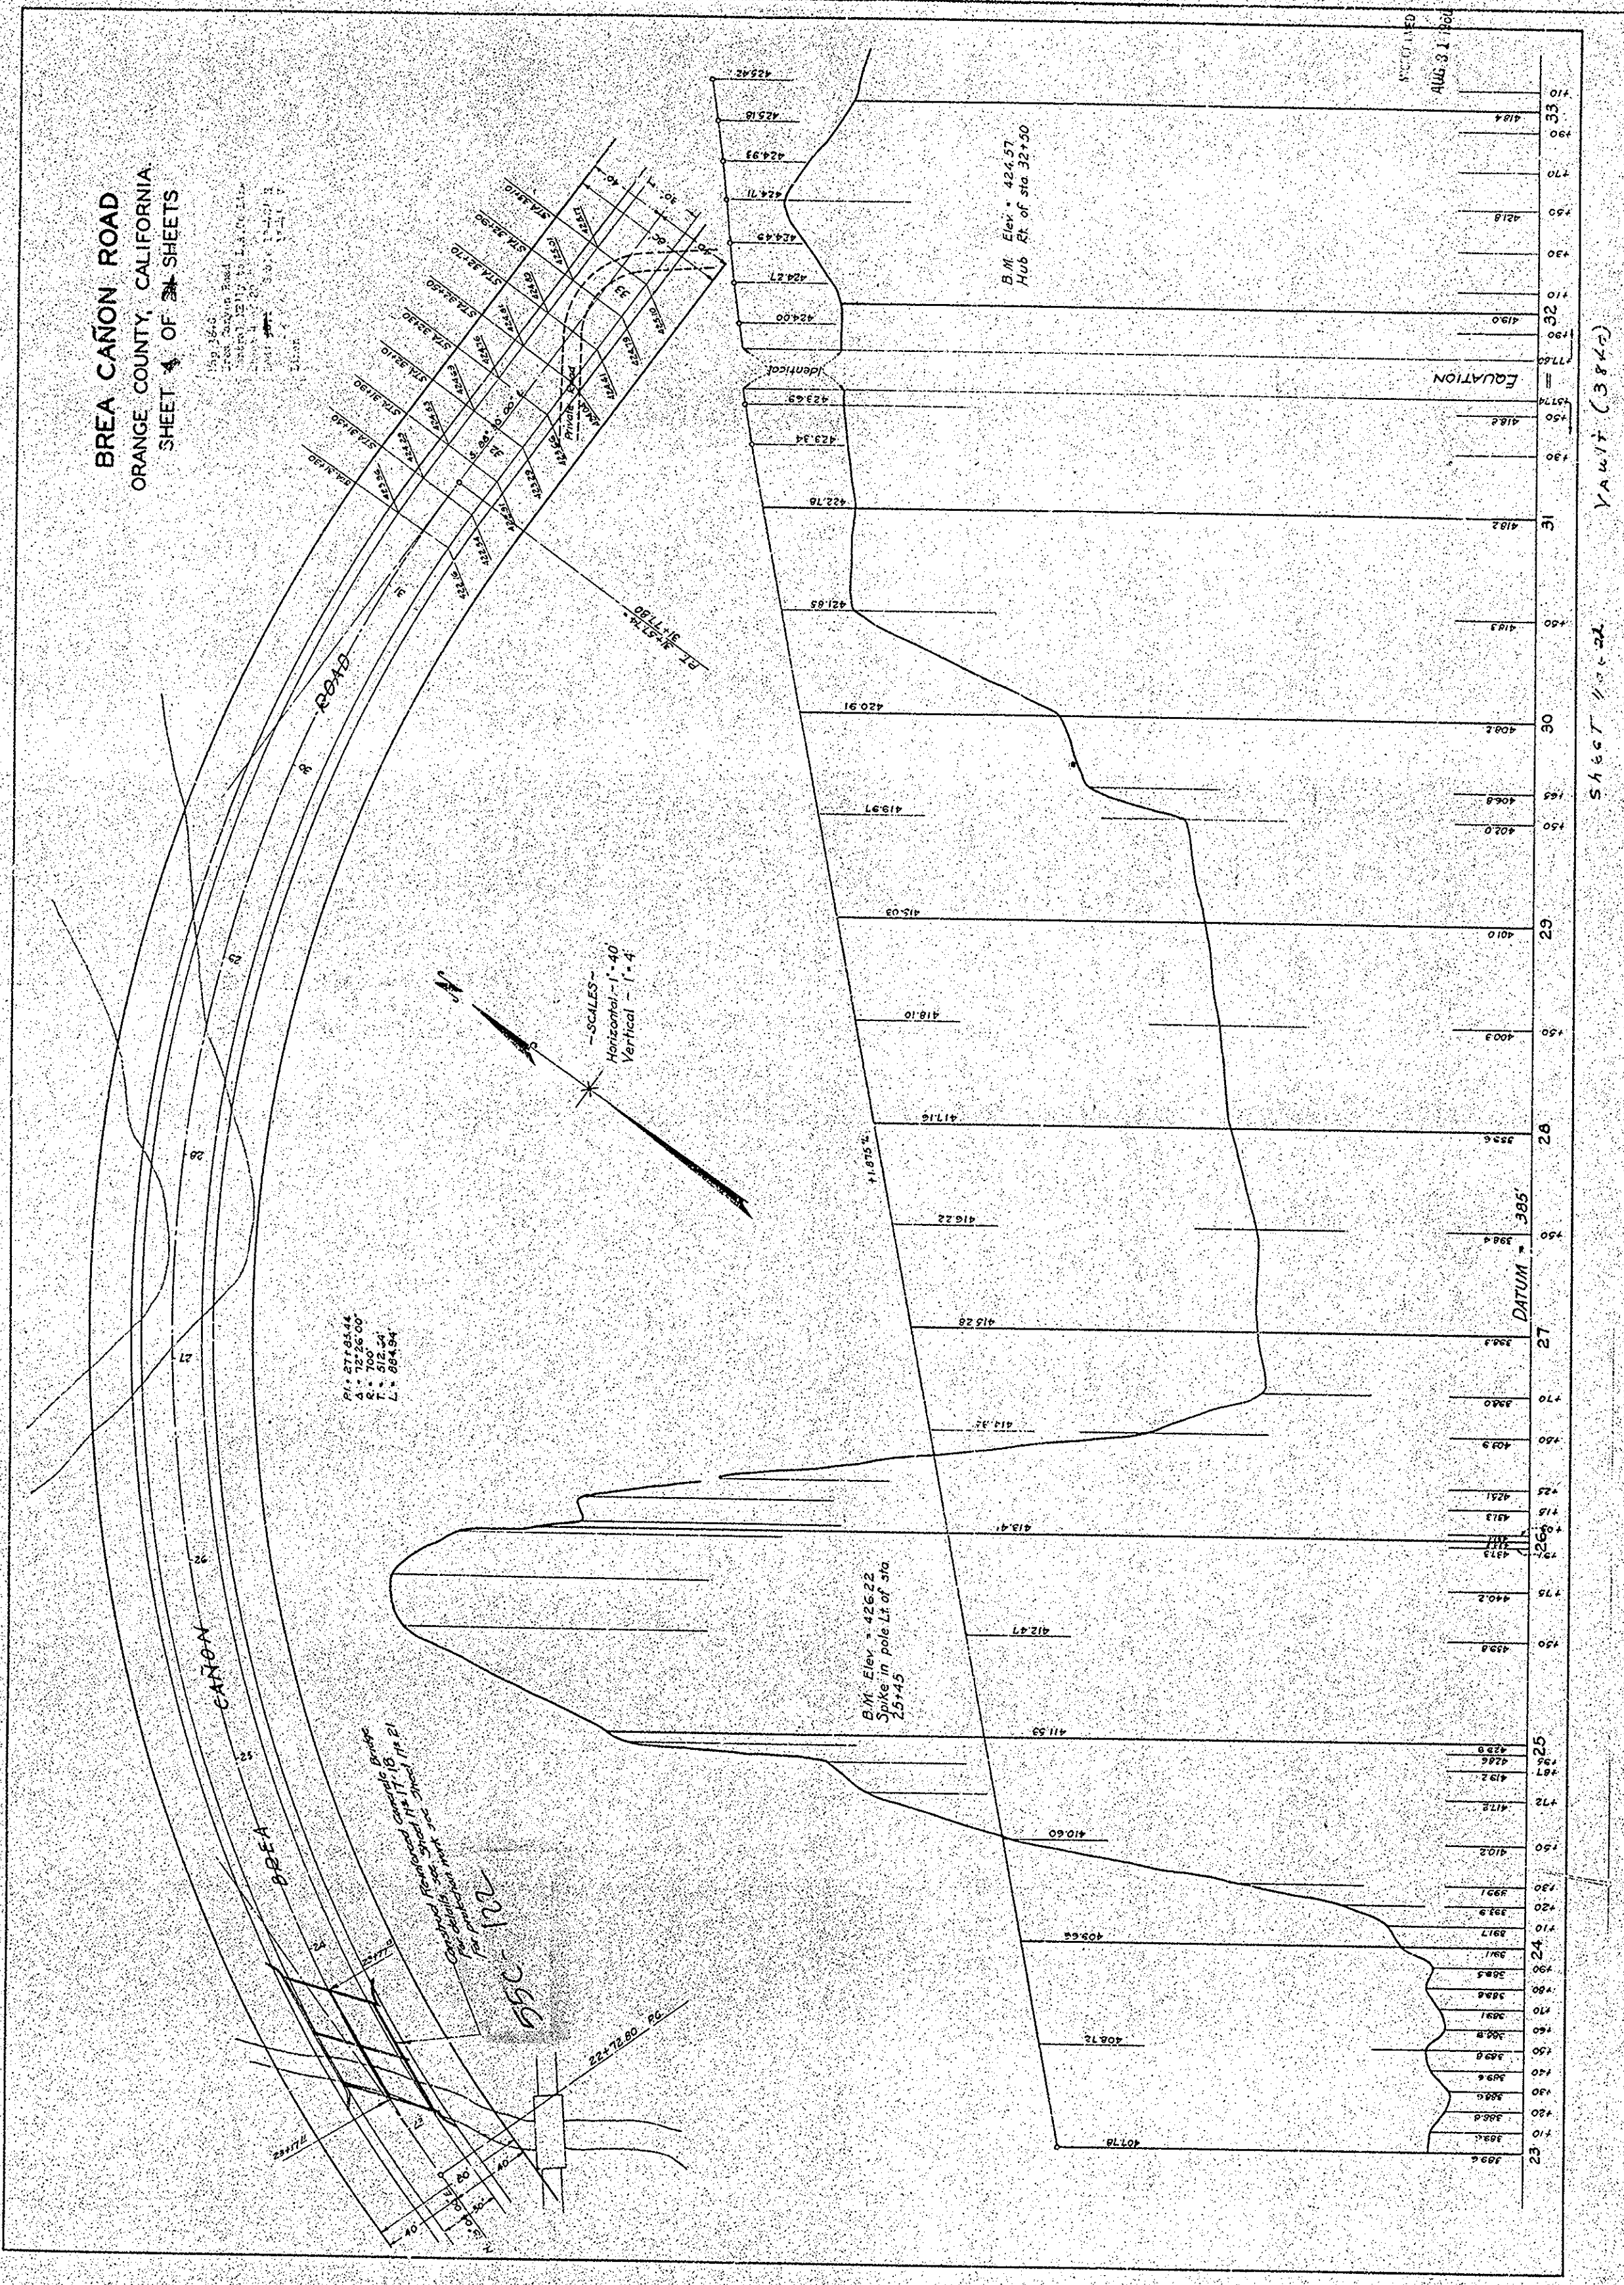

SHEET 4 OF 34

YAWIT (3842)