
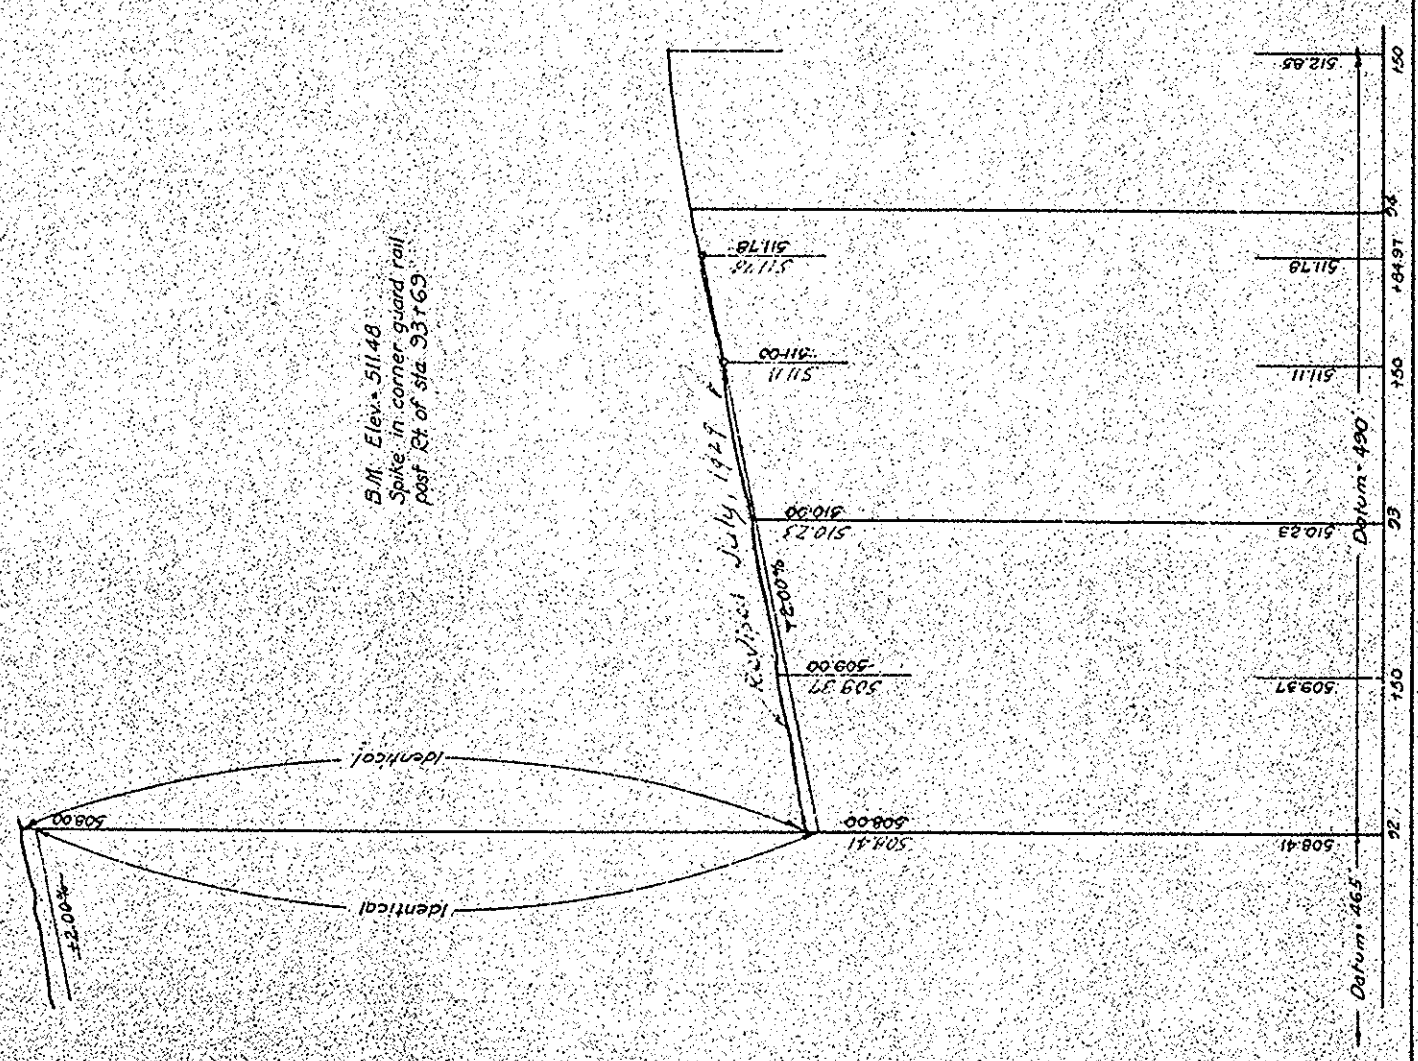
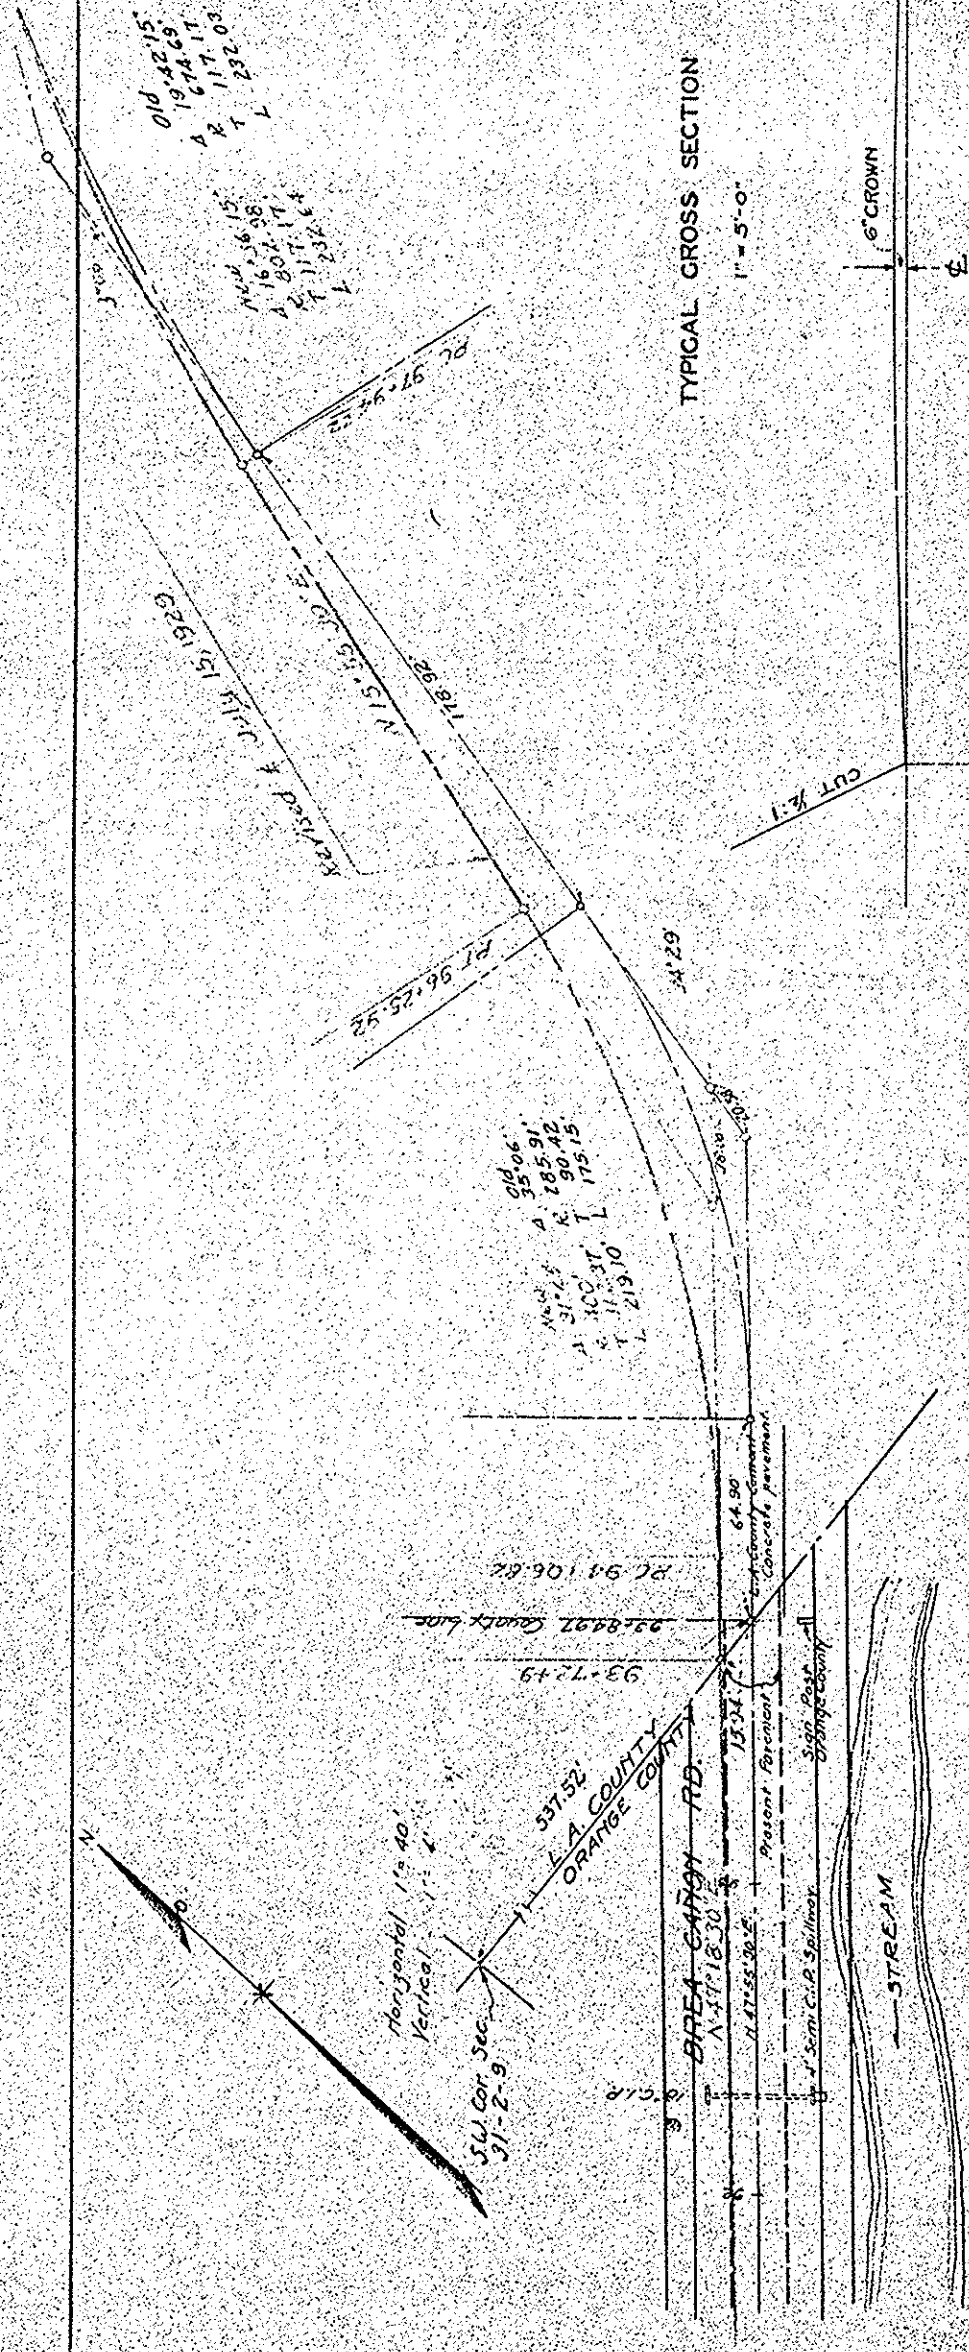


BREA CAÑON ROAD
ORANGE COUNTY - CALIFORNIA
SHEET # OF 34 SHEETS

Drawn by: J. L. Smith
Checked by: J. L. Smith
Scale: 1" = 40' H
Date: 11-1-58
Sheet 11 of 34

TYPICAL CROSS SECTION
1" = 5'-0"

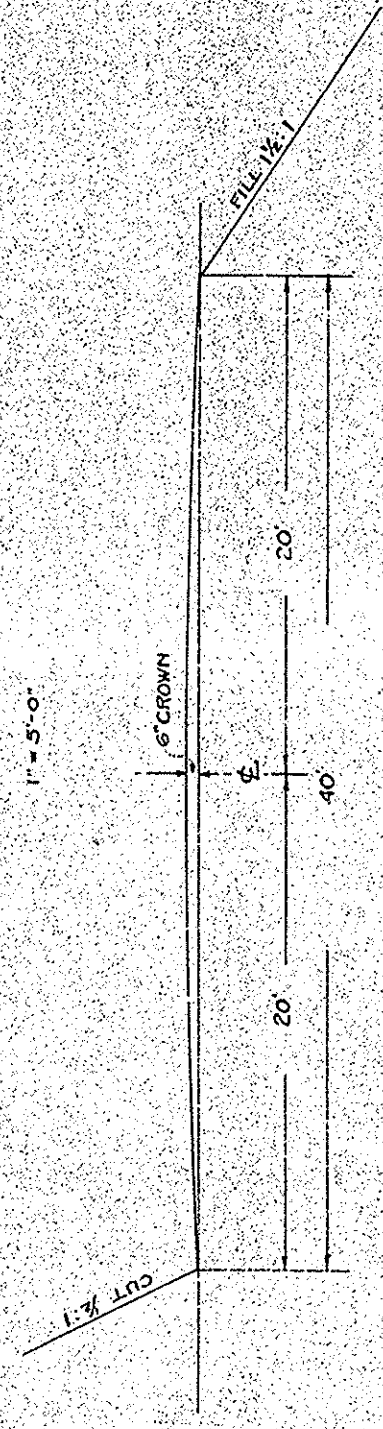

Sheet 11 of 34
Vault (3 x 10)