


BREA CANYON ROAD
SHEET 13 OF 46 SHEETS

DATE: 10/1/80
DRAWN BY: J. L. HARRIS
CHECKED BY: J. L. HARRIS
SHEET NO. 13 OF 46
PROJECT NO. 100-100-100
TITLE: BRIDGE

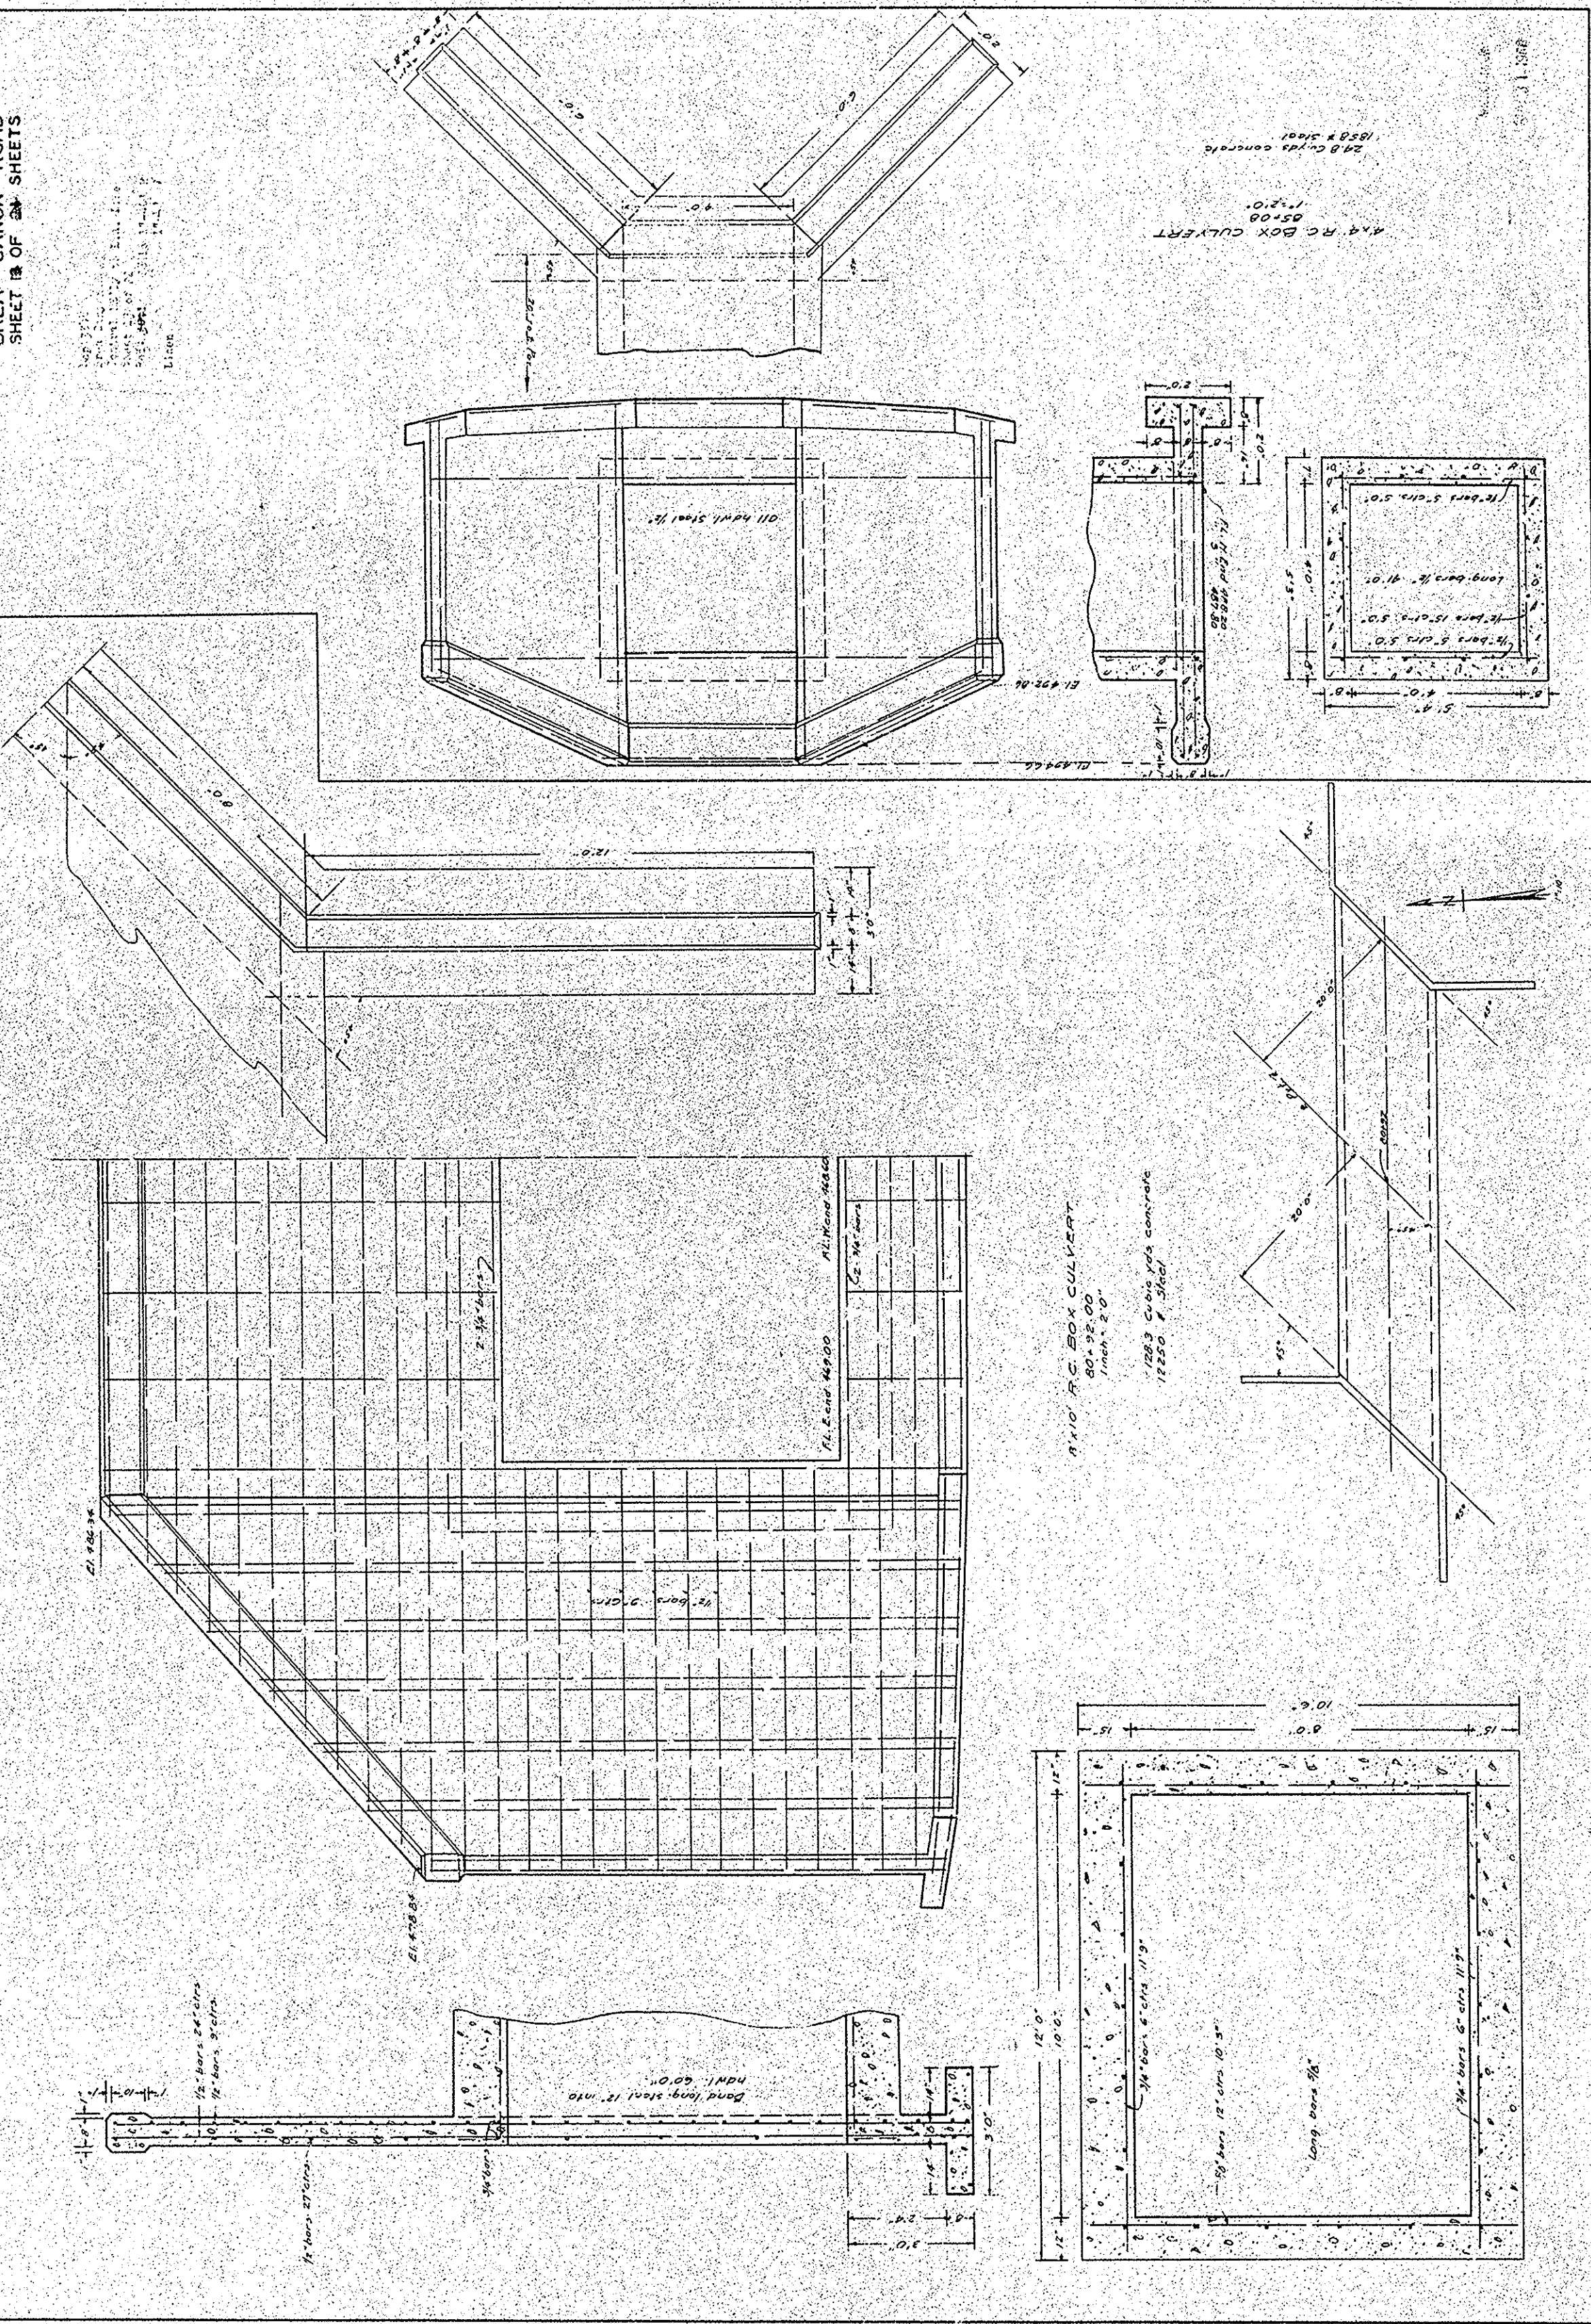

SHEET 13 OF 46 SHEETS