
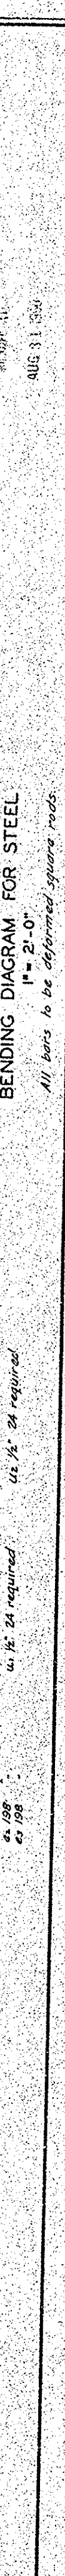
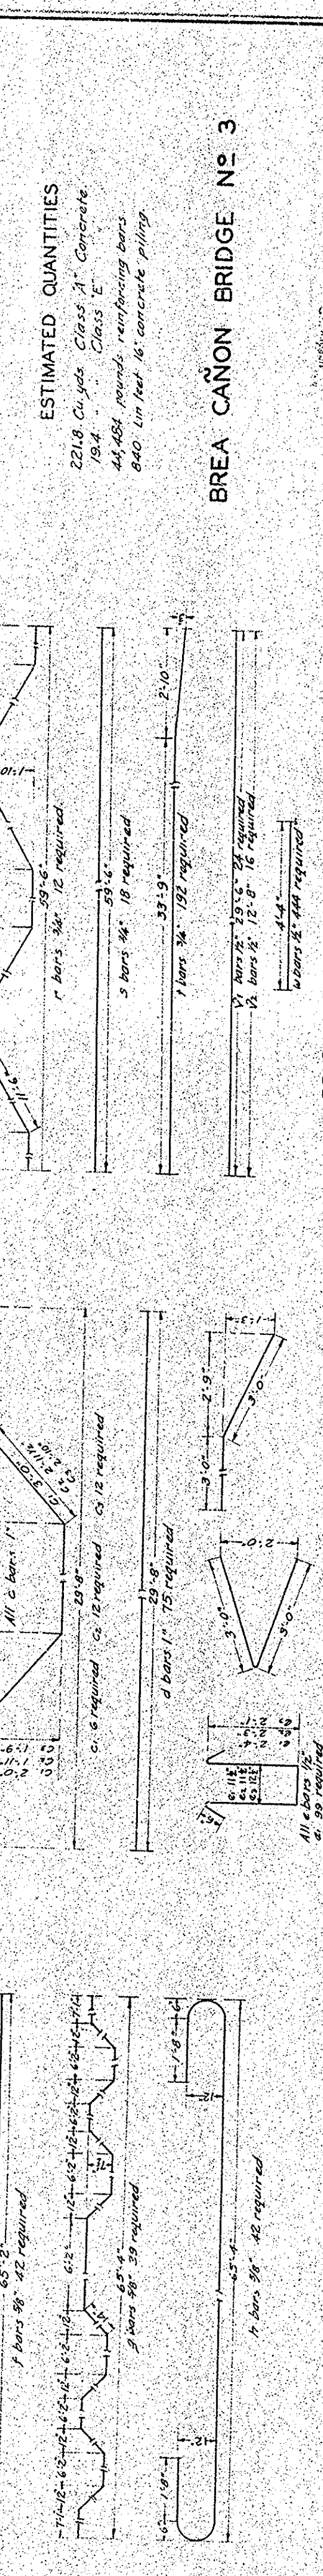
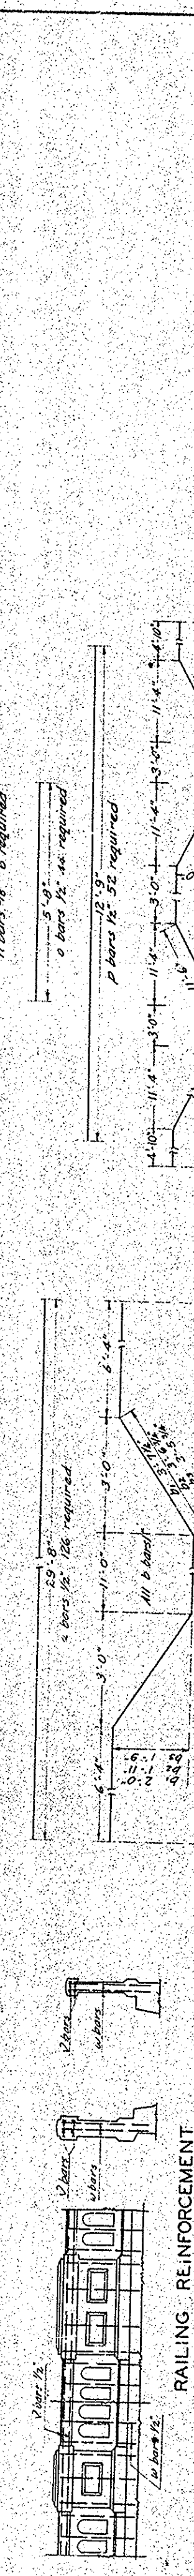
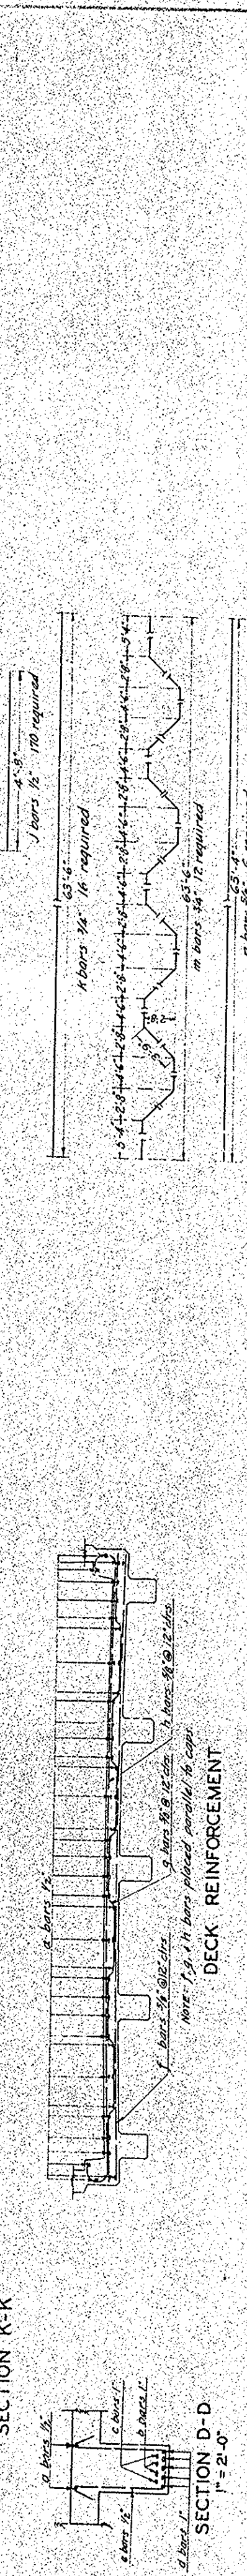


BREA CAÑON ROAD
ORANGE COUNTY CALIFORNIA
SHEET 28 OF 34 SHEETS
SCALE 1"=4'-0"

Approved _____
 June 15, 1964
 Supv. of Highways

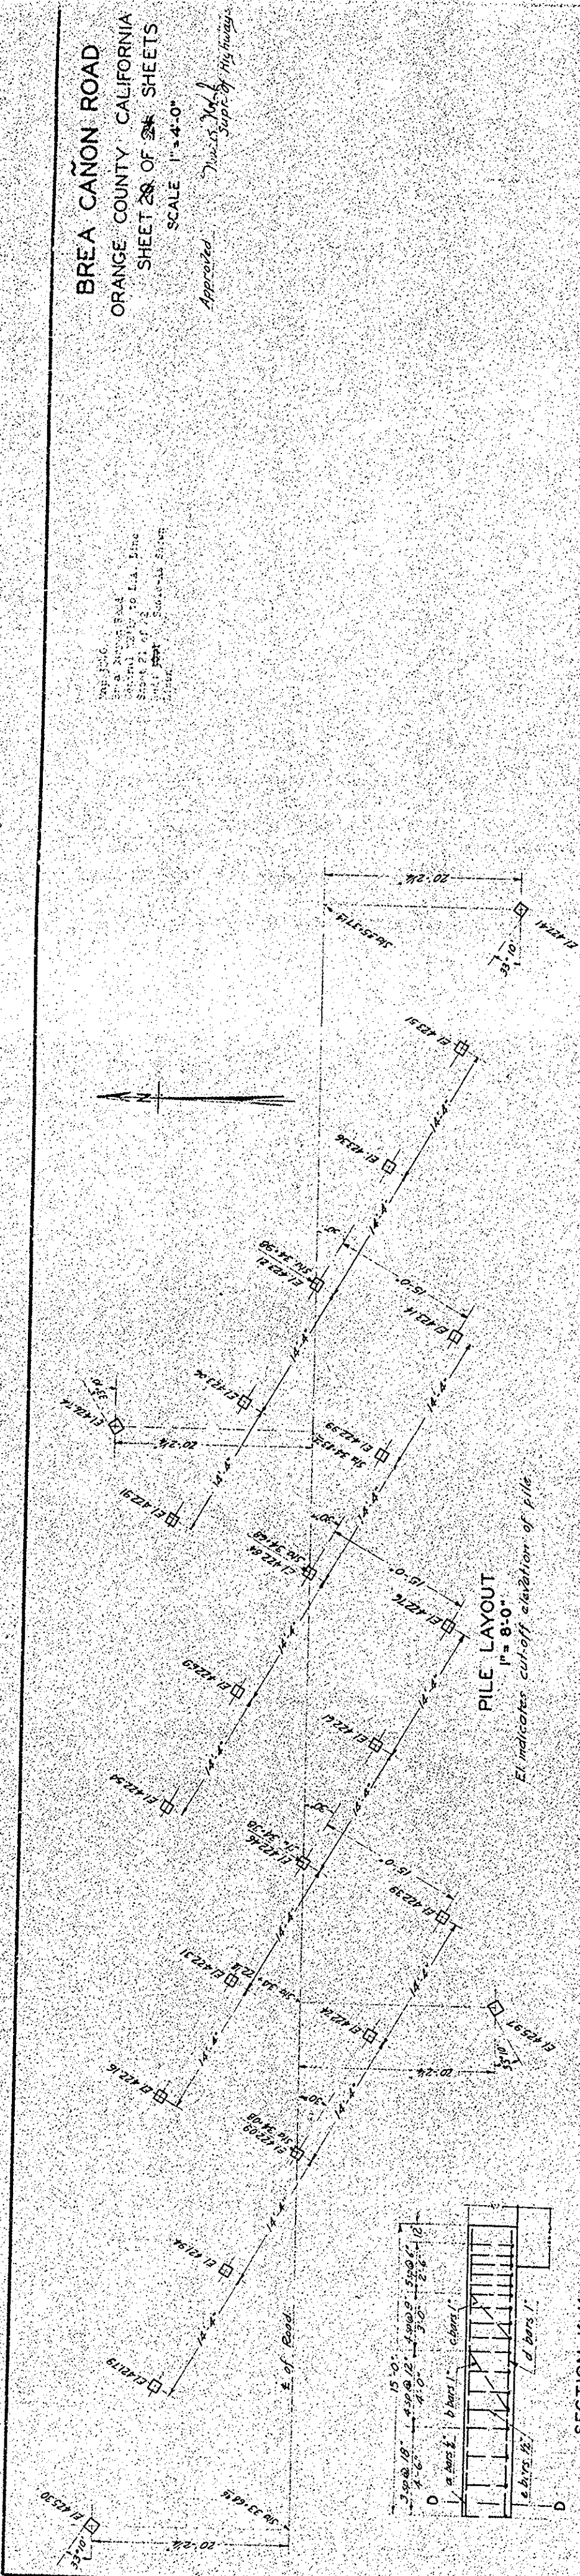

54801 210422 Vault (34001)