
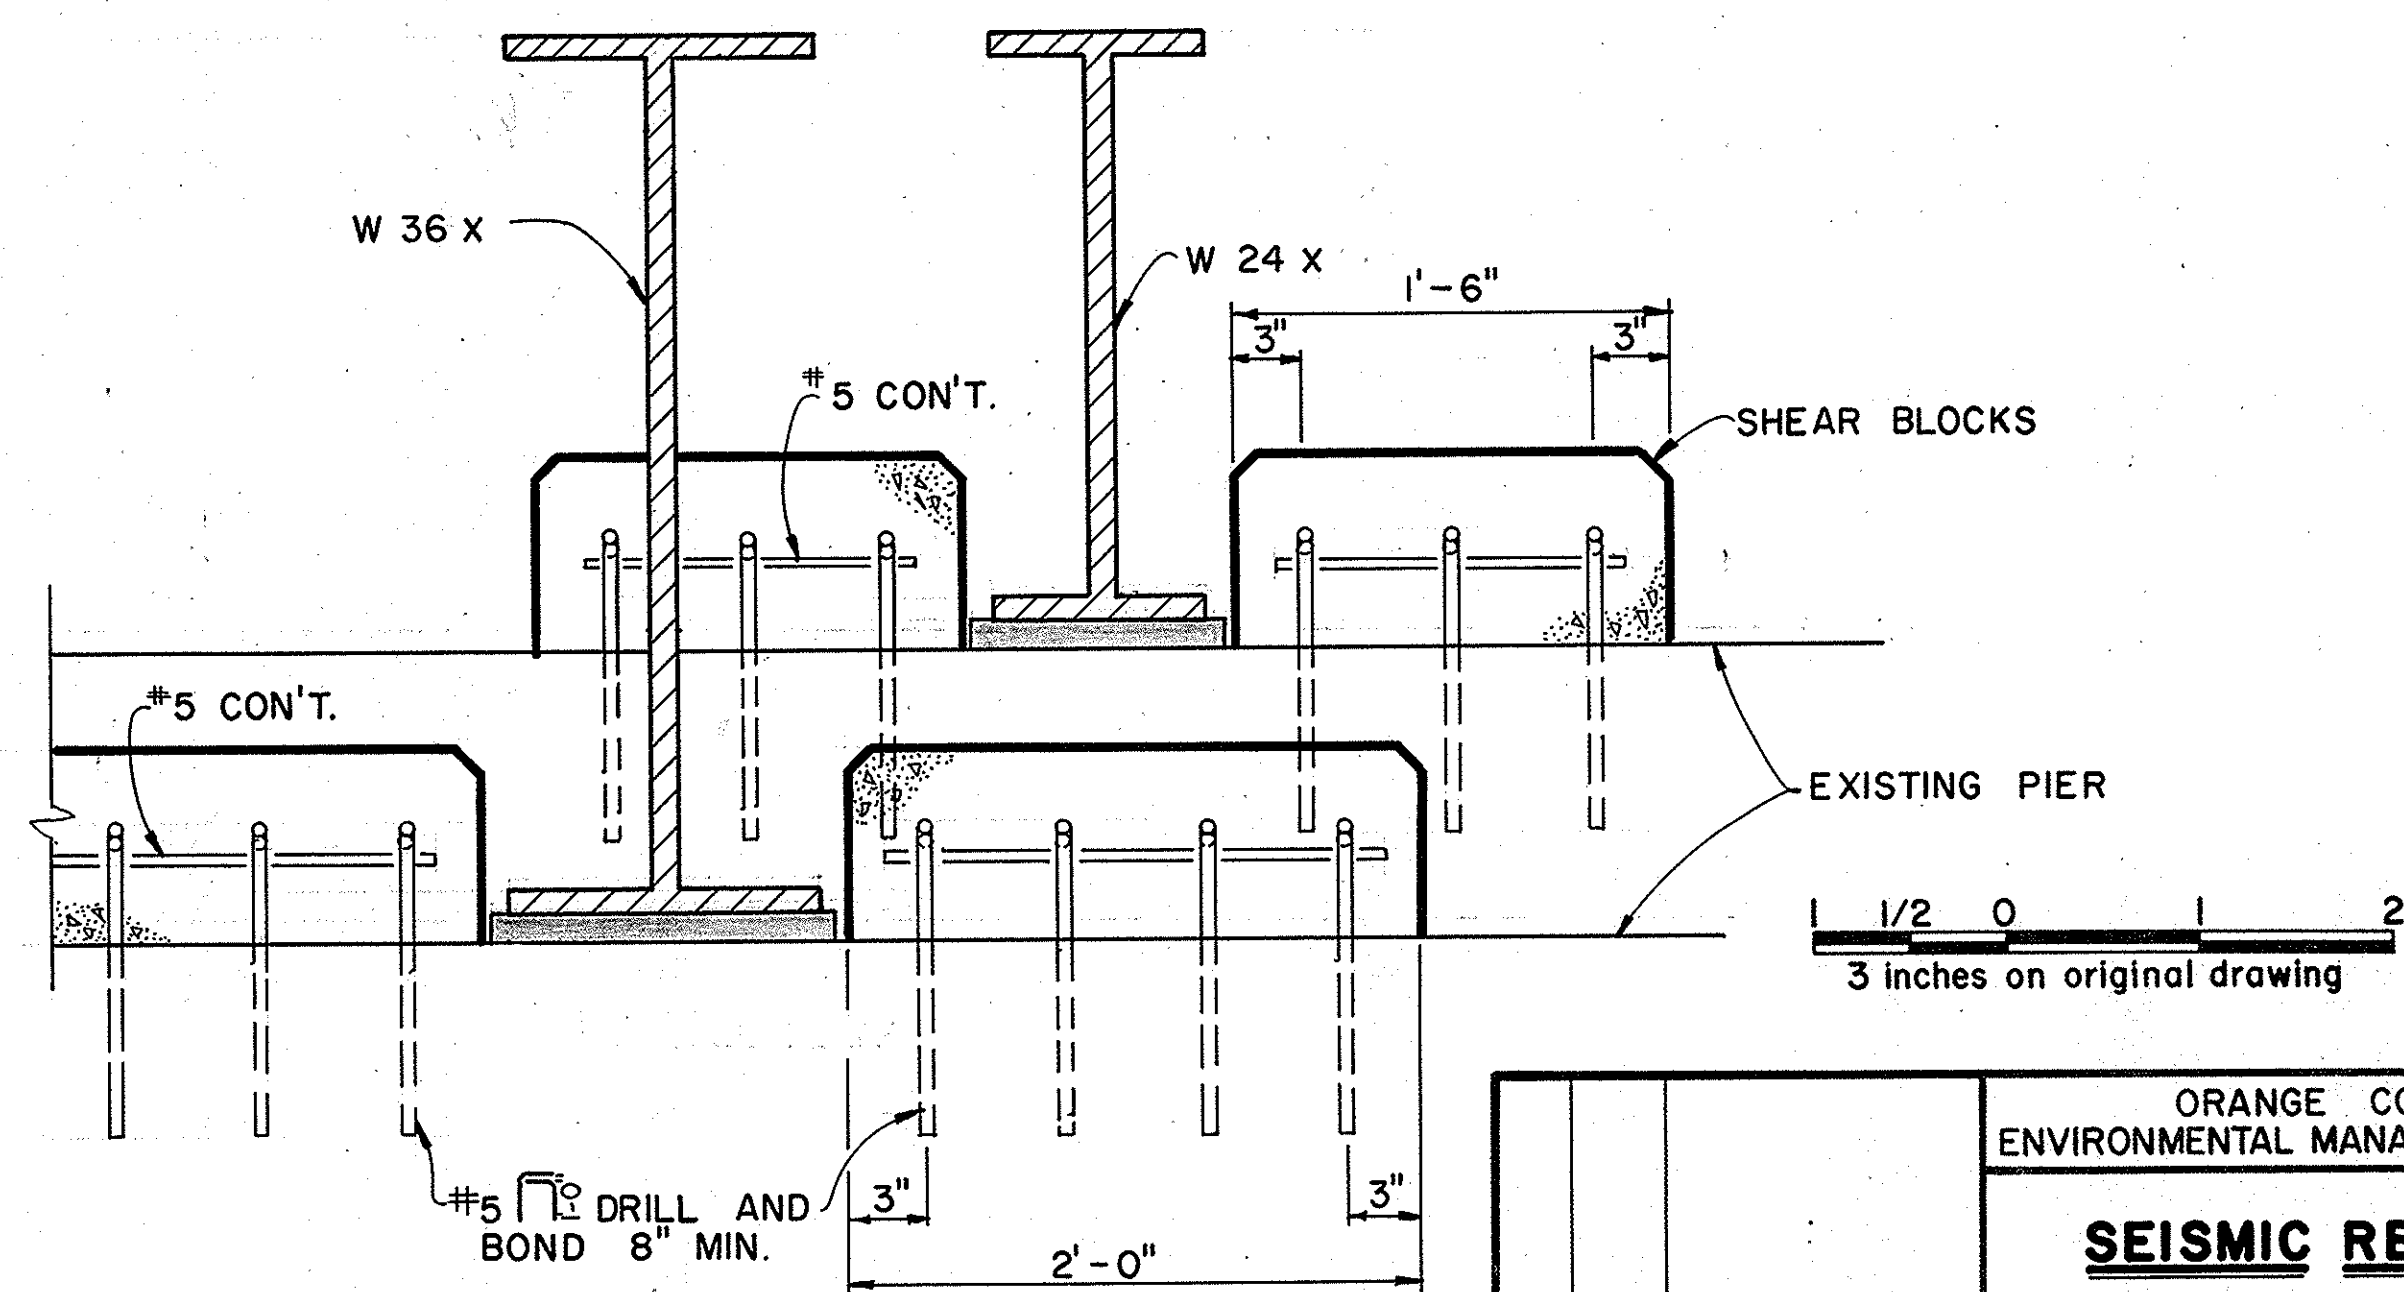
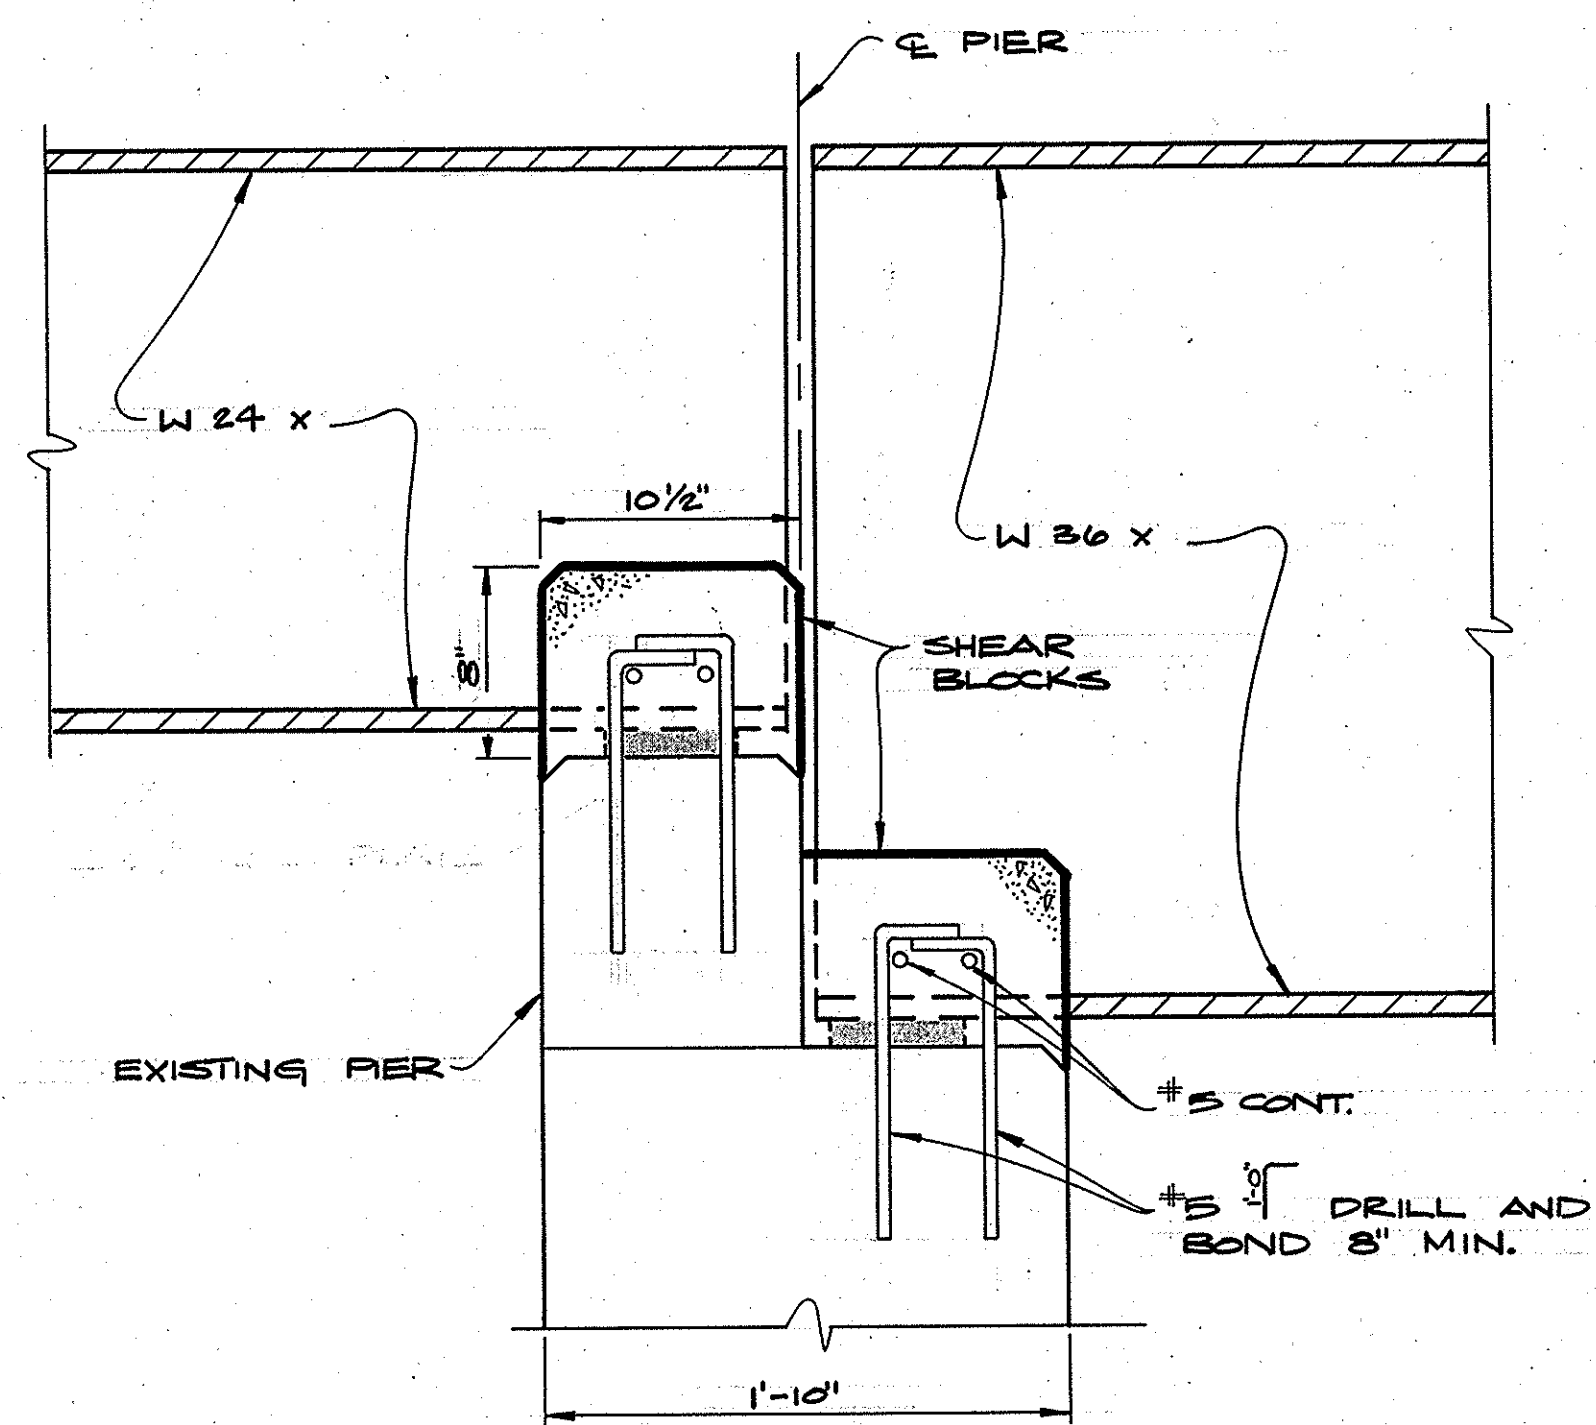
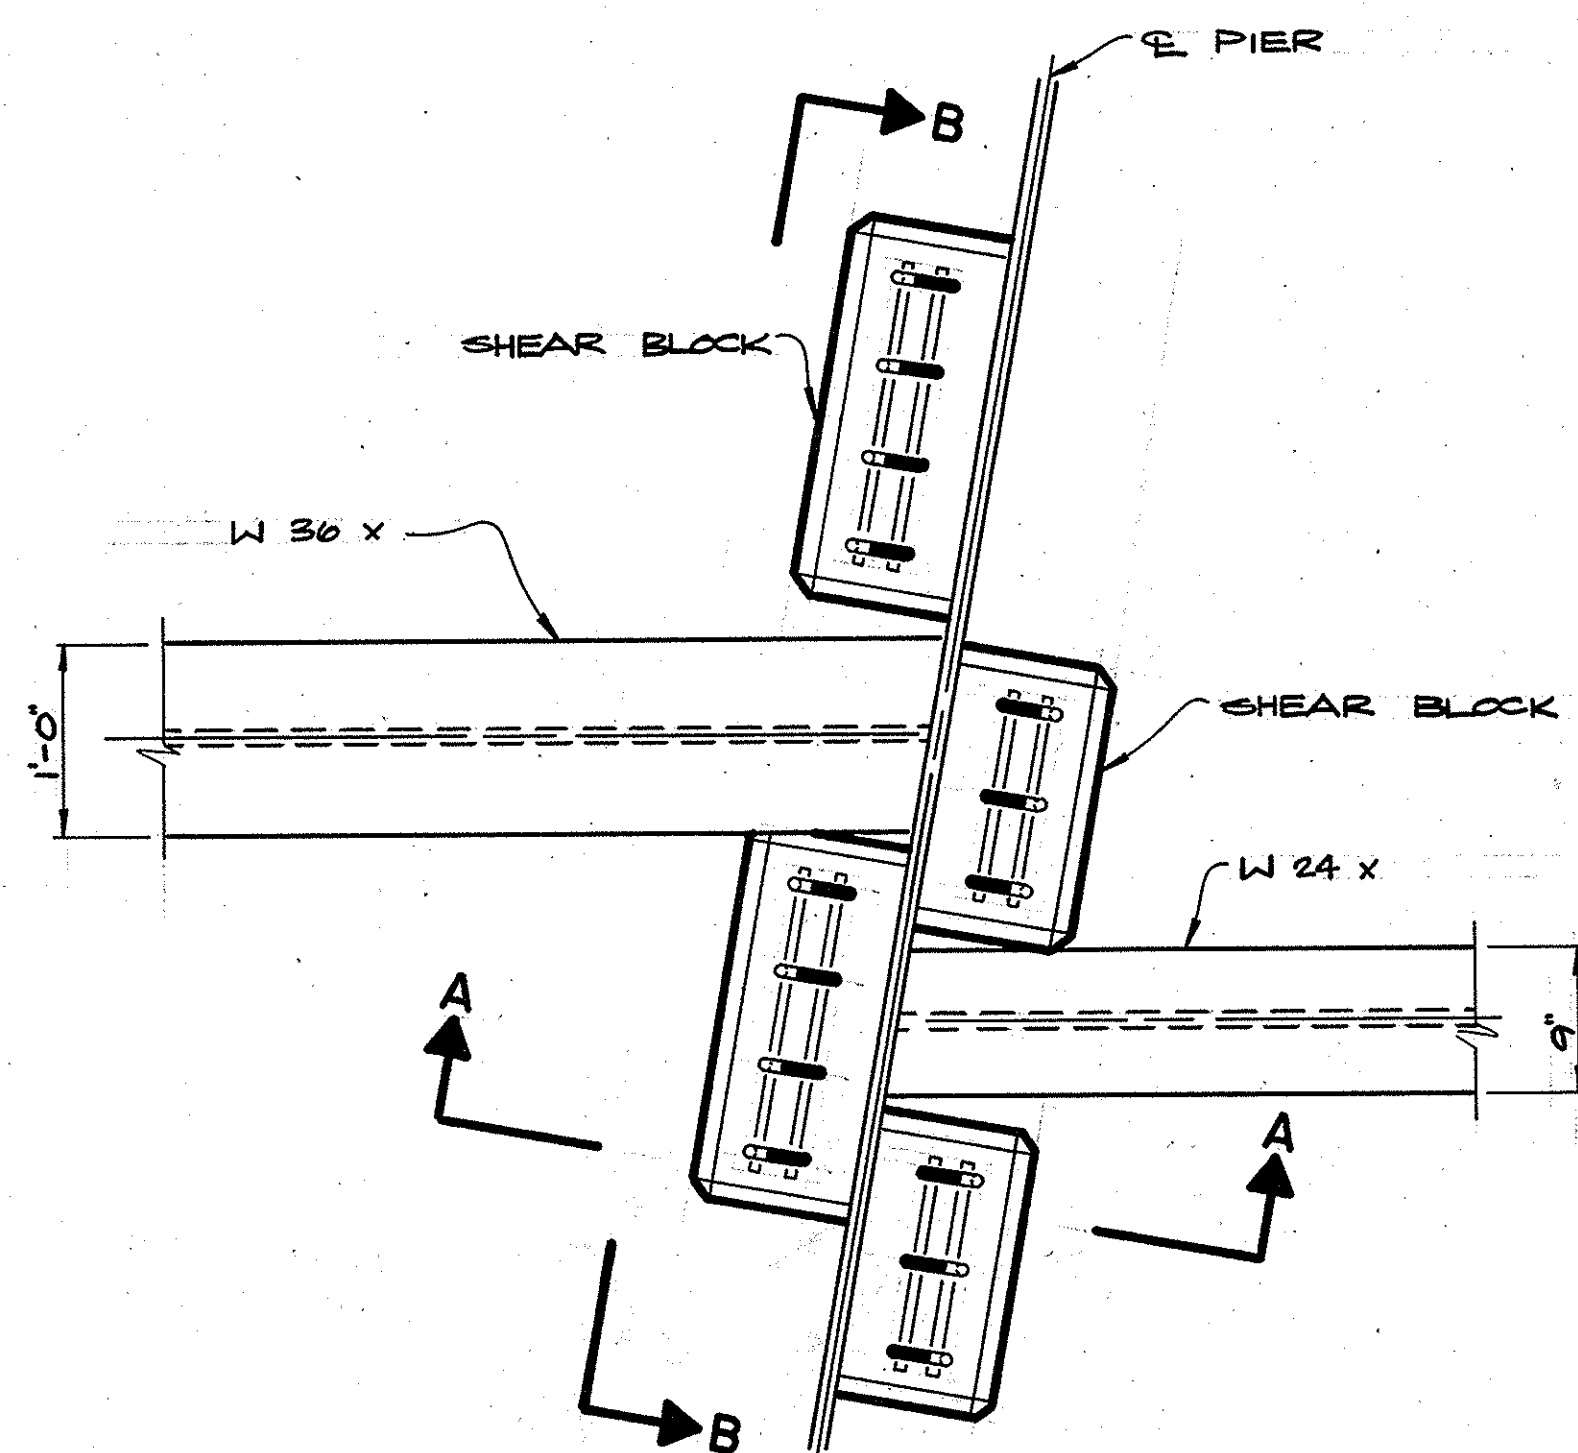
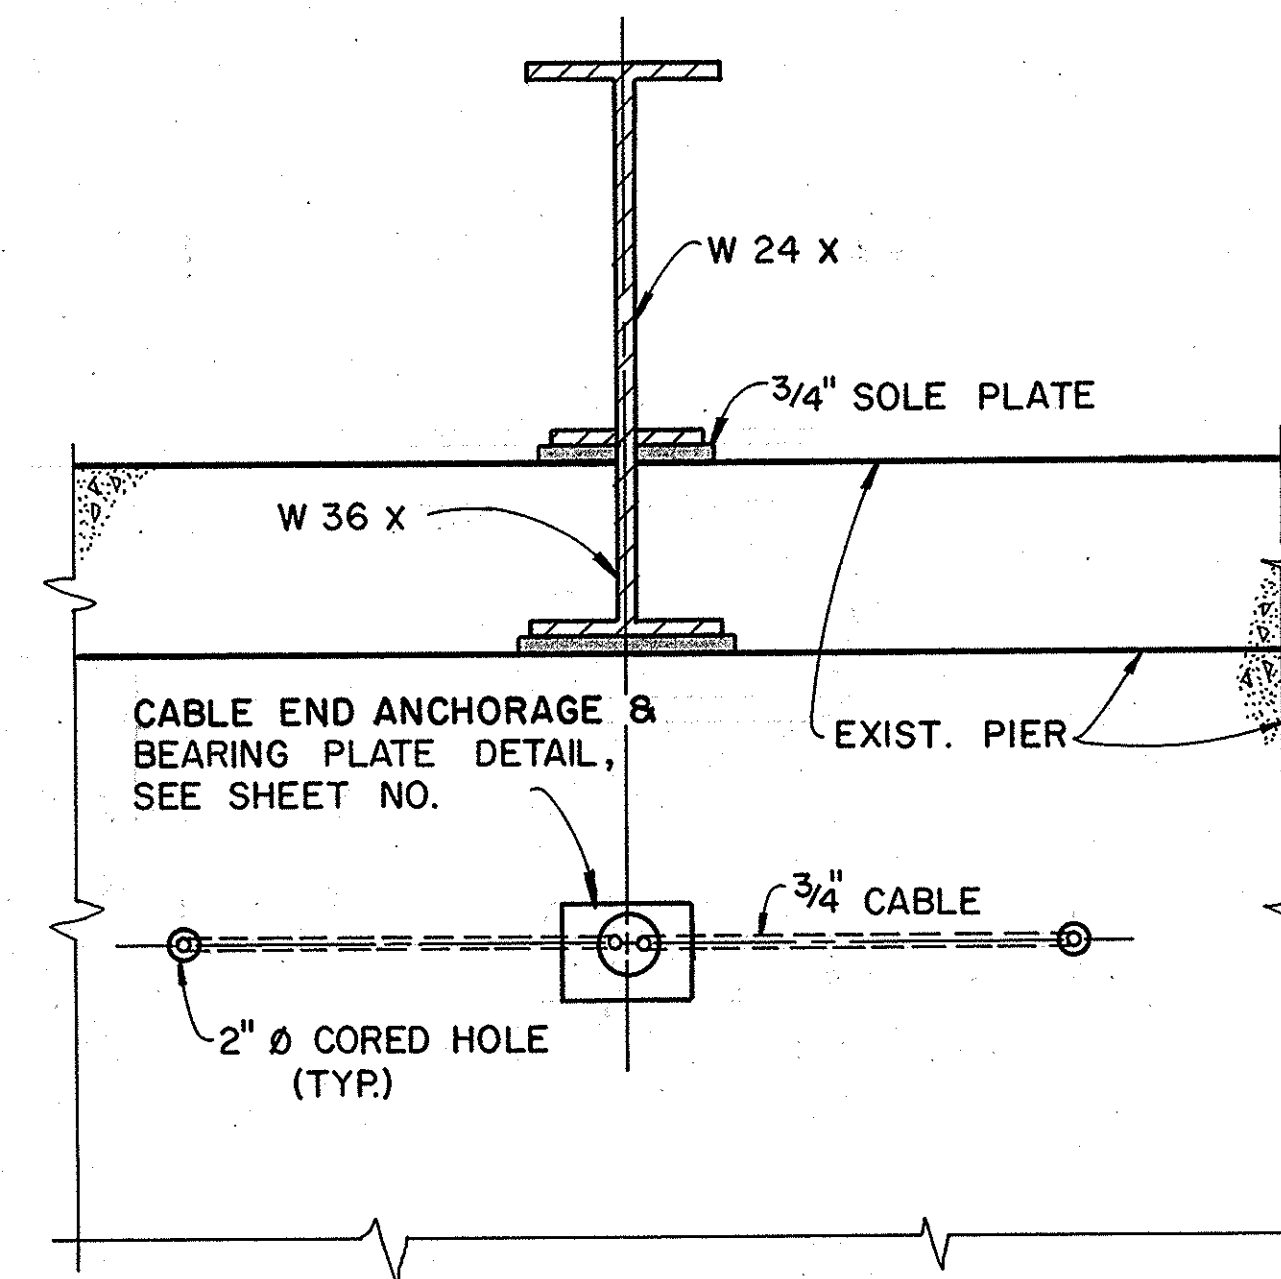
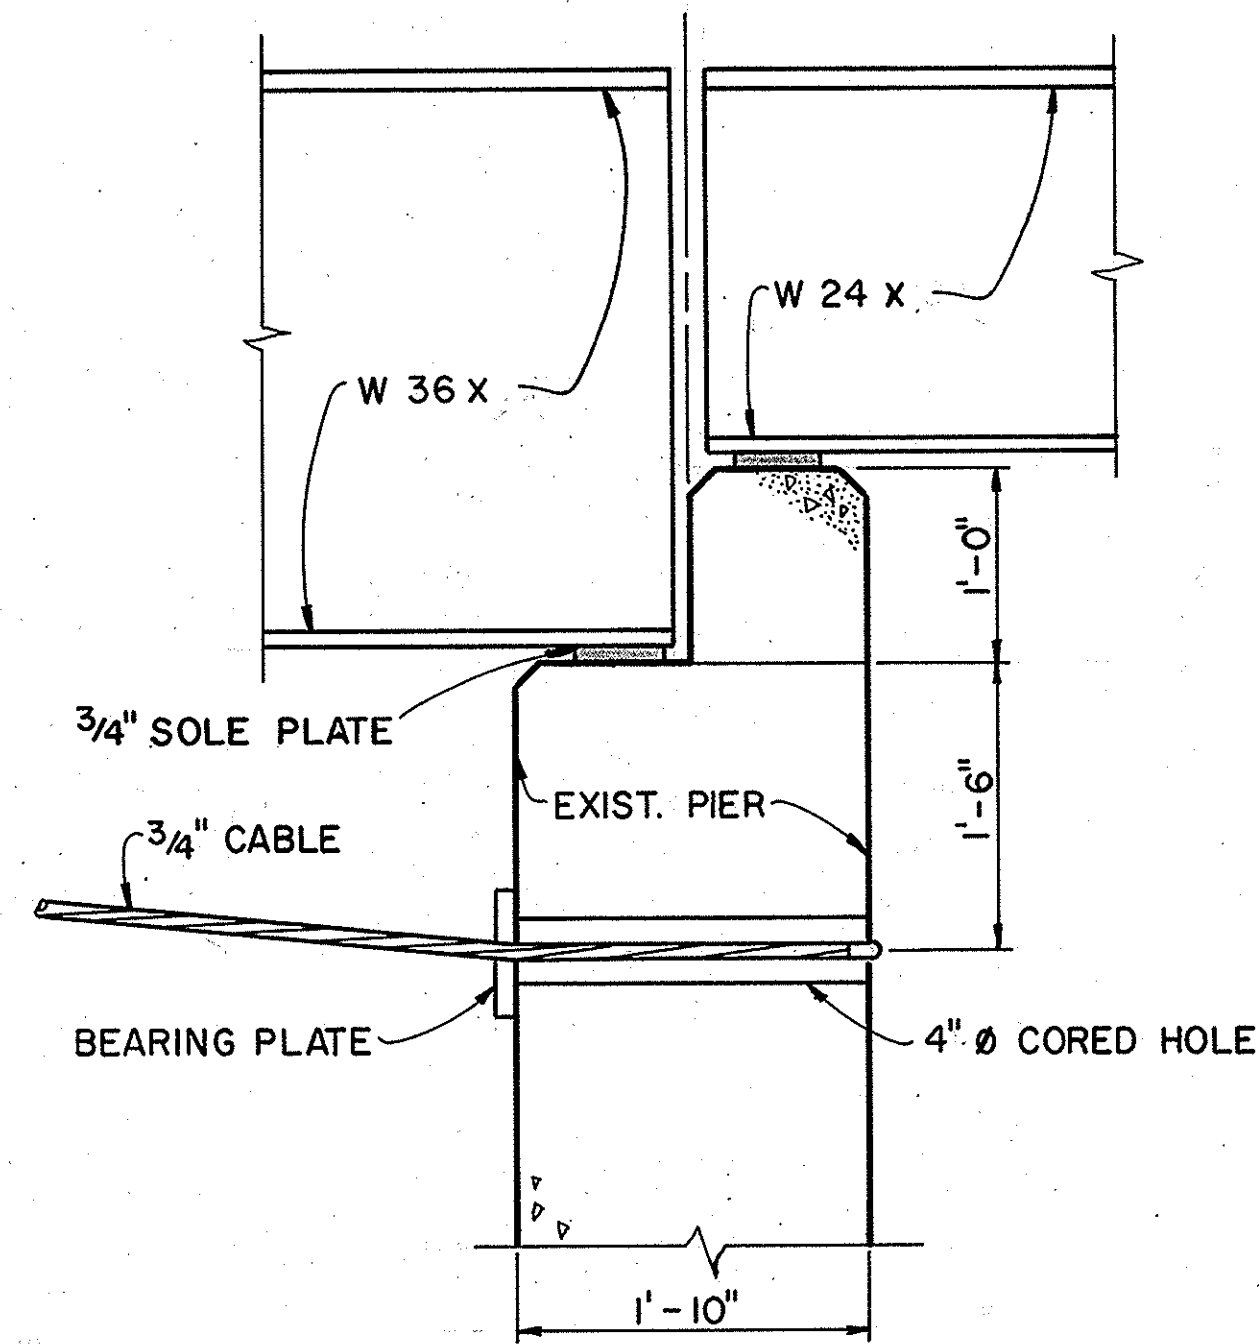


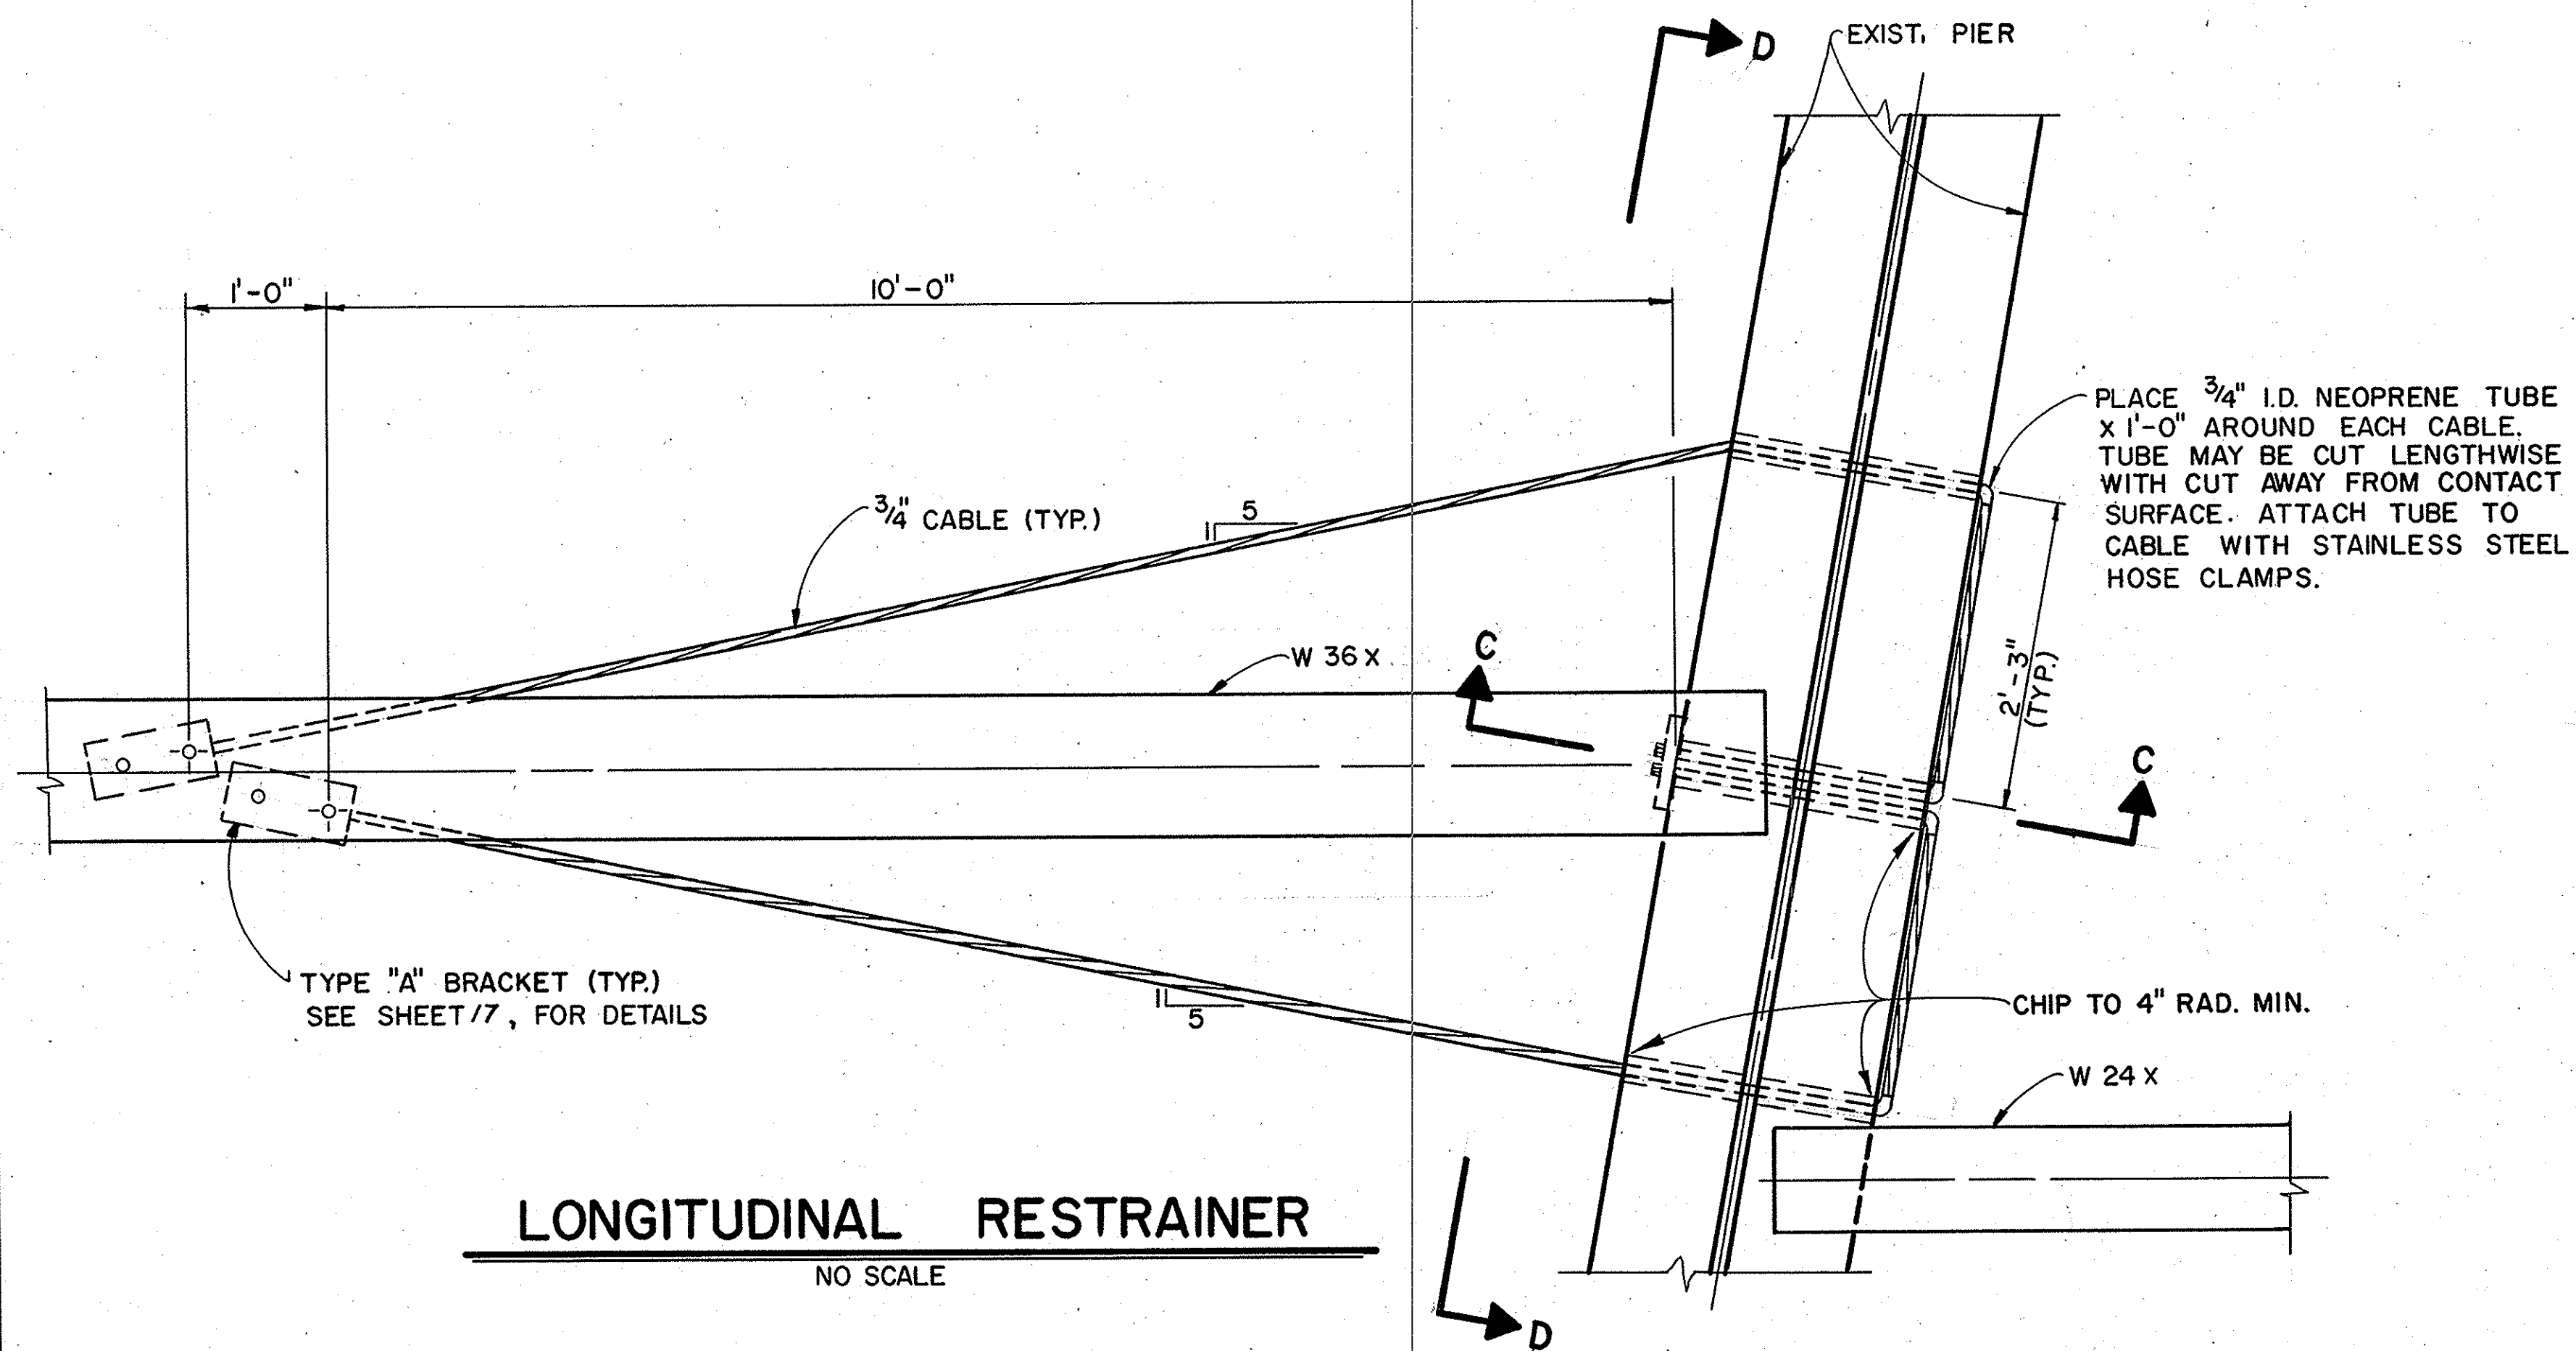

ORANGE COUNTY ENVIRONMENTAL MANAGEMENT AGENCY			
SEISMIC RETROFIT BRISTOL ST. BRIDGE at SANTIAGO CK. LONGITUDINAL RESTRAINER & PIER SHEAR BLOCKS			
MARK	DATE	DESCRIPTION	PREPARED UNDER SUPERVISION OF
REVISIONS			
DESIGNED	M.M.HSU	SCALE	DATE
DRAWN	P.BURK	CHECKED	DATE
DWG. NO.			15