


Bridge #AN-2
Broadway Bridge
Across Bolso Chico
Inlet Channel
Sheet 2 of 7
Rep. 2-25-71 Scale as shown
Penoll Sketch

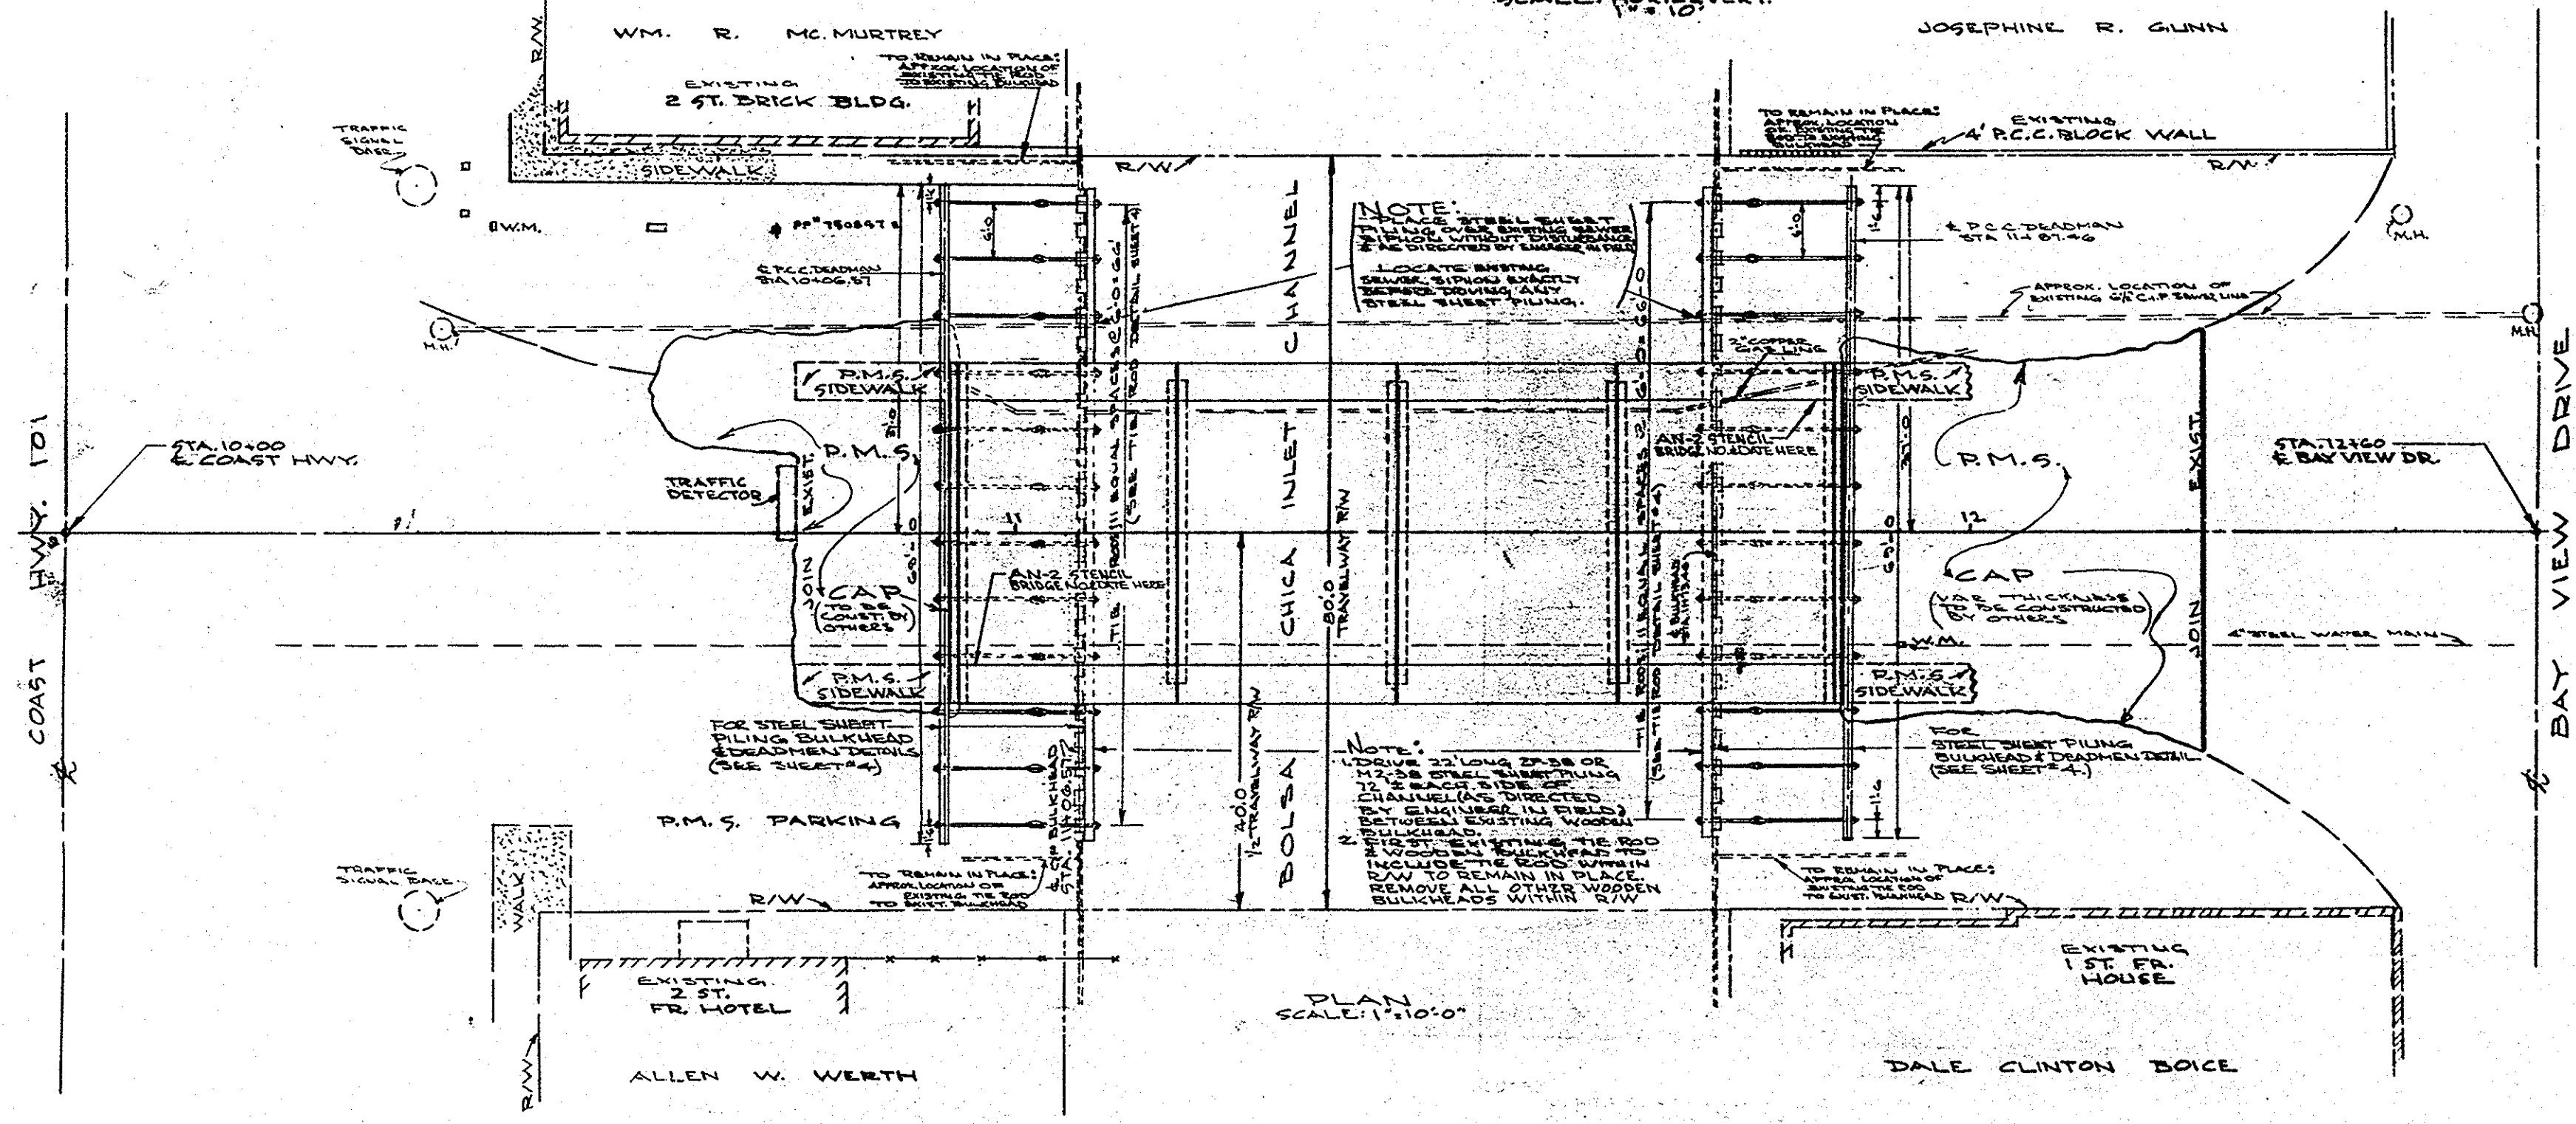

NOTE: UTILITIES ON EXISTING BRIDGE TO BE RELOCATED BY OTHERS

ORANGE COUNTY HIGHWAY DEPARTMENT	
BROADWAY BRIDGE	
GENERAL PLAN	
DESIGNED BY: J. W. S. 1-5-67	CHECKED BY: J. W. S. 2-27-67
APPROVED: J. W. S. 2-27-67	SCALE: AS SHOWN
SHEET 2 OF 7	

AN-2

AN-2

MICROFILMED
JUN 30 1980