


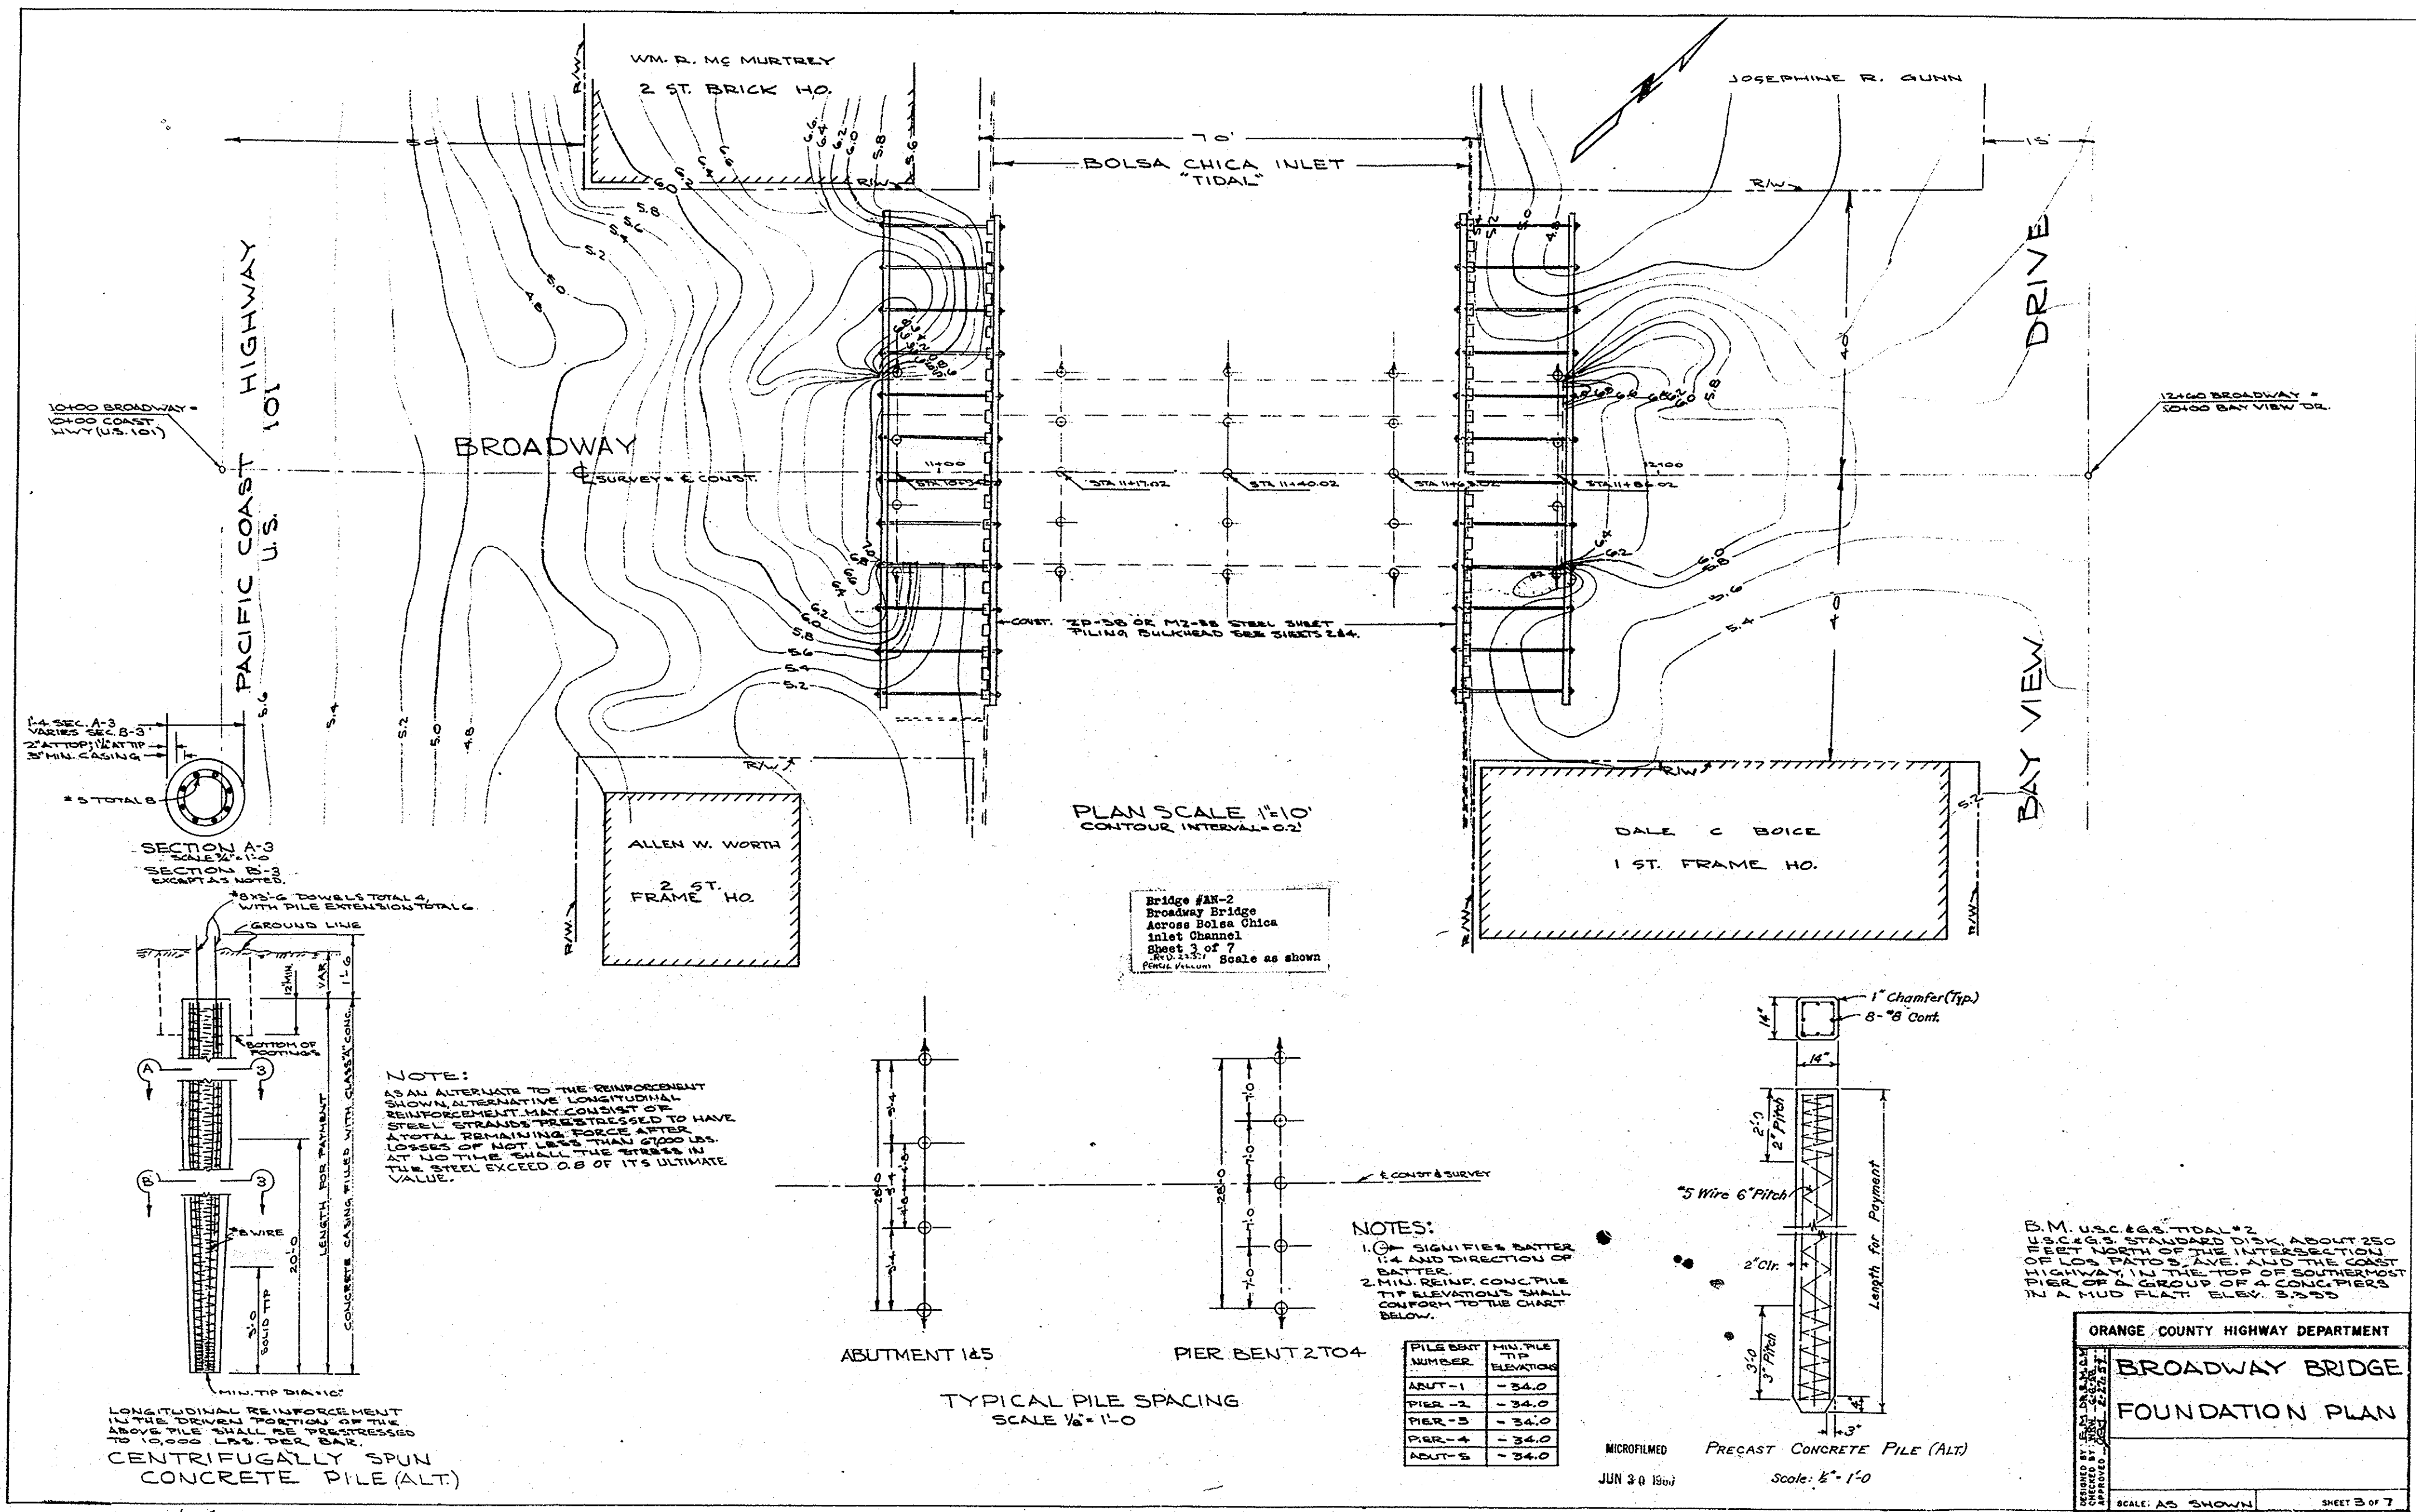

AN-2

AN-2