




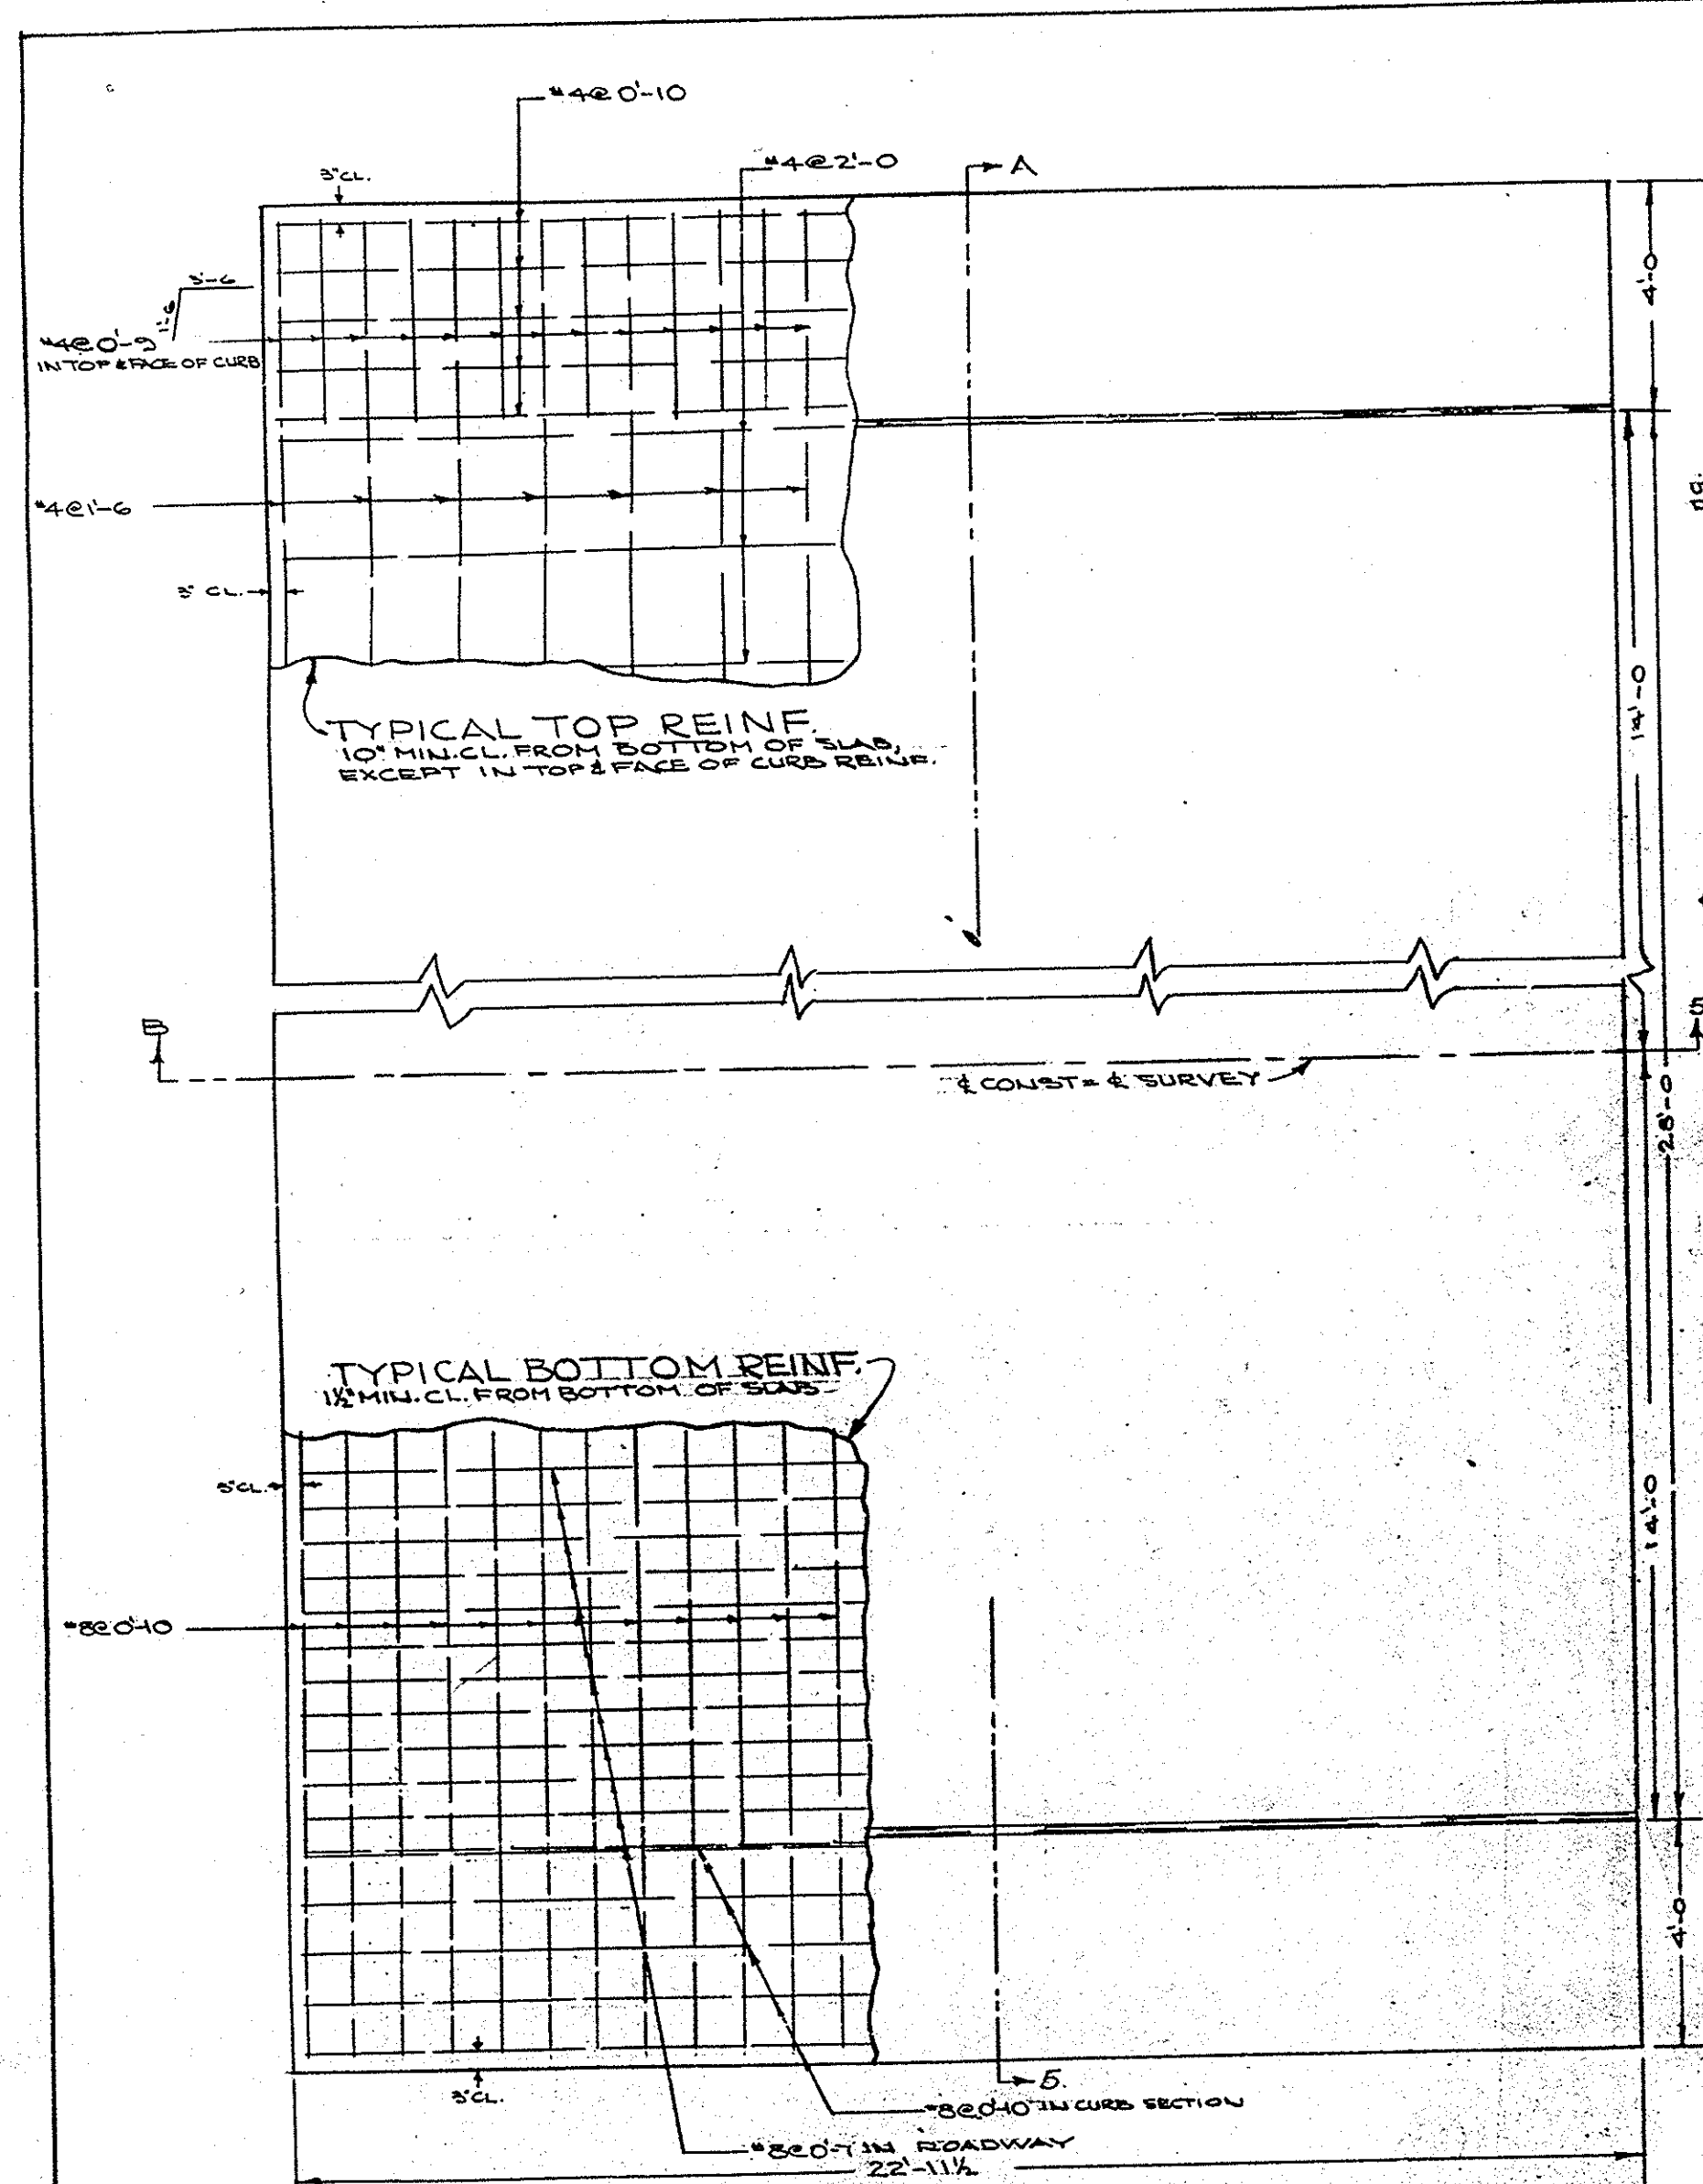


PLAN SPANS I to IV
SCALE 1/2" = 1'-0"

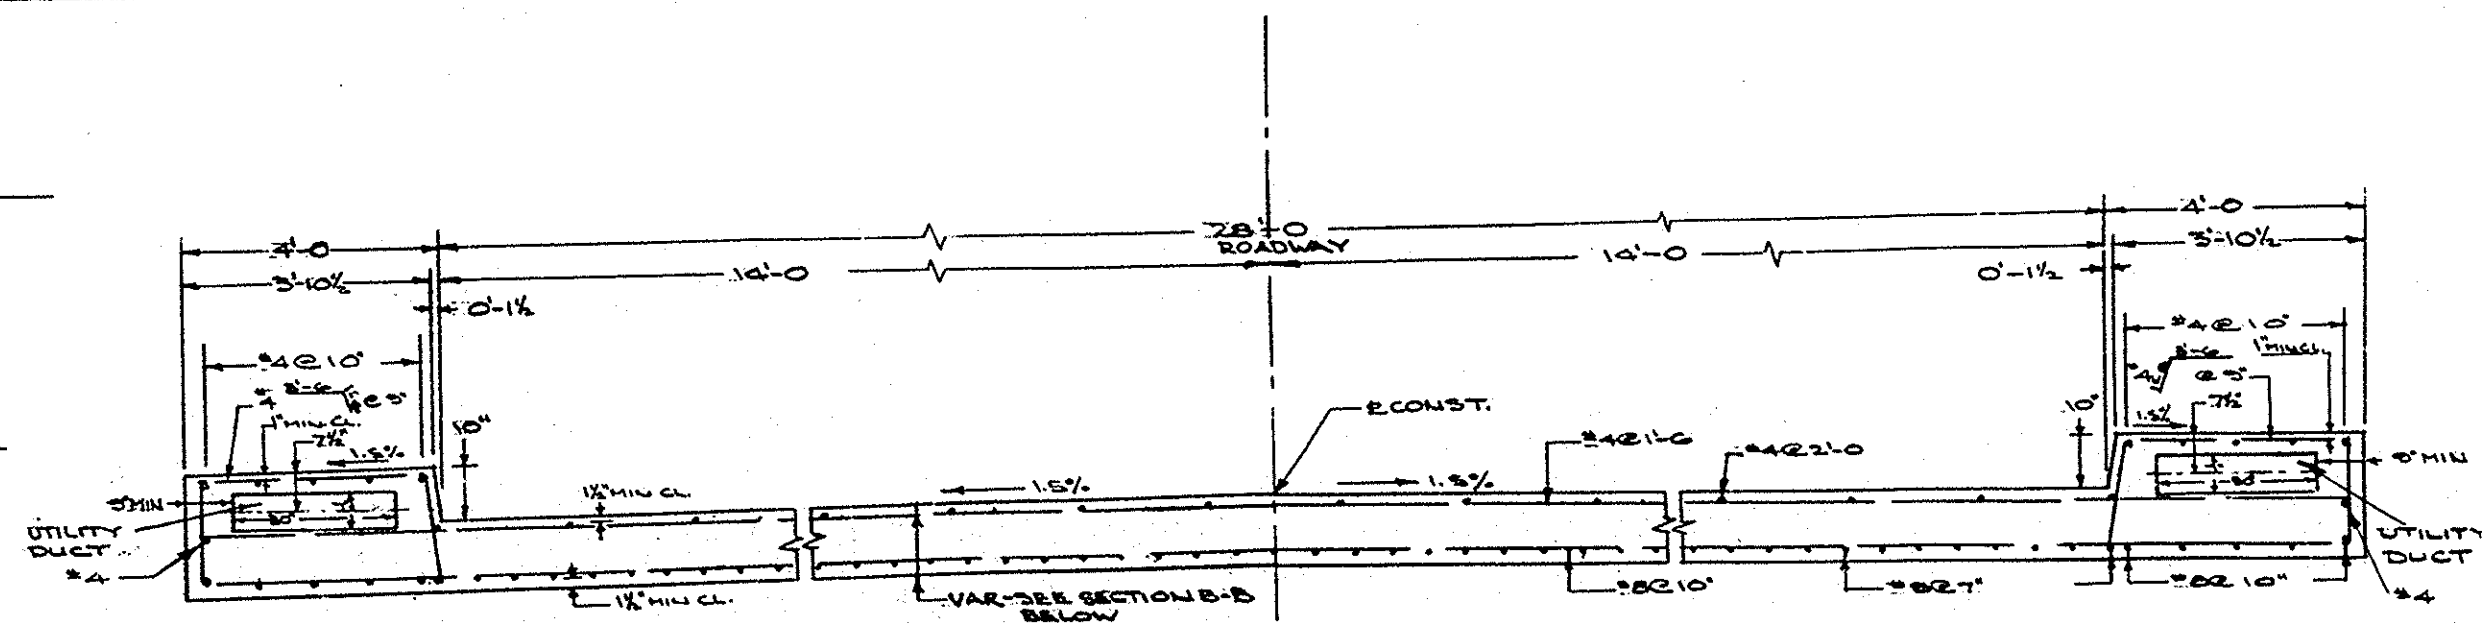

TYPICAL SECTION A-5
SCALE 1/2" = 1'-0"

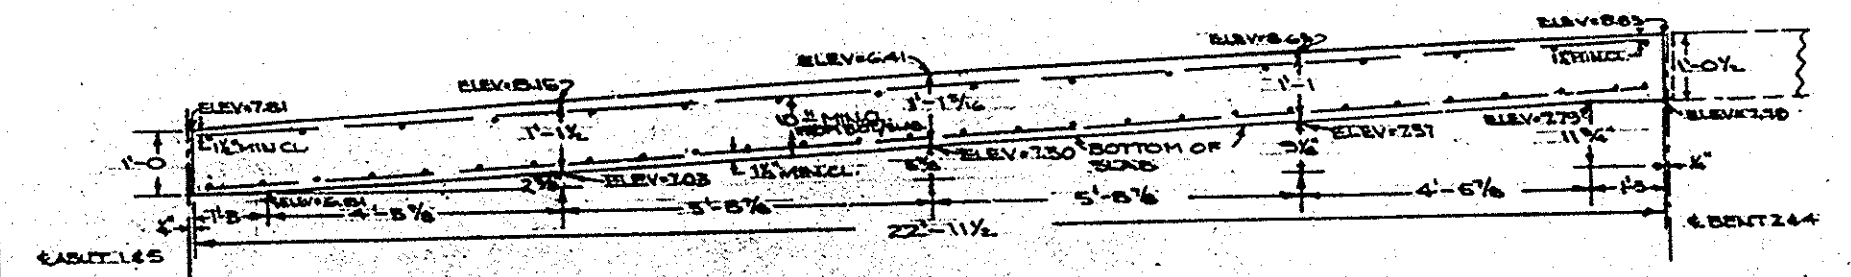


TYPICAL SECTION B-5 SPANS I & IV
BRIDGE SYMMETRICAL ABOUT BENT #3
SCALE 1/2" = 1'-0"

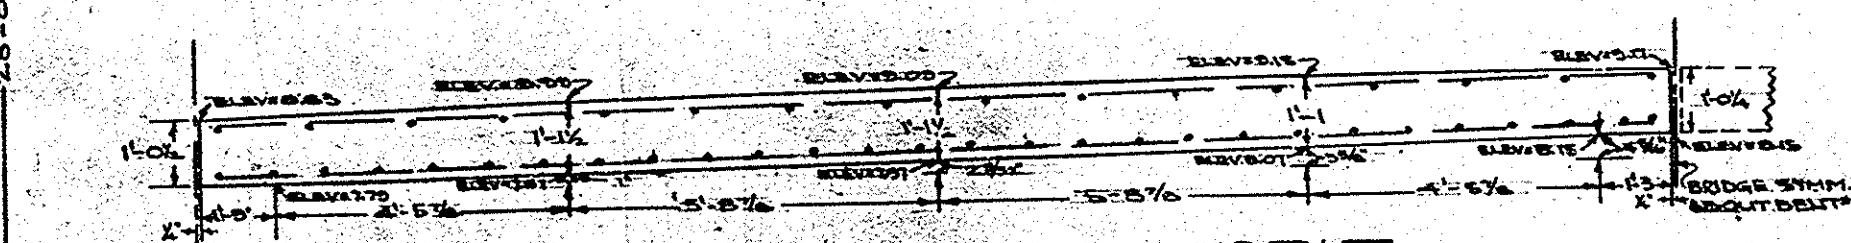

TYPICAL SECTION B-5 SPANS II & III
BRIDGE SYMMETRICAL ABOUT BENT #3
SCALE 1/2" = 1'-0"

NOTE:
1- RAILINGS NOT SHOWN
2- SET ANCHOR BOLTS TO MATCH FABRICATED RAILING.

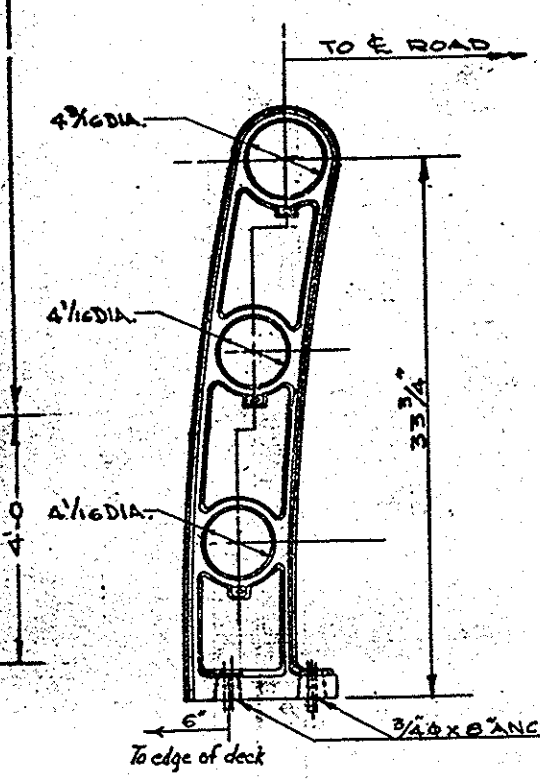

TYPICAL RAILING POST

DESCRIPTION	SIZE
TOP RAIL	4 1/2" O.D. x 1/8" WALL
MIDDLE RAIL	4" O.D. x 1/8" WALL
BOTTOM RAIL	4" O.D. x 1/8" WALL

NOTE:
POST TO BE PERM. MOLD CASTING
REYNOLDS #3 RI, ALCOA #3001
OR EQUAL.

Bridge #AN-2
Broadway Bridge
Across Bolsa Chica
Inlet Channel
Sheet 5 of 7
RCD 12.5.1 Scale as shown
Penon Sketch

ORANGE COUNTY HIGHWAY DEPARTMENT

BROADWAY BRIDGE
SLAB & MISCELLANEOUS
DETAILS

SUPERSTRUCTURE

SCALE: AS SHOWN SHEET 5 OF 7

MICROFILMED
JUN 30 1960

AN-2