


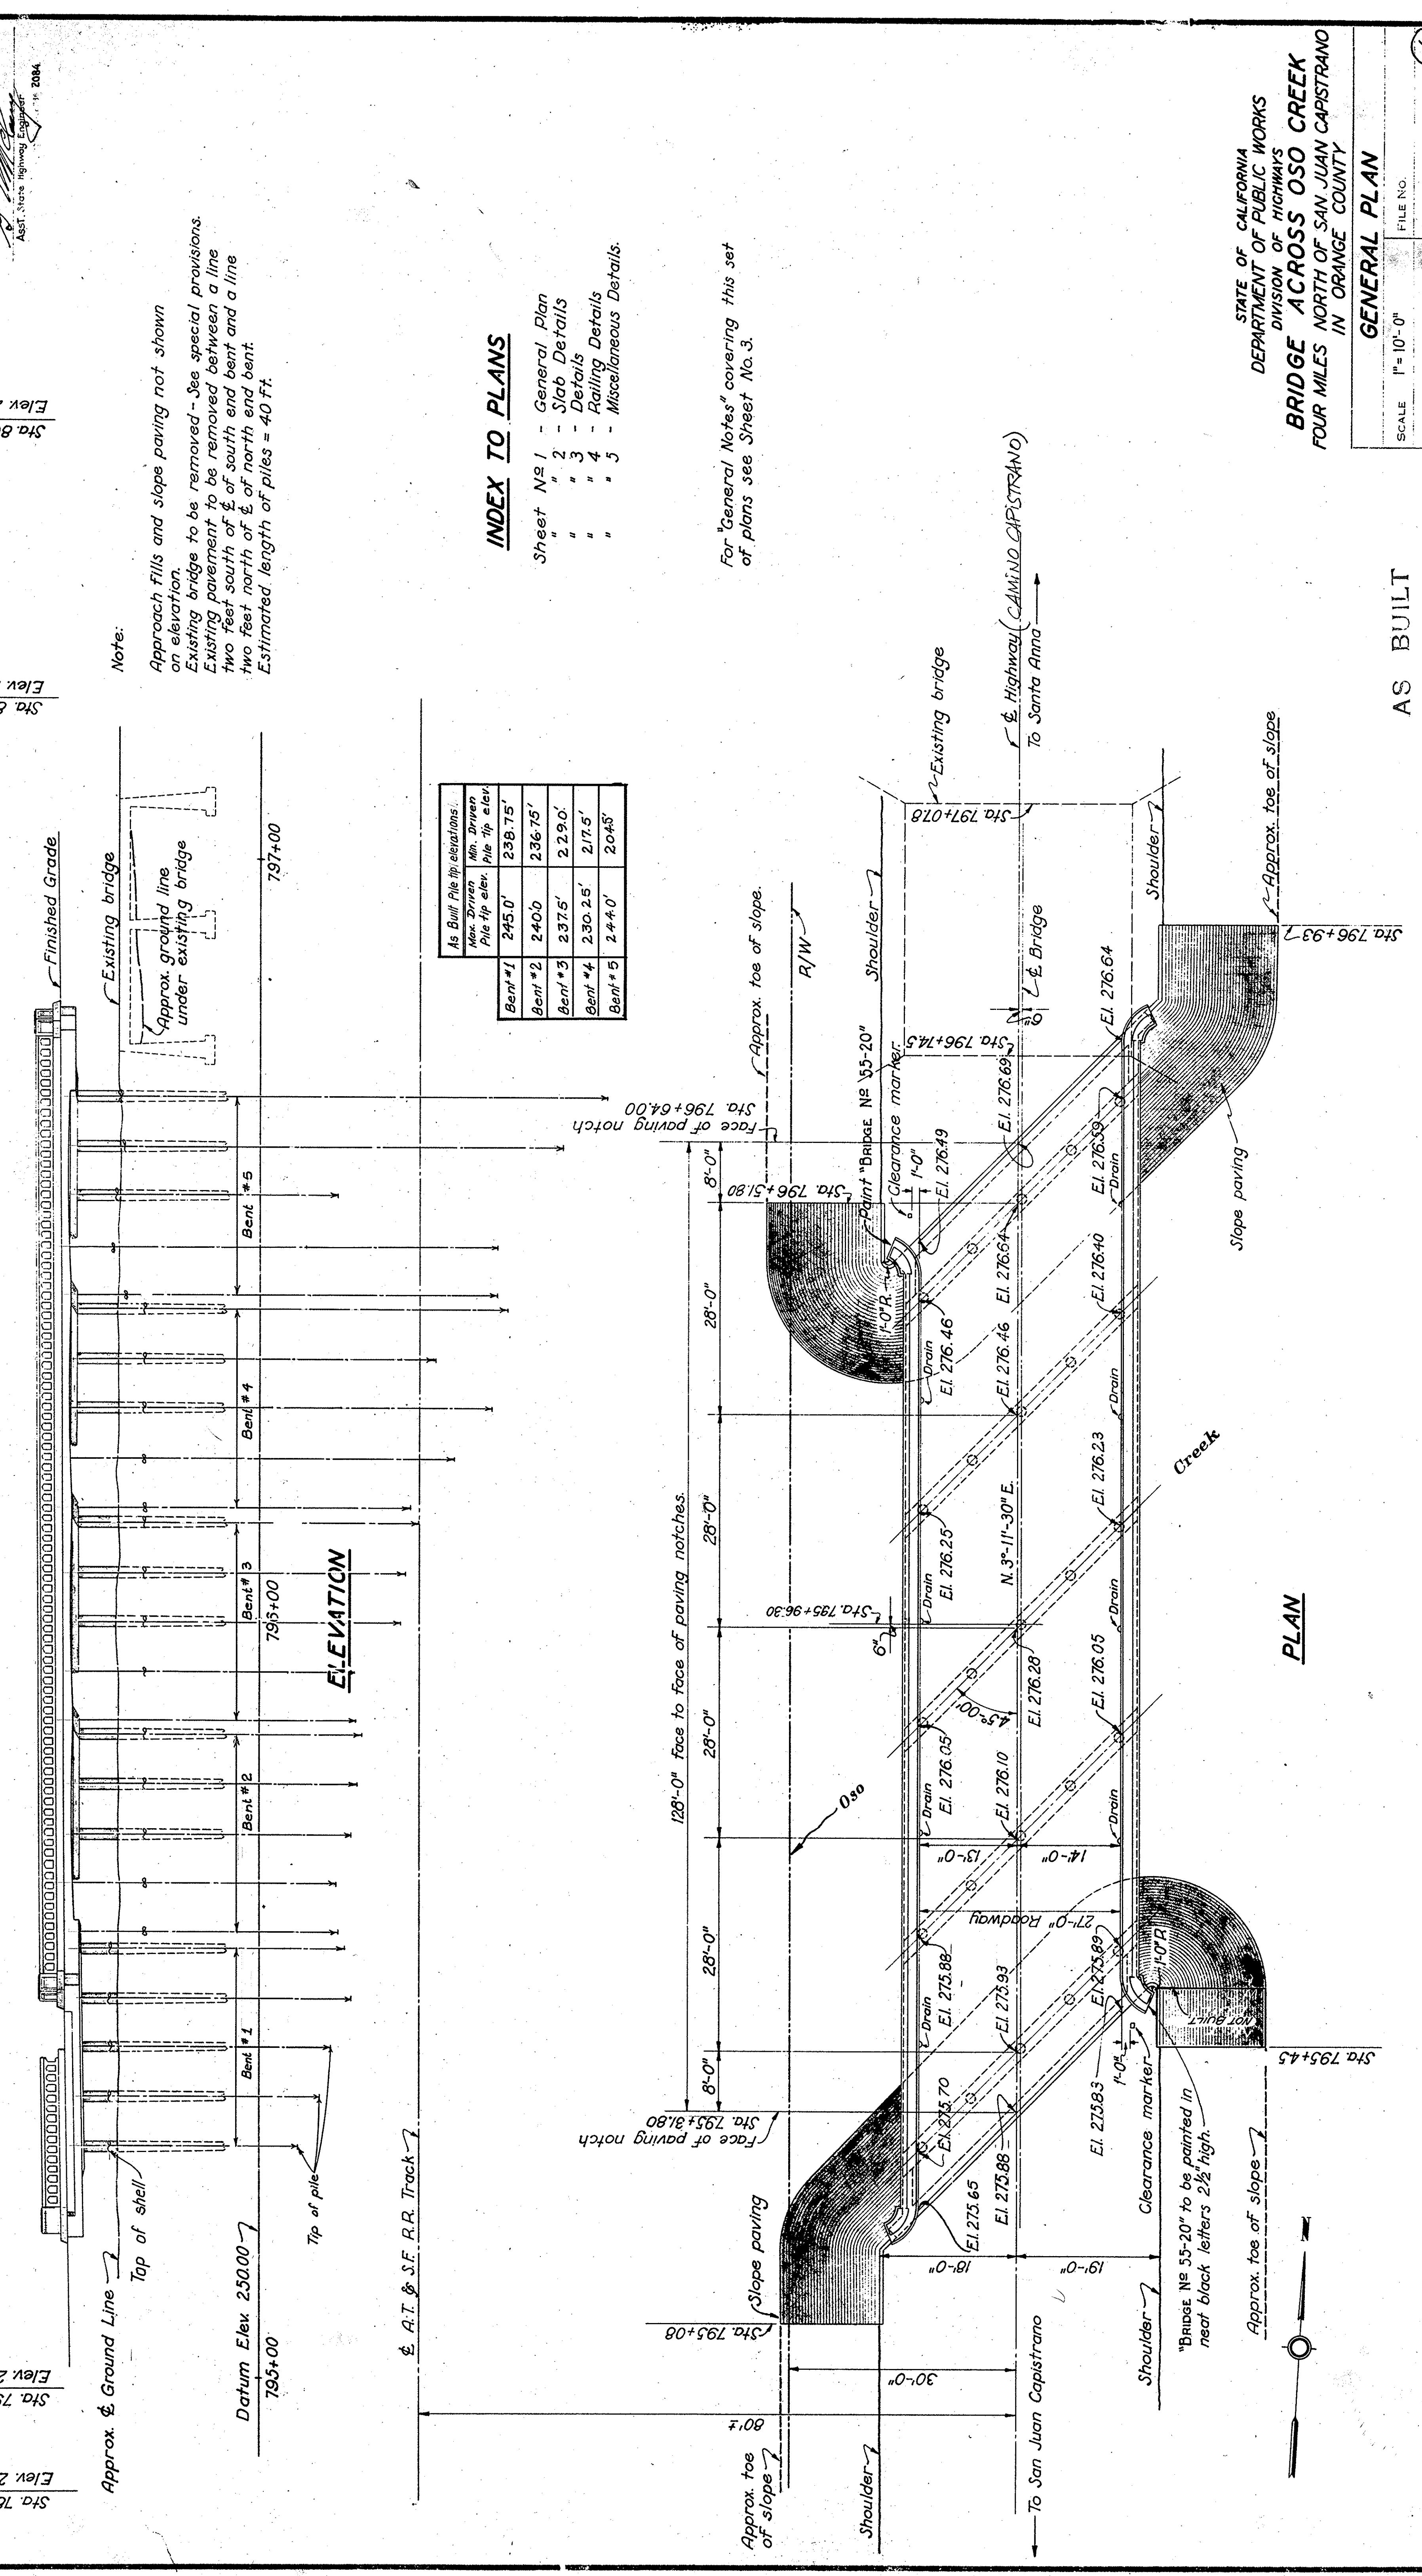

| As Built | Max. Driven | Min. Driven | Min. Driven |
|----------|-------------|-------------|-------------|
| Bent #1  | 245.0'      | 240.0'      | 238.75'     |
| Bent #2  | 237.5'      | 230.25'     | 229.0'      |
| Bent #3  | 230.25'     | 224.0'      | 217.5'      |
| Bent #4  | 230.25'     | 224.0'      | 217.5'      |
| Bent #5  | 230.25'     | 224.0'      | 217.5'      |

|             |                       |
|-------------|-----------------------|
| Sheet No. 1 | General Plan          |
| " 2         | Slab Details          |
| " 3         | Details               |
| " 4         | Railing Details       |
| " 5         | Miscellaneous Details |

For "General Notes" covering this set of plans see Sheet No. 3.

Approach fills and slope paving not shown on elevation.

Existing bridge to be removed - See special provisions.

Existing pavement to be removed between a line two feet south of  $\frac{1}{2}$  of south end bent and a line two feet north of  $\frac{1}{2}$  of north end bent.

Estimated length of piles = 40 ft.

AS BUILT