



128'-0" Face to face of paving notches.

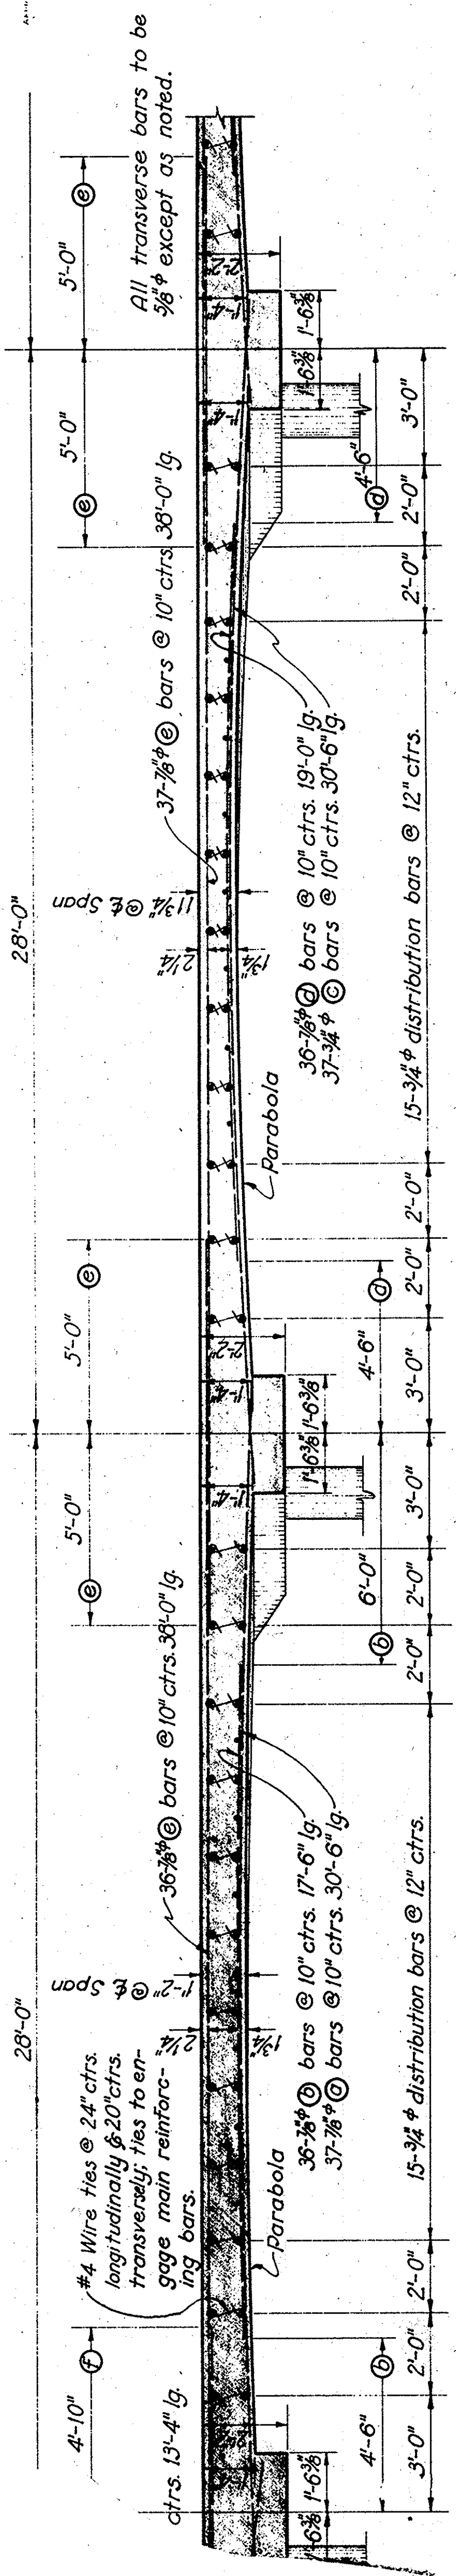

SECTION A-A

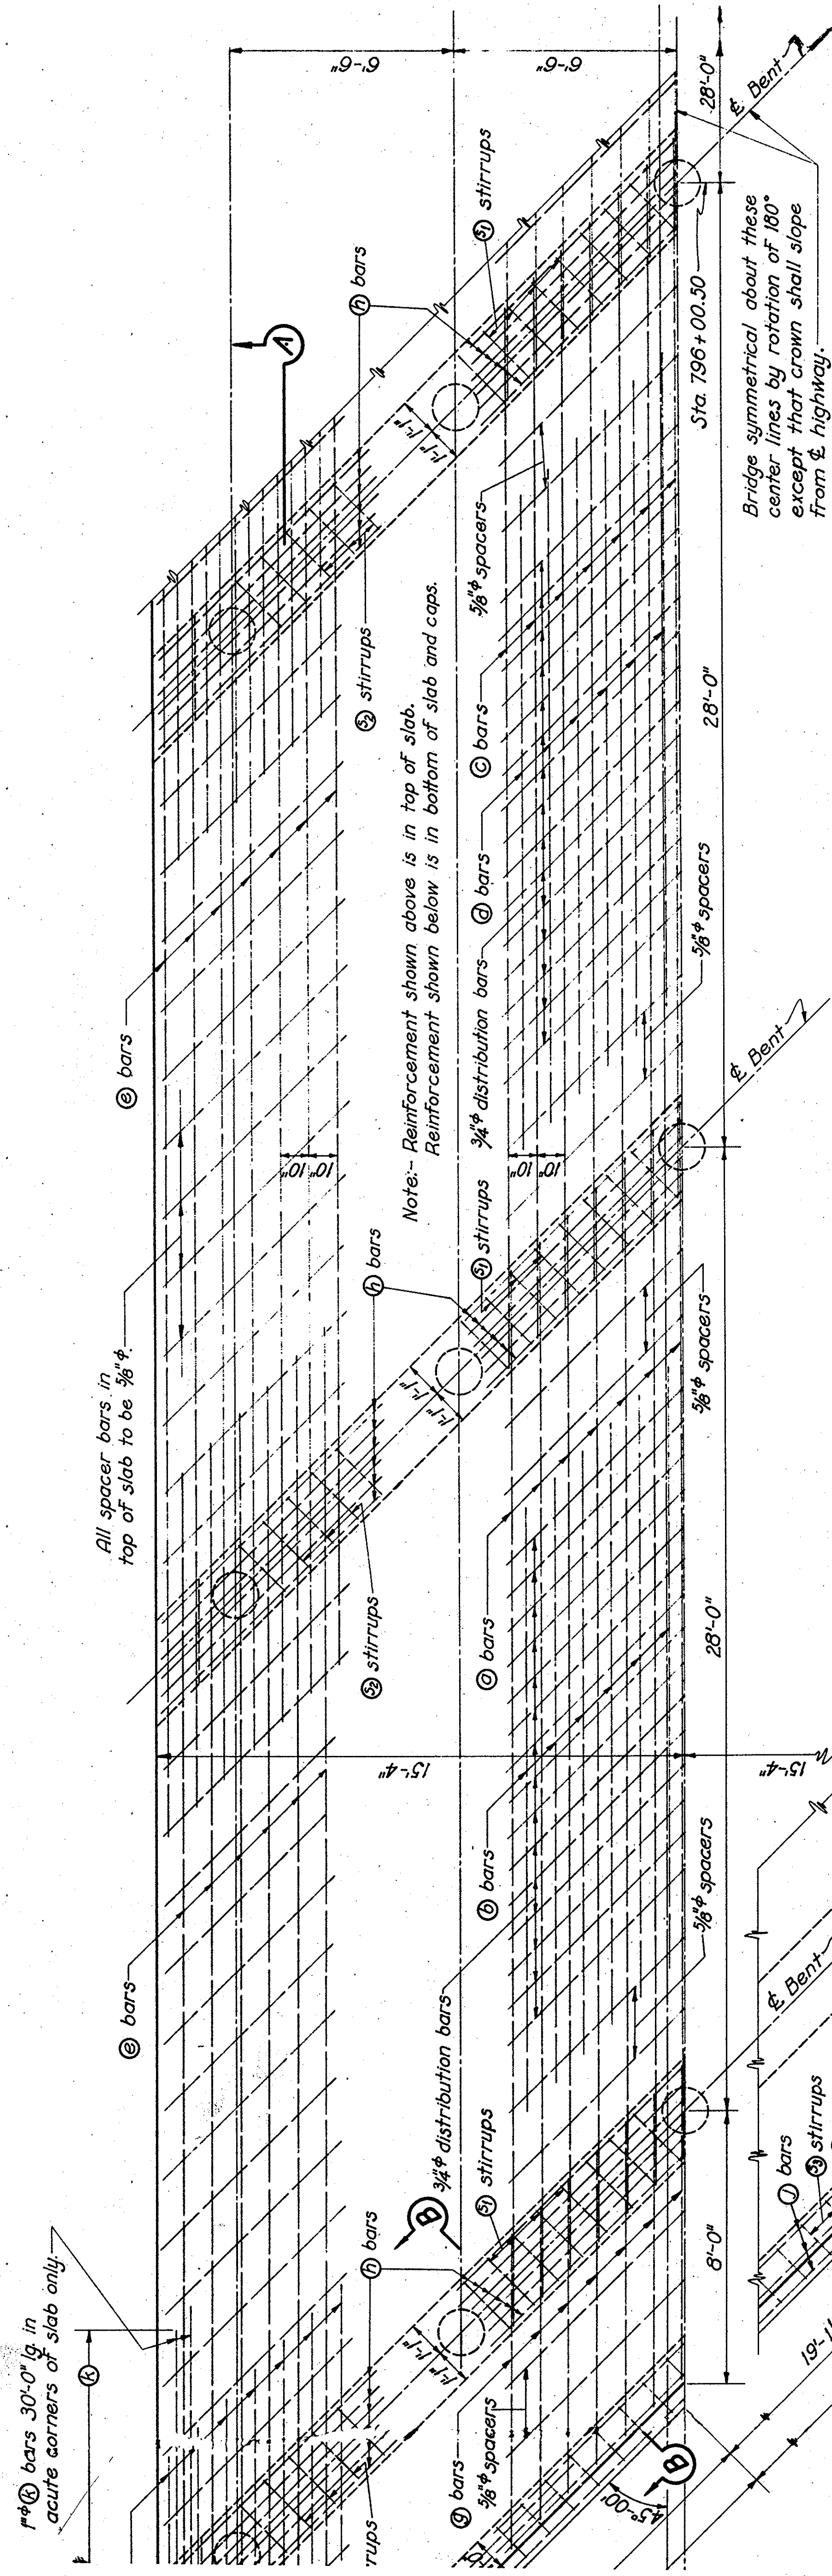

PART PLAN

Note:-  
Railing and curb not shown on this sheet. For details see Sheet No. 4.  
For details of drains, markers and hooked bars see Sheet No. 5.

BRIDGE ACP

SLAB

SCALE  
5/16"

AS BUILT

SECTION C-C

