

⊕ Amount to be added to overall dimension of concrete member to give the length of the hooked reinforcing bars, hooked at each end.

10




8 Required
Scale: 3" = 1'-0"

1. $\frac{1}{2} \log \frac{1}{2}$

SECTION



KEYS - SLAB TO GIRDER

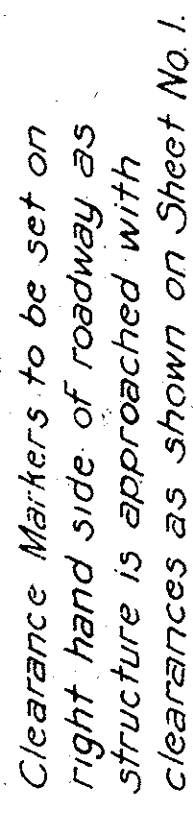

2 Required
Scale: 1"=1'-0"

