


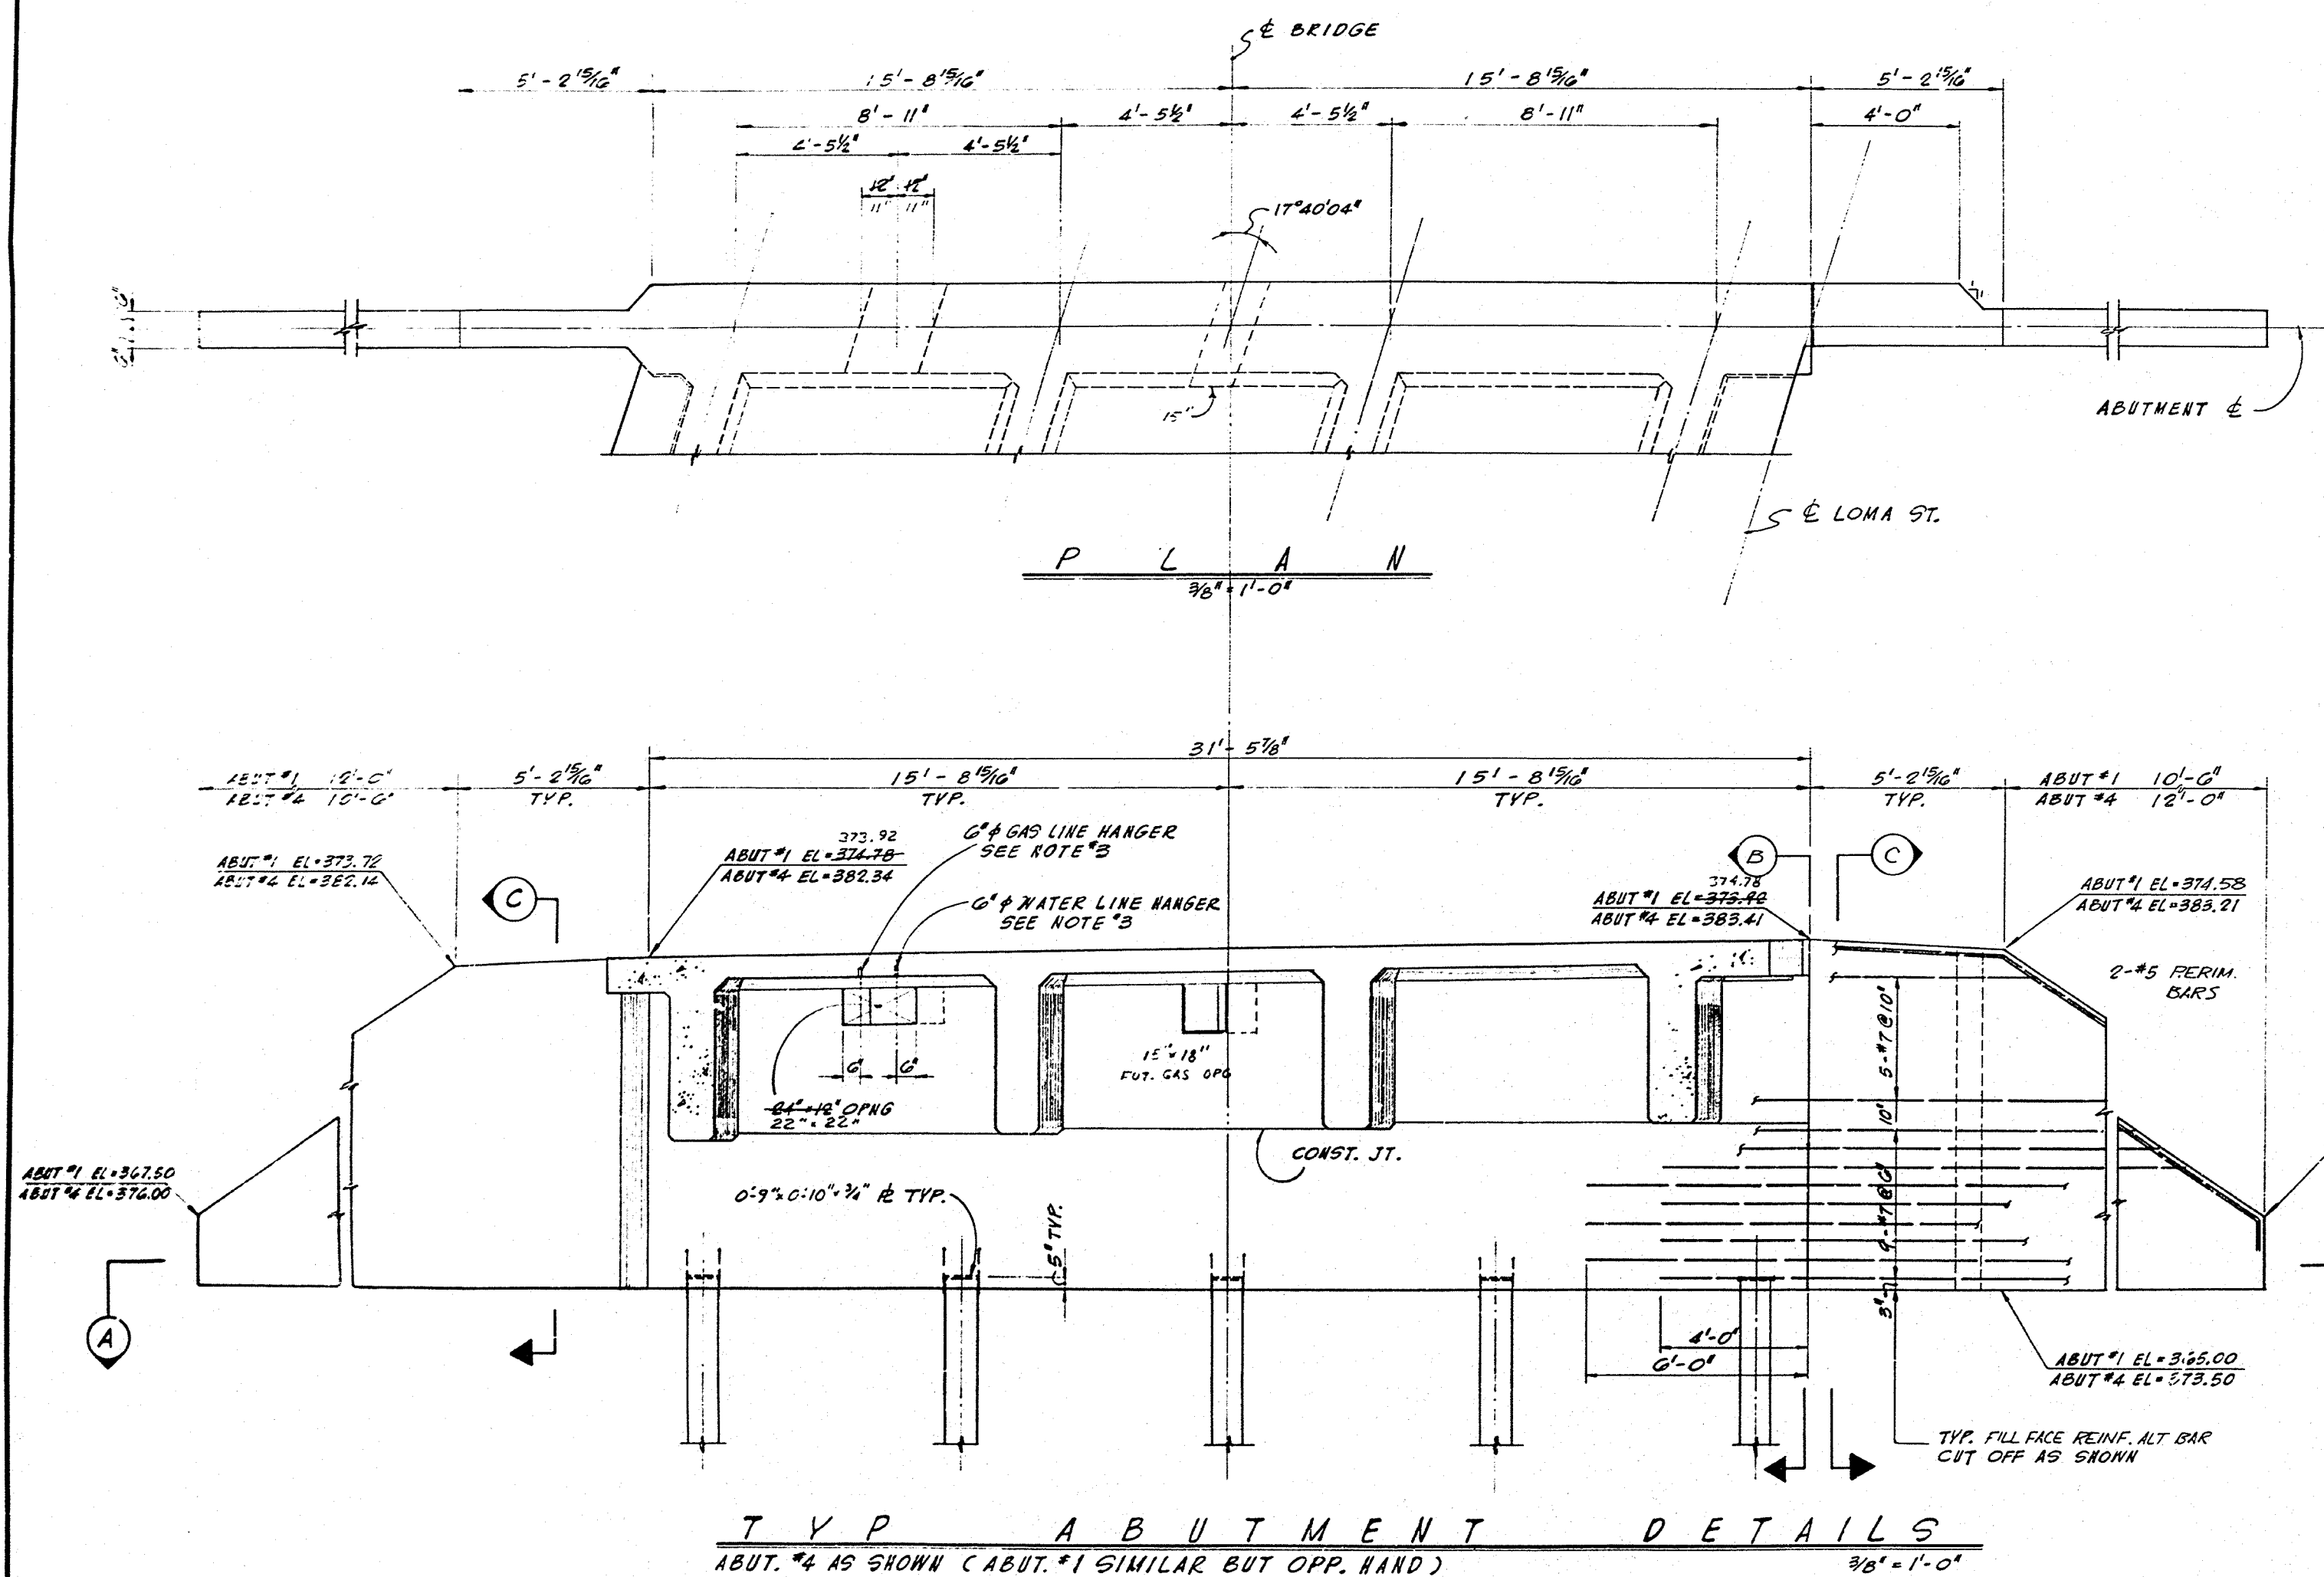


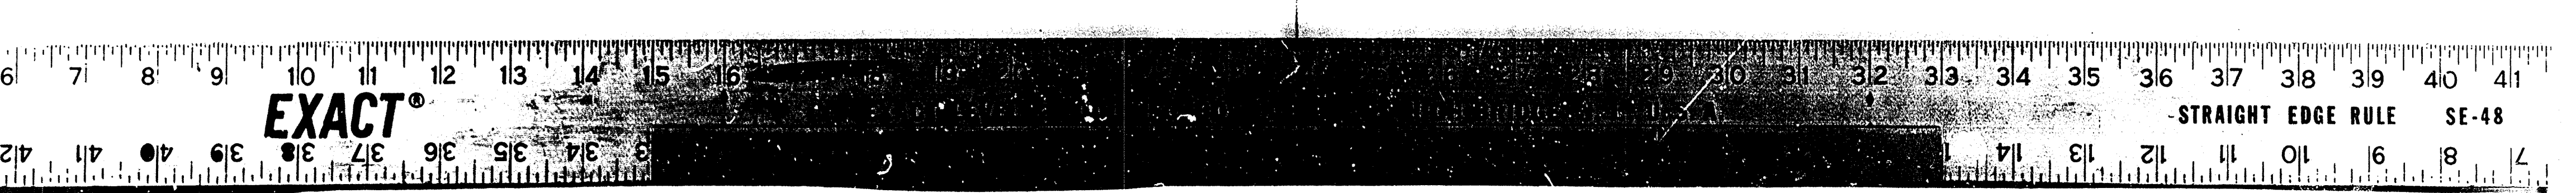

SECTION A-A
3/8" = 1'-0"

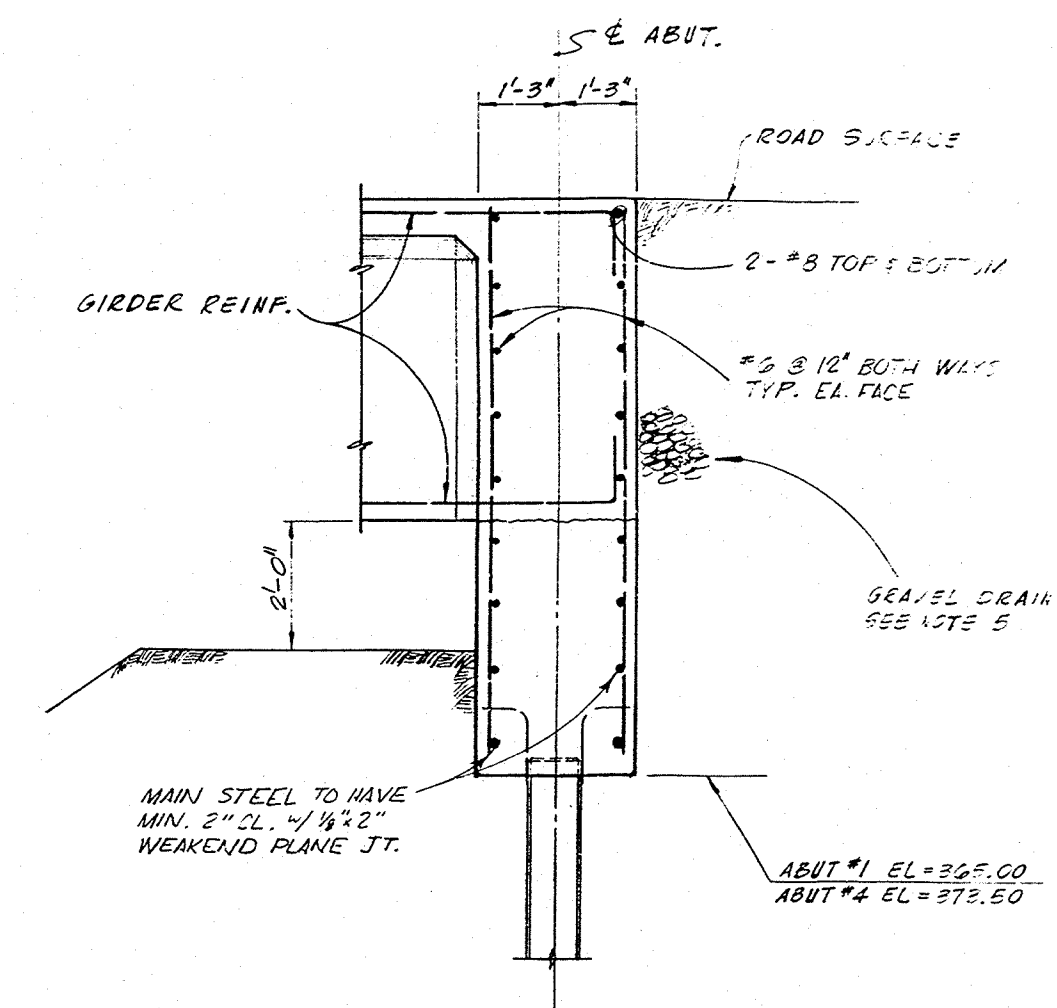

SECTION B-B
1/2" = 1'-0"

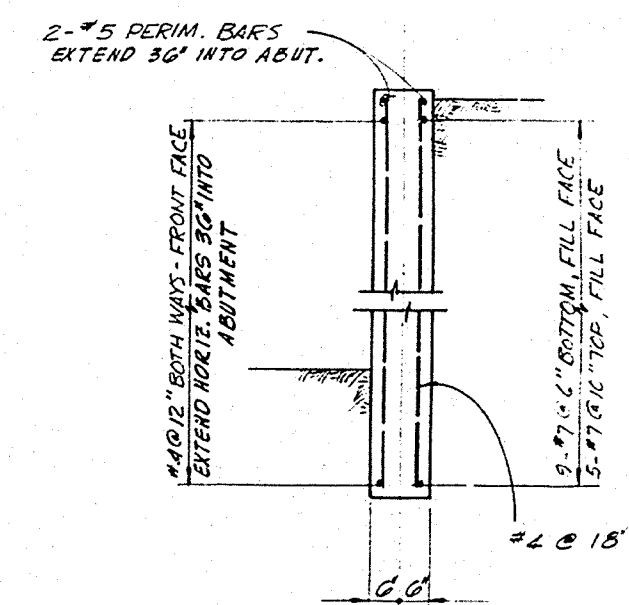

SECTION C-C
1/2" = 1'-0"

NOTES

1. BACKFILL BEHIND ABUTMENT WALL SHALL BE PLACED SIMULTANEOUSLY AT BOTH ABUTMENTS AFTER THE DECK IS COMPLETED.
2. FOR PILE TIP ELEVATION, SEE SHEET #3.
3. ALL HANGER INSERTS ARE TO BE FURNISHED BY OTHERS. VERIFY INSERT TYPE, SIZE AND SPACING WITH RESPECTIVE UTILITY COMPANIES.
4. BRACE ABUTMENT & WING WALLS AS REQ'D DURING CONSTRUCTION.
5. PROVIDE 12" x 12" CONT. GRAVEL DRAIN COR 1/4" x CRUSHED ROCK) BEHIND ABUTMENT & WING WALLS. SLOPE 1/4" PER FOOT TO DISCHARGE AT END OF WING WALLS.

CONSTRUCTION PLANS
Loma Street Bridge
Sheet 4 of 11
3/4" = 1'-0" Scale as shown
Tollman

ORANGE COUNTY ROAD DEPARTMENT	
LOMA ST. BRIDGE SC-II OVER SANTIAGO CREEK	
ABUTMENT DETAILS	
SCALE As Shown	SHEET 4 OF 11

DR 11 (10475)